


S.S. ARTHUR WRIGHT.


- PROFILE - DECK PLAN -

LENGTH B.P. 208.6 BREADTH MLD 33.0 DEPTH MLD UPPER DK 15.10 R.Q.DK 19.7
 - TO CLASS LLOYDS 100.A.I. -
 - SCALE 1/8" = 1 FOOT. -

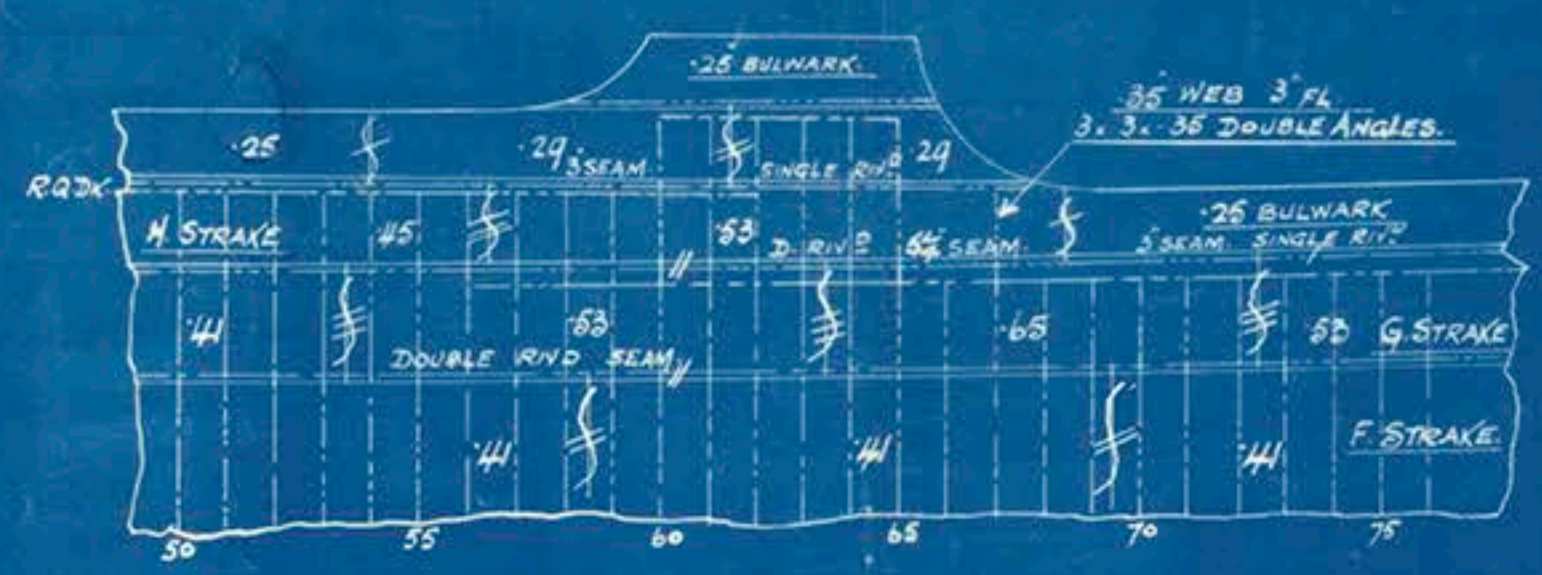

SHELL PLATING AT BREAK


WT B⁴D TRANSOM FLOOR

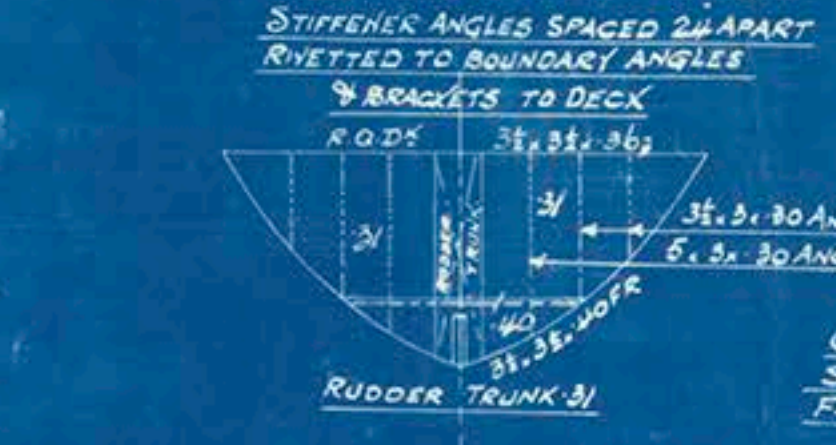


AFTER PEAK B⁴D NO 3 WT



AFTER PEAK B⁴D NO 5 WT

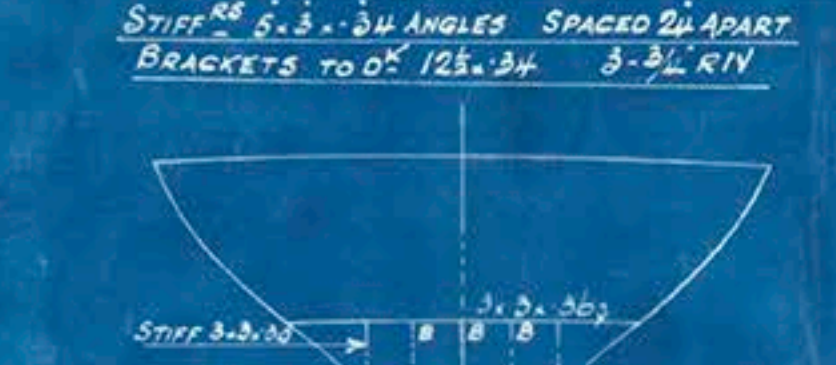


BUNKER BULKHEAD NON. WT

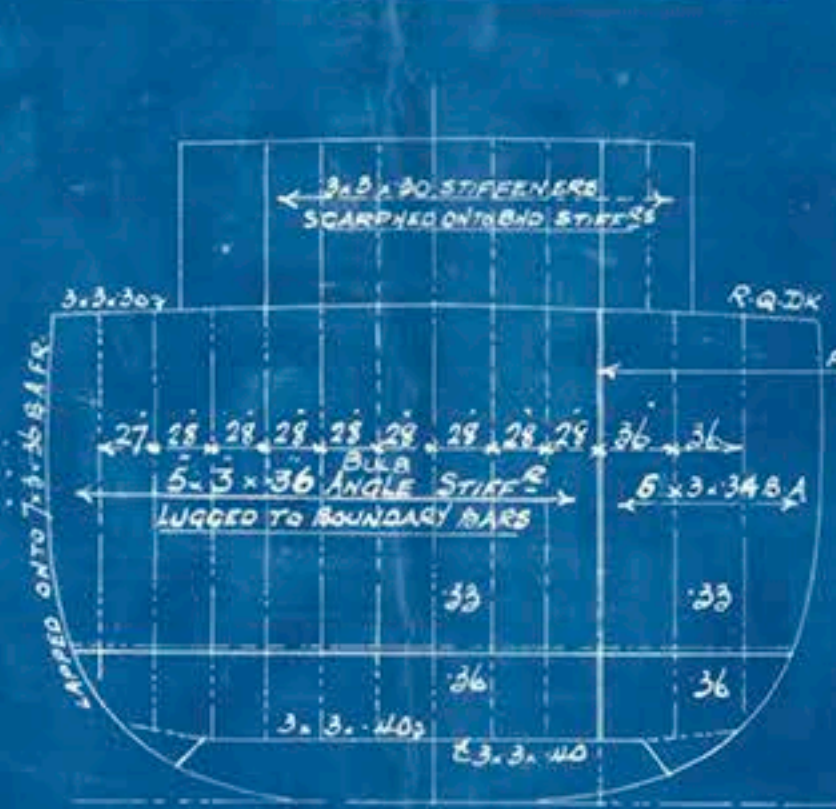

No 236

WT BULKHEAD BETWEEN FRAMES 29 & 30

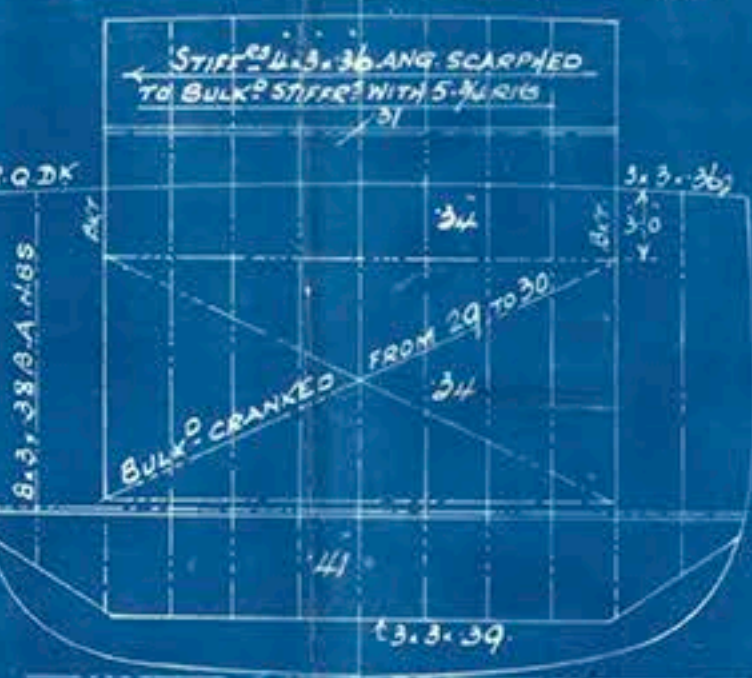

NON WT BULKHEAD - FRAME NO 62



UPPER HALF BEAMS



© 2018

Lloyd's Register Foundation

Wm. Pickersgill & Sons Ltd
 SHIPBUILDERS
 SOUTHWICK, SURREY
 LONDON

"Arthur Wright"
Pickersills 10236

Profile & Decks

As built

Now

"ARISTON"

Sunderland Report No. 32024

EX

"ARTHUR WRIGHT"

RETAIN

Register
ation



© 2018

Lloyd's Register
Foundation

LR-FAF-TB23-F-34