

PROFILE & DECK PLANS.


LENGTH B.P. 135'-0" BREADTH EX. 30'-0" DEPTH MLO 13'-10."

1/8" SCALE

TO CLASS 100 A1 LLOYDS "RAISED QUARTER DECK"
1ST N° 55.92 Q^R D^S FRAME N° 59.92. 2ND N° 10848.

THE FOLLOWING ADDITIONS WERE MADE TO THE
SCANTLINGS PER OWNERS REQUIREMENTS.

20	ON FRAMES INTANK	
20	REV. FRG. THROUGHOUT BOTTOM	
30	ELL A STRAKE	FRG 8 TO 101
"	"	R. " " " " 6 " 57
"	"	C " " " " 25 " 89
30	INT ^L PLATES EACH SIDE INTANK & BOILER ROOM	
30	" " BARS TOP & BOTTOM	
30	BULB ANGLE FRG. BETWEEN PEAK BULKHEADS	
30	TANK TOP (EXCEPT CENTRE STRAKE) & MARGIN PLATE	

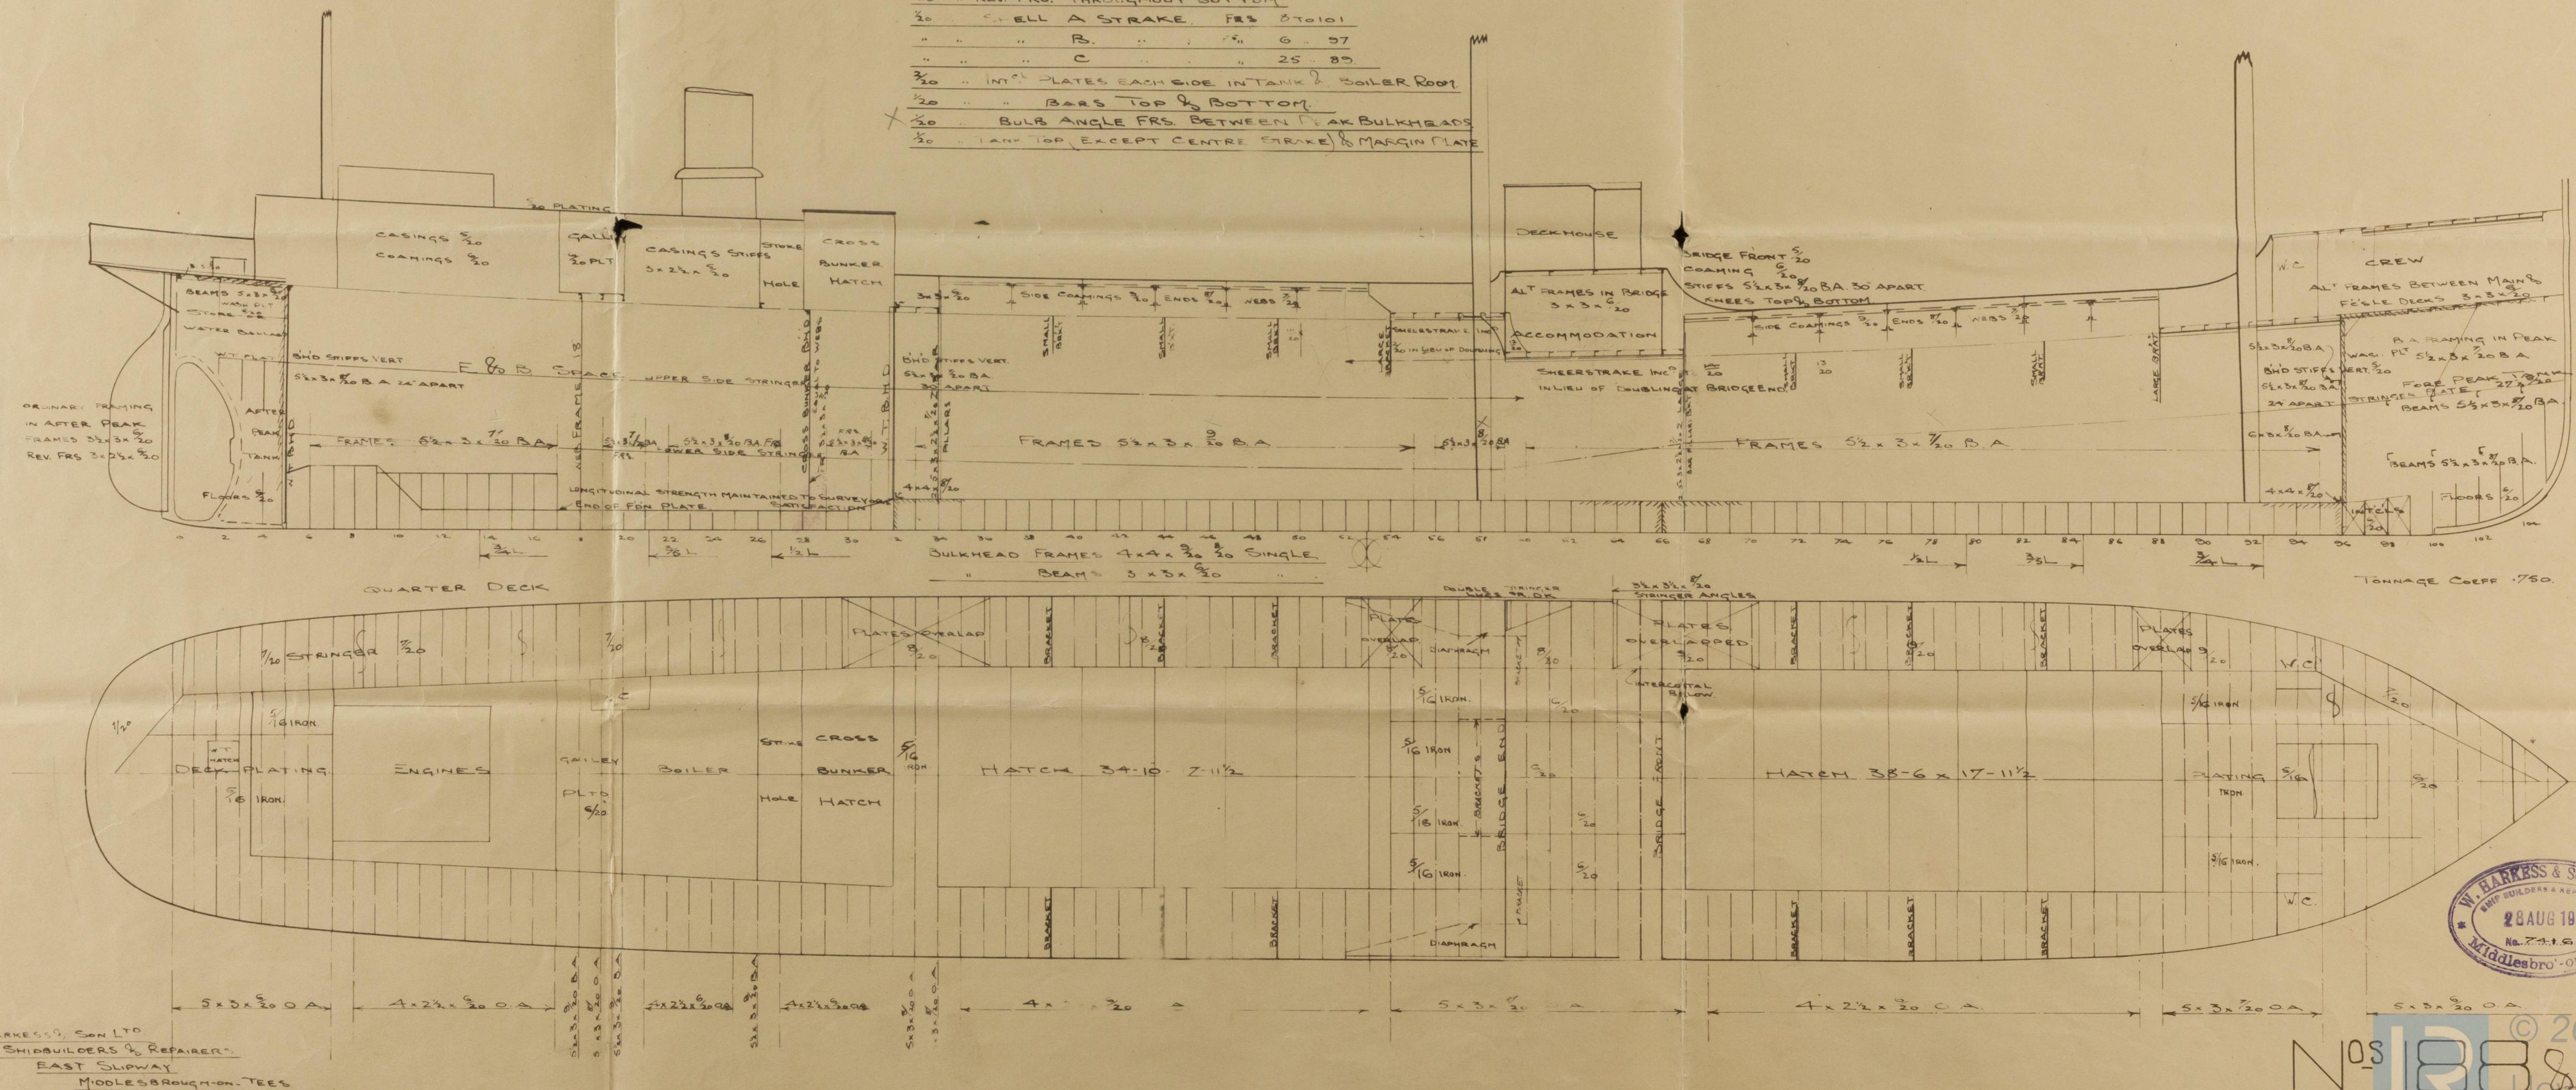

W. HARRISS & SON LTD.
SHIPBUILDERS & REPAIRERS.
EAST SLIPWAY
MIDDLESBROUGH-ON-TEES

W. HARKESS & SON, LTD.
SHIP BUILDERS & REPAIRERS
28 AUG 1911
No. 7446
Middlesex

© 2020
Lloyd's Register
Foundation

002062-002070-0275

W. Harkness & Son Ltd
Yard No 189
S. S. "Eskwood"
Profile & Deck Plans
(As built)

Inst. Report 6983



© 2020

Lloyd's Register
Foundation

002062-002070-0275