

PROFILE & DECK PLAN.  
Nos 1026-7-8-9-1030.

SS. "LORD GRAY"

1165  
Mann & Lloyd's Register of Shipping  
Hull

STEEL SCREW TRAWLER.


DIMNS: 140'-0" B.P. x 23'-10 1/2" MLD x 14'-0" MLD.

SCALE 1/4" = 1 FOOT.

TO CLASS 100 A.1. STEAM TRAWLER.

BULKHEADS STIFFENED TO SURVEYORS  
SATISFACTION.

BEAMS 6" x 3" x .45 EXCEPT WHERE MARKED  
OTHERWISE.

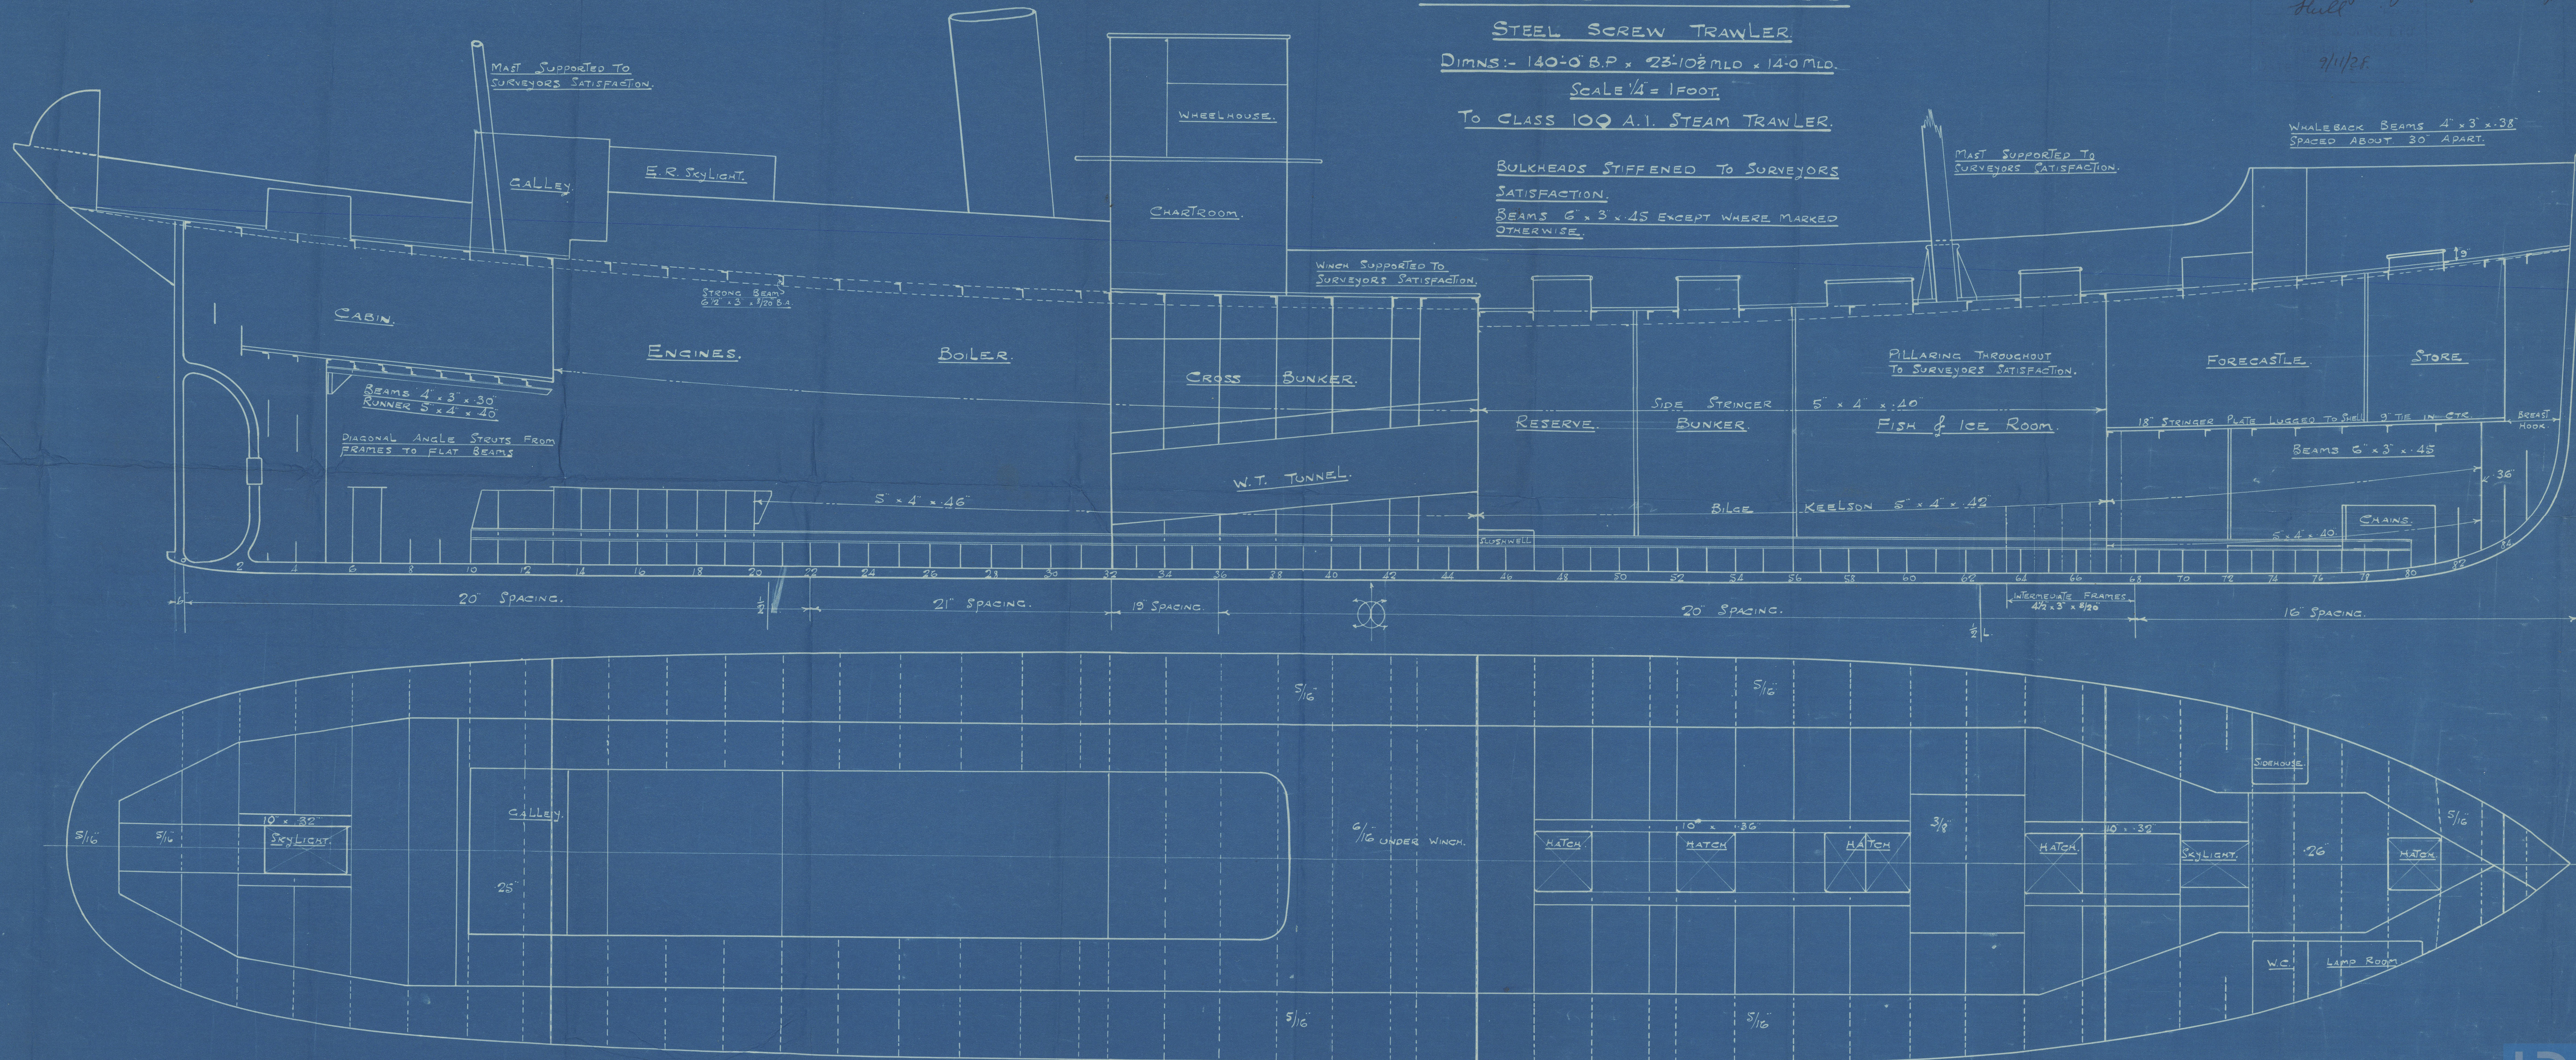



1028.

Profile & Deck.  
(as built).

Cochrane & Sons Ltd.

C.C.

Lord Grey

MINISTRY OF DEFENCE No.

39418.



© 2020

Lloyd's Register  
Foundation