

SEE ALSO TABLE 52A

RIVETING # RIVETS IN FRAMES EXCLUDED

DESCRIPTION	DIAM	ROWS	DISTANCE	BREADTH
SEAMS OF KEELSTRAKE	3/4"	#	7 RIVETS	115
SEAMS OF BOTTOMPLATING NOT EXCEEDING 9 1/4"	5/8"	#	8	57
SEAMS OF BOTTOMPLATING ABOVE 9 1/4"	3/4"	#	7	115
SEAMS OF SIDEPLATING NOT EXCEEDING 9 1/4"	5/8"	#	8	57
SEAMS OF SIDEPLATING ABOVE 9 1/4"	3/4"	#	7	65
SEAMS OF SHEERSTRAKE	3/4"	#	7	65
SEAMS OF BULWARK	5/8"	#	4 1/2 D	57
FRAMES WITH SIDEPLATING ABOVE 9 1/4"	3/4"	#	7 D	
FRAMES WITH SIDEPLATING NOT EXCEEDING 9 1/4"	5/8"	#	7 D	
FRAMES WITH SHELL IN WAY OF FLOTTANKS, PEAKS AND IN PAINTING AREA	5/8-3/4"	#	5 1/2 D	
BOTTOMFRAMES FORWARD 0.5L	3/4"	#	5 1/2 D	
" " IN WAY OF MOTORSEATING	5/8"	#	5 D	
" " WITH SHELL IN D.B. ELSEWHERE	5/8-3/4"	#	7 D	
" " WITH FLOORS	5/8"	#	7 D	
FORWARD 0.5L	5/8"	#	5 1/2 D	
REVERSED FRAMES TO FLOORS & INNERBOTTOM	5/8"	#	7 D	
BRACKET FLOORS WITH FRAME & REVERSED FRAME	3/4" 5 RIV	#	7 D	
SEAMS WITH MAIN AND RQ DECK (CROWN OF TANKS)	3/4-5/8"	#	7 D	
FRAMES WITH FLOORS FOREPEAK	5/8"	#	6 D	
" " AFTERPEAK	5/8"	#	5 D	
REVERSED FRAMES TO FLOORS	5/8"	#	7 D	
SHELL TO MARGIN PLATE	5/8-3/4"	#	4 1/2 D	
STRINGER ANGLE TO SHELL AND DECK (SLIGHTLY REELED)	3/4"	#	4 1/2 D	
BILGE KEEL TO FLAT IRON BAR	3/4"	#	5 D	
RAILING BAR TO BULWARK	5/8"	#	7 D	

ARC WELDING

DESCRIPTION	TYPE
W.T. & OT. FLOORS IN DOUBLE BOTTOM	5/8"
BILGE BRACKETS TO MARGIN PLATE (PAINTING)	3/4" 3/4"
SOLID & SKELETON FLOORS TO MARGIN PLATE (PAINTING IN WAY OF)	3/4" 3/4"
CENTRE GIRDER TO KEEL AND DOUBLE BOTTOM	4/8" 4/8"
FACE BARS OF WEBS	4/8" 4/8"
BULWARK STIFFENERS TO PLATING	3/8" 3/8"
COAMING STIFFENERS TO PLATING	4/8" 4/8"
100x10 BILGE KEELS TO SHELL	4/8" 4/8"
BUTTS OF DECK AND SHELL	PET. A
BUTTS AND SEAMS OF INNERBOTTOM	PET. A
INTERM. FRAMES 100x10 IN PAINT. REG.	4/8" 4/8"

RAISED QUARTERDECK COASTER.

MIDSHIP SECTION

CLASSED LLOYDS * 100 A 1.

PRINCIPAL DIMENSIONS.

LENGTH OVER ALL	66.05 M ⁸ = 218' 10"
LENGTH BETWEEN PERP.	60.85 M ⁸ = 199' 8 1/4"
BREADTH MOULDED	10.06 M ⁸ = 33' 0"
DEPTH TO MAINDECK	4.595 M ⁸ = 15' 1"
DEPTH TO R.Q. DECK	5.71 M ⁸ = 18' 8 3/4"
DRAFT	4.362 M ⁸ = 14' 3 3/4"

L = 60.80. B = 10.06. D_{HD} = 4.595 D_{RQ} = 5.71
h_{HD} = 3.72 h_{RQ} = 4.835 d = 4.362
d/D_{HD} = 0.95 d/D_{RQ} = 0.764


EQUIPMENT NUMERALS

L(B+D) = 60.80 (10.06 + 4.595) =	891.82
RQ DECK 1856 x 1.115 =	20.69
POOP 0.75 x 17.25 x 2.13 =	27.36
FORECASTLE 0.75 x 8.75 x 2.13 =	13.98
DECKHOUSE POOP 0.5 x 12.18 x 2.13 =	12.97
CAPT. DECKHOUSE 0.5 x 4.5 x 2.13 =	4.79
WHEELHOUSE 0.5 x 4.5 x 2.13 =	4.79
CASING 0.5 x 4.6 x 1.40 =	3.22

EM = 979.82
LETTER L

WEBFRAMES
N⁸ 35, 39, 43, 47, 51, 54

CANTILEVER BRACKETS
N⁸ 70-74, 78-82, 85-89.

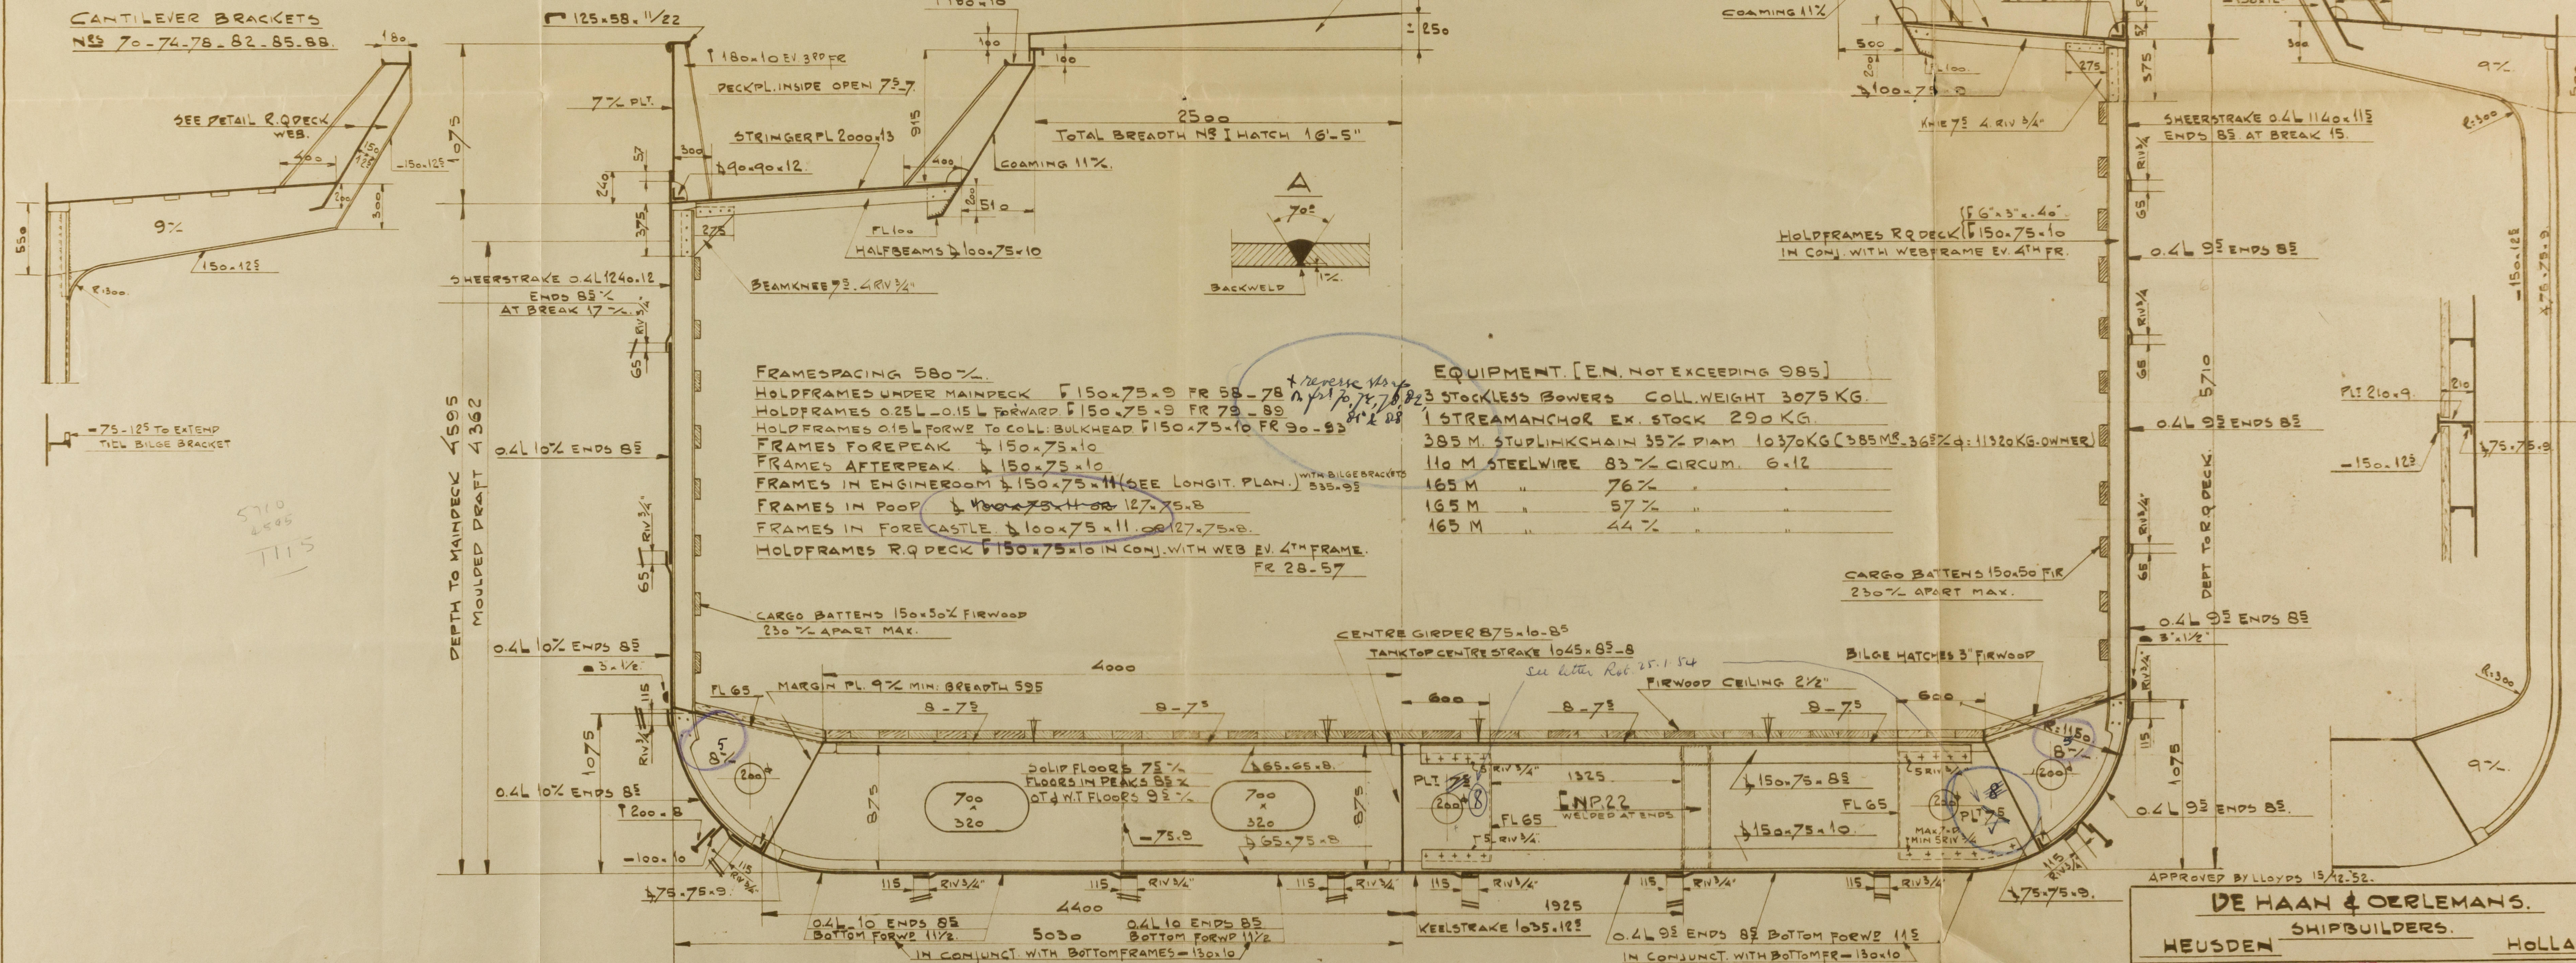

EQUIPMENT. [EN. NOT EXCEEDING 985]

1 STOCKLESS BOWERS	COLL. WEIGHT 3075 KG.
1 STREAMANCHOR EX. STOCK	290 KG.
385 M. STUPLINKCHAIN 35% DIAM.	10370 KG (385 M ⁸ 36% DIAM. 11320 KG. OWNER)
110 M STEELWIRE	83% CIRCUM. 6.12
165 M	76%
165 M	75%
165 M	44%

CARGO BATTENS 150x50x4 FIR
230% APART MAX.

BILGE HATCHES 3' FIRWOOD

FIRWOOD CEILING 2 1/2"

MARGIN PL. 9% MIN. BREADTH 595

SOLID FLOORS 75% FLOORS IN PEAKS 85% OT & NT FLOORS 93%

CENTRE GIRDER 875x10-85

TANKTOP CENTRE STRAKE 1045x85-8

DEPT. TO R.Q. DECK 5.71

DEPT. TO MAINDECK 4.595

MOULDED DRAFT 4.362

RAISED QUARTERDECK COASTER

MIDSHIP SECTION

CLASSED LLOYDS * 100 A 1.

DE HAAN & OERLEMANS.

SHIPBUILDERS.

HOLLAND.

HEUSDEN

BELONGS TO ROTTERDAM REPORT No. 36293

BELONGS TO ROTTERDAM REPORT No. 37184

MIDSHIP SECTION.

Plan as built © 2020

YARD No. 274

SCALE 1:25

DRAWING No. 274-03





0000 117000 191700

Midship
section.

★ LISBETH 17.

RECORDED
LONDON

2

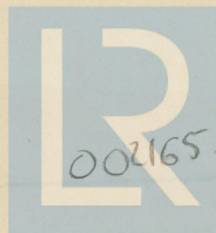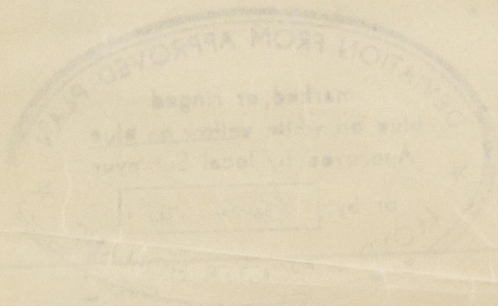

© 2020

Lloyd's Register
Foundation