



SINGLE SCREW CARGO VESSEL YARD No 189.

PROFILE AND DECK.

DIMS: 165'0" 32'6" x 13'6"

SCALE: 1/4" = 1'0"


TO CLASS LLOYDS 100 A1

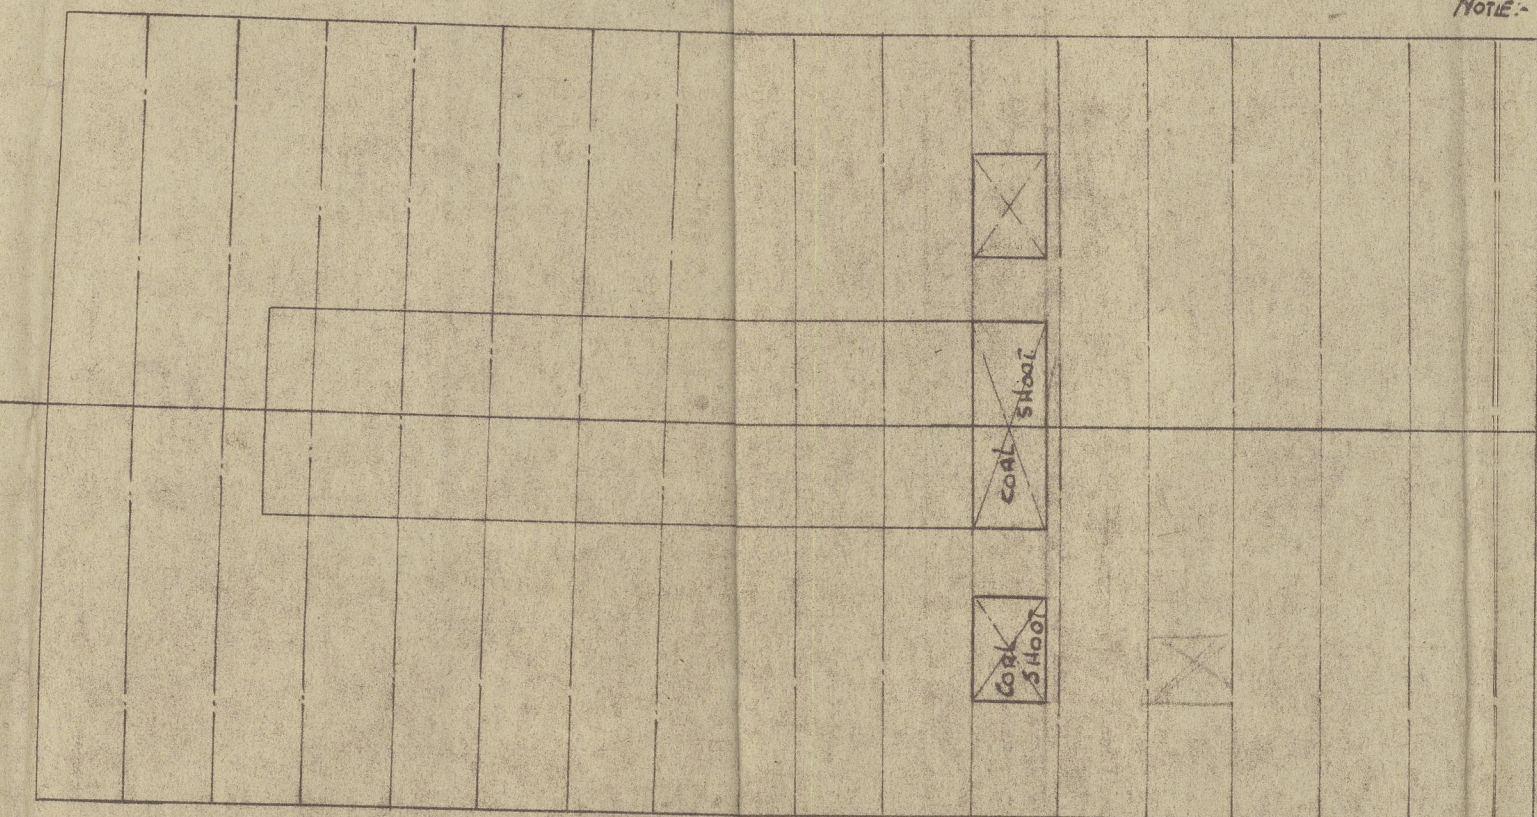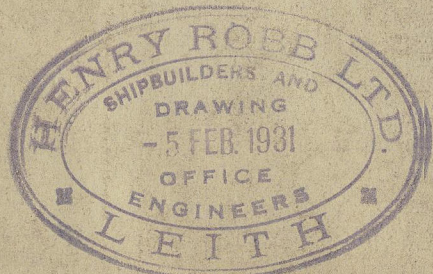

NOTE: FOR HOLD PILLARS SEE 'SEPARATE PLAN' to be Submitted

Particular arrangements and Strengthening of bottom forward to be Submitted

18'0" L  
5'2" L  
12'8" L

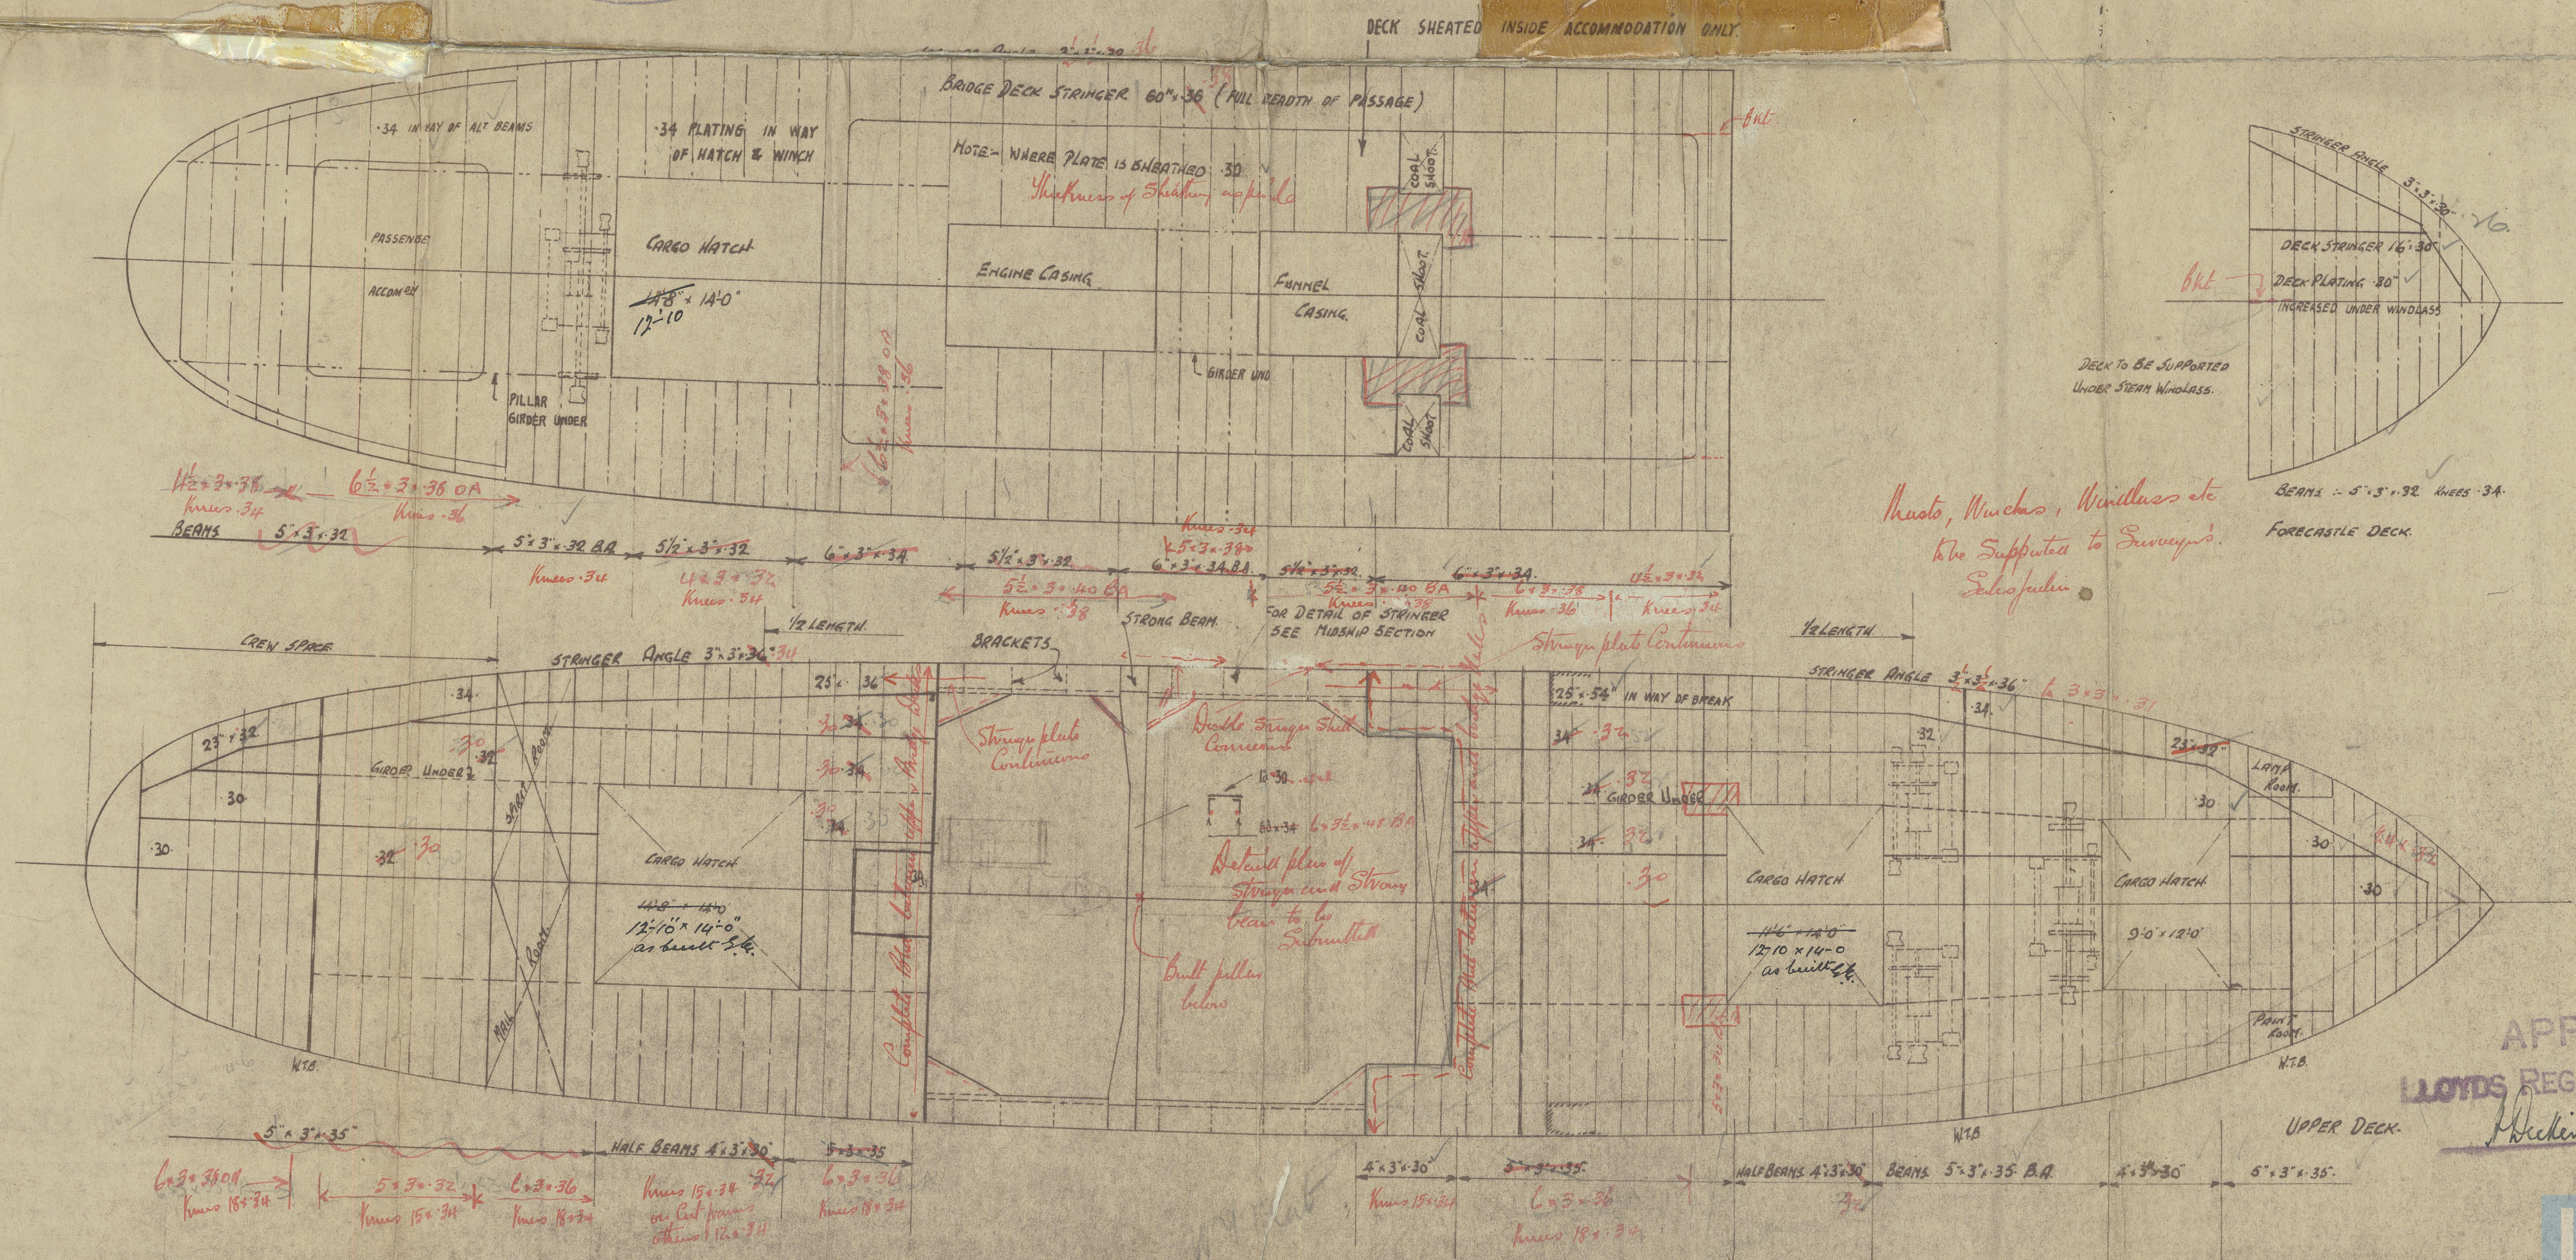

APPROVED  
LLOYDS REGISTER OF SHIPPING

9.2.31.



© 2021  
Lloyd's Register  
Foundation

002222-002228-0002



Muss HENRY ROBB L<sup>d</sup>  
N<sup>o</sup> 189

---

PROFILE + DECK

(see also Plan of "Bridge Deck"  
also plan of "Upper D<sup>m</sup> + Lower Turret  
Forward" showing these as built.)

Fitzroy

S.S. "Lafonia"

Lth. Rpt. 18070.

002222-002228-0002

© 2021

Lloyd's Register  
Foundation