

SCALE $\frac{1}{2}'' = \text{ONE FOOT.}$

DIMENSIONS :- LENGTH B.P. 167'-0"


SCALE $\frac{1}{2}$ " = ONE FOOT.

DIMENSIONS :- LENGTH B.P. 167'-0"


BREADTH MLD. 25'-6"

DEPTH MLD. 12'-1"


1ST MARCH 1932

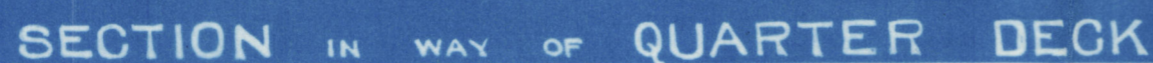


SECTION IN WAY OF UPPER DECK.

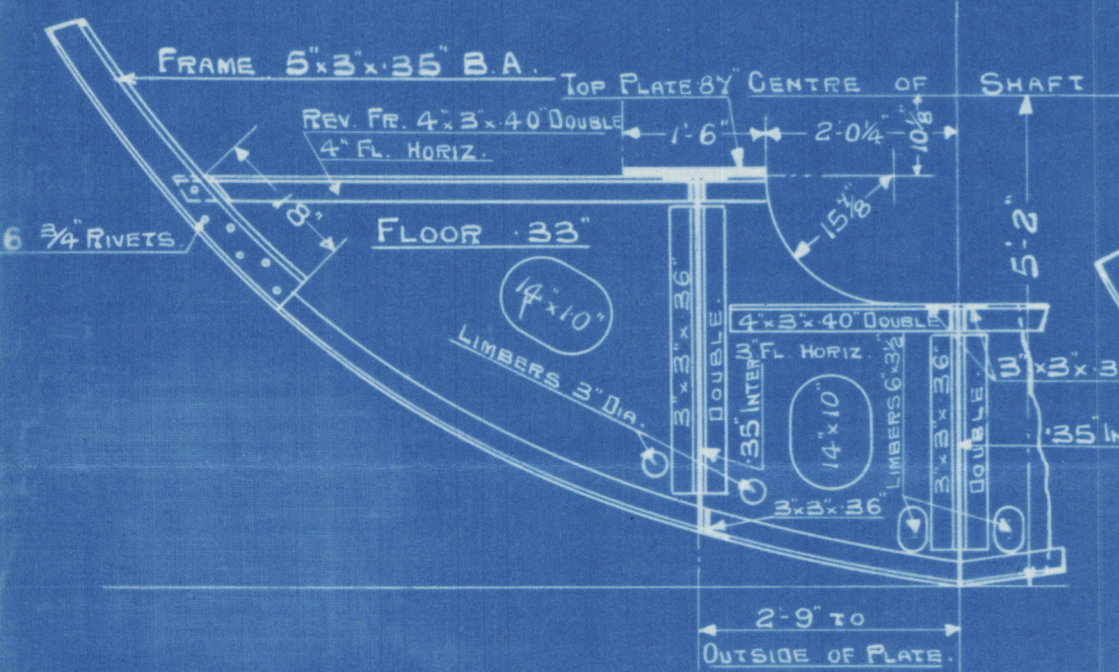


SECTION THRO' ENGINE FLOOR.

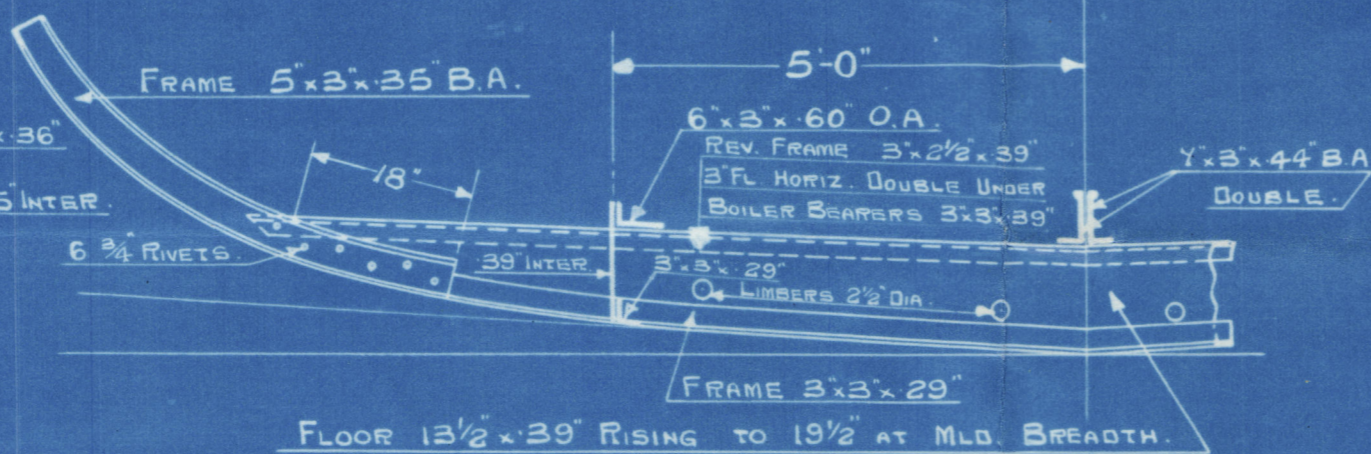

SECTION THRO' BOILER FLOOR.

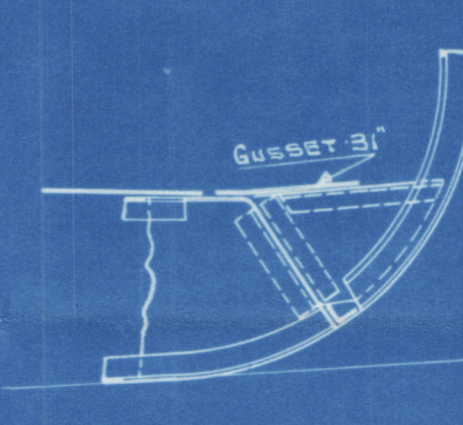

GUSSET PLATES
ON ALTERNATE FRAMES

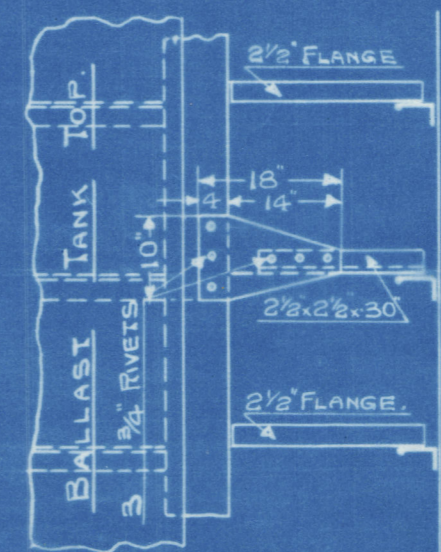

S/S. ROWAN

SCOTT & SONS No 321

MIDSHIP SECTION
(AS BUILT)

GLASGOW REPORT No. 52181



© 2020

Lloyd's Register
Foundation

002330-002334-0038