




PROFILE AND DECKS S.S. "ARABIAN — PRINCE".

MASTS, WINCHES, WINDLASS, DECK HOUSES ETC.,
SUPPORTED TO SURVEYORS AND OWNERS
SATISFACTION.

SCALE 1/8" = 1 FOOT.

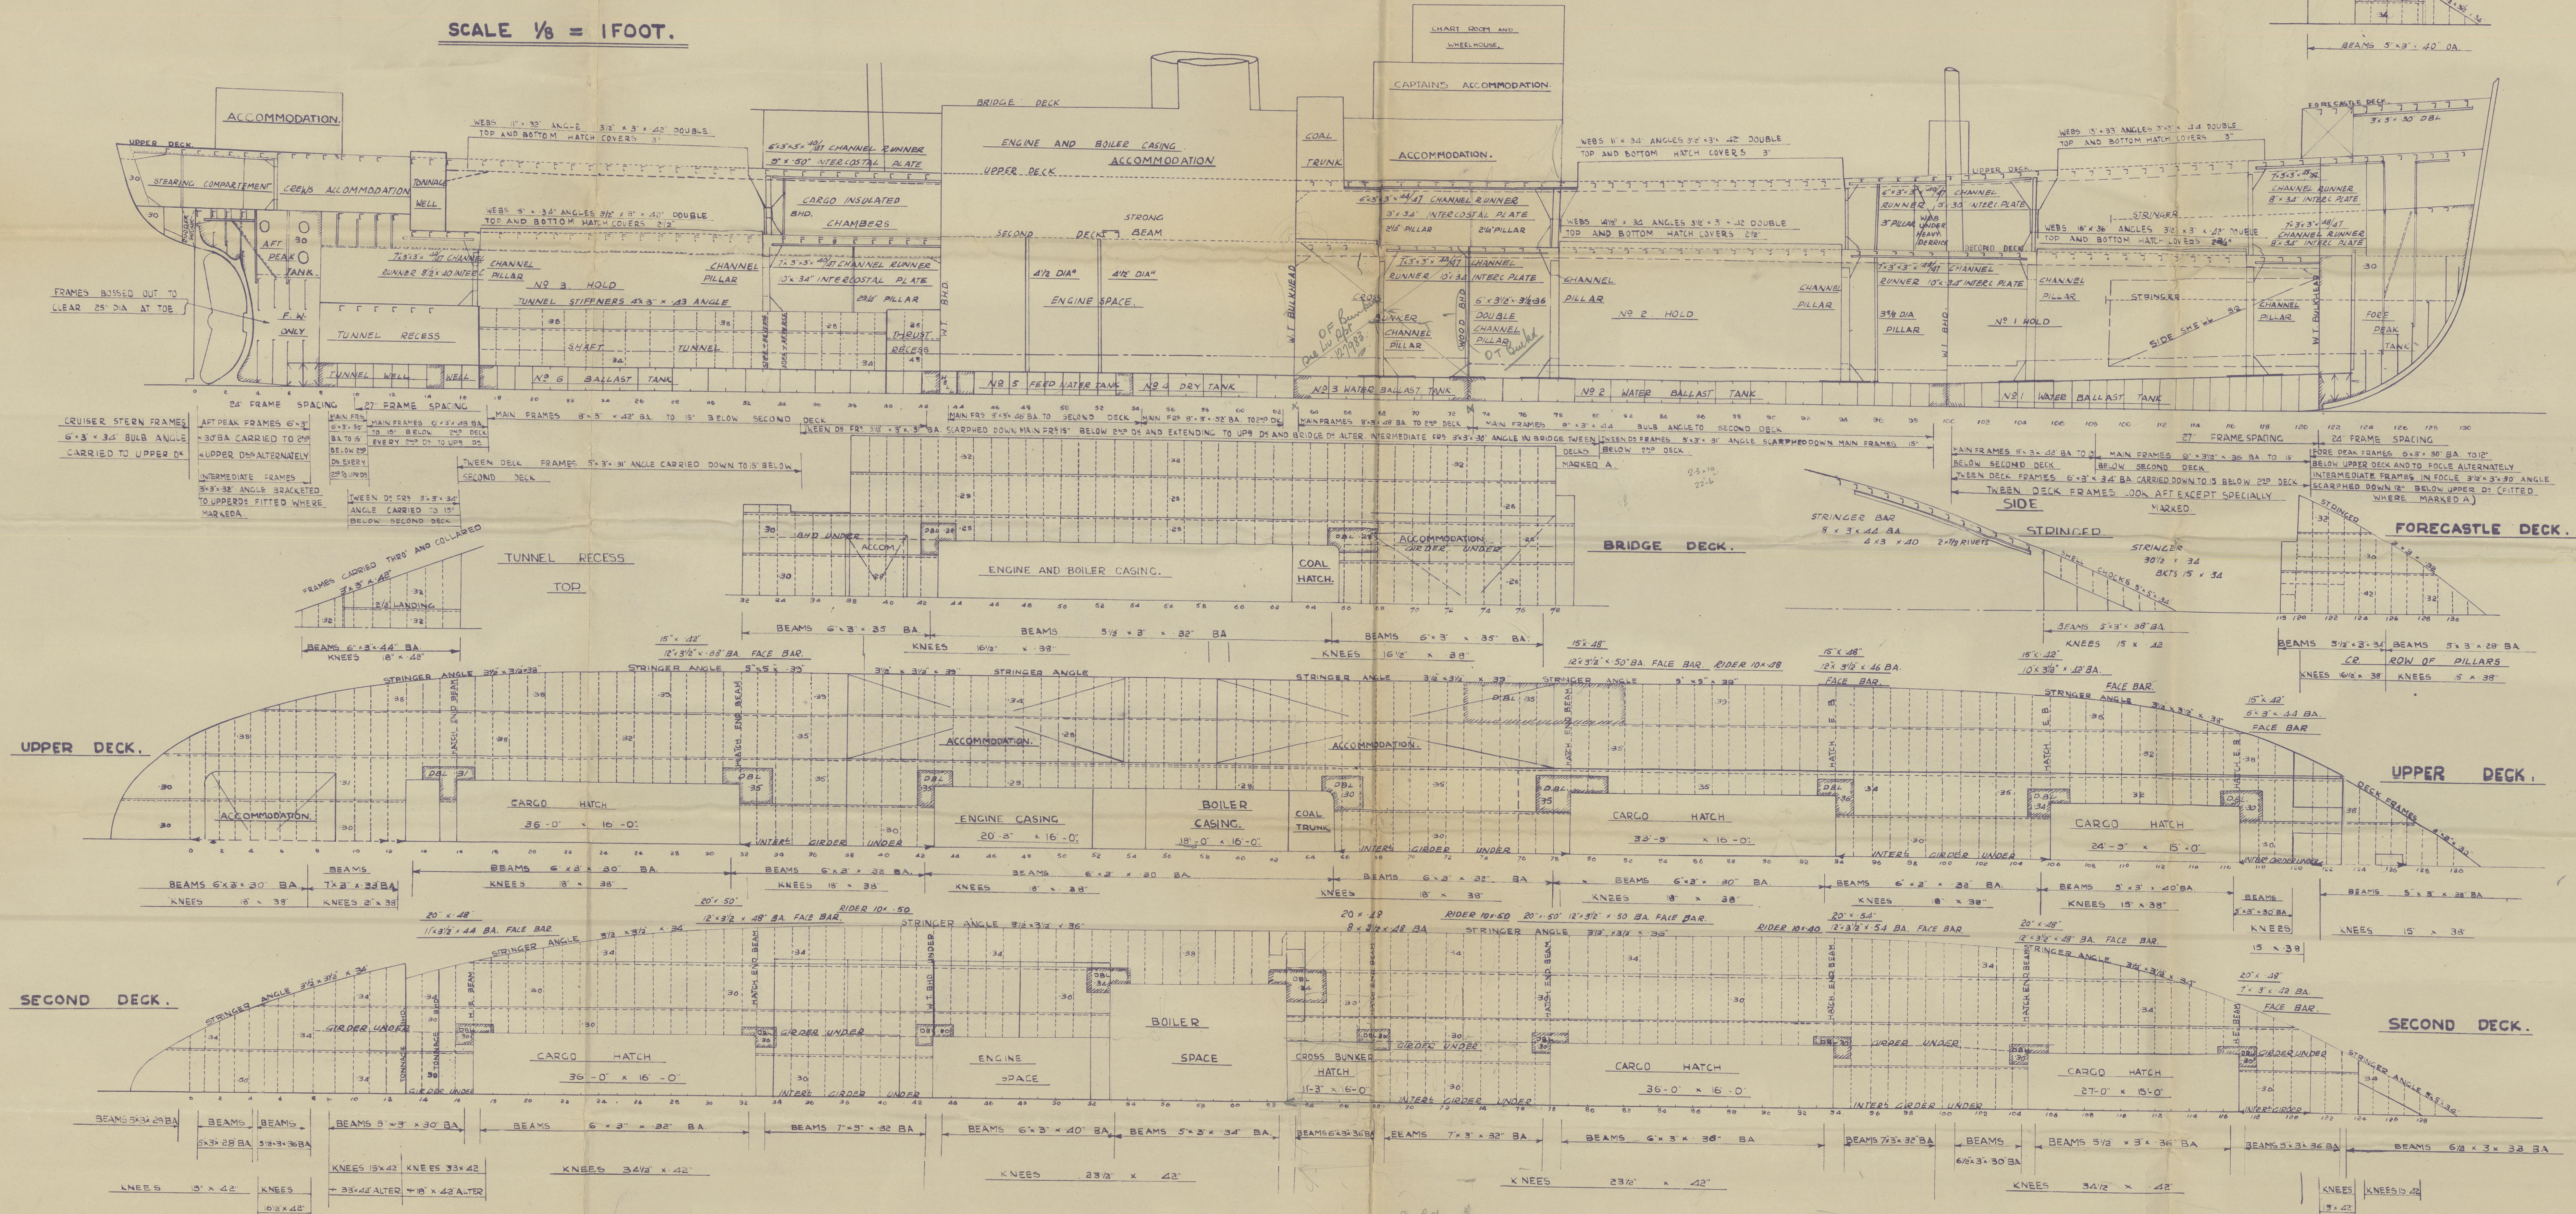


W^m Hamilton & Co^{rs} L^{ds}

W 425.

'ARABIAN PRINCE'

Gr. 1st L. R. N. 20244.

Project & O.K. plans
as Built.

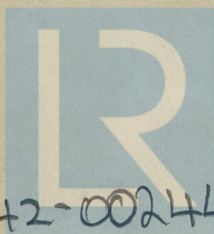

© 2021

Lloyd's Register
Foundation

002442-002448-0060