

MIDSHIP SECTION.

STEEL SCREW TRAWLER.

No 1154.

151'-8" B.P. x 25'-6" MLD. x 14'-6" MLD.
TO CLASS 100.A.1-STEAM TRAWLER.

SCALE $\frac{1}{2}$ " = 1 FOOT.

NUMERALS.

L x D ----- 2199

L x (B+D) ----- 6066

EQUIPMENT.

1ST BOWER ANCHOR $8\frac{3}{4}$ CWTs - STOCKLESS

2ND " " $8\frac{3}{4}$ " " "

KEDGE ANCHOR. $3\frac{1}{2}$ " EX STOCK.

120 FMS $1\frac{1}{8}$ " STUD LINK CABLE.

60 " 6" HAWSER.

60 " $5\frac{1}{2}$ " WARP.


RIVETING

ALL SHELL LANDINGS TO BE DOUBLE RIVETED EXCEPT TOP EDGE OF SHEER STRAKE, WHICH IS TO BE SINGLE RIVETED.

BUTTS OF GARBOARD AND SHEER STRAKE TO BE STRAPPED AND TREBLE RIVETED FOR $\frac{1}{2}$ LENGTH, STRAPPED AND DOUBLE RIVETED AT ENDS.

BUTTS OF E AND F STRAKES OVERLAPPED AND TREBLE RIVETED FOR $\frac{1}{2}$ LENGTH - OVERLAPPED AND DOUBLE RIVETED AT ENDS.

REMAINDER OF SHELL BUTTS OVERLAPPED AND DOUBLE RIVETED ALL FORE AND AFT. SHELL RIVETS TO BE STEEL, OTHERS IRON.

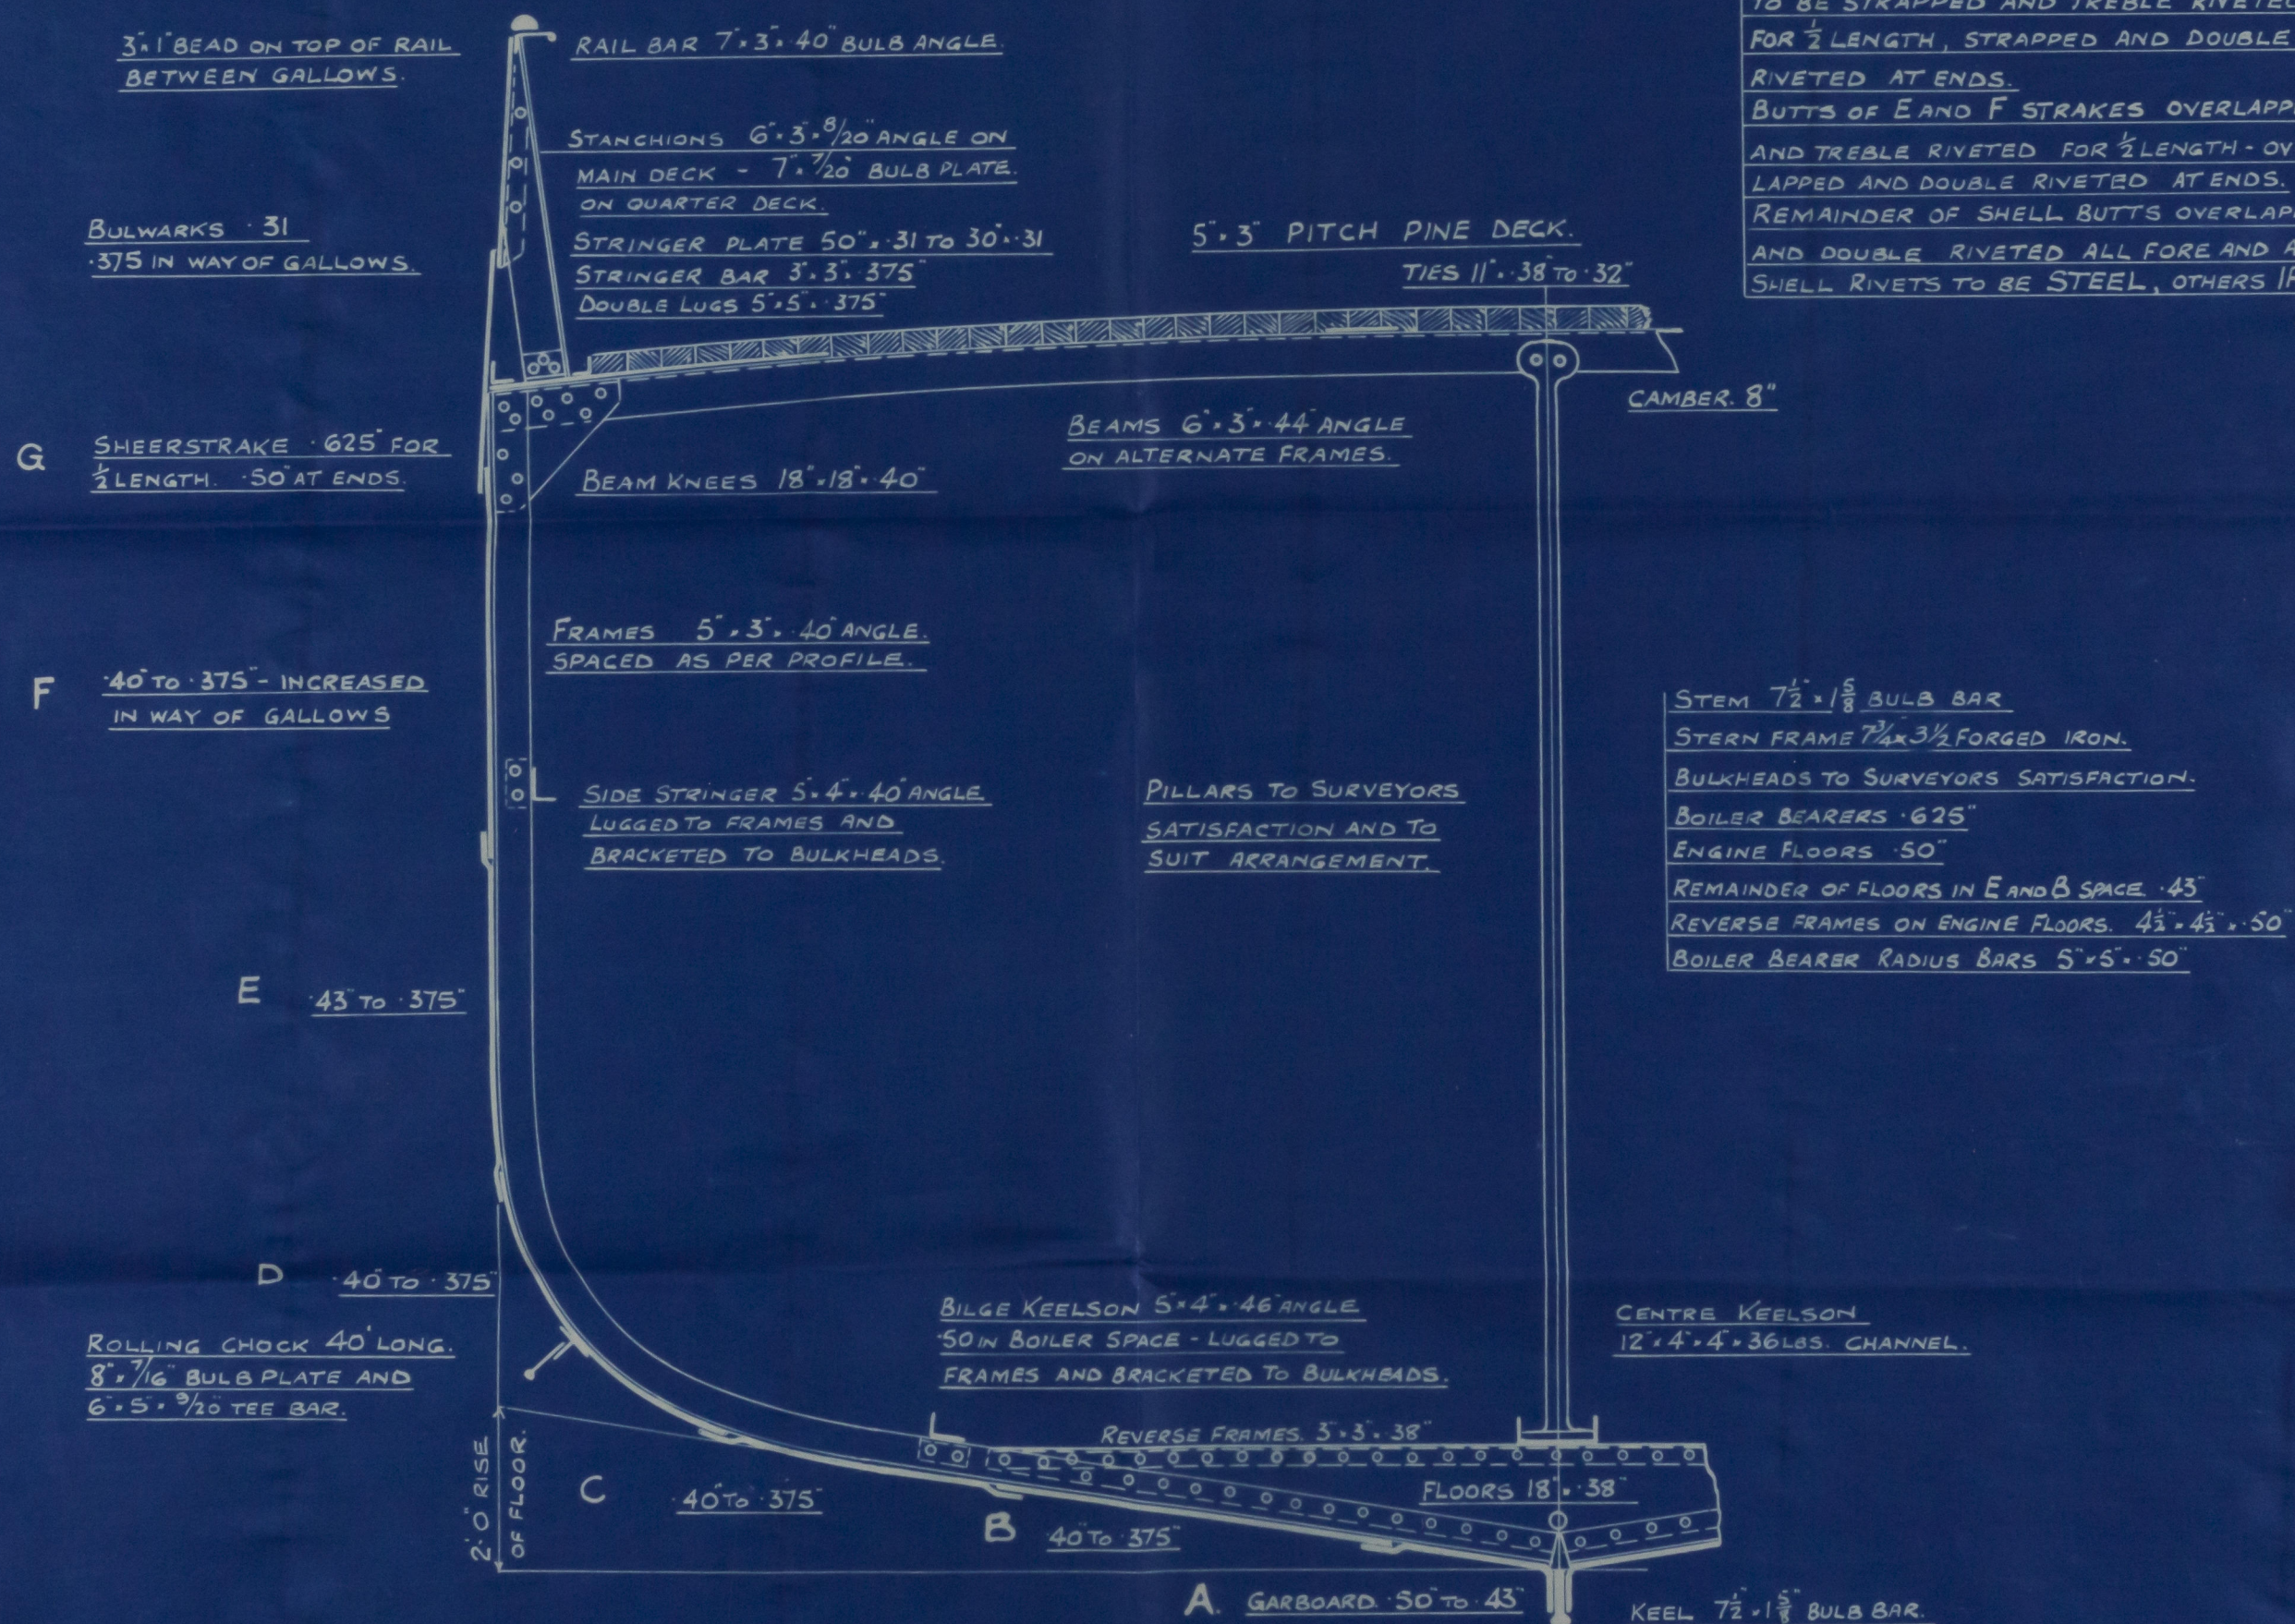

© 2020 Lloyd's Register Foundation

1152
as built

002674-002681-0002

PLAN NO. 4098
FOR ENCLOSURE TO
Lloyd's Register of Shipping
FROM
COCHRANE & SONS, LTD.
SHIPBUILDERS, SELBY.
DATE 17/4/36

N^o 7154
Midship Section
(as built)
Cochranes Sons Ltd

S.S. K "Admiral Drake"
HULL NO. 46439



© 2020
Lloyd's Register
Foundation

002674-002681-0002

MIDSHIP SECTION
VIA