




POOP DECK.

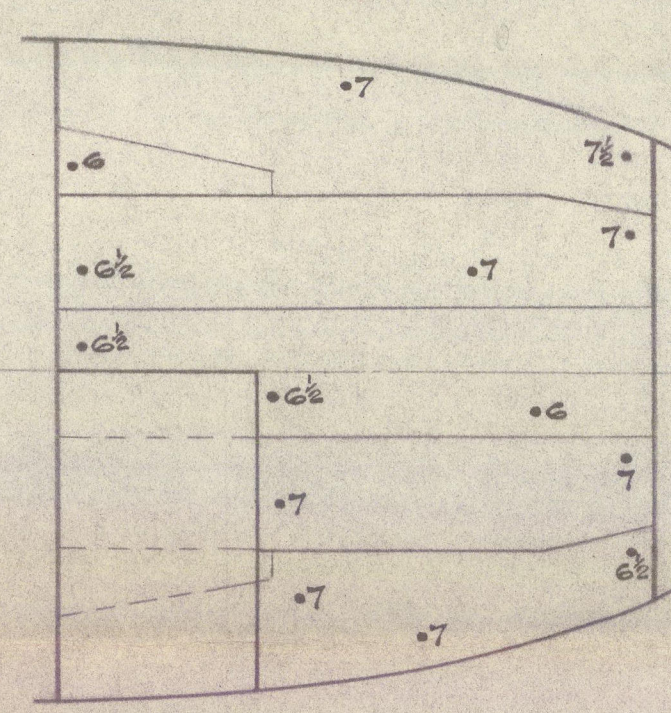


DEEP TANK - TOP

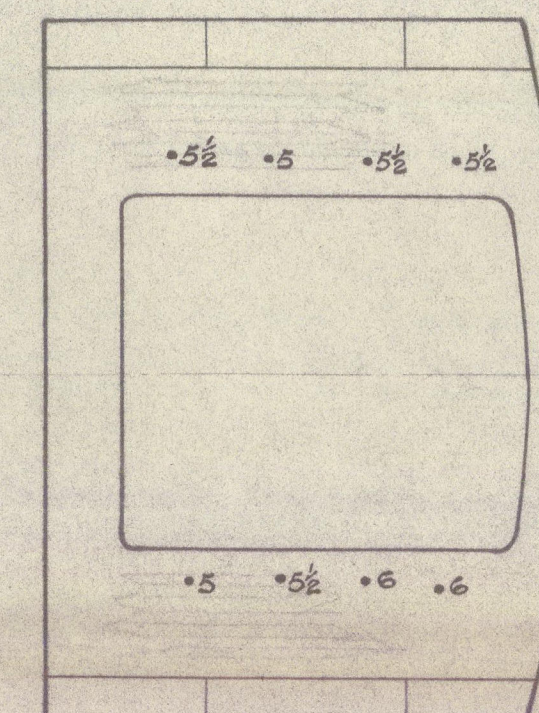

UPPER BRIDGE DECK

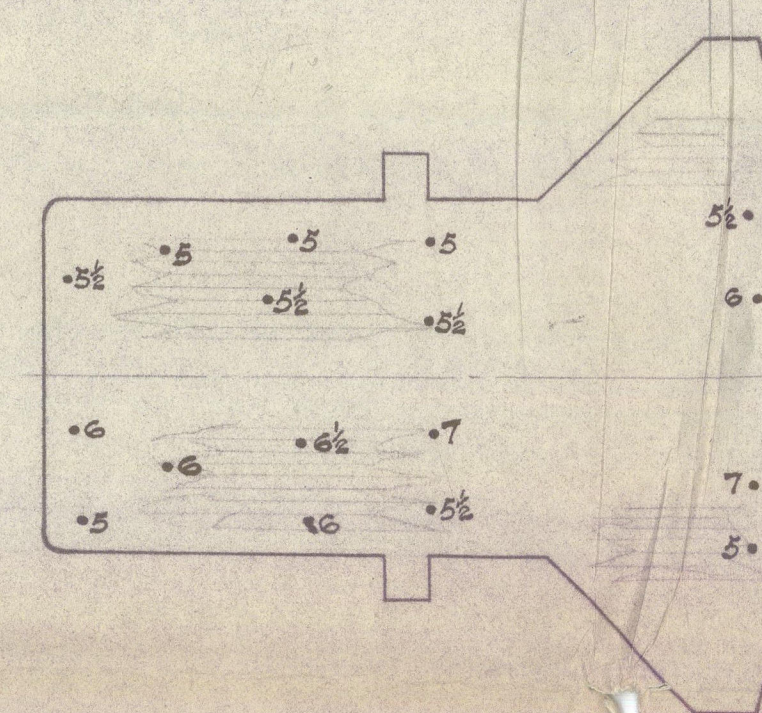

MONKEY ISLAND.

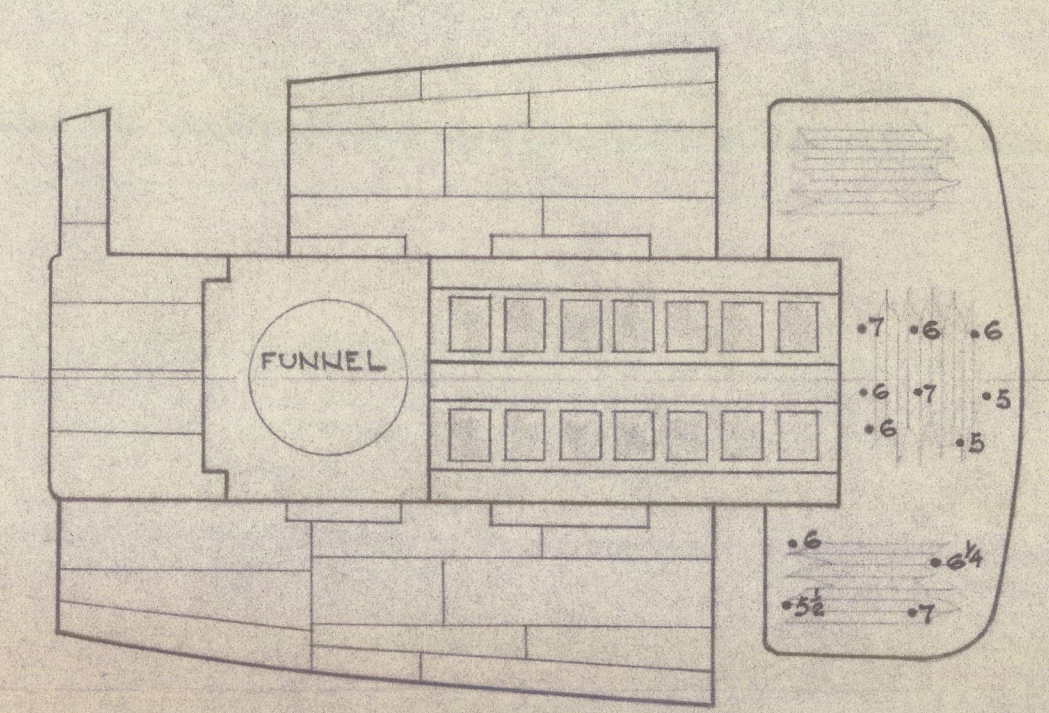

BOAT - DECK.

NOTE:-

ALL TEST HOLE THICKNESSES ARE MARKED IN TWENTIETHS OF AN INCH
 NEW DOUBLERS SHOWN THUS
 PLATE PARTLY RENEWED SHOWN THUS
 NEW RIVETS SHOWN THUS

Renewal & doubling shown in red.

: Renewal
 : Doubling

COPY FOR
 SHELL TANKERS LTD.
 COPIES SENT TO
 SHELL TANKERS LTD.
 (LLOYD'S SURVEYORS)

Q.	Ref.	Item.	SINGAPORE HARBOUR BOARD, SINGAPORE SHIPBUILDERS, ENGINEERS & BOILERMAKERS.	SCALE N.T.S. DRAWN Y.K.KOH. TRACED CHECKED DATE 26/2/60. DRG NO. R/1456
		'CORILLA'		
		TEST HOLES IN SHELL, AND IN DECKS.		

See letter

Office

Foundation

4
"CORILLA"

for attachment to App. 13721
see letter dtd 16/3/60



Test holes in Shell & Deck.

CHC



© 2020

Lloyd's Register
Foundation

002674-002681-6051