

24/11 4/5/17

EQUIPMENT NO 5386-25 (LETTER C)

- 1 STOCKLESS BOWER ANCHOR 8 1/4 CMTS AND 1 DO. 8 CMT.
- 1 STREAM ANCHOR 2 3/4 CMT EX STOCK
- 1 KEDGE ANCHOR 1 CMT. EX STOCK
- 165 FATHOMS 5/16" STUD CHAIN CABLE
- 45 FATHOMS 2 1/4" STEEL WIRE
- 75 FATHOMS 2 1/2" STEEL WIRE TOWLINE
- 90 FATHOMS 5" HAWSER

LONGITUDINAL NUMBER	4893.75	LONGITUDINAL NUMBER	4556
RAISED QUARTER DECK	171.5	RAISED QUARTER DECK	173.25
BRIDGE DECK	55.125	BRIDGE DECK	51.57
FORECASTLE	115.875	FORECASTLE	129.19
CASING	150.0	CASINGS	151.50
EQUIPMENT NUMBER	5386.25	EQUIPMENT NUMBER	5061.51

SS NO 24


14.5 FT.
135 FT. x 23 FT. x 10'-9" MLD

CLASS 100A1

BRIDGE DECK
BEAMS 4 1/2" x 3" x 30 ALT. KNEES 11" x 30"
STRINGER PLATE 25" x 1/4"
TIE PLATES 6" x 1/4"
STRINGER ANGLE 2 1/2" x 2 1/2" x 25"
WATERWAY ANGLES 2 1/2" x 2 1/2" x 25"
WOOD DECK 5" x 2 1/2" RICH PINE

NUMERALS	TRANSVERSE NUMBER (B+D)	33.75
LONGITUDINAL	L(B+D)	4556
d (MAIN DECK)	9.5	d (QUARTER DECK) 15.0
b (MAIN DECK)	12.5	b (QUARTER DECK) 9.4

NUMERALS	TRANSVERSE NUMBER (B+D)	33.75
LONGITUDINAL	L(B+D)	4893.75
d (MAIN DECK)	9.5	d (QUARTER DECK) 13.0
b (MAIN DECK)	13.48	b (QUARTER DECK) 10.17

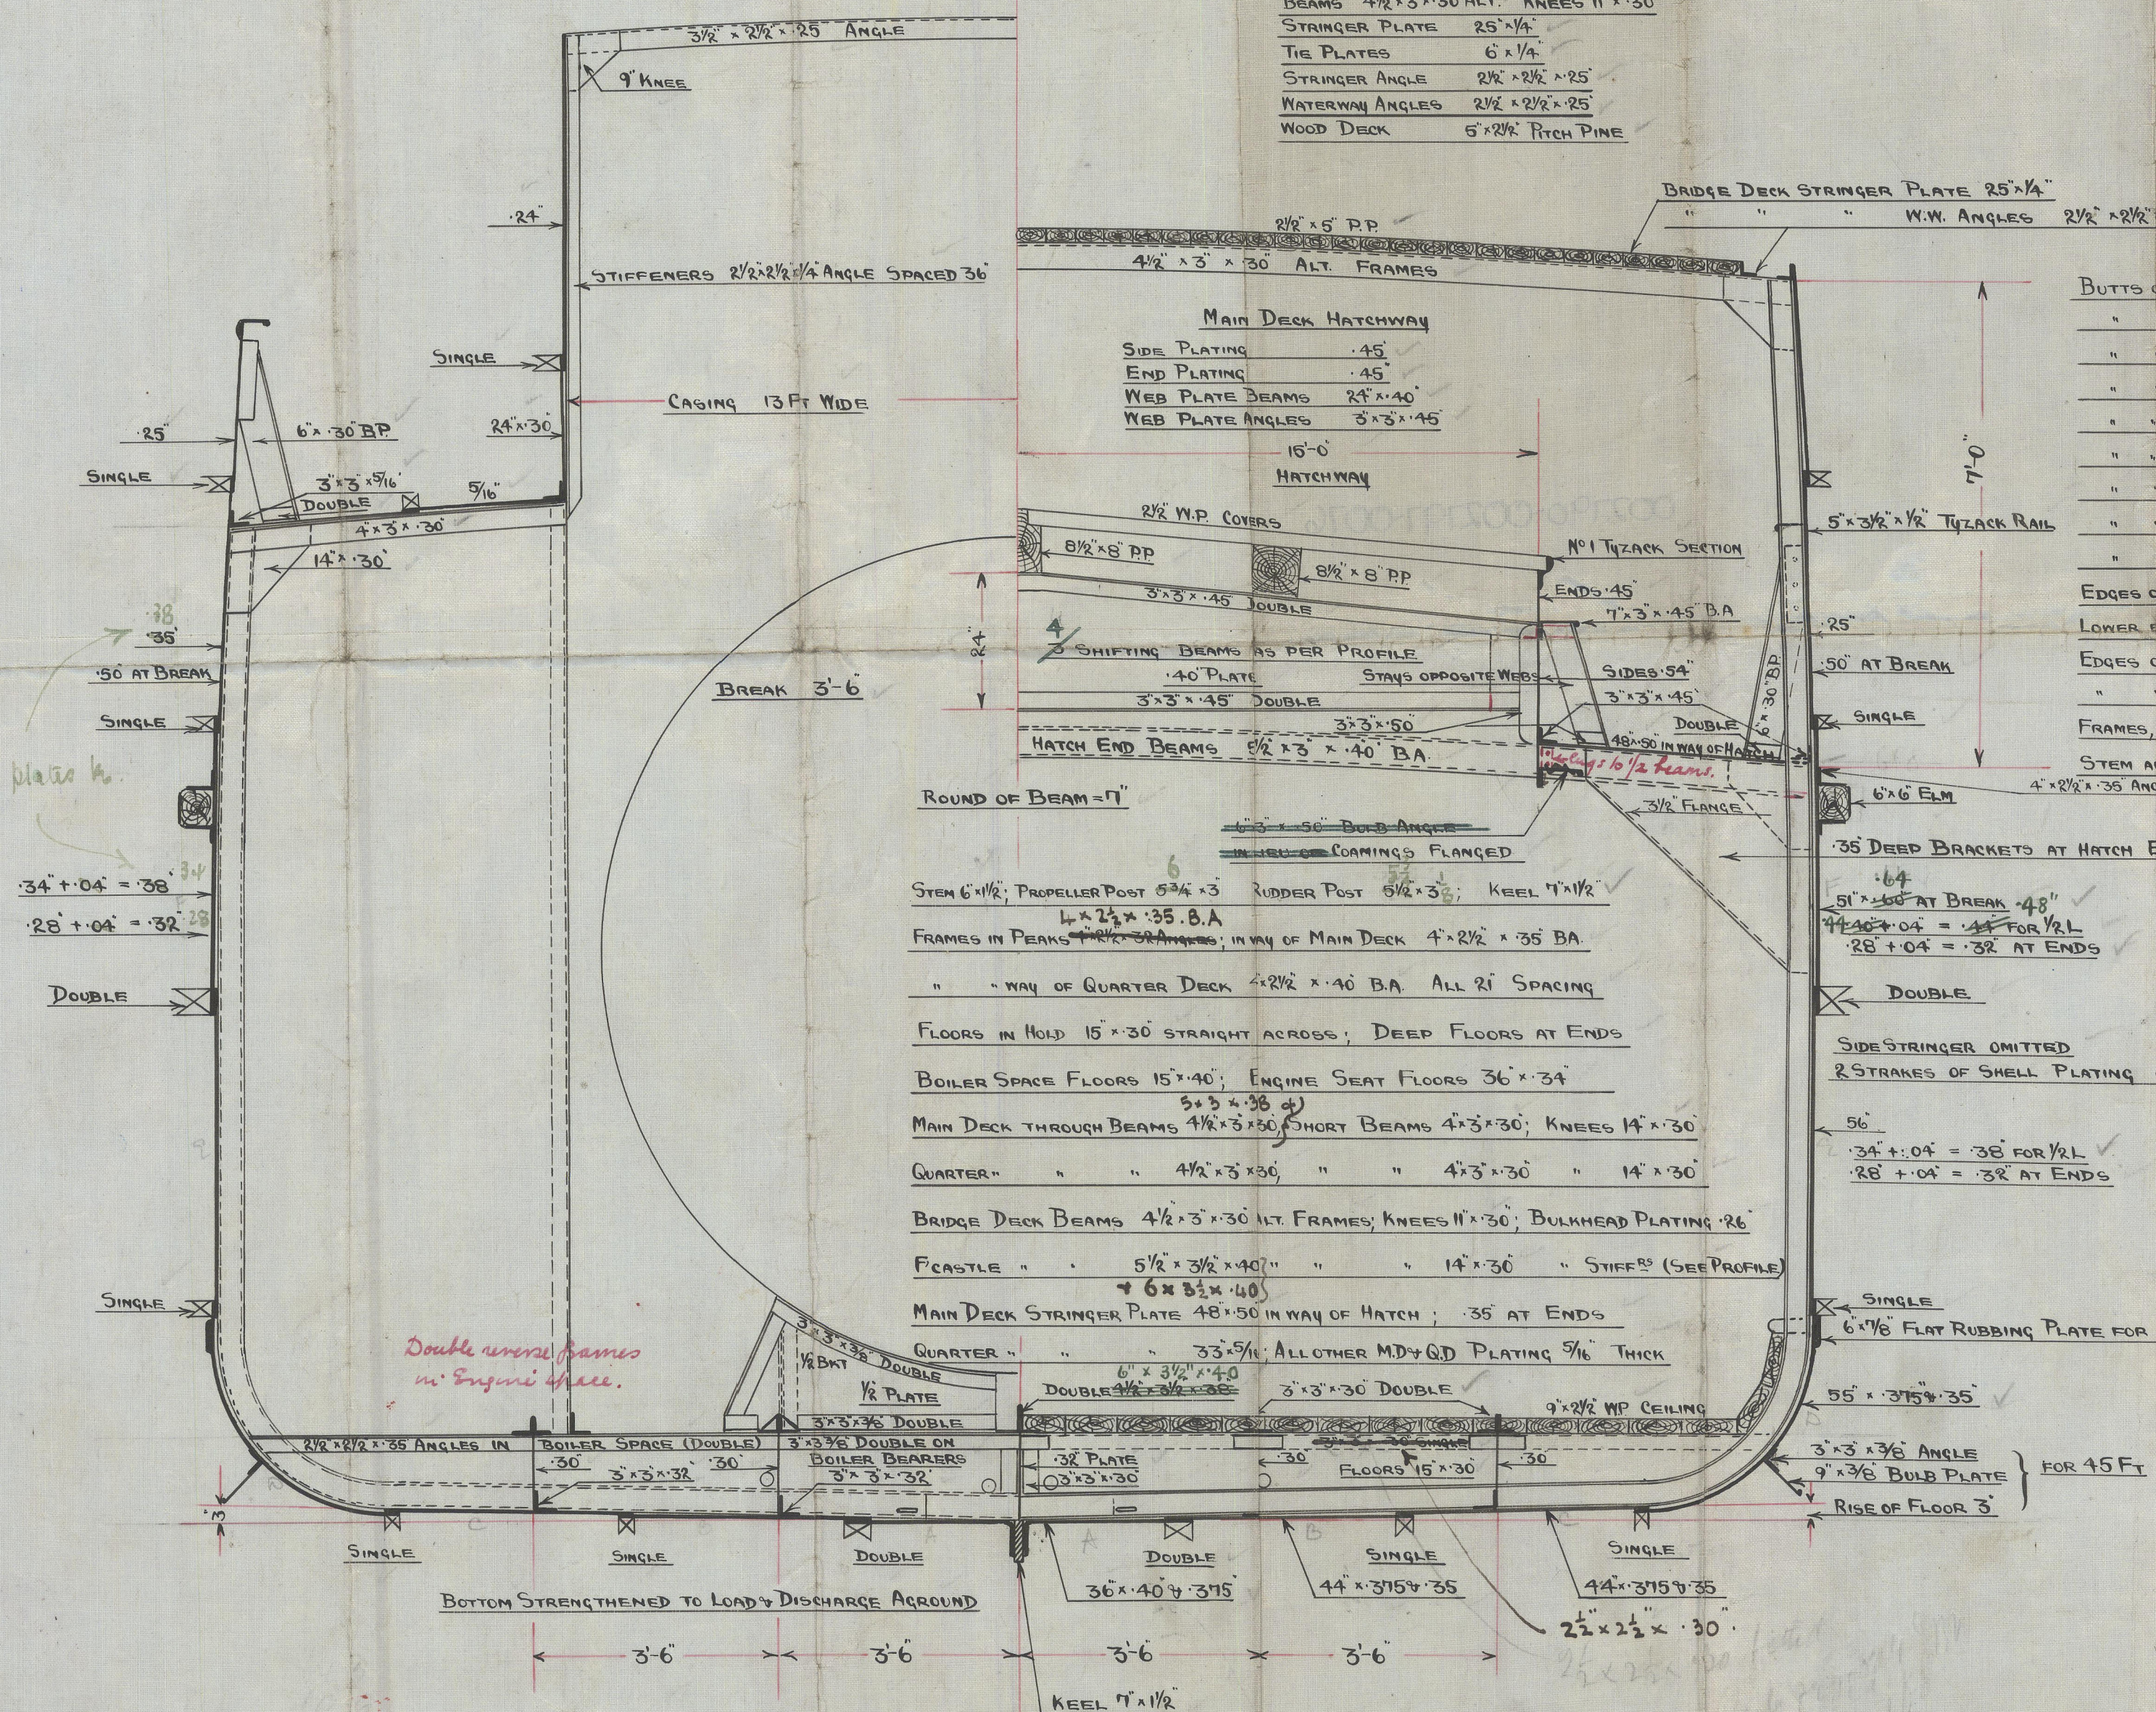

RIVETING	
BUTTS OF GARBOARD STRAKE	TREBLE RIVETED 3/4 RIVETS
" " " "	AT ENDS DOUBLE RIVETED 3/4 RIVETS
" " " "	MAIN DECK SHEERSTRAKE TREBLE RIVETED FOR 1/2 L 3/4 RIVETS
" " " "	DOUBLE RIVETED AT ENDS 3/4 RIVETS
" " " "	OTHER SHELL PLATING DOUBLE RIVETED THROUGHOUT 3/4 RIVETS
" " " "	BULWARKS AND FORECASTLE SIDE PLATING SINGLE 3/4 RIVETS
" " " "	MAIN DECK STRINGER PLATE IN WAY OF HATCH TREBLE RIVETED 3/4 RIVETS
" " " "	OTHER " " " " DOUBLE RIVETED 3/4 RIVETS
" " " "	DECK PLATING THROUGHOUT " " 3/4 RIVETS
EDGES OF GARBOARD PLATES	DOUBLE RIVETED 3/4 RIVETS
LOWER EDGE OF MD SHEERSTRAKE	DOUBLE 3/4 RIVETS
EDGES OF OTHER SHELL PLATING	SINGLE 3/4 RIVETS
" " " "	DECK PLATING " " 3/4 RIVETS
FRAMES, FLOORS, REVERSE BARS, BEAMS, KEELSONS ETC.	ALL 3/4 RIVETS
STEM AND STERNPOST AND KEEL	1" RIVETS

Amendment in green
29.8.19. JW

As built
in blue



A. JEFFREY & CO. LTD.
SHIPBUILDERS
20/4/11 ALLOA

MIDSHIP SECTION
14.5 FT.
SS 135 FT. x 23 FT. x 10'-9" MLD
SCALE - 1/2" = 1 FT.

002790-002797-0076

S. S. N: 24

Midship Section

Mem A. Jeffery & Co
Alloa.

S. S. "Finny"
(as built.)

No.
40134

© 2020

002790-002797-0076
Lloyd's Register
Foundation