

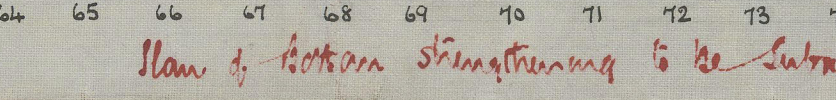


1.1. "Tuning"
 (a) will)

1700-170500-00

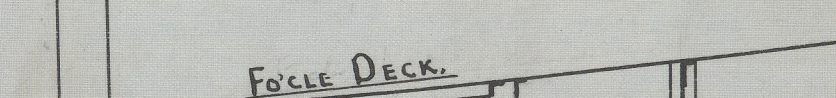

Jan 9.8.19

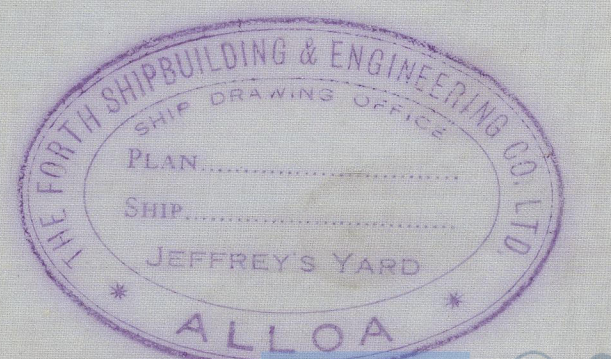

№ 24.

Forth S/B or long co LD (Jeffreys)
Profile & deck plan.

S. S. "Finney"
(as built)

GLASGOW REPORT No. 40134

002790-002797-0077