



ELEANOR BROOKE - N°346.

ELIZABETH LYSAGHT - N°347.

SYLVIA BEALE - N°348.

PROFILE & DECKS.

SCALE $\frac{1}{8}" = 1 \text{ FOOT.}$

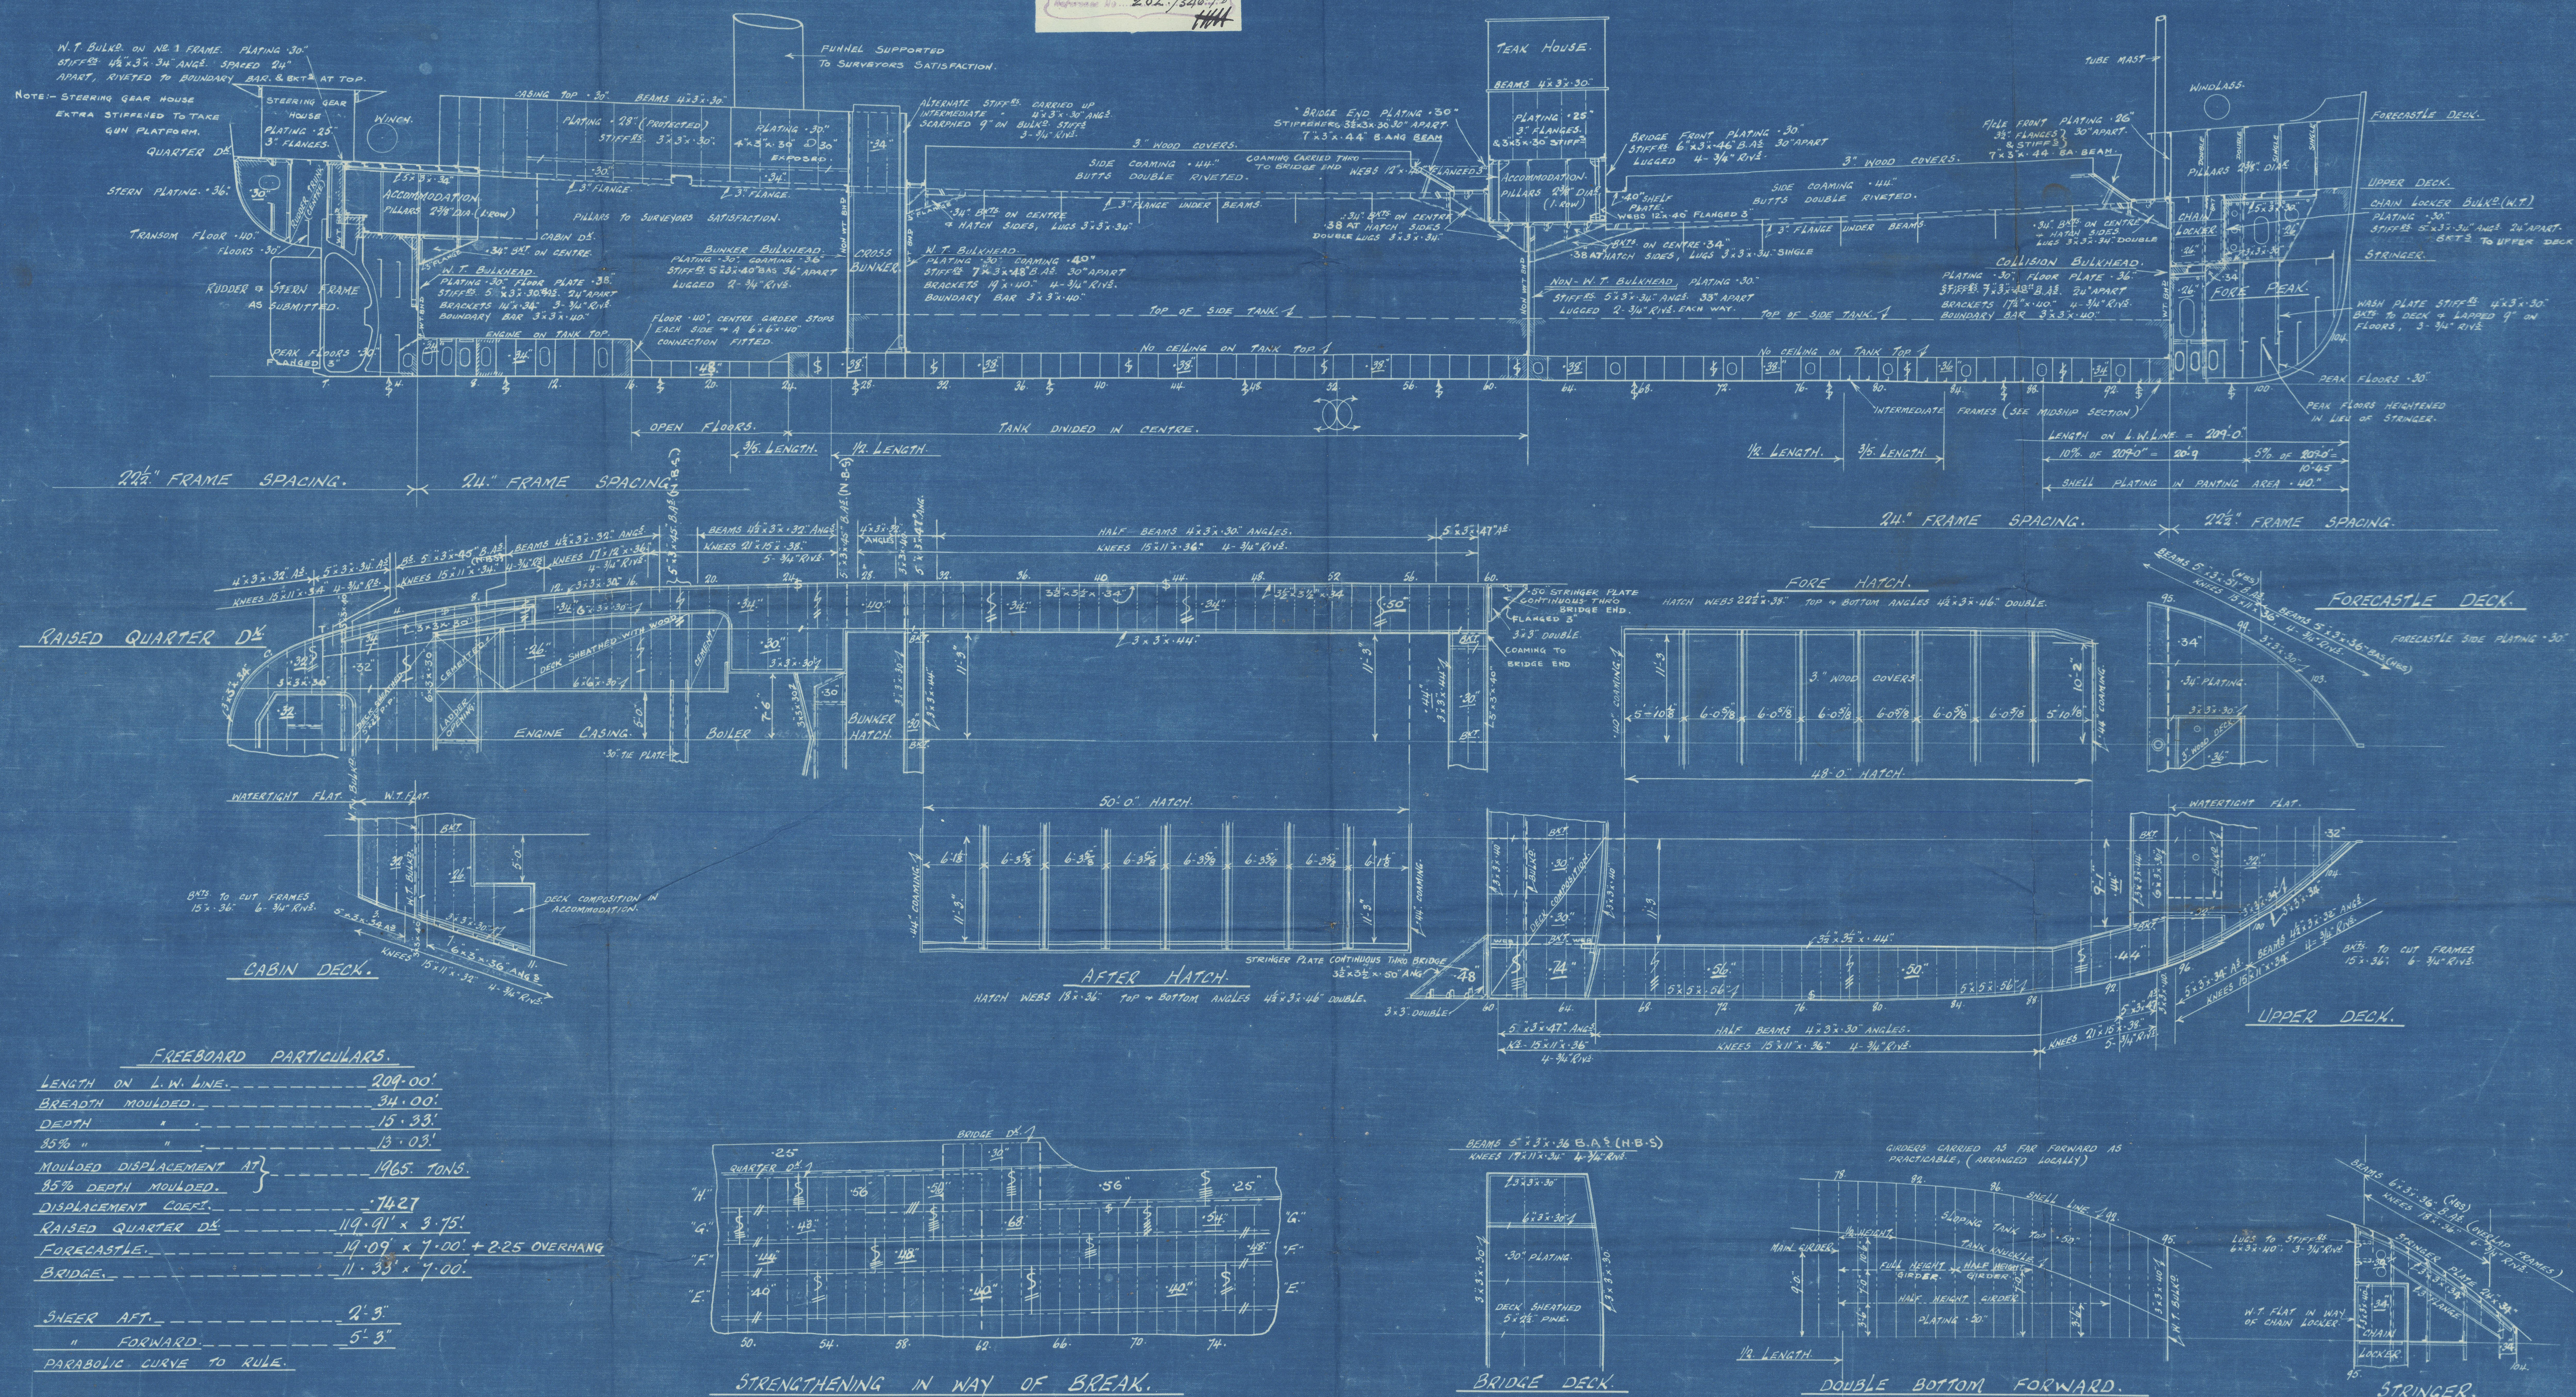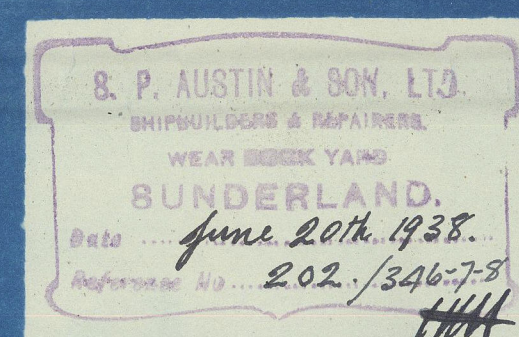

S/o SYLVIA BEALE

Messrs. S.P. Austin & Son's No. 348

Profile of Decks (As built plan)

SUNDERLAND, COT. NO. 32408

RETAIN

© 2020

Lloyds Register
Foundation

003162-003174-0035