
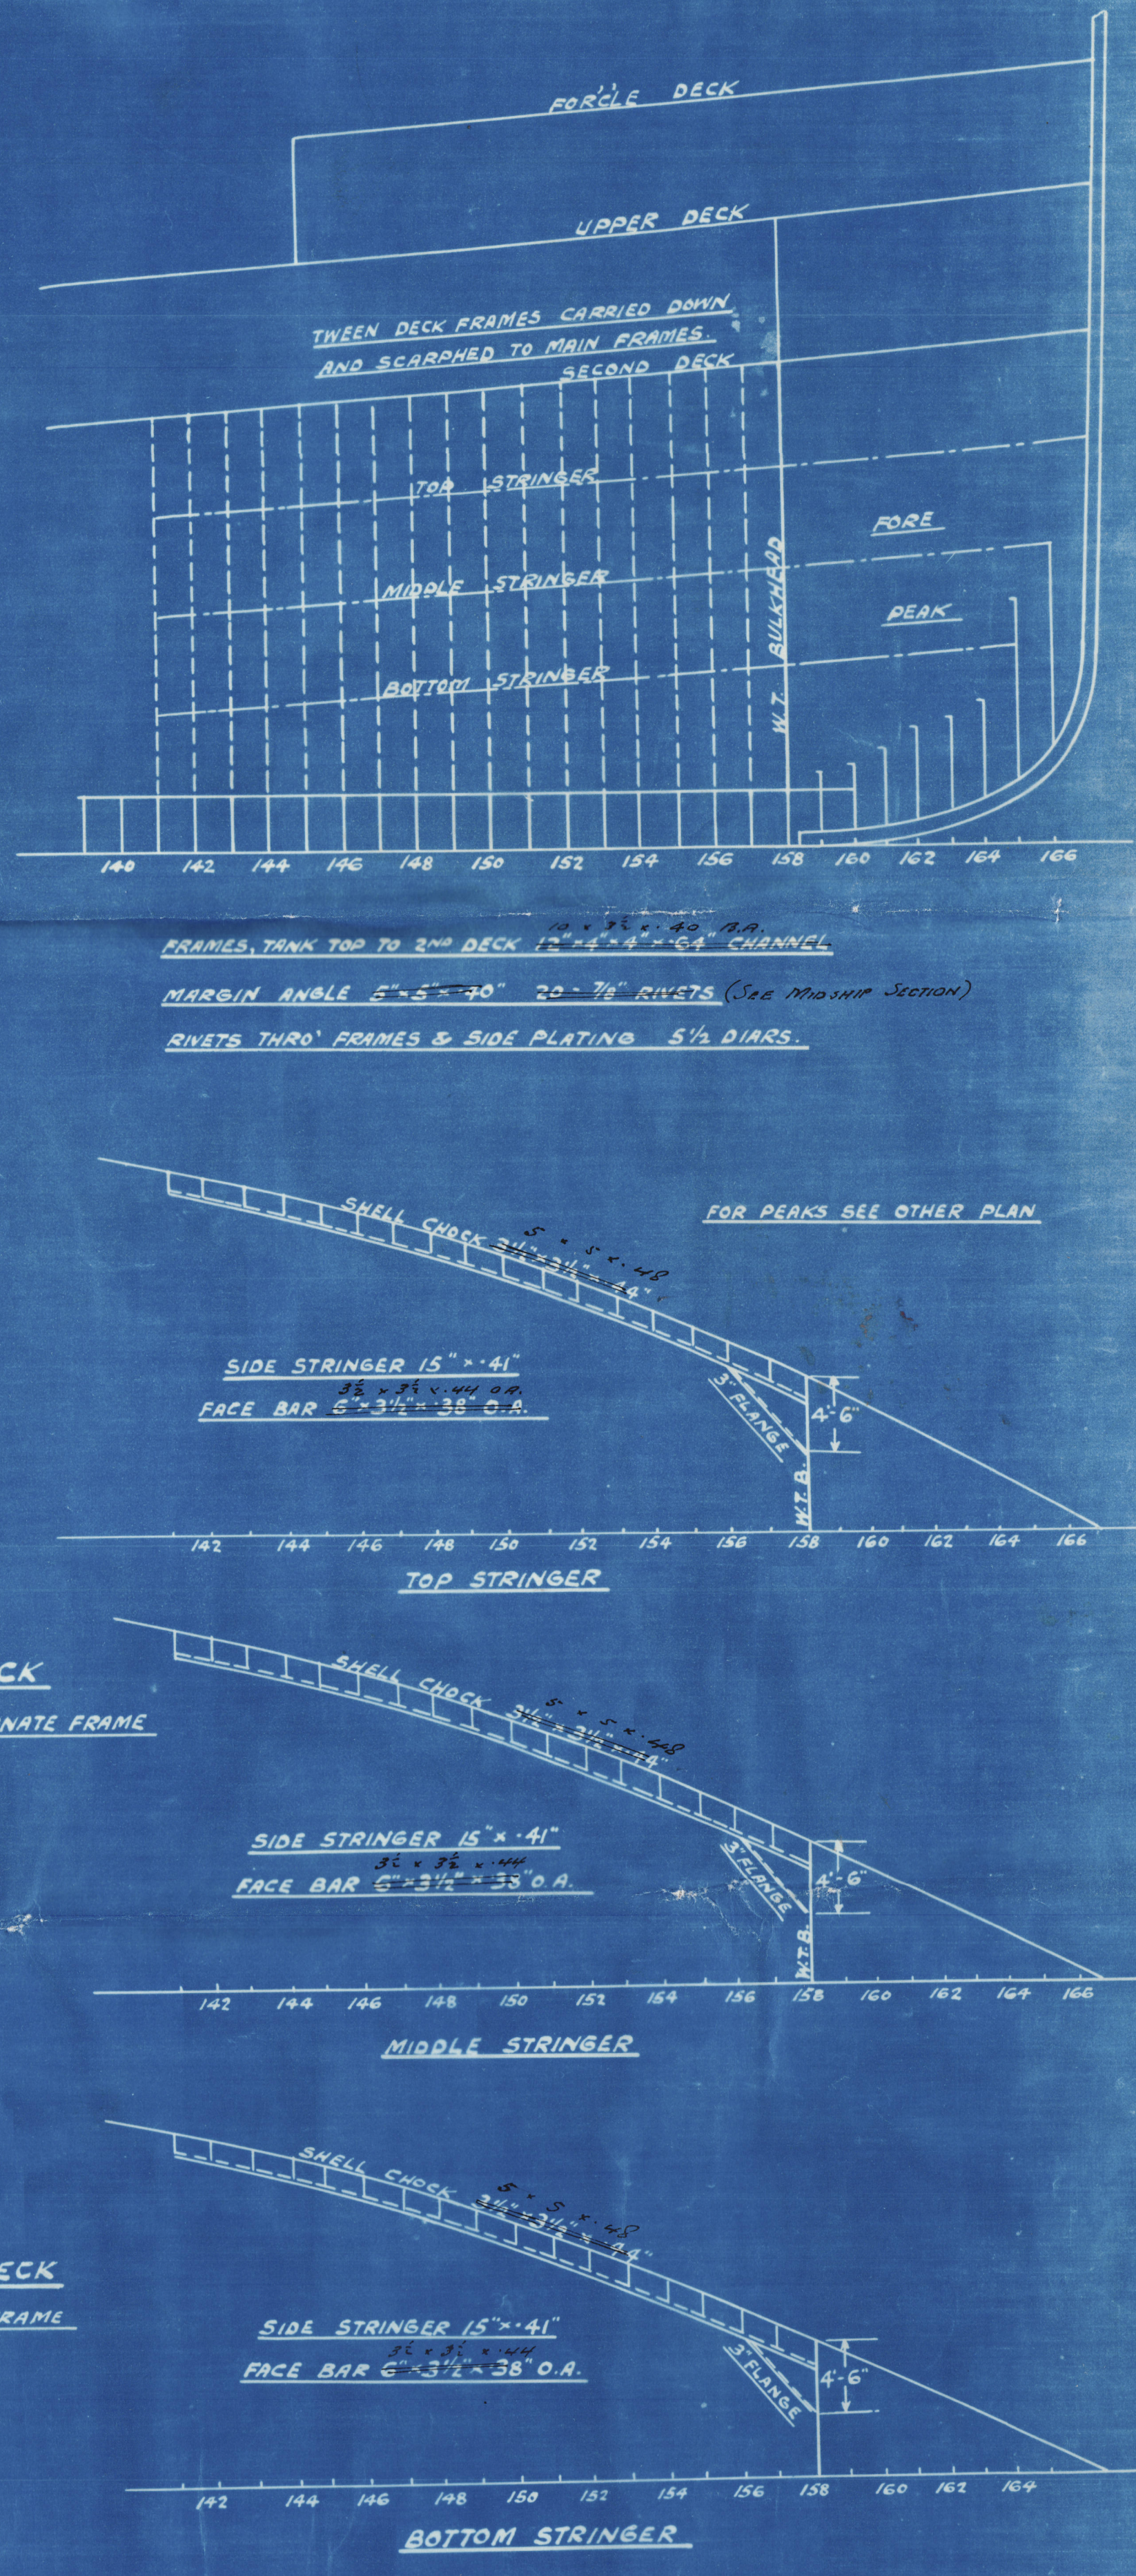


LONGITUDINAL & DECKS.











































































SCALE 1/8" = ONE FT.
DIMENS: 385'0" B.A. x 52'0" T. x 51'9" MLD. x 29'0" MLD. TO UPPER DECK.

NOTE
THE SCANTLINES & DETAILS OF CONSTRUCTION NOTED HEREON
WERE SUBMITTED ON THE UNDERSTANDING THAT THEY ARE THE
MINIMUM WHICH WILL PRESENTED FOR CONSIDERATION & IT NOT THEY ARE
TO BE AMENDED, ERRORS AND OMISSIONS EXCEPTED.
PLAN OF HATCHES, BULKHEADS, TUNNEL,
DECK GIRDERS, & BOTTOM STRENGTHENING FOR
WILL BE SUBMITTED LATER.

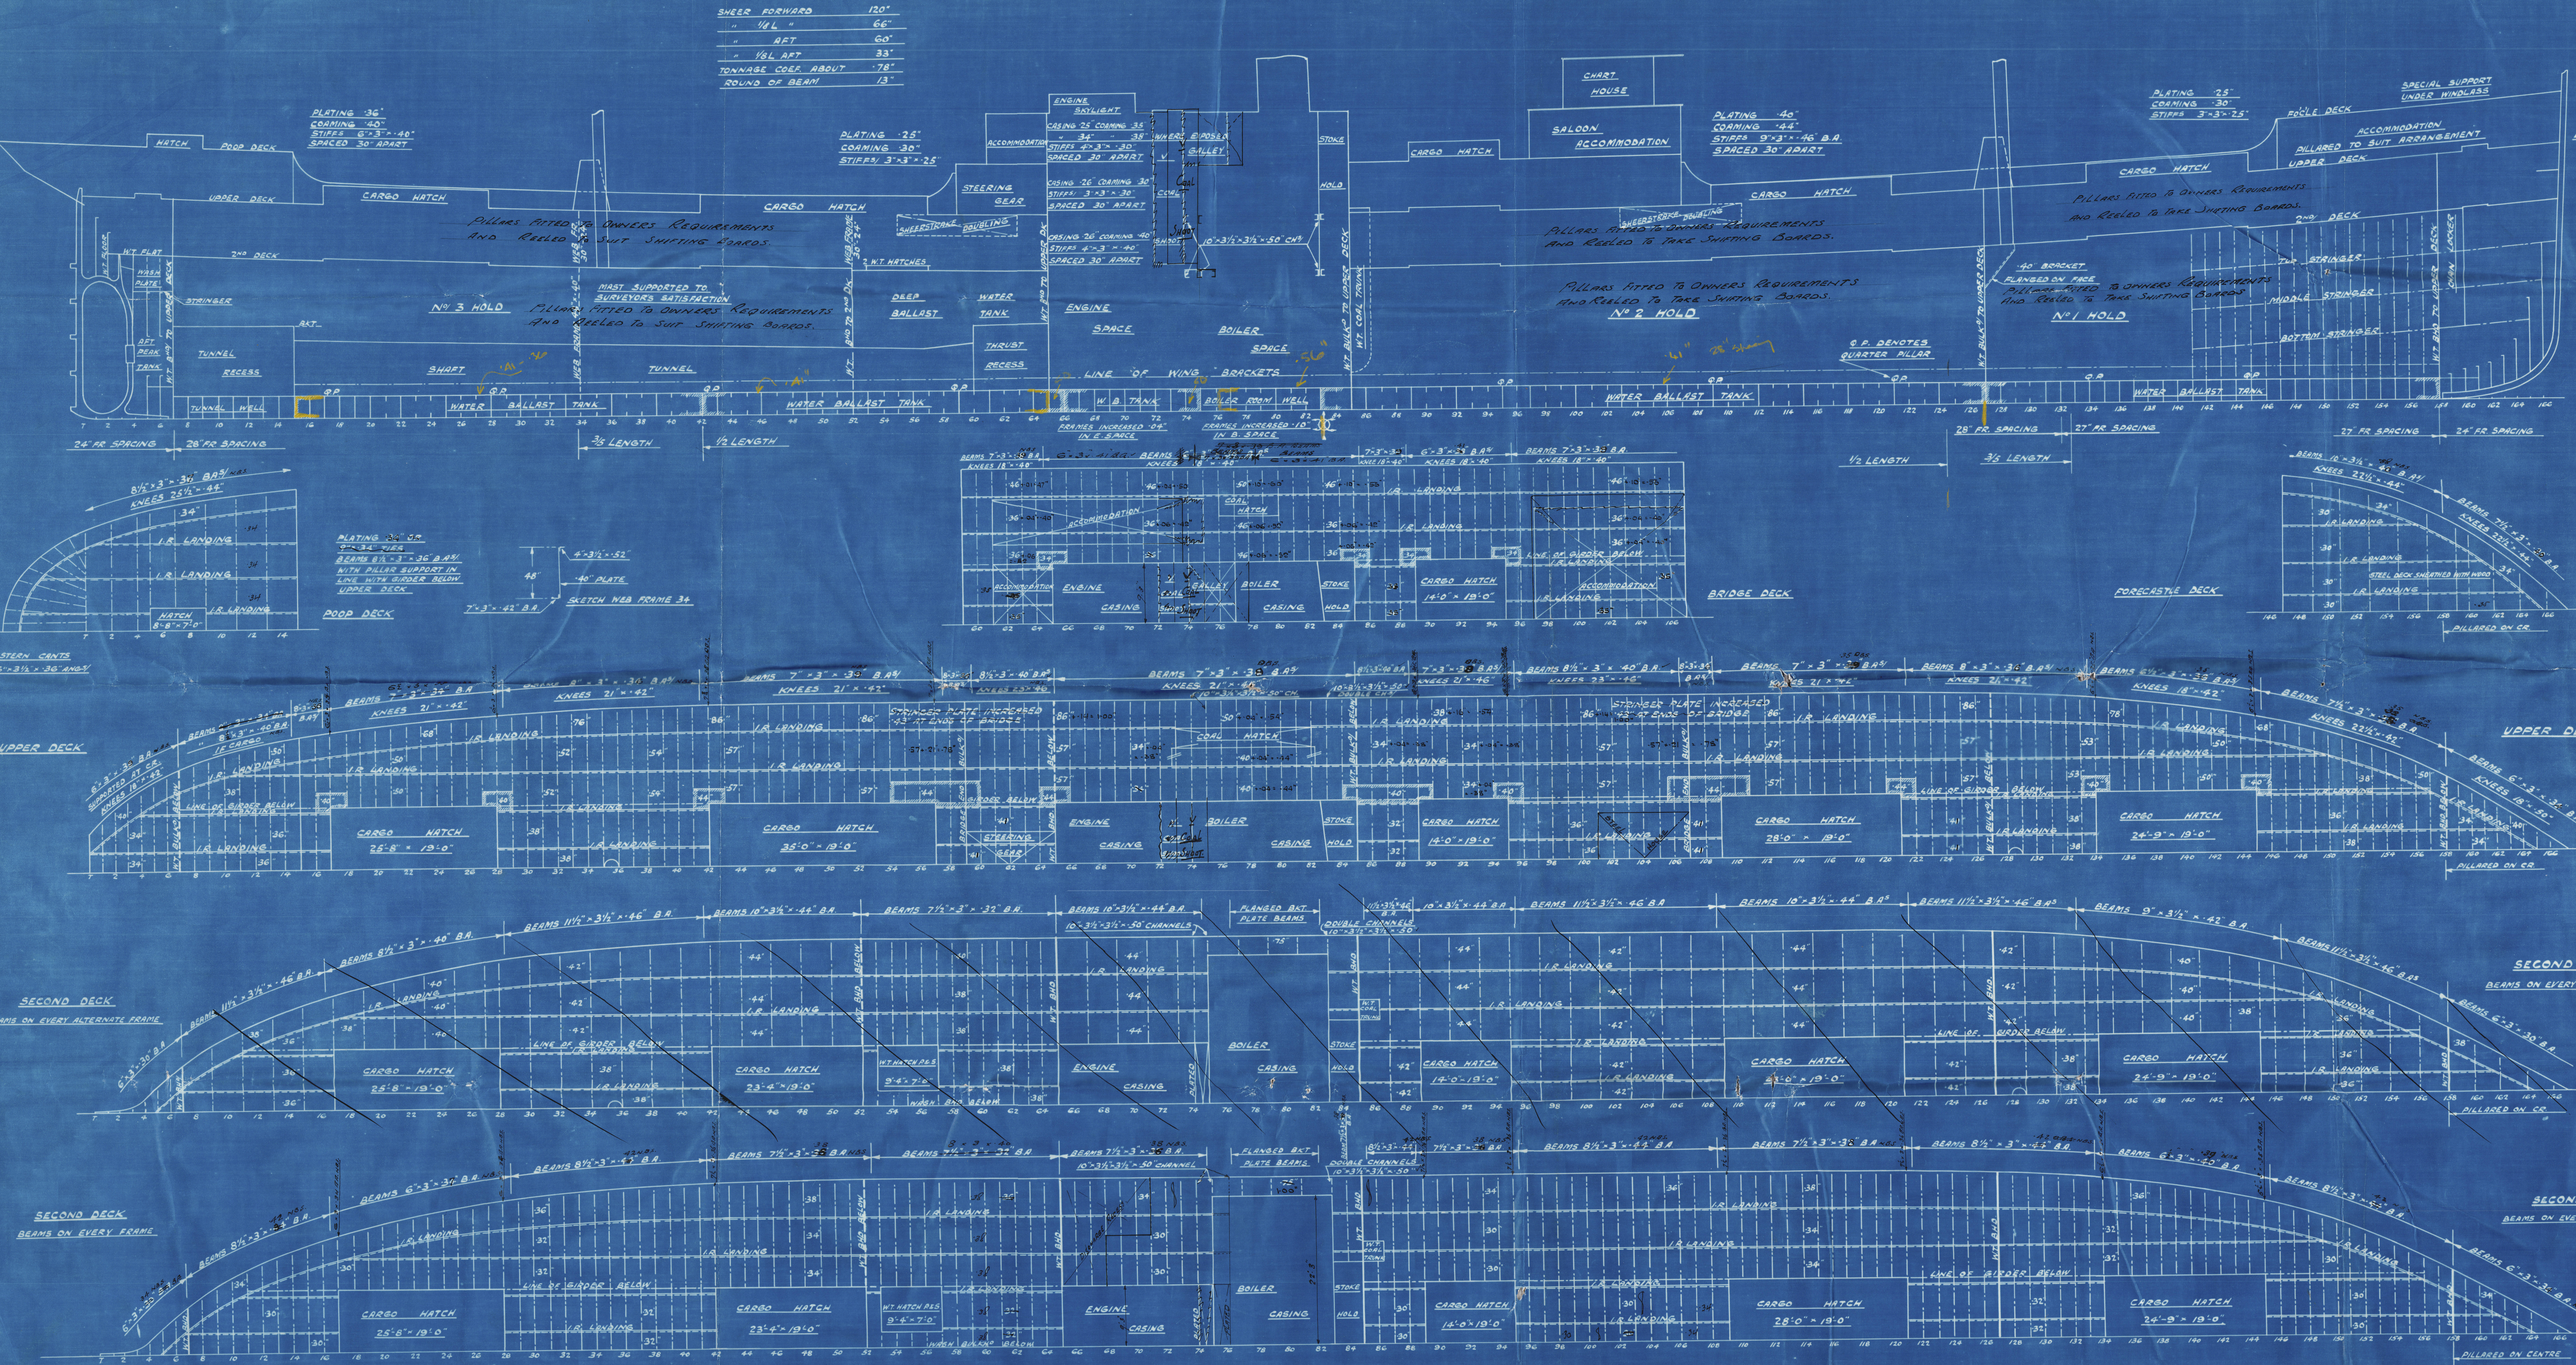

SHEER FORWARD 120°

" 1/4 L "	66°
" 1/4 RT "	60°
" 1/4 L RT "	33°
TOWNSHIP CORRECTION	78°
ROUND OF BEAM	13°

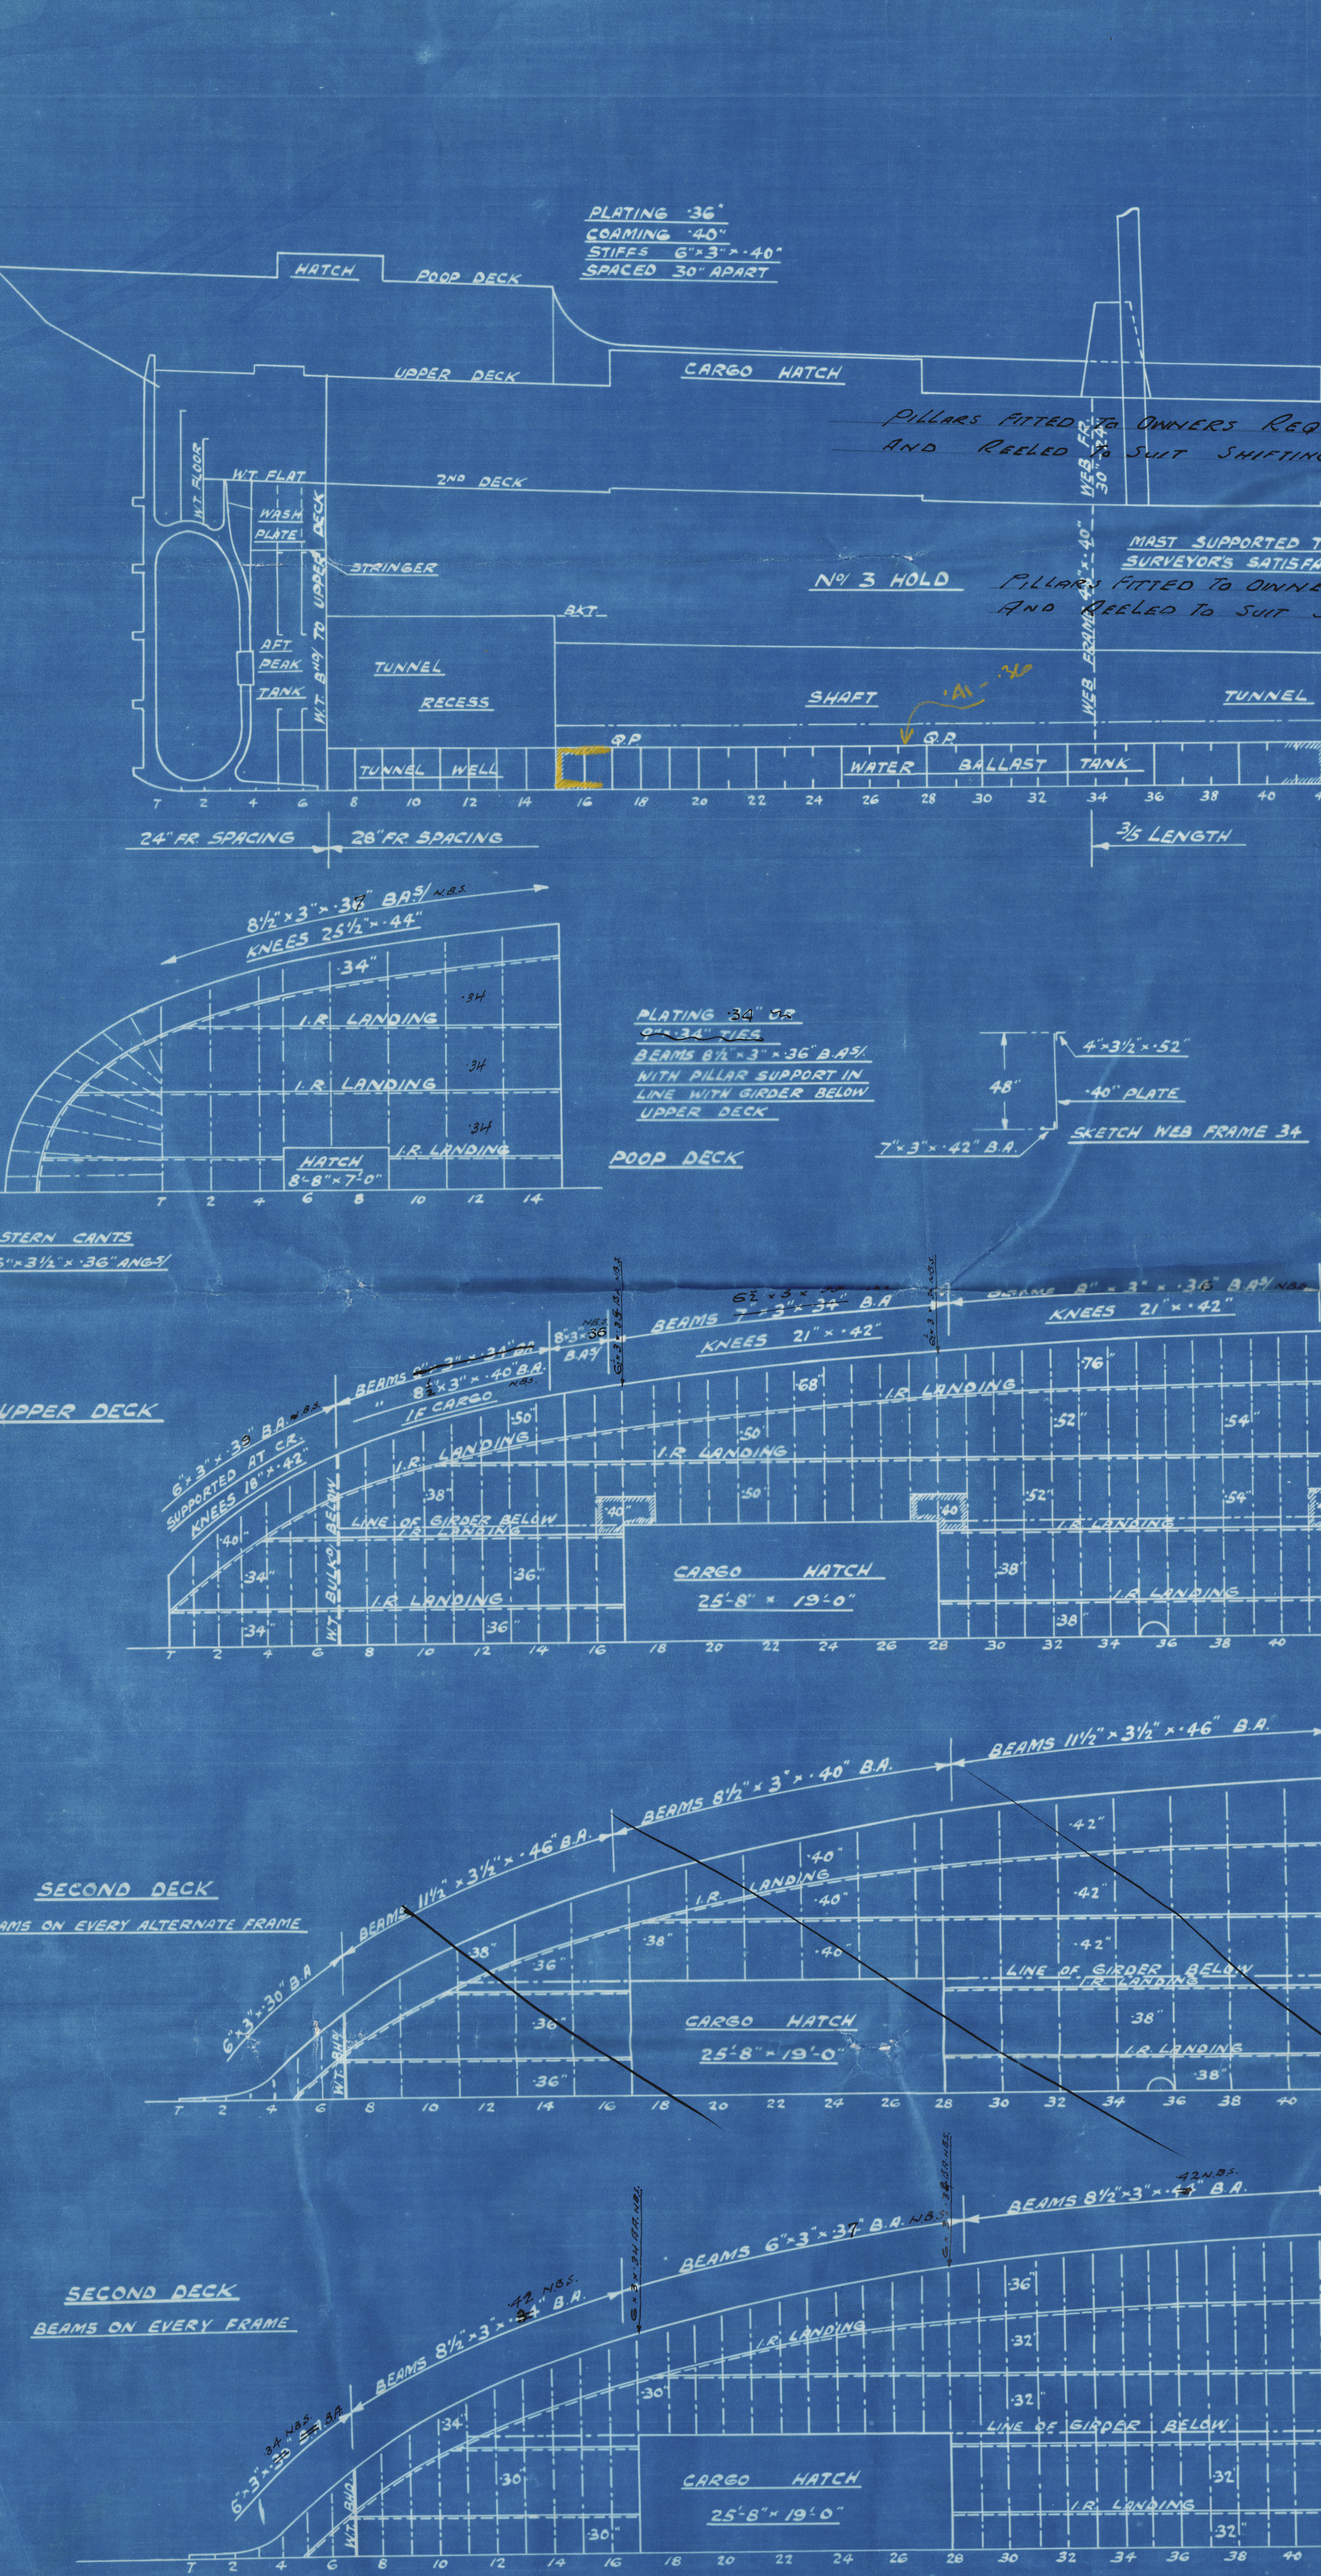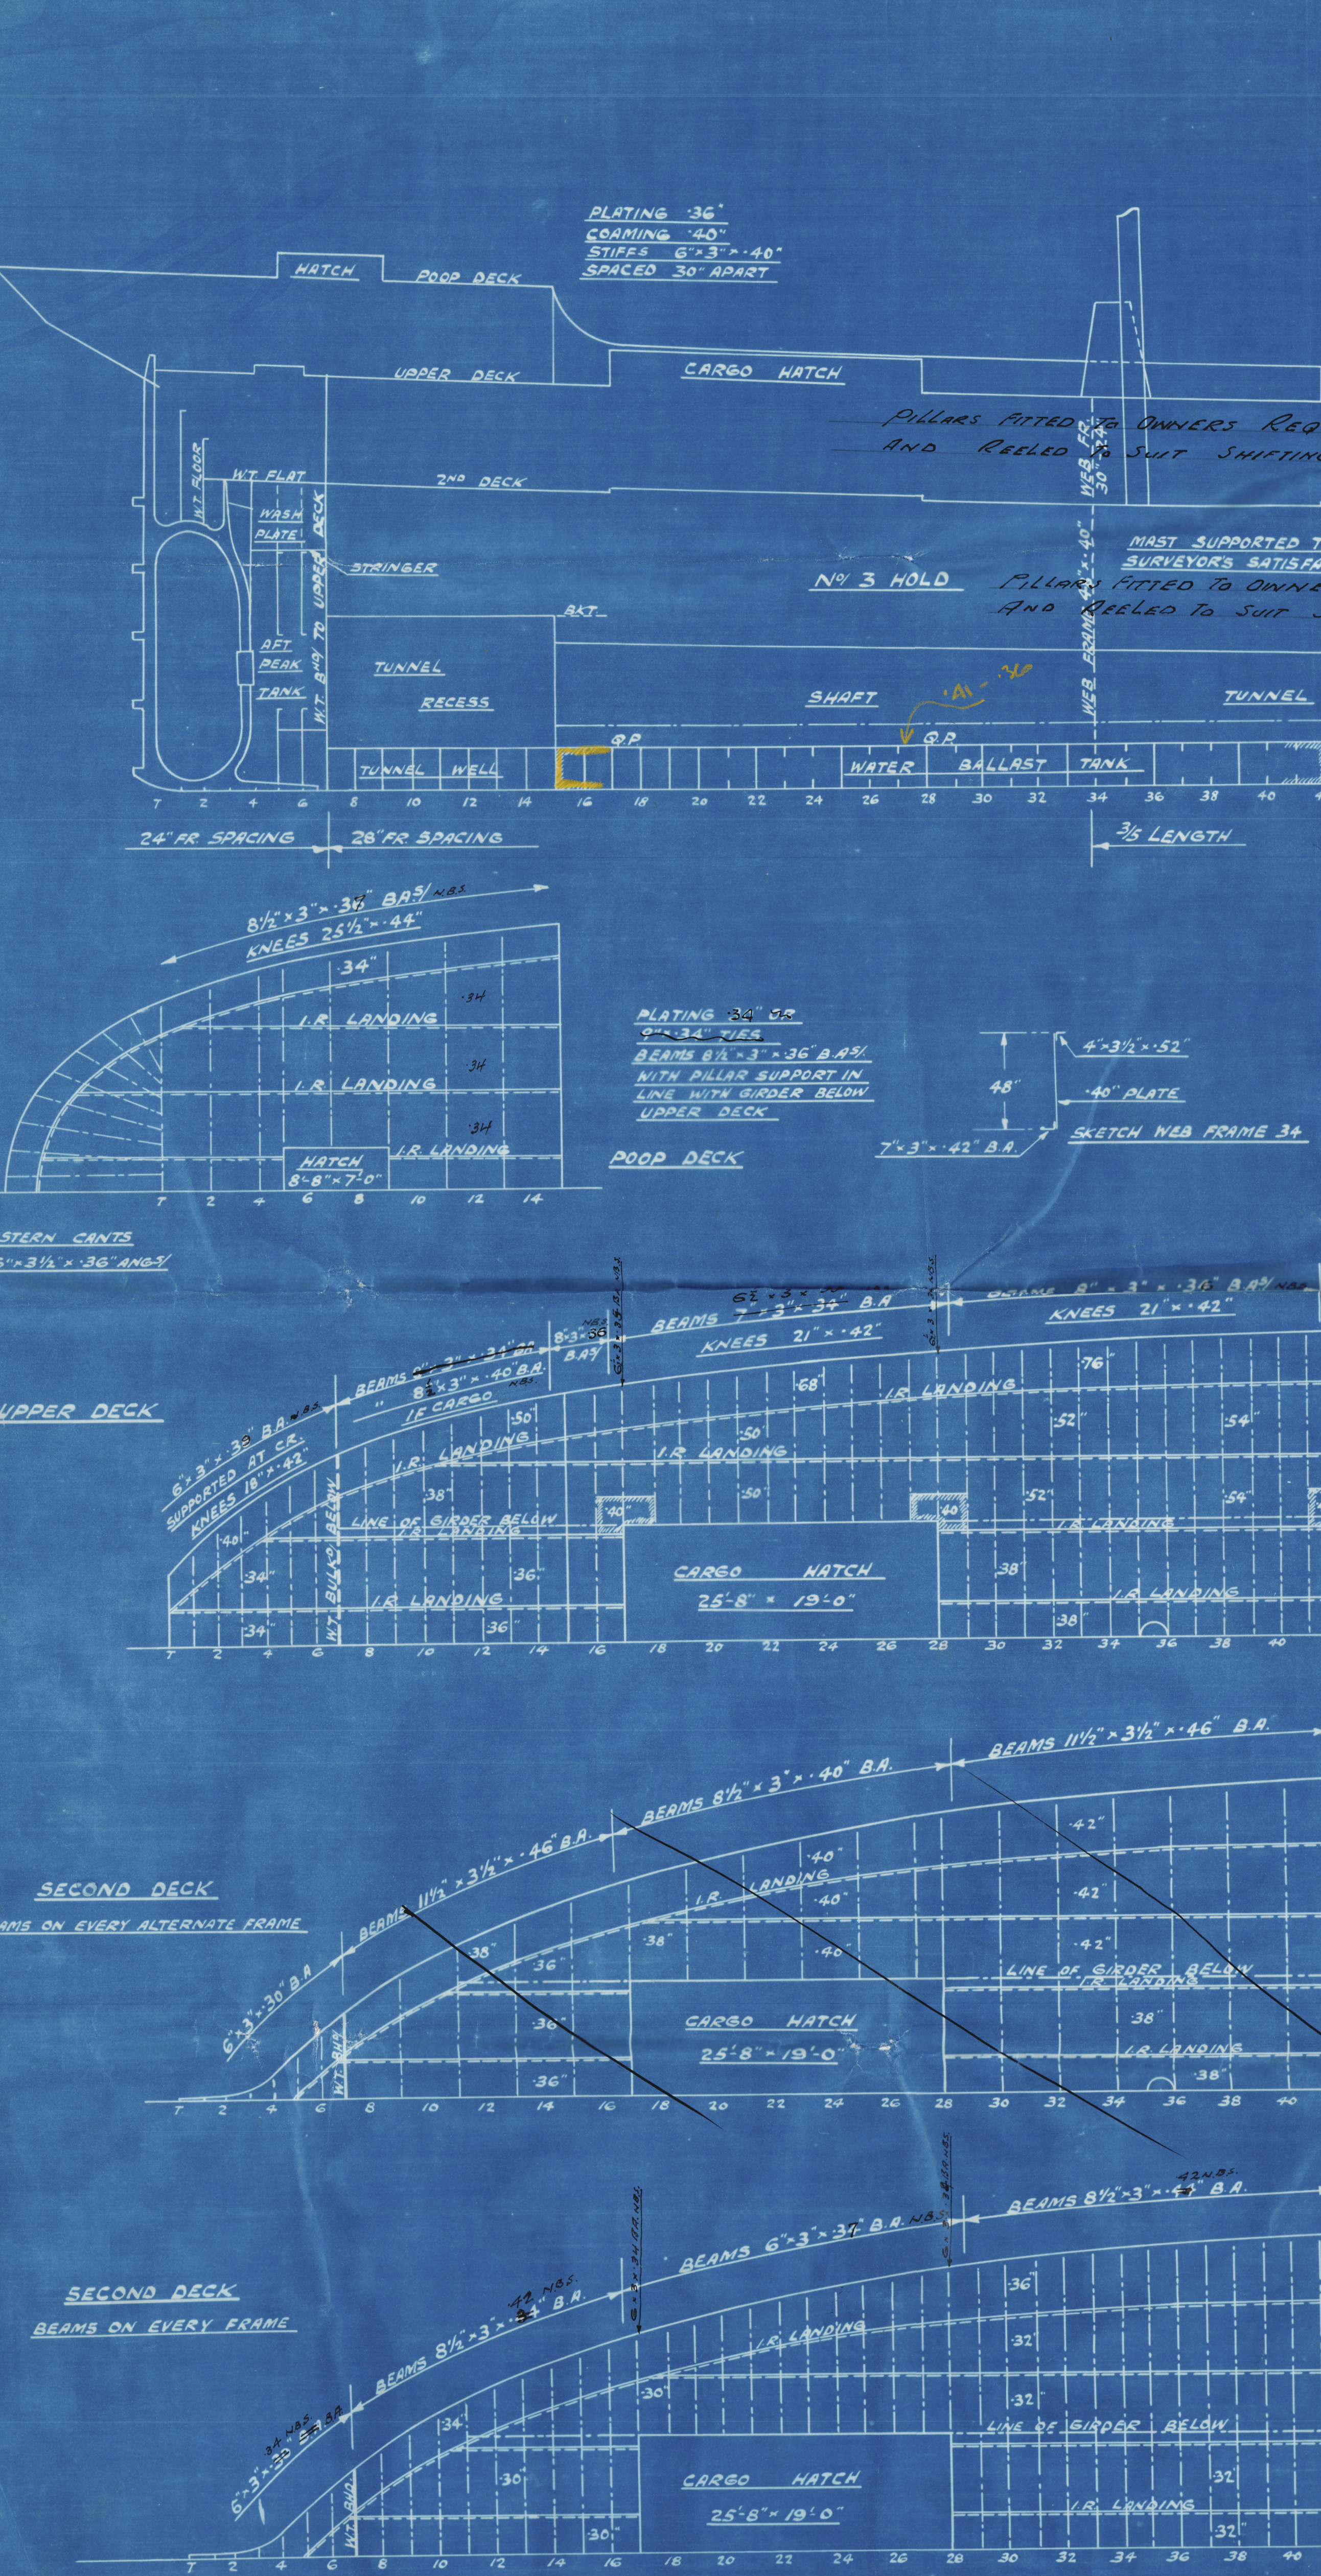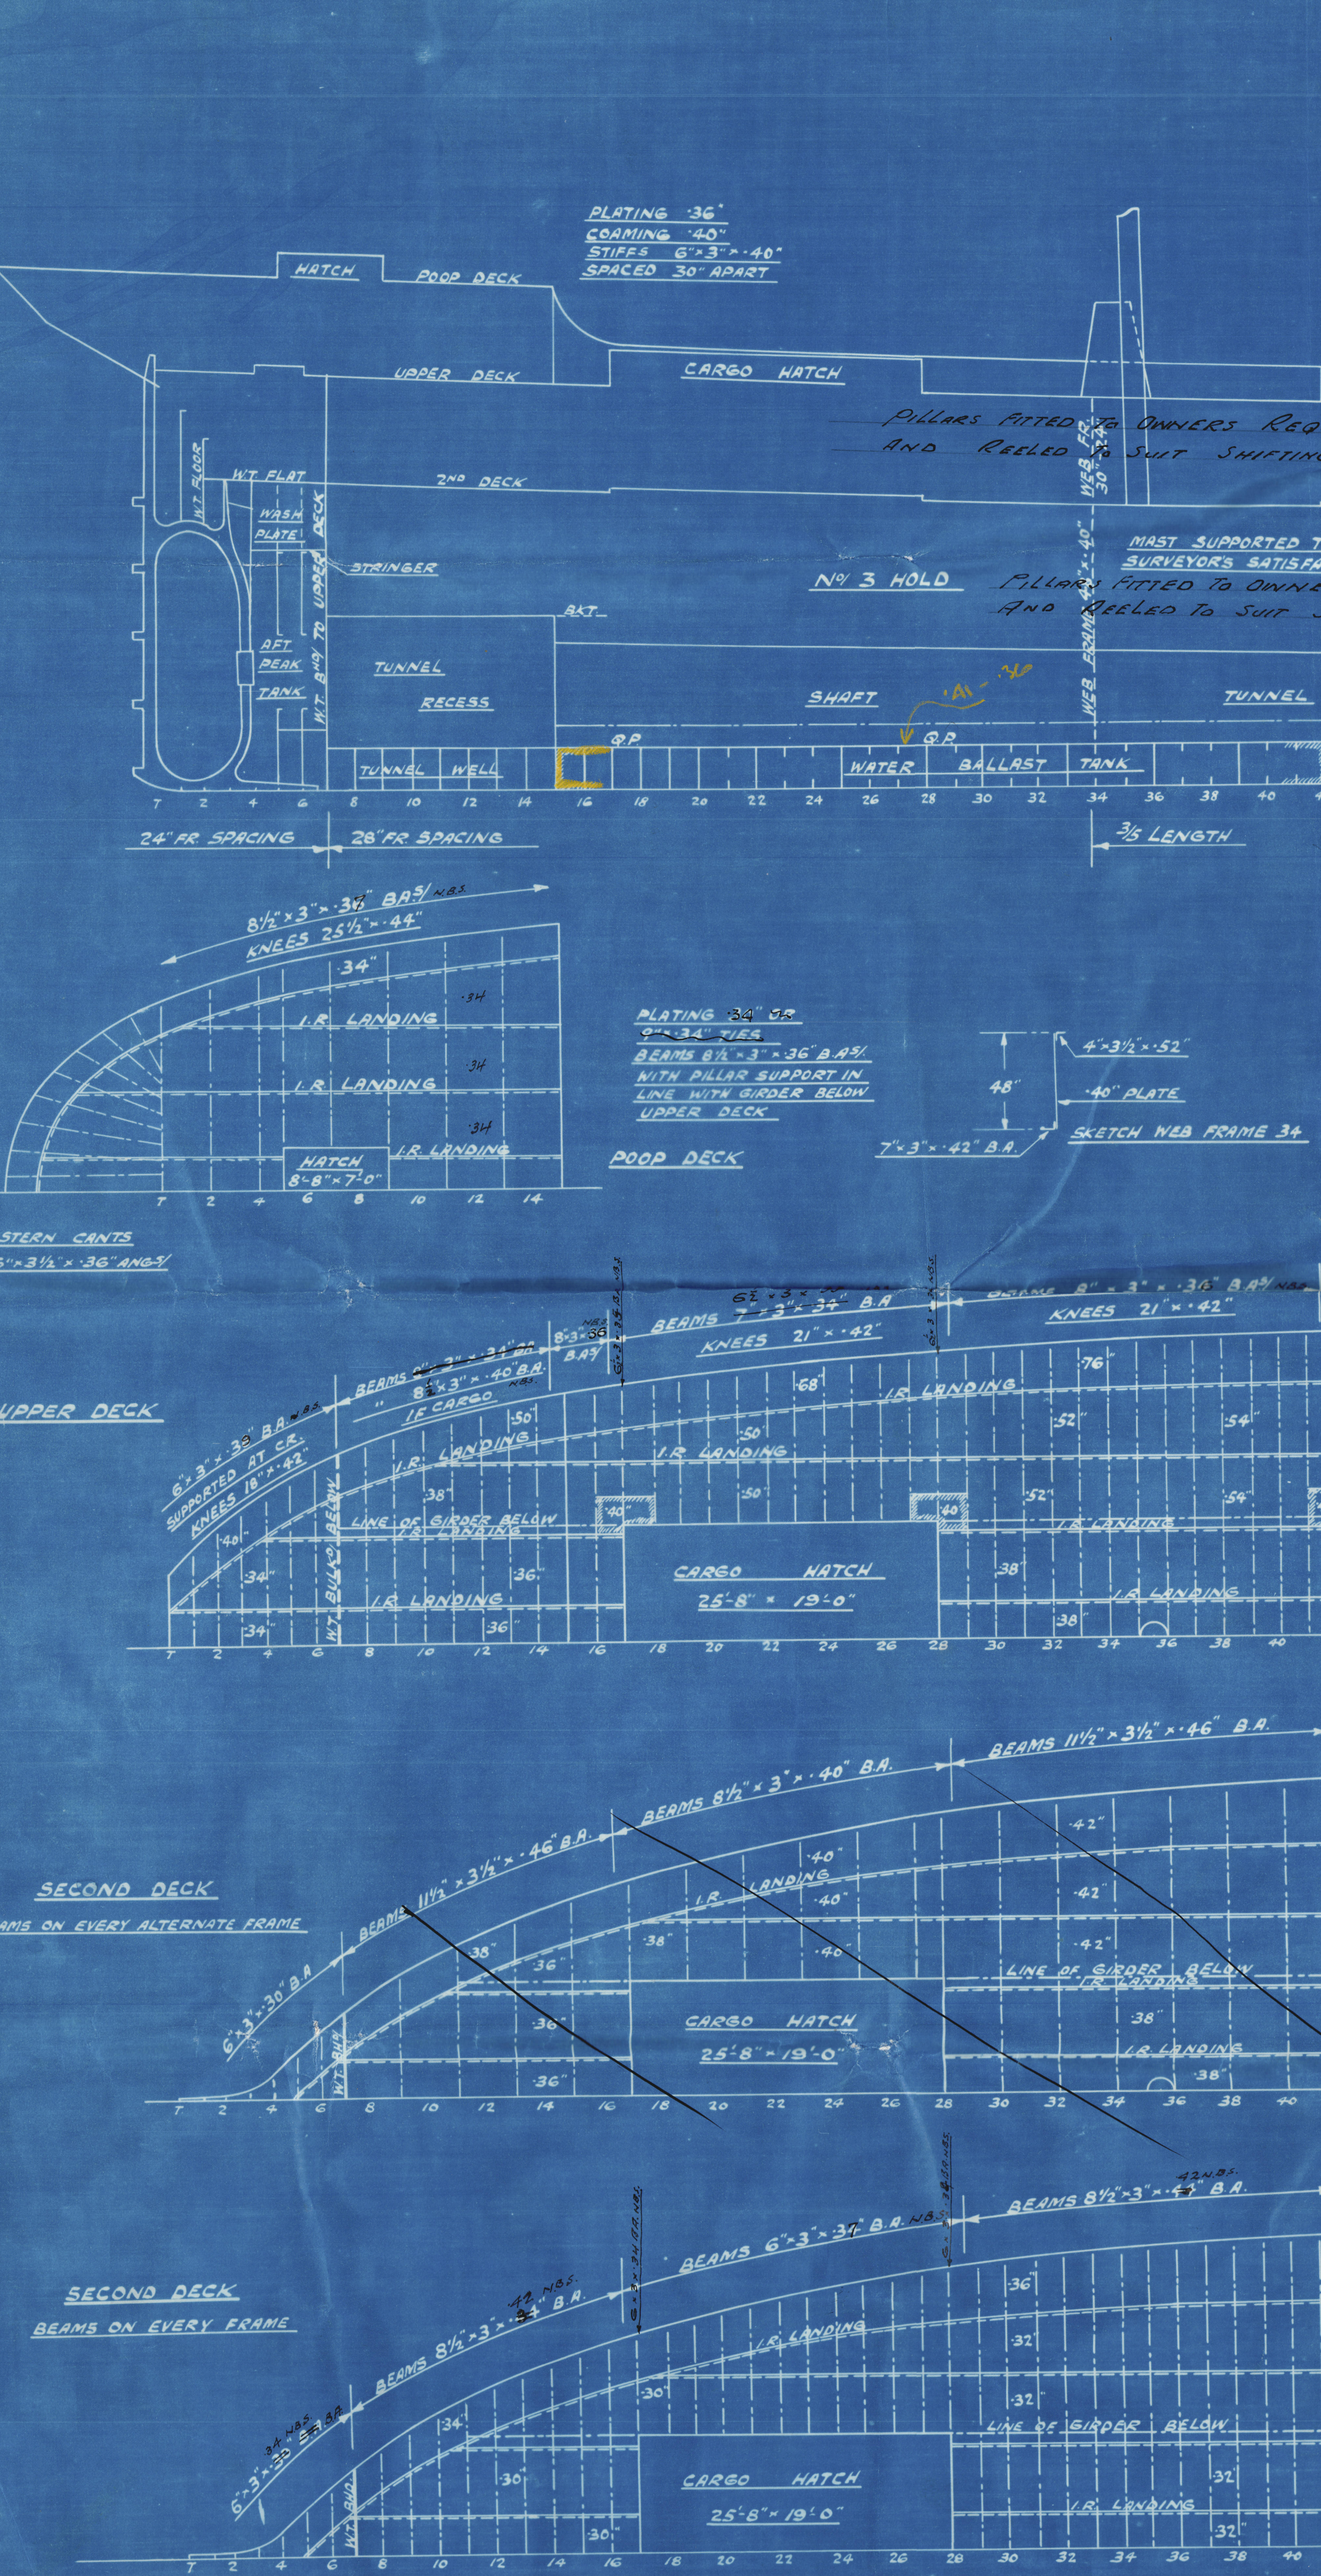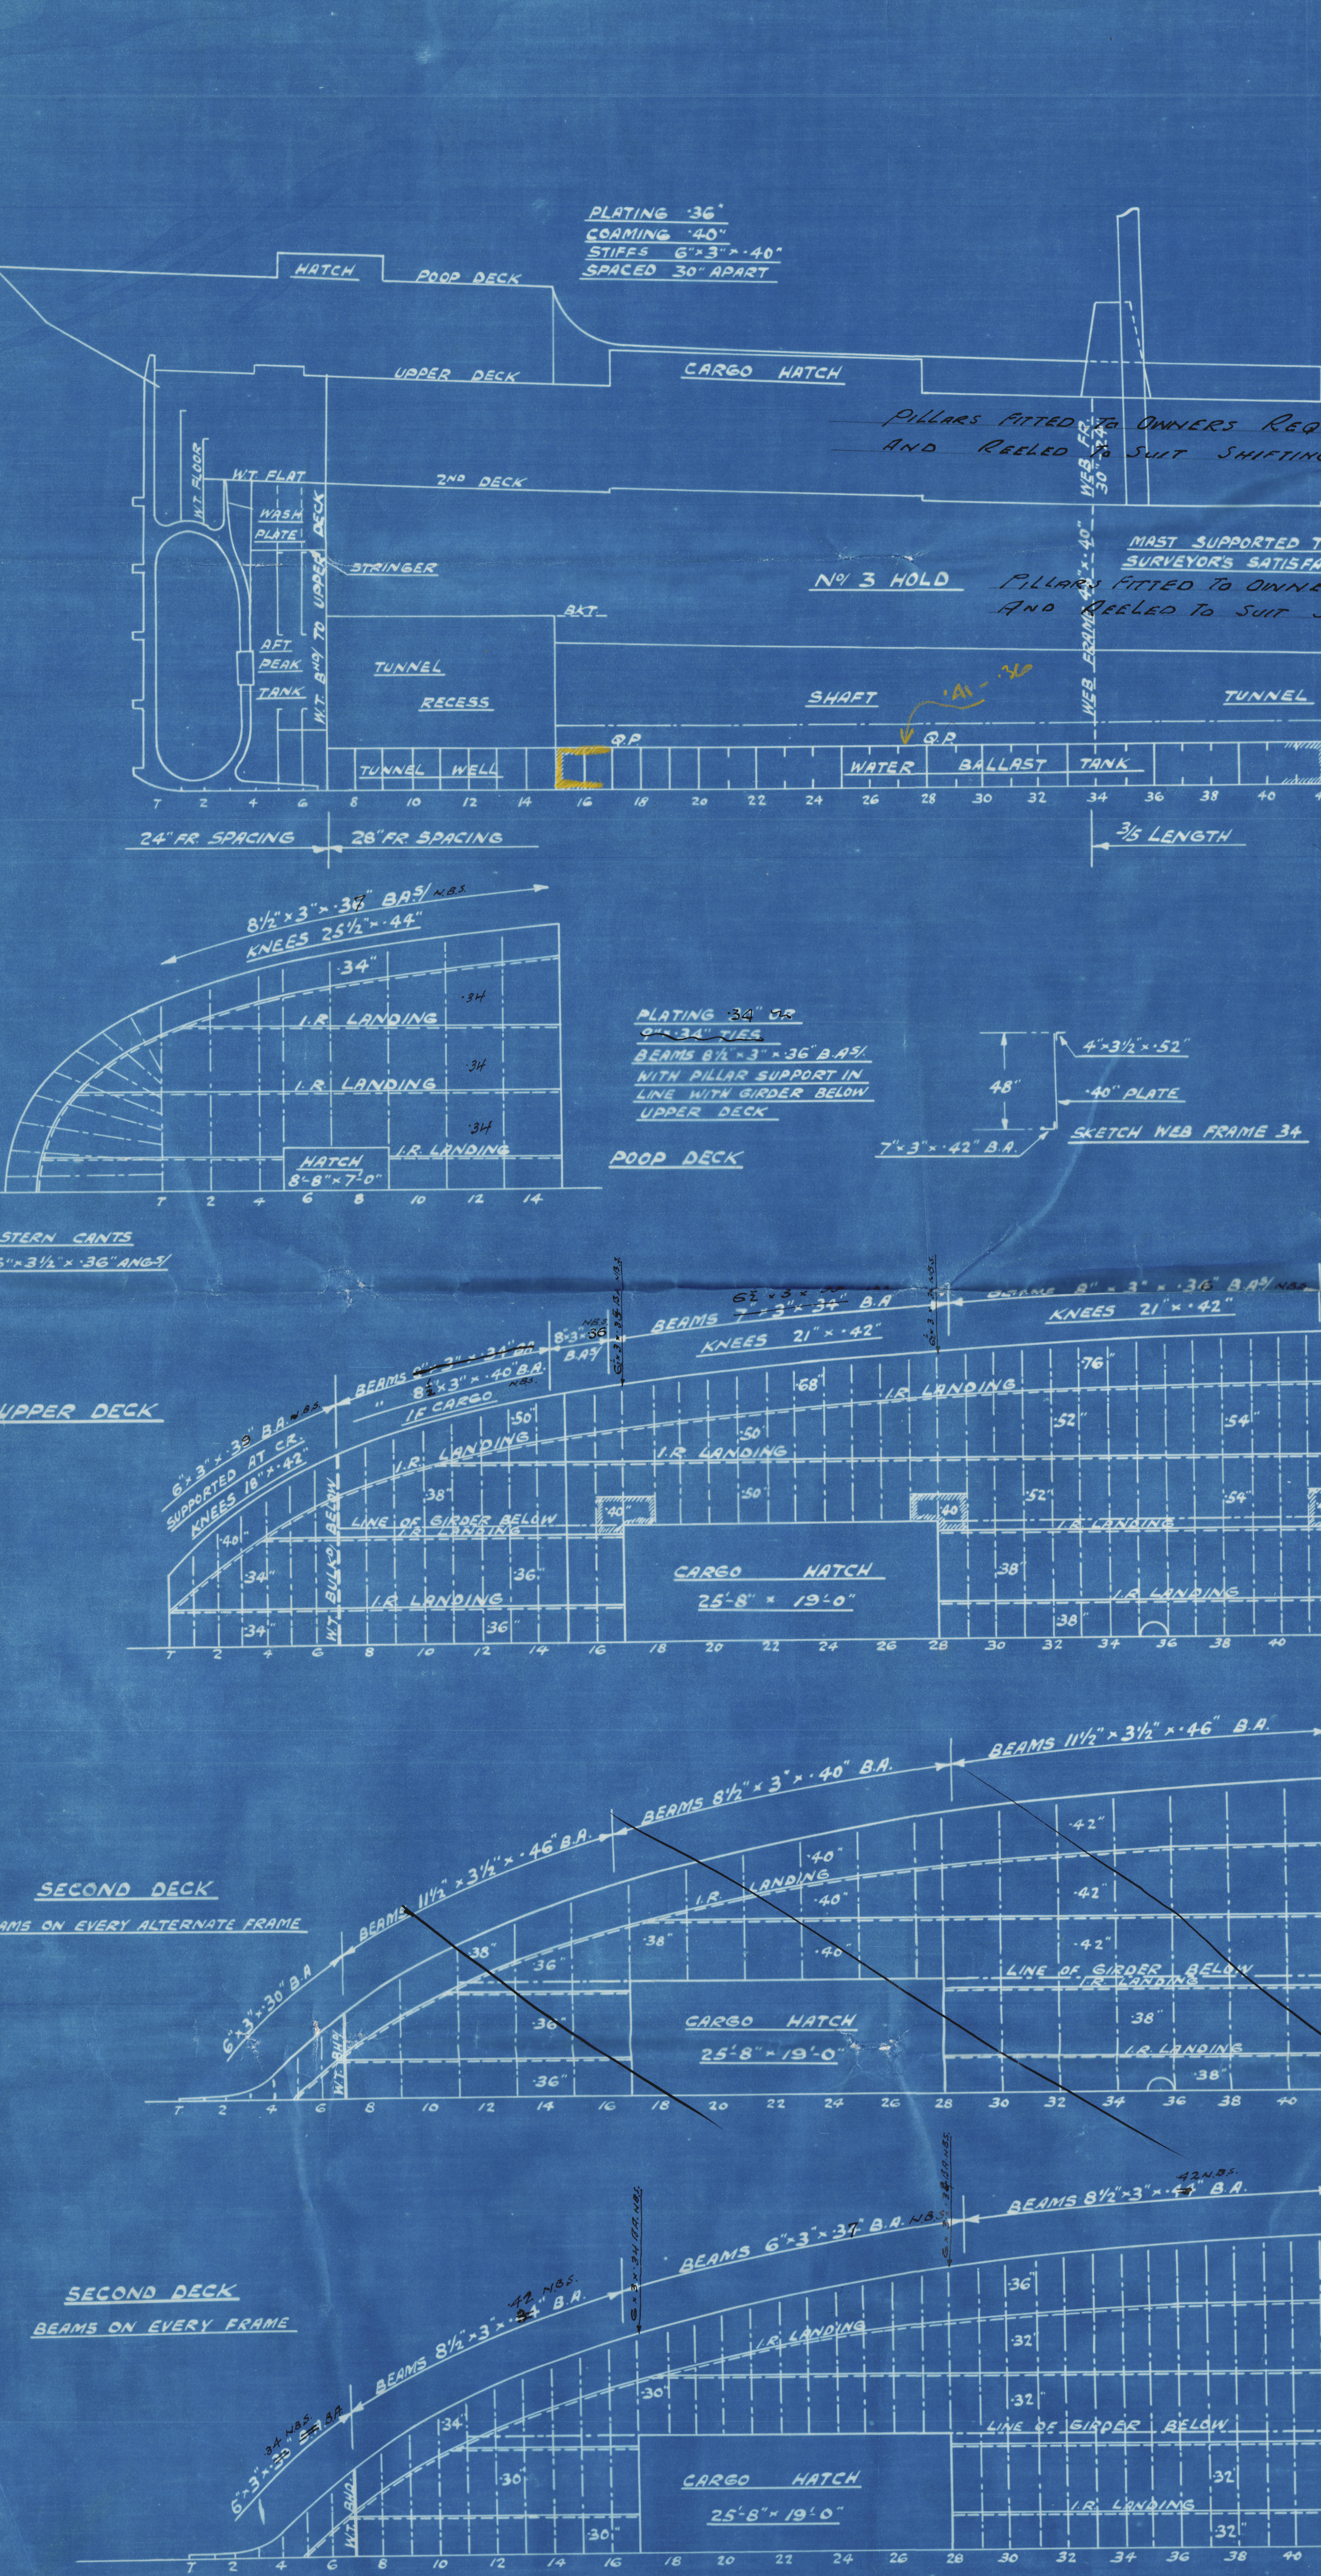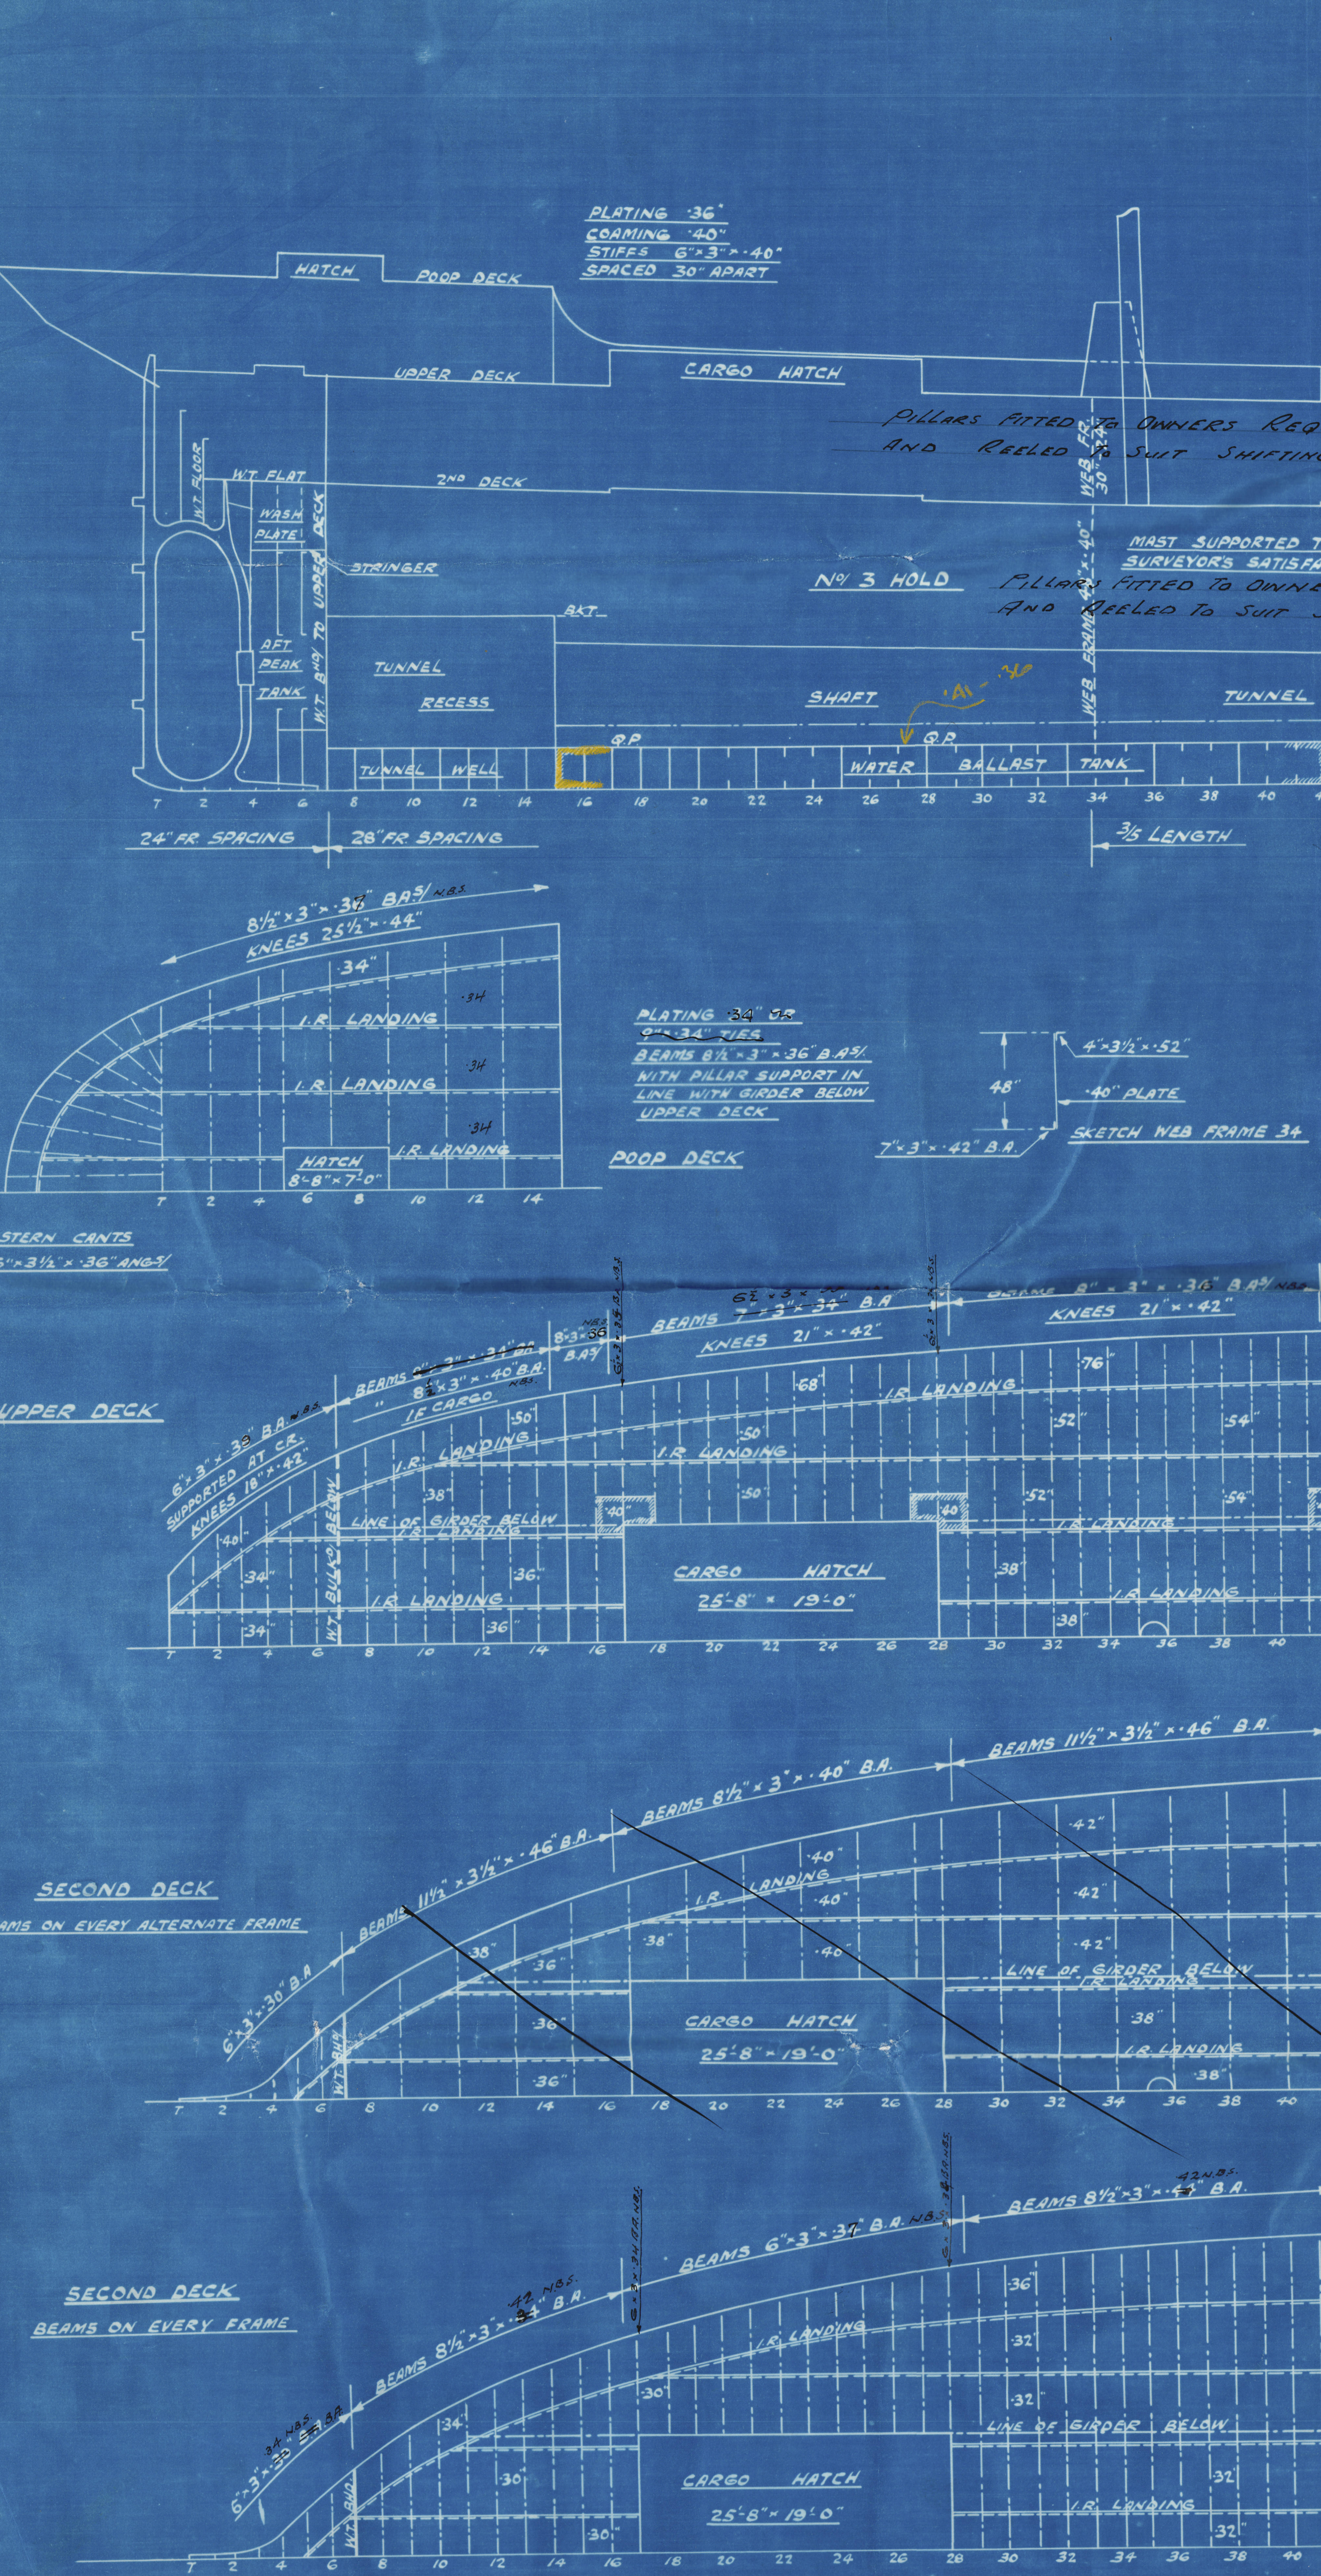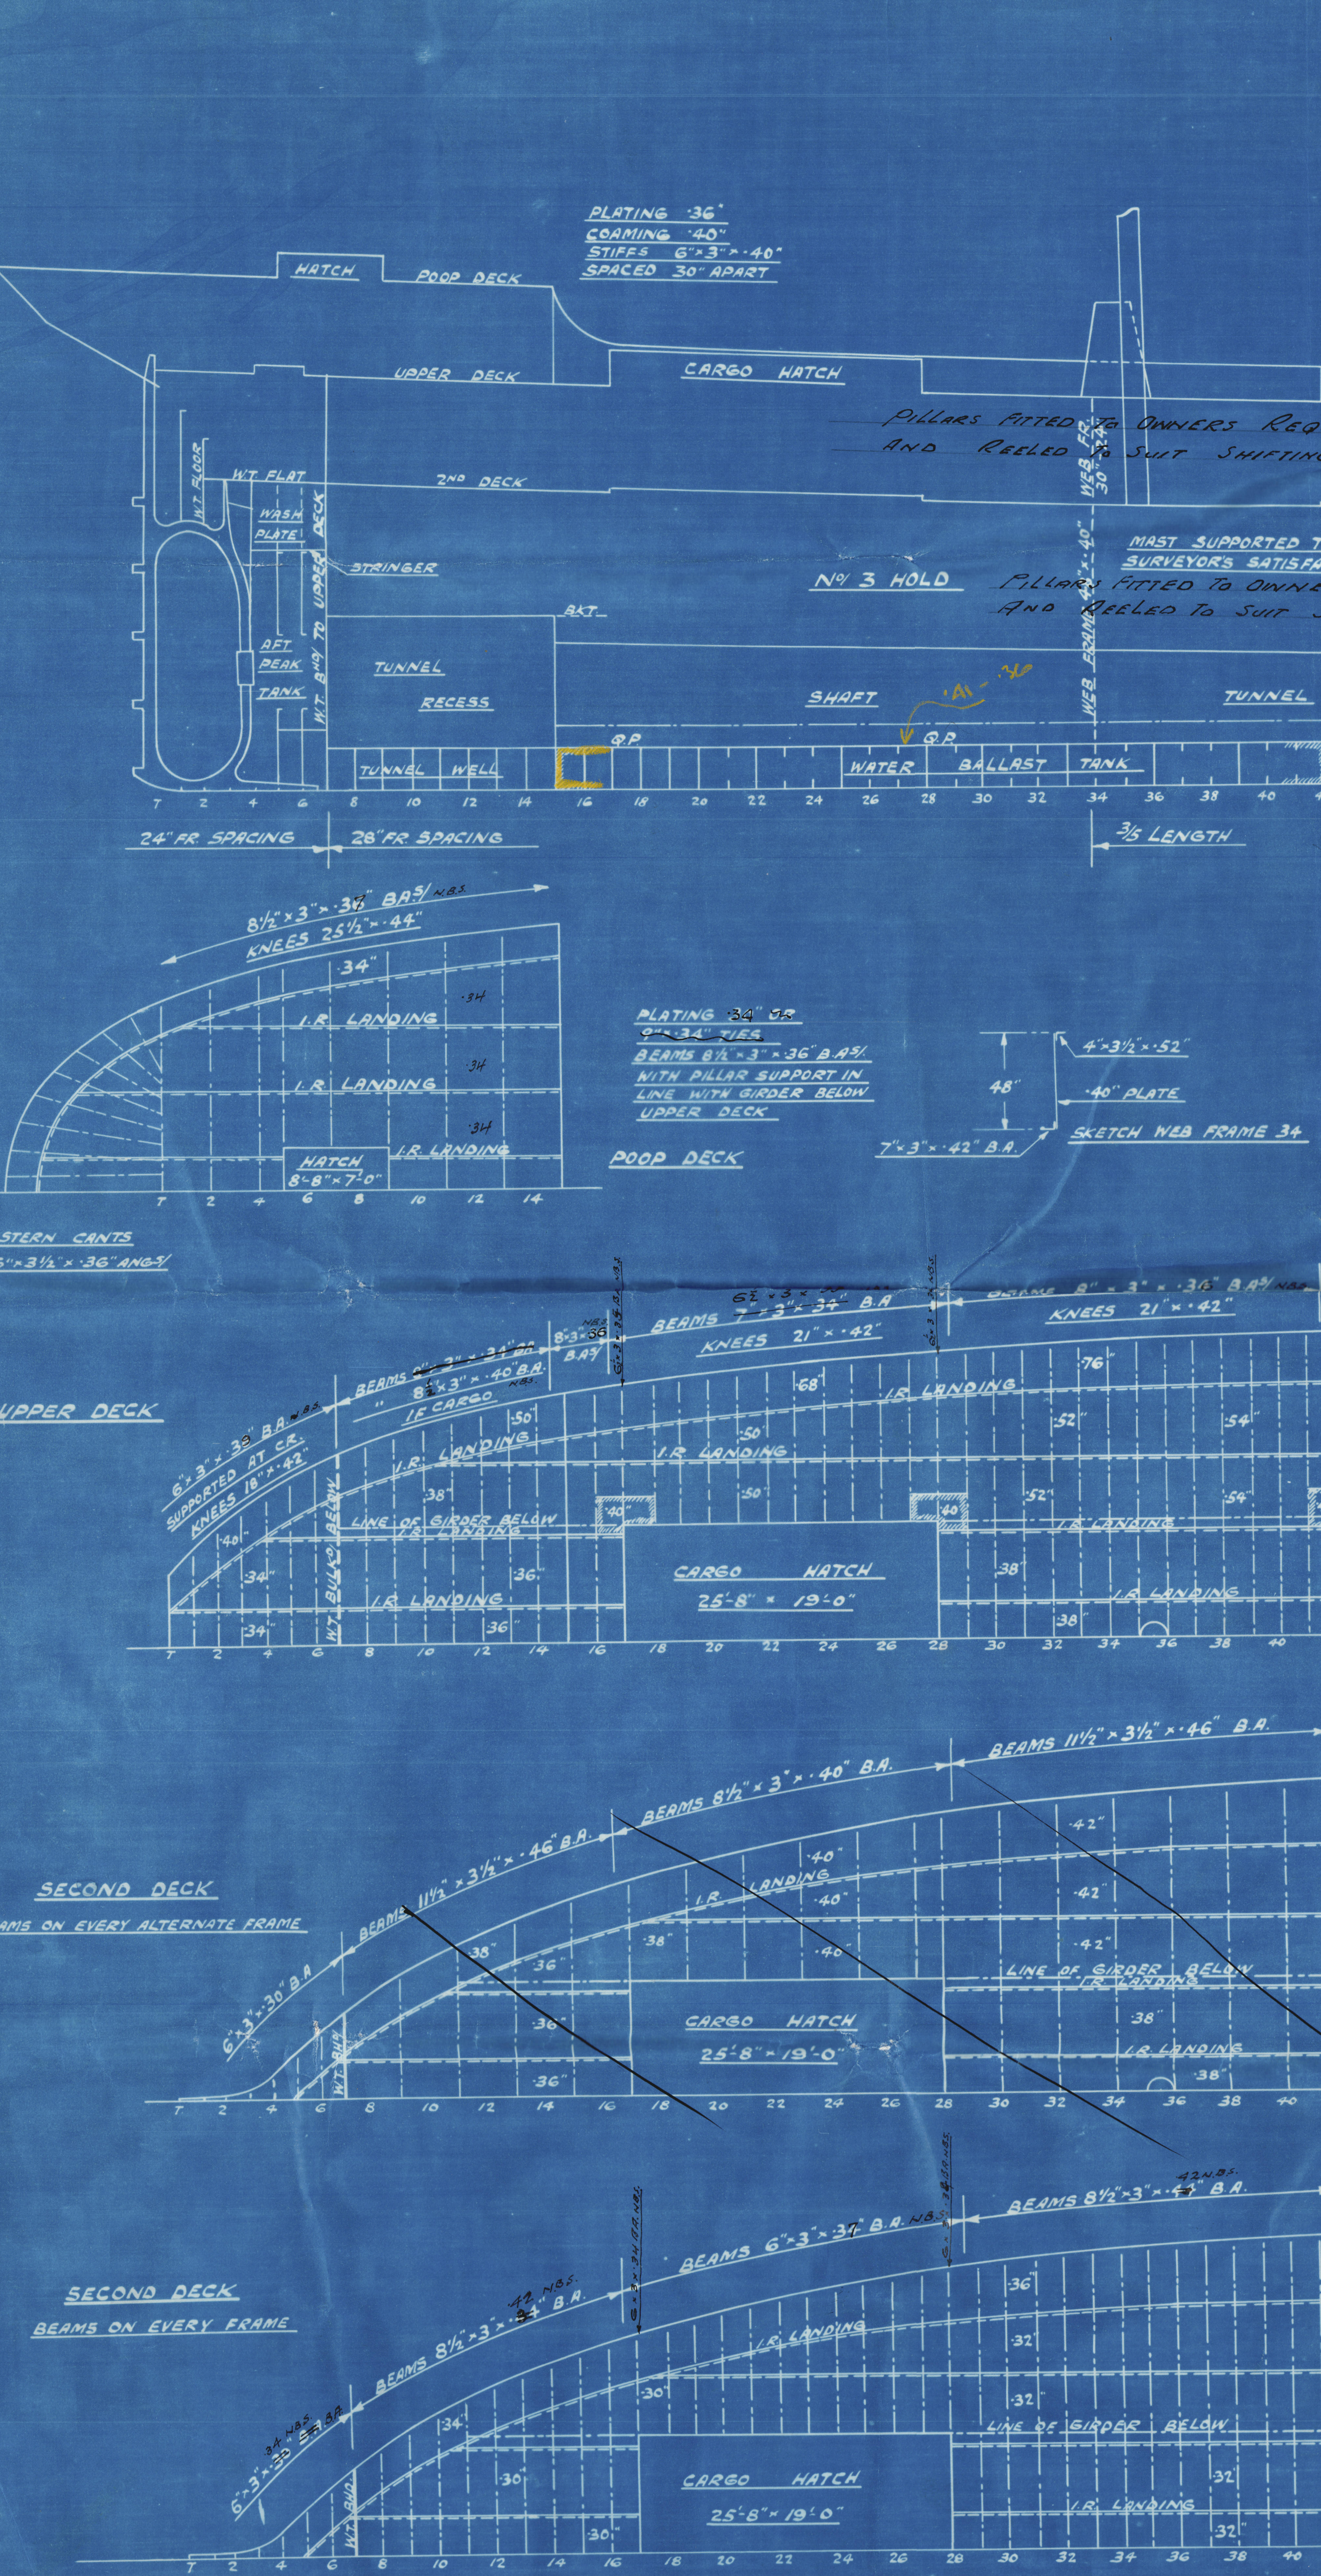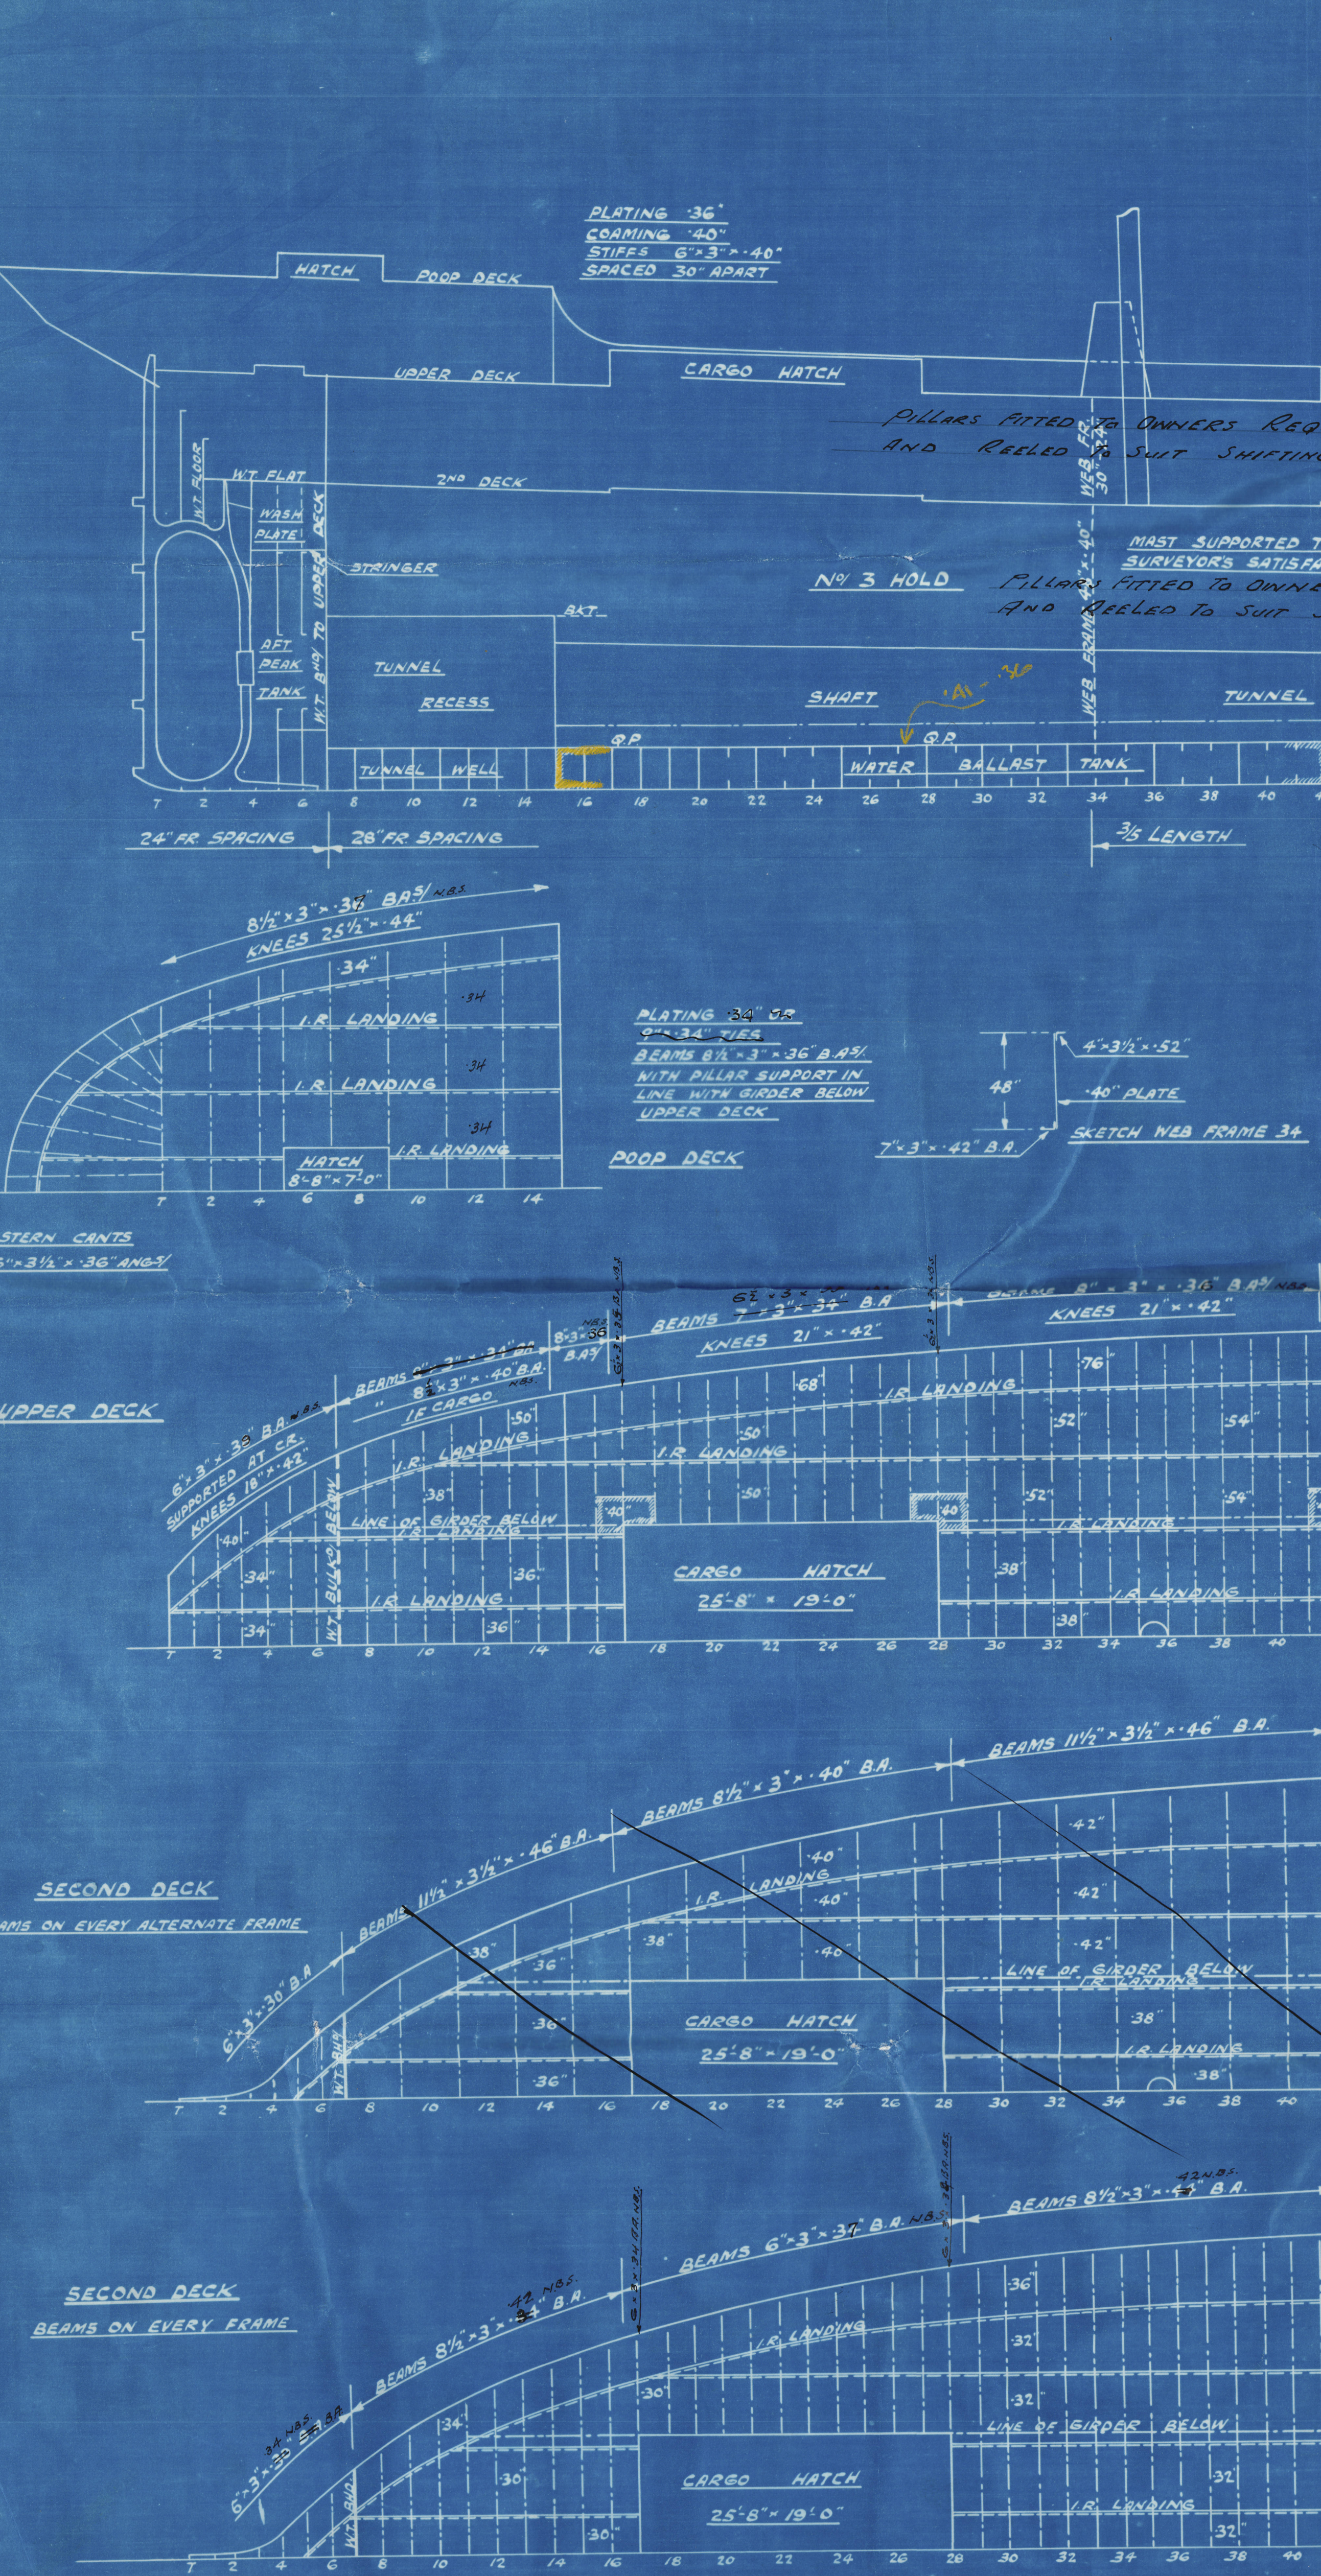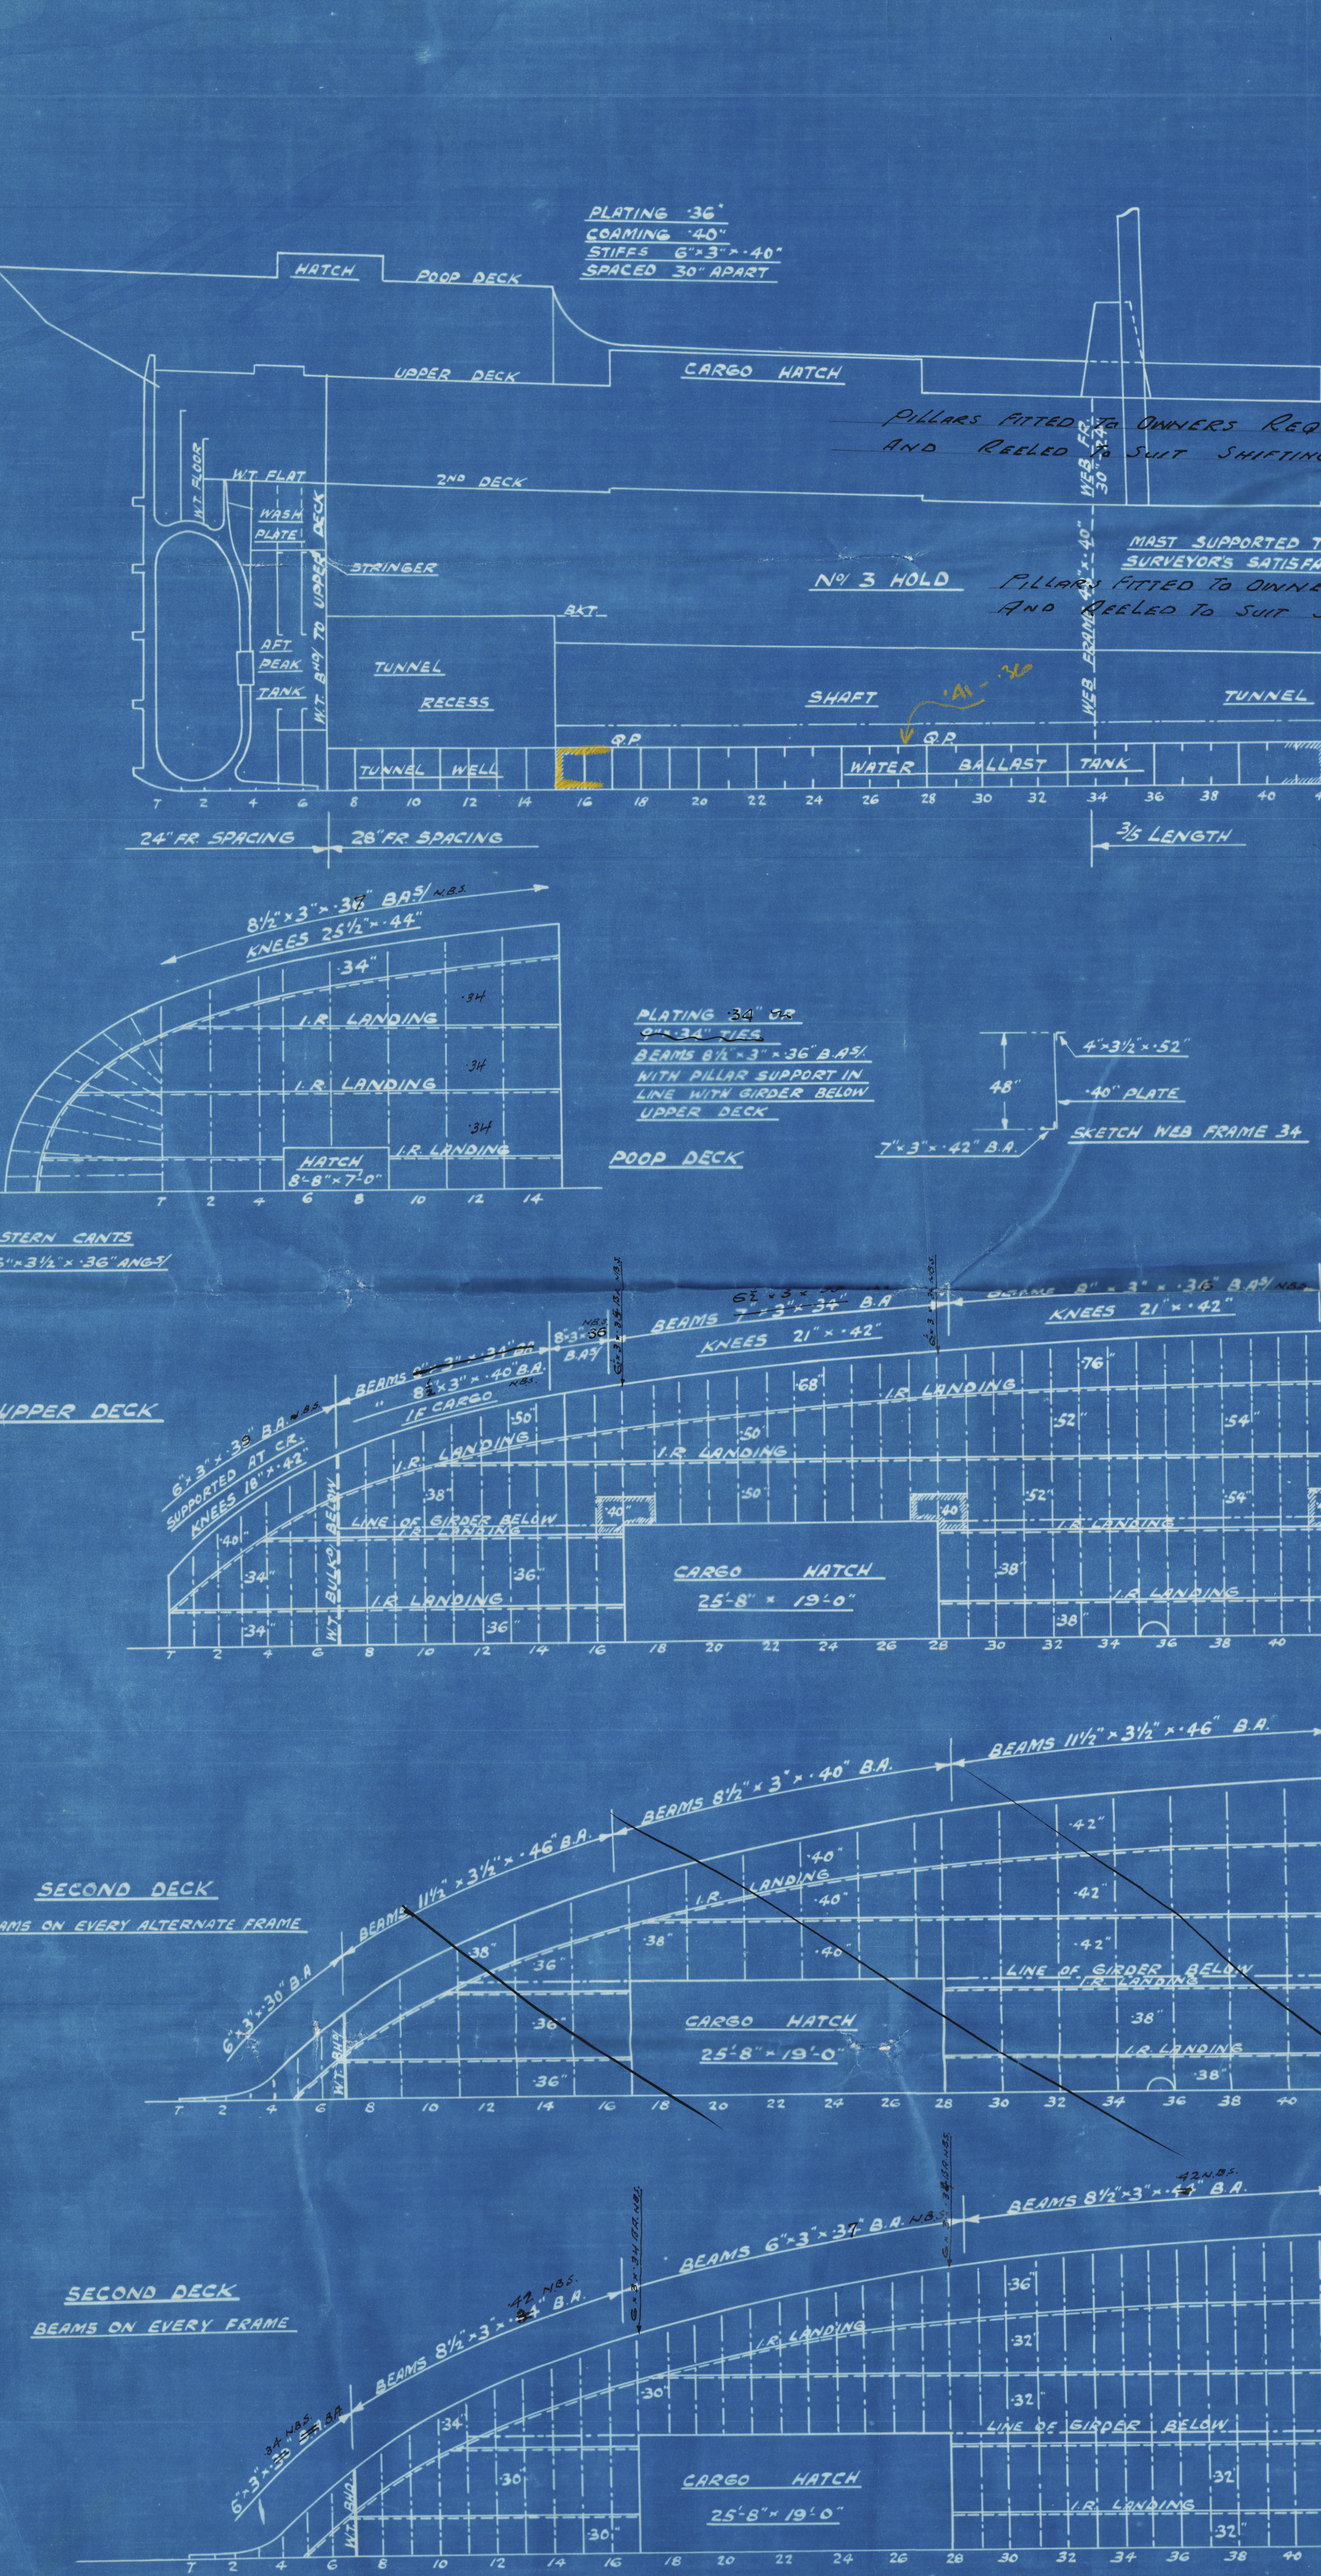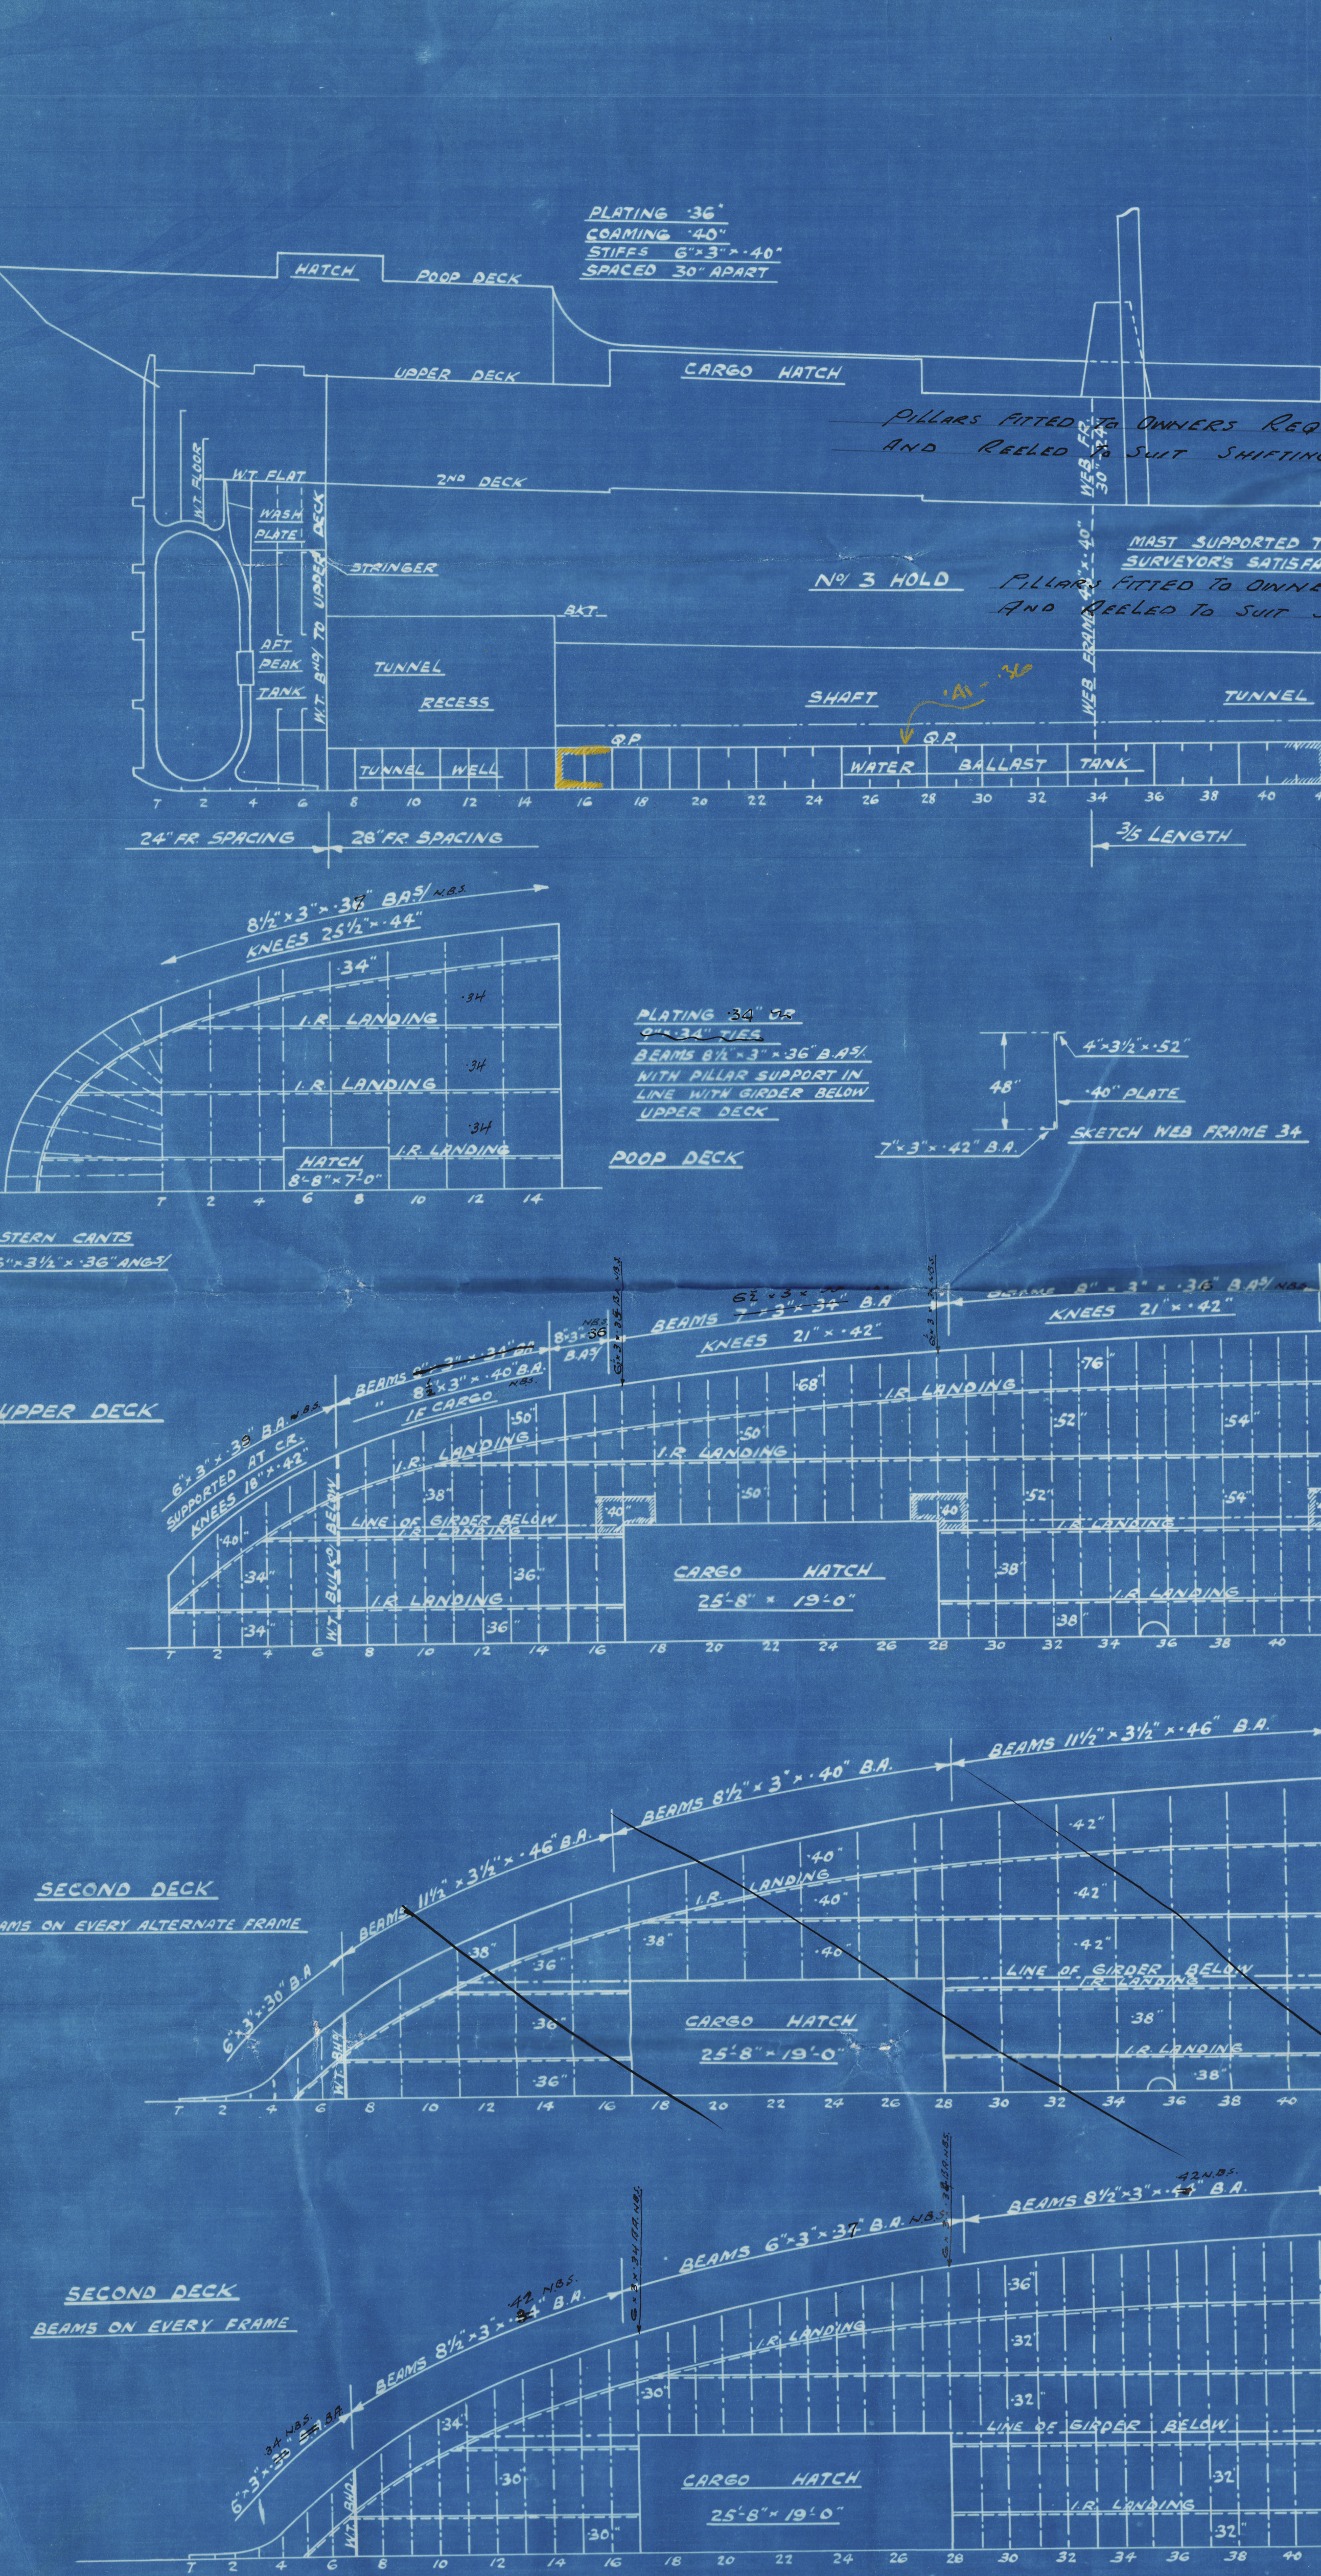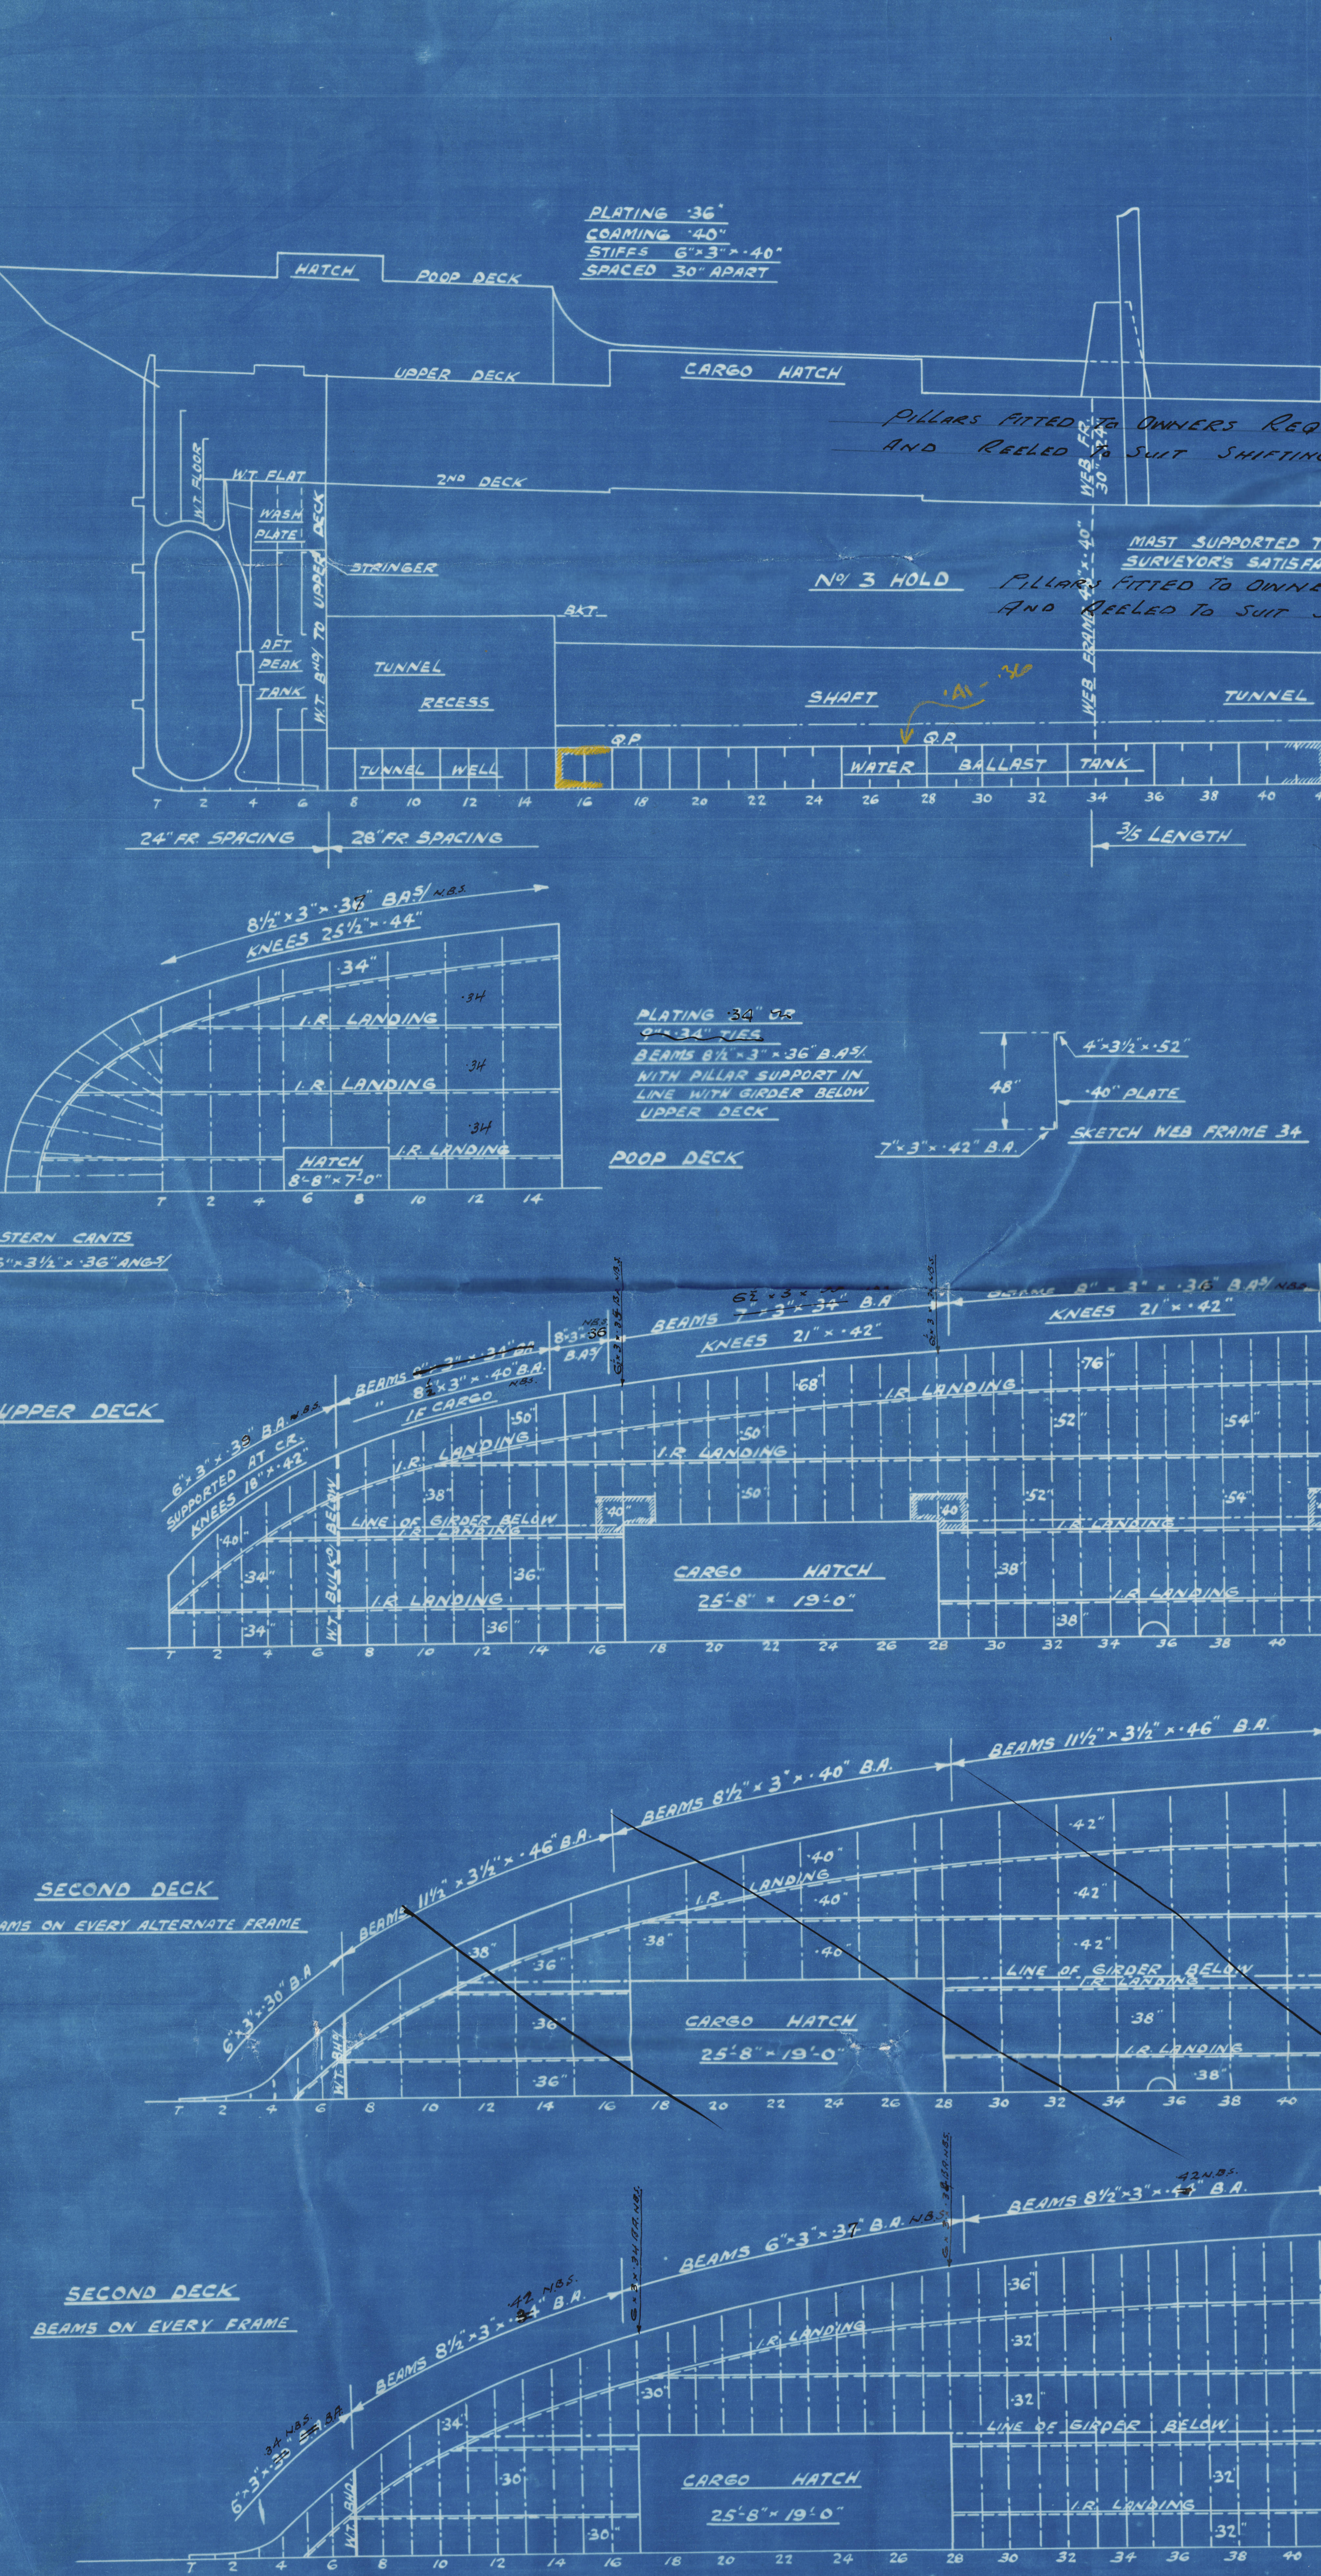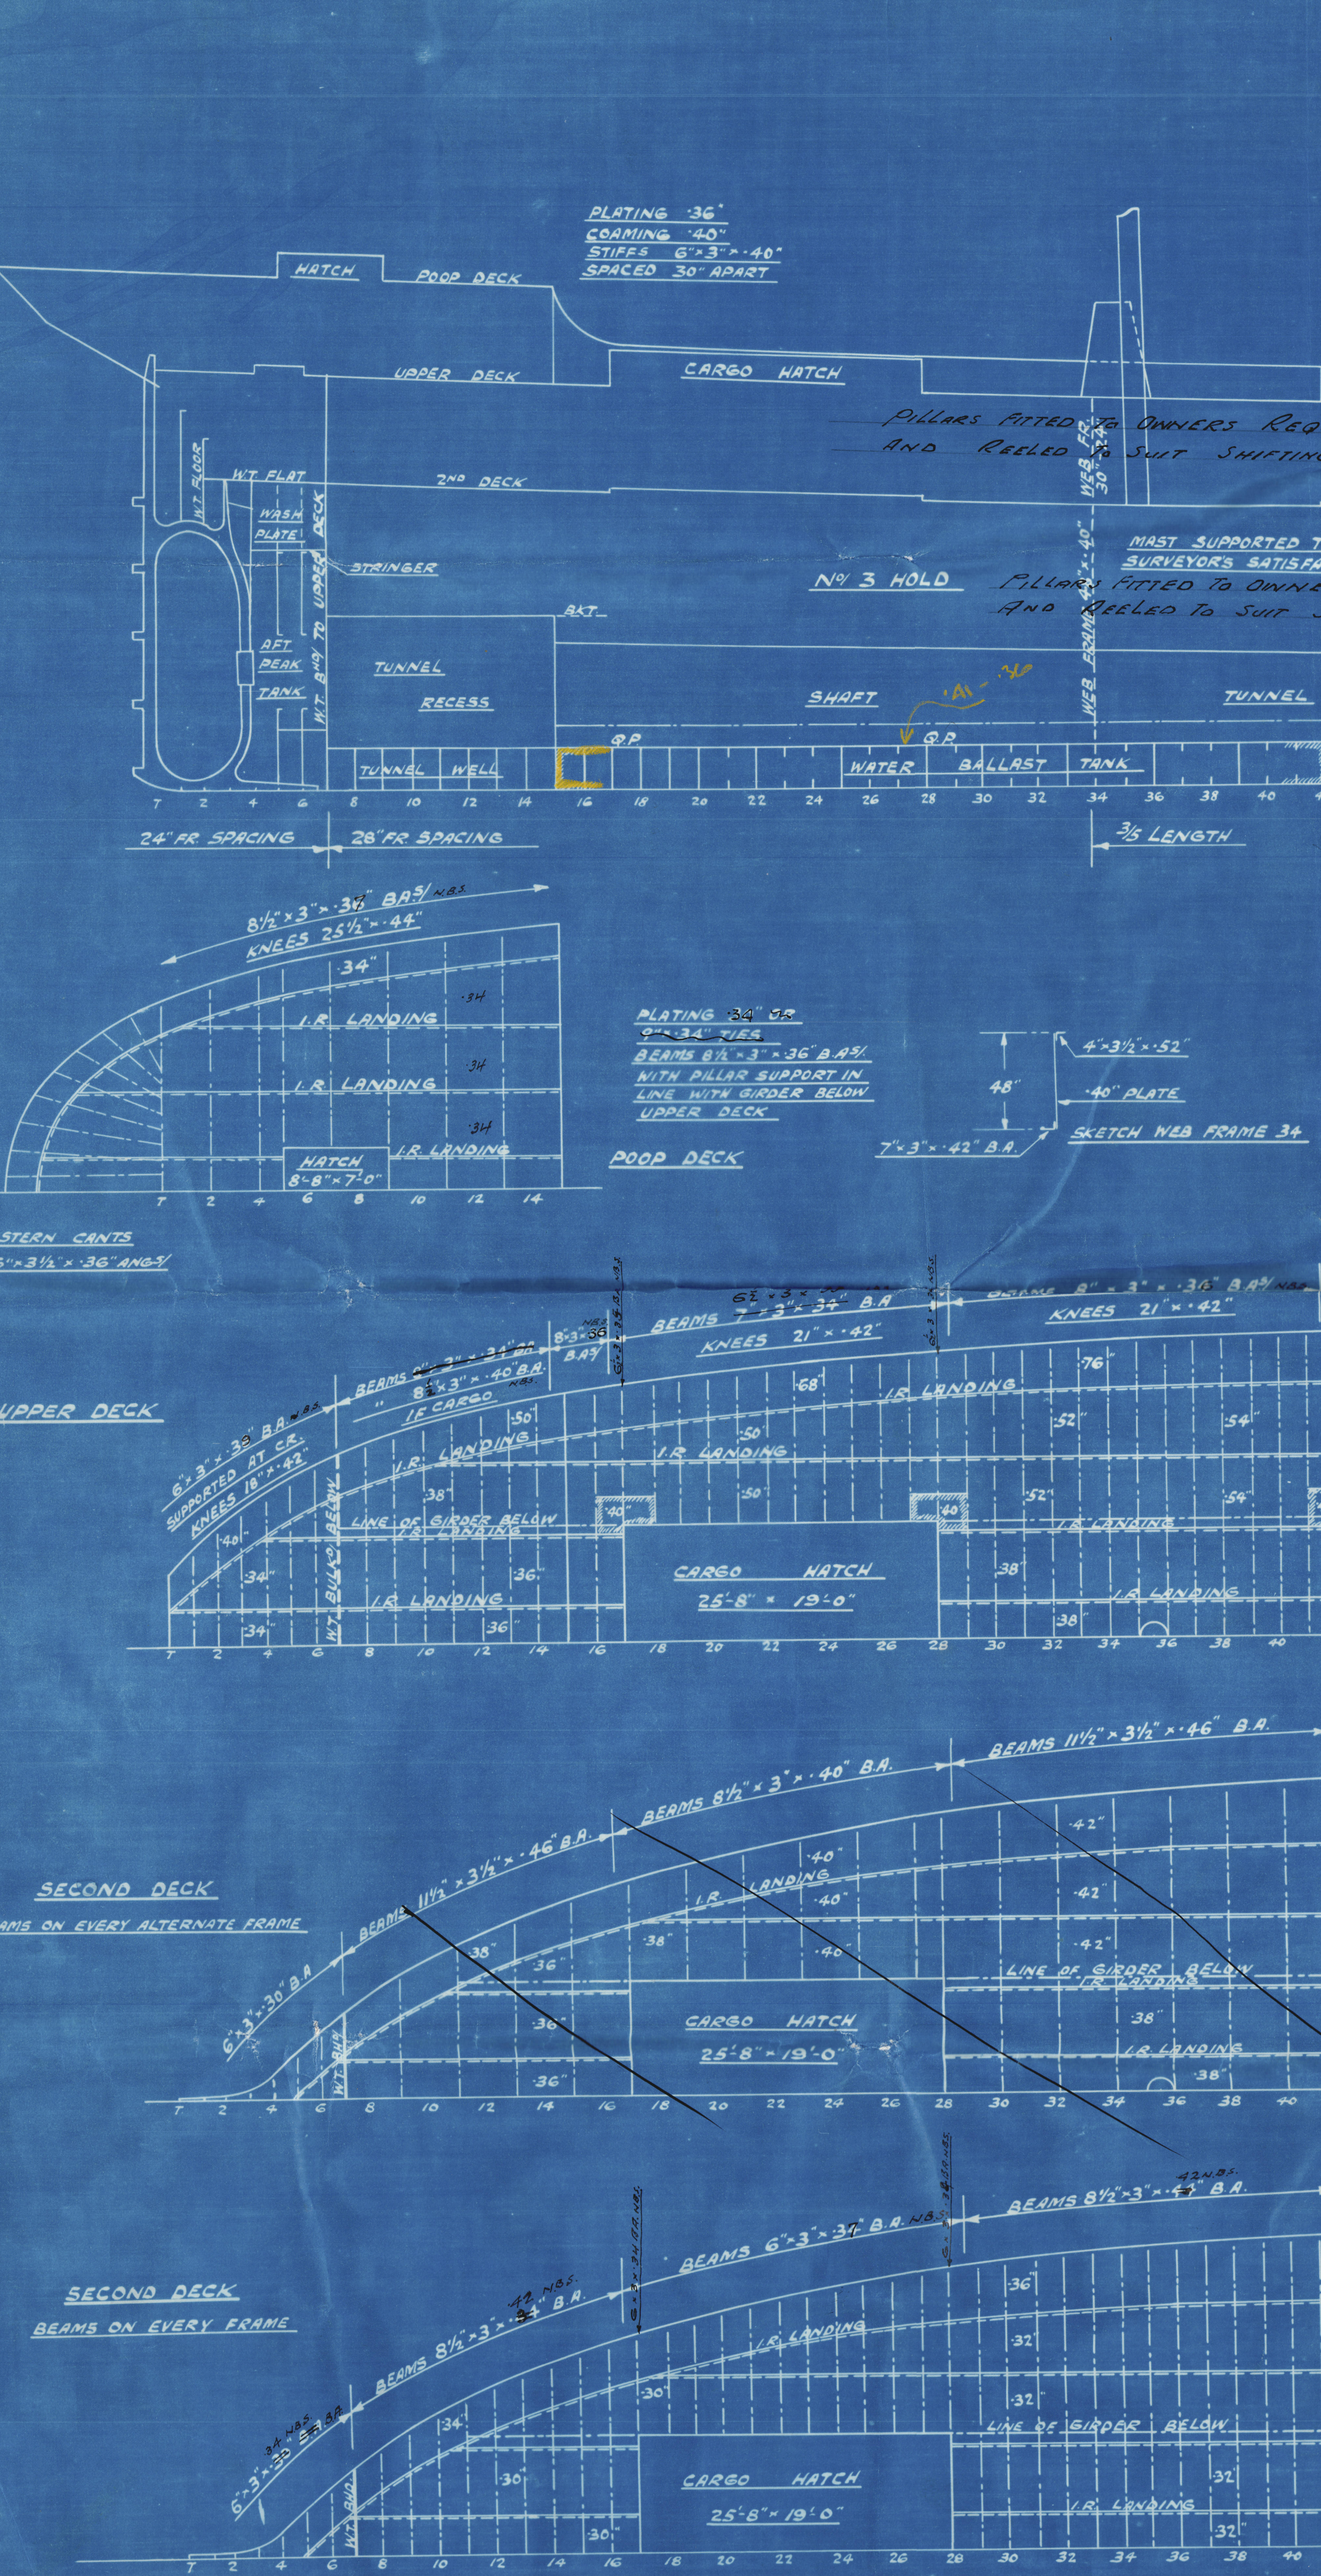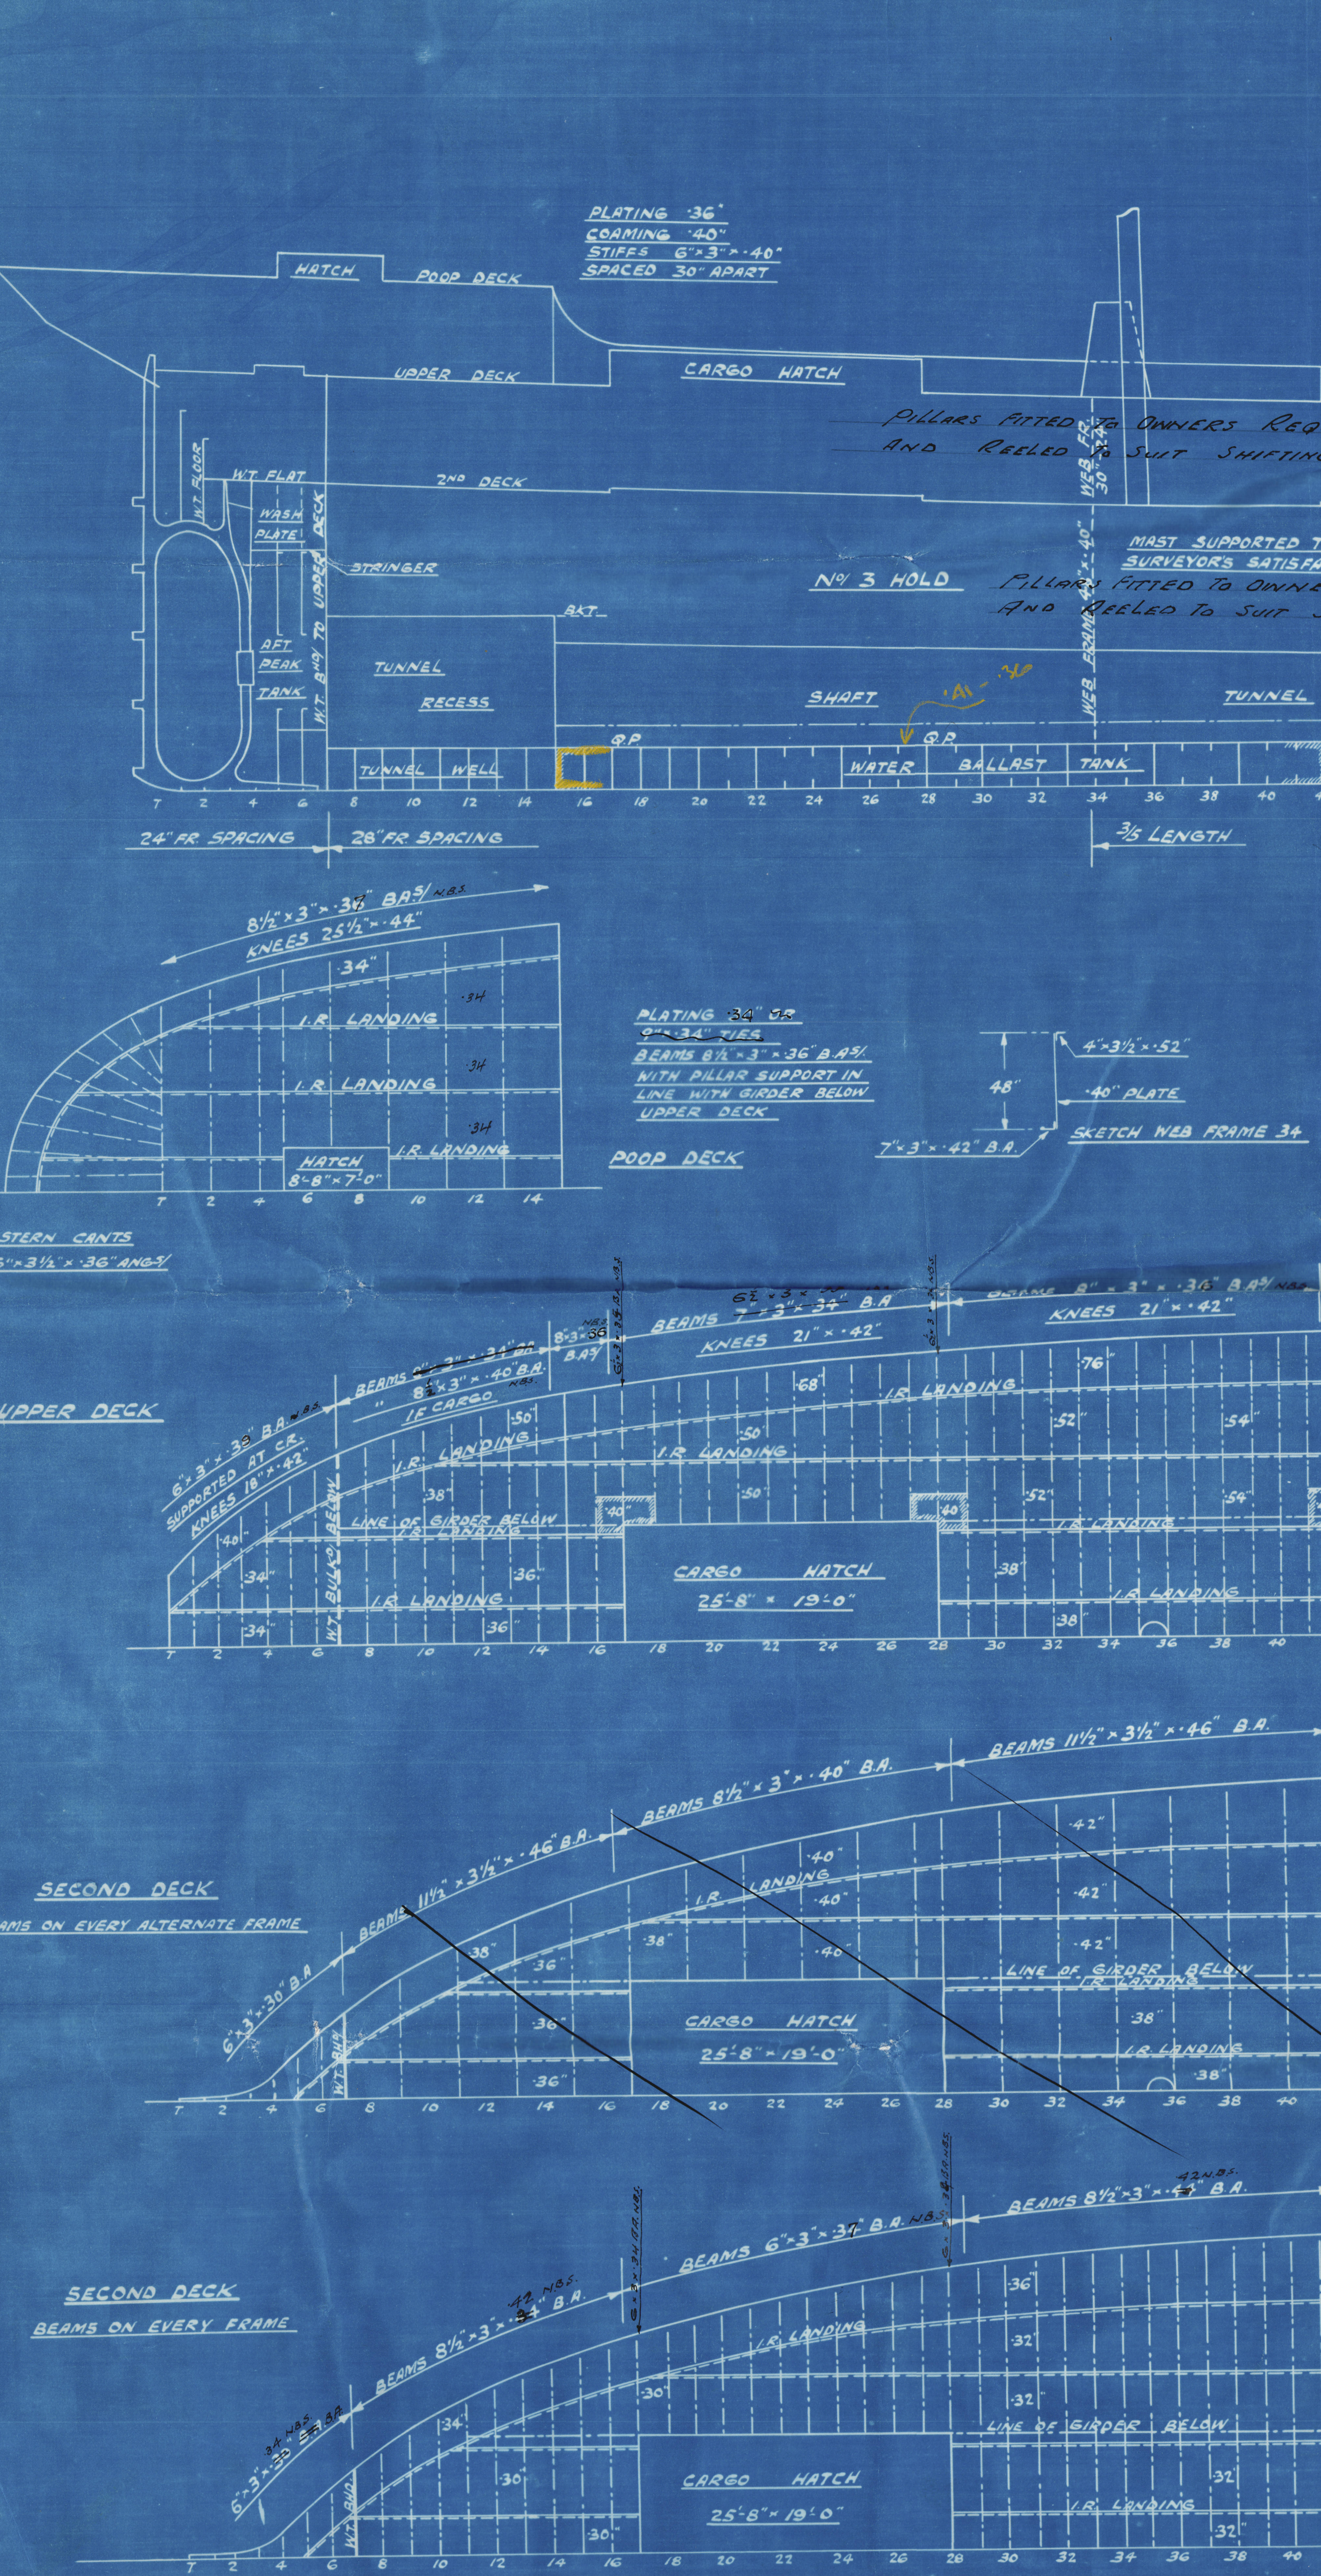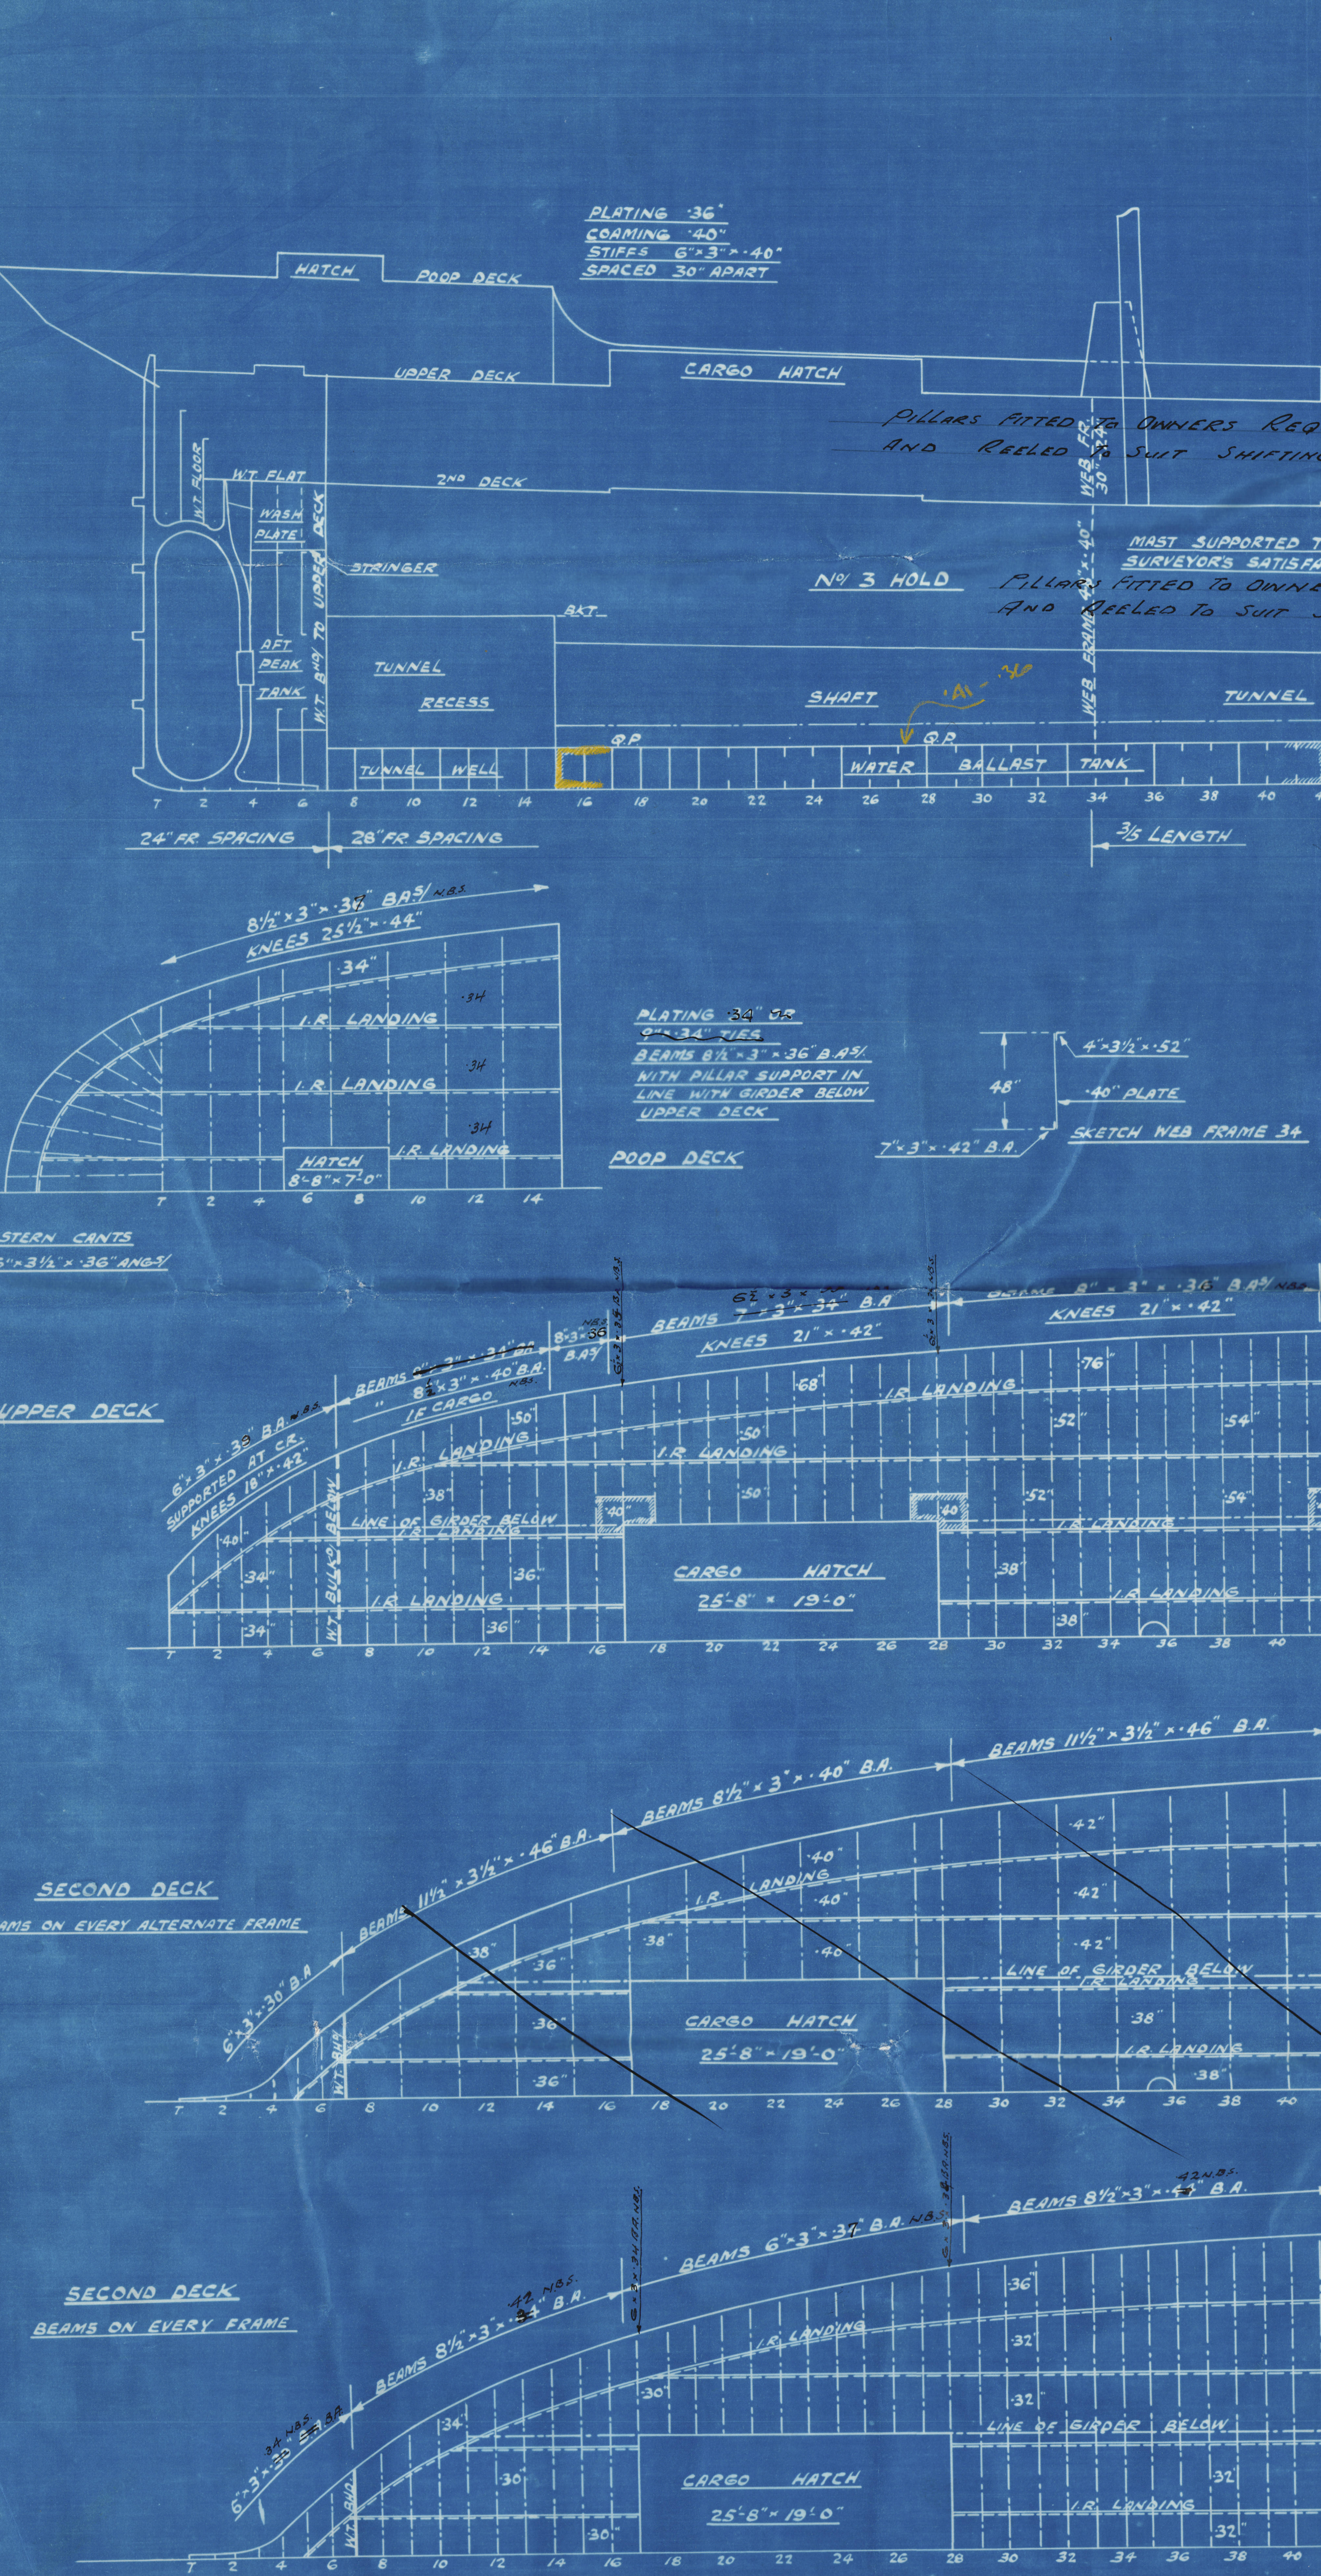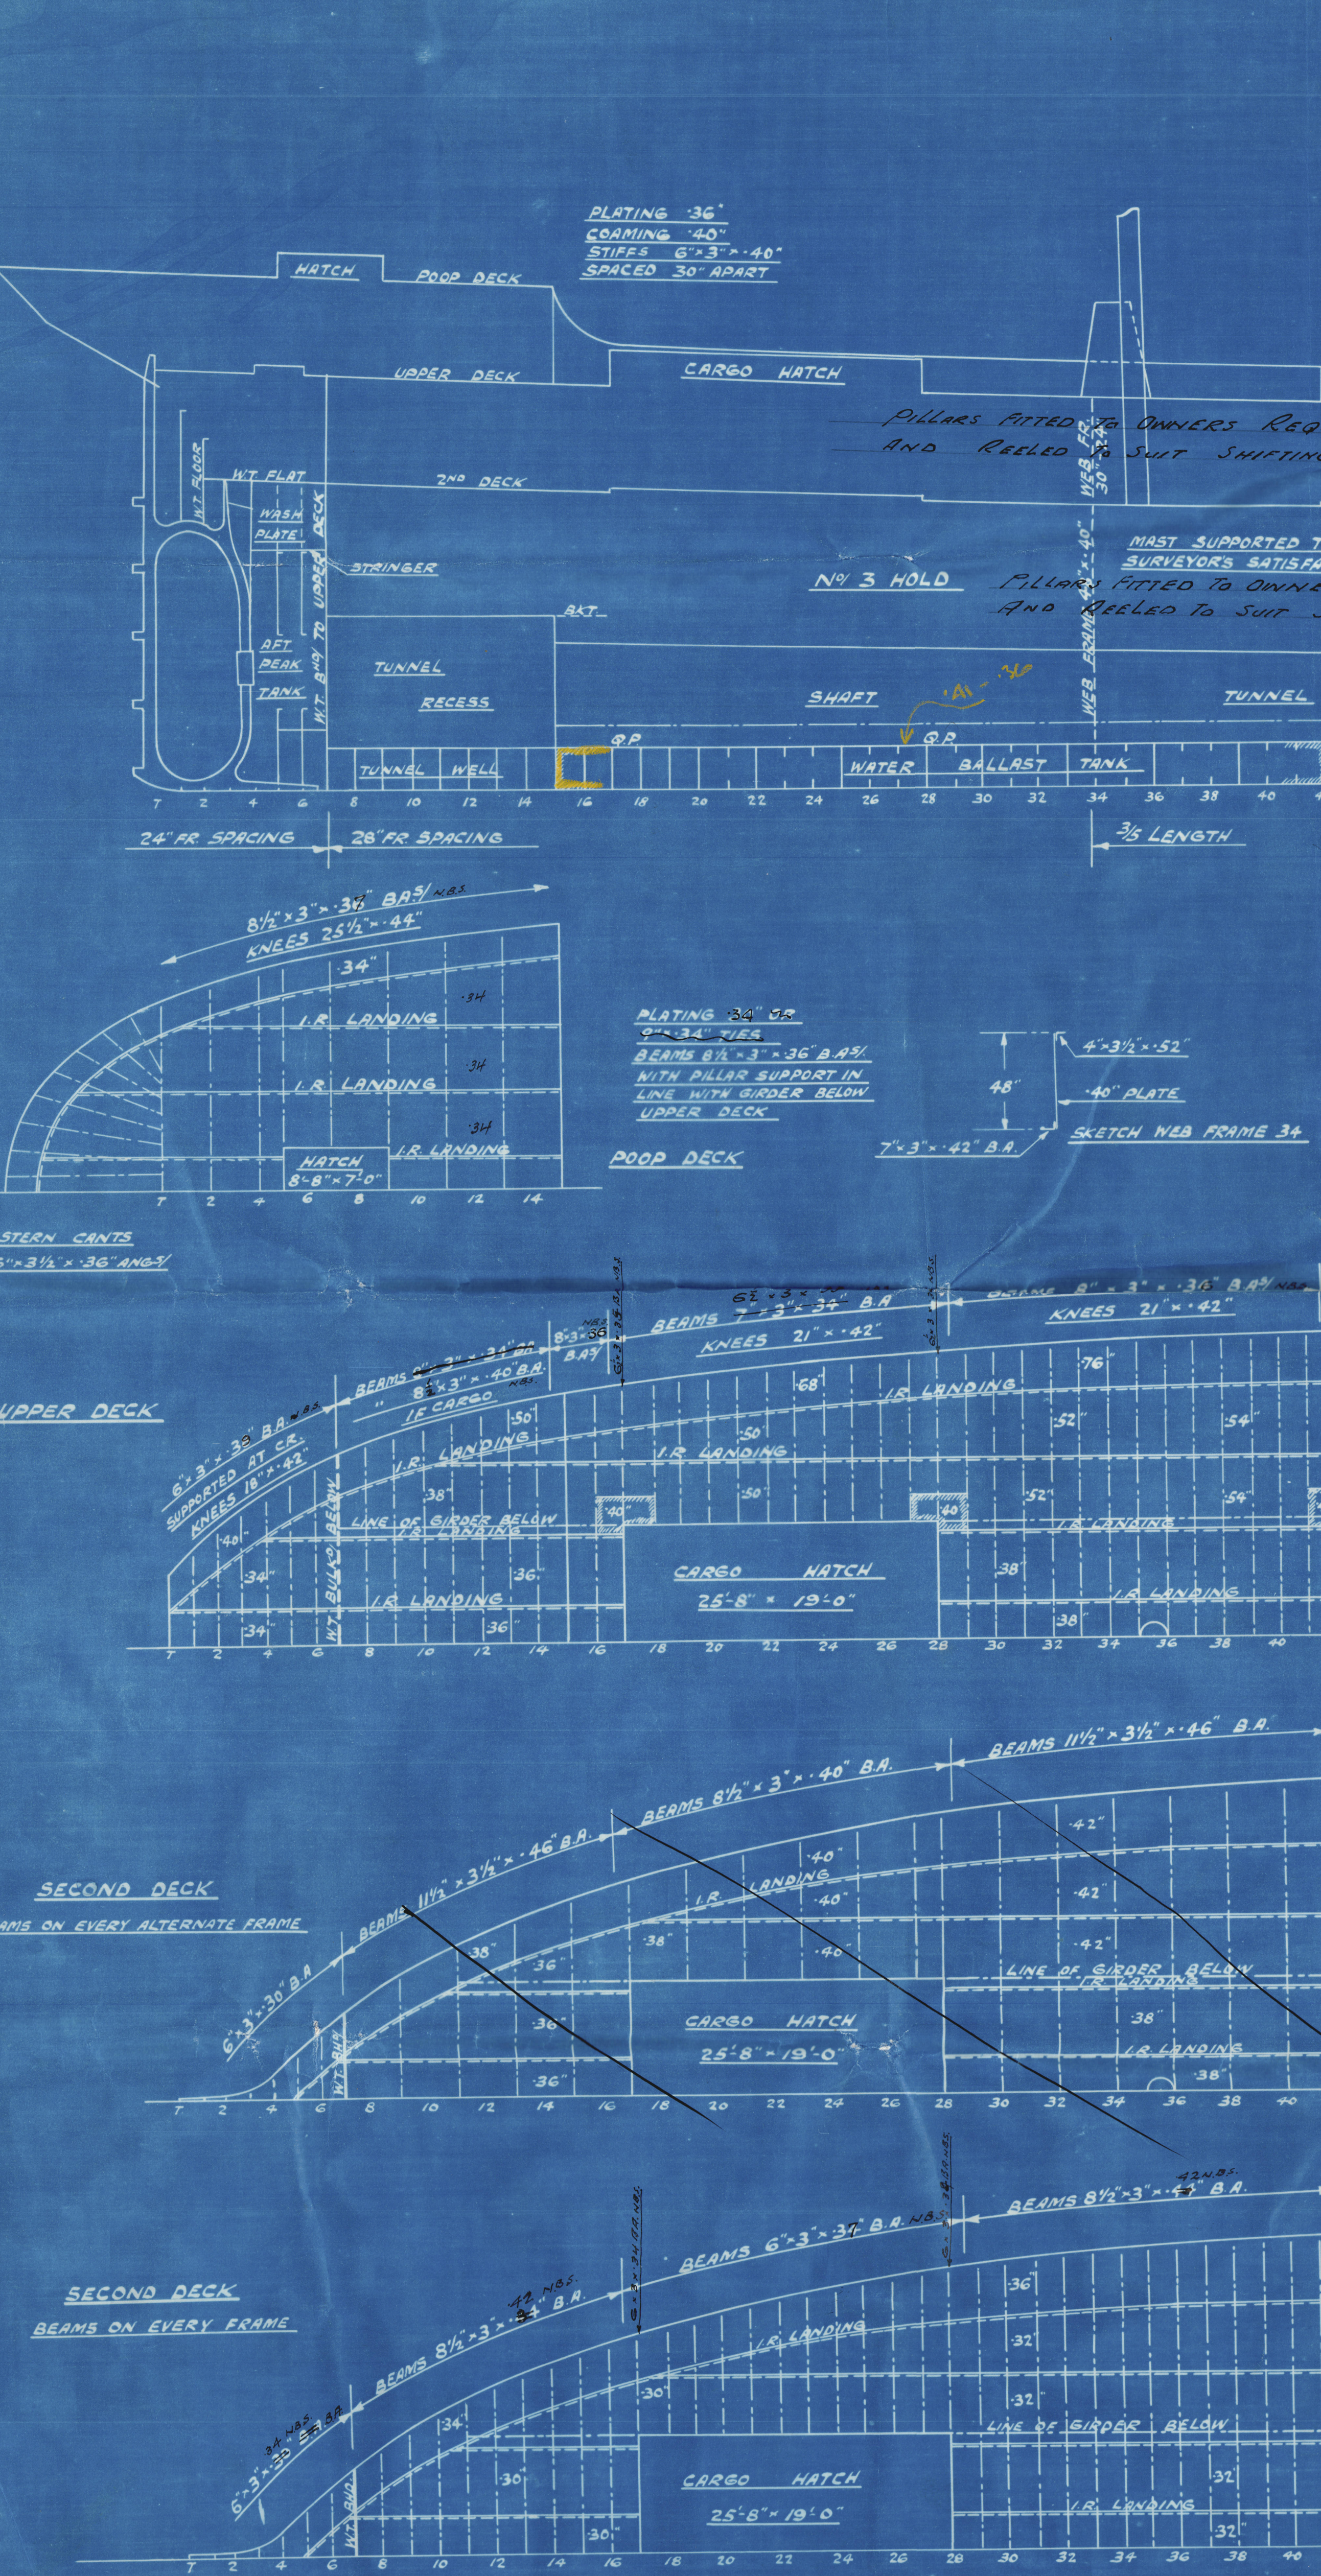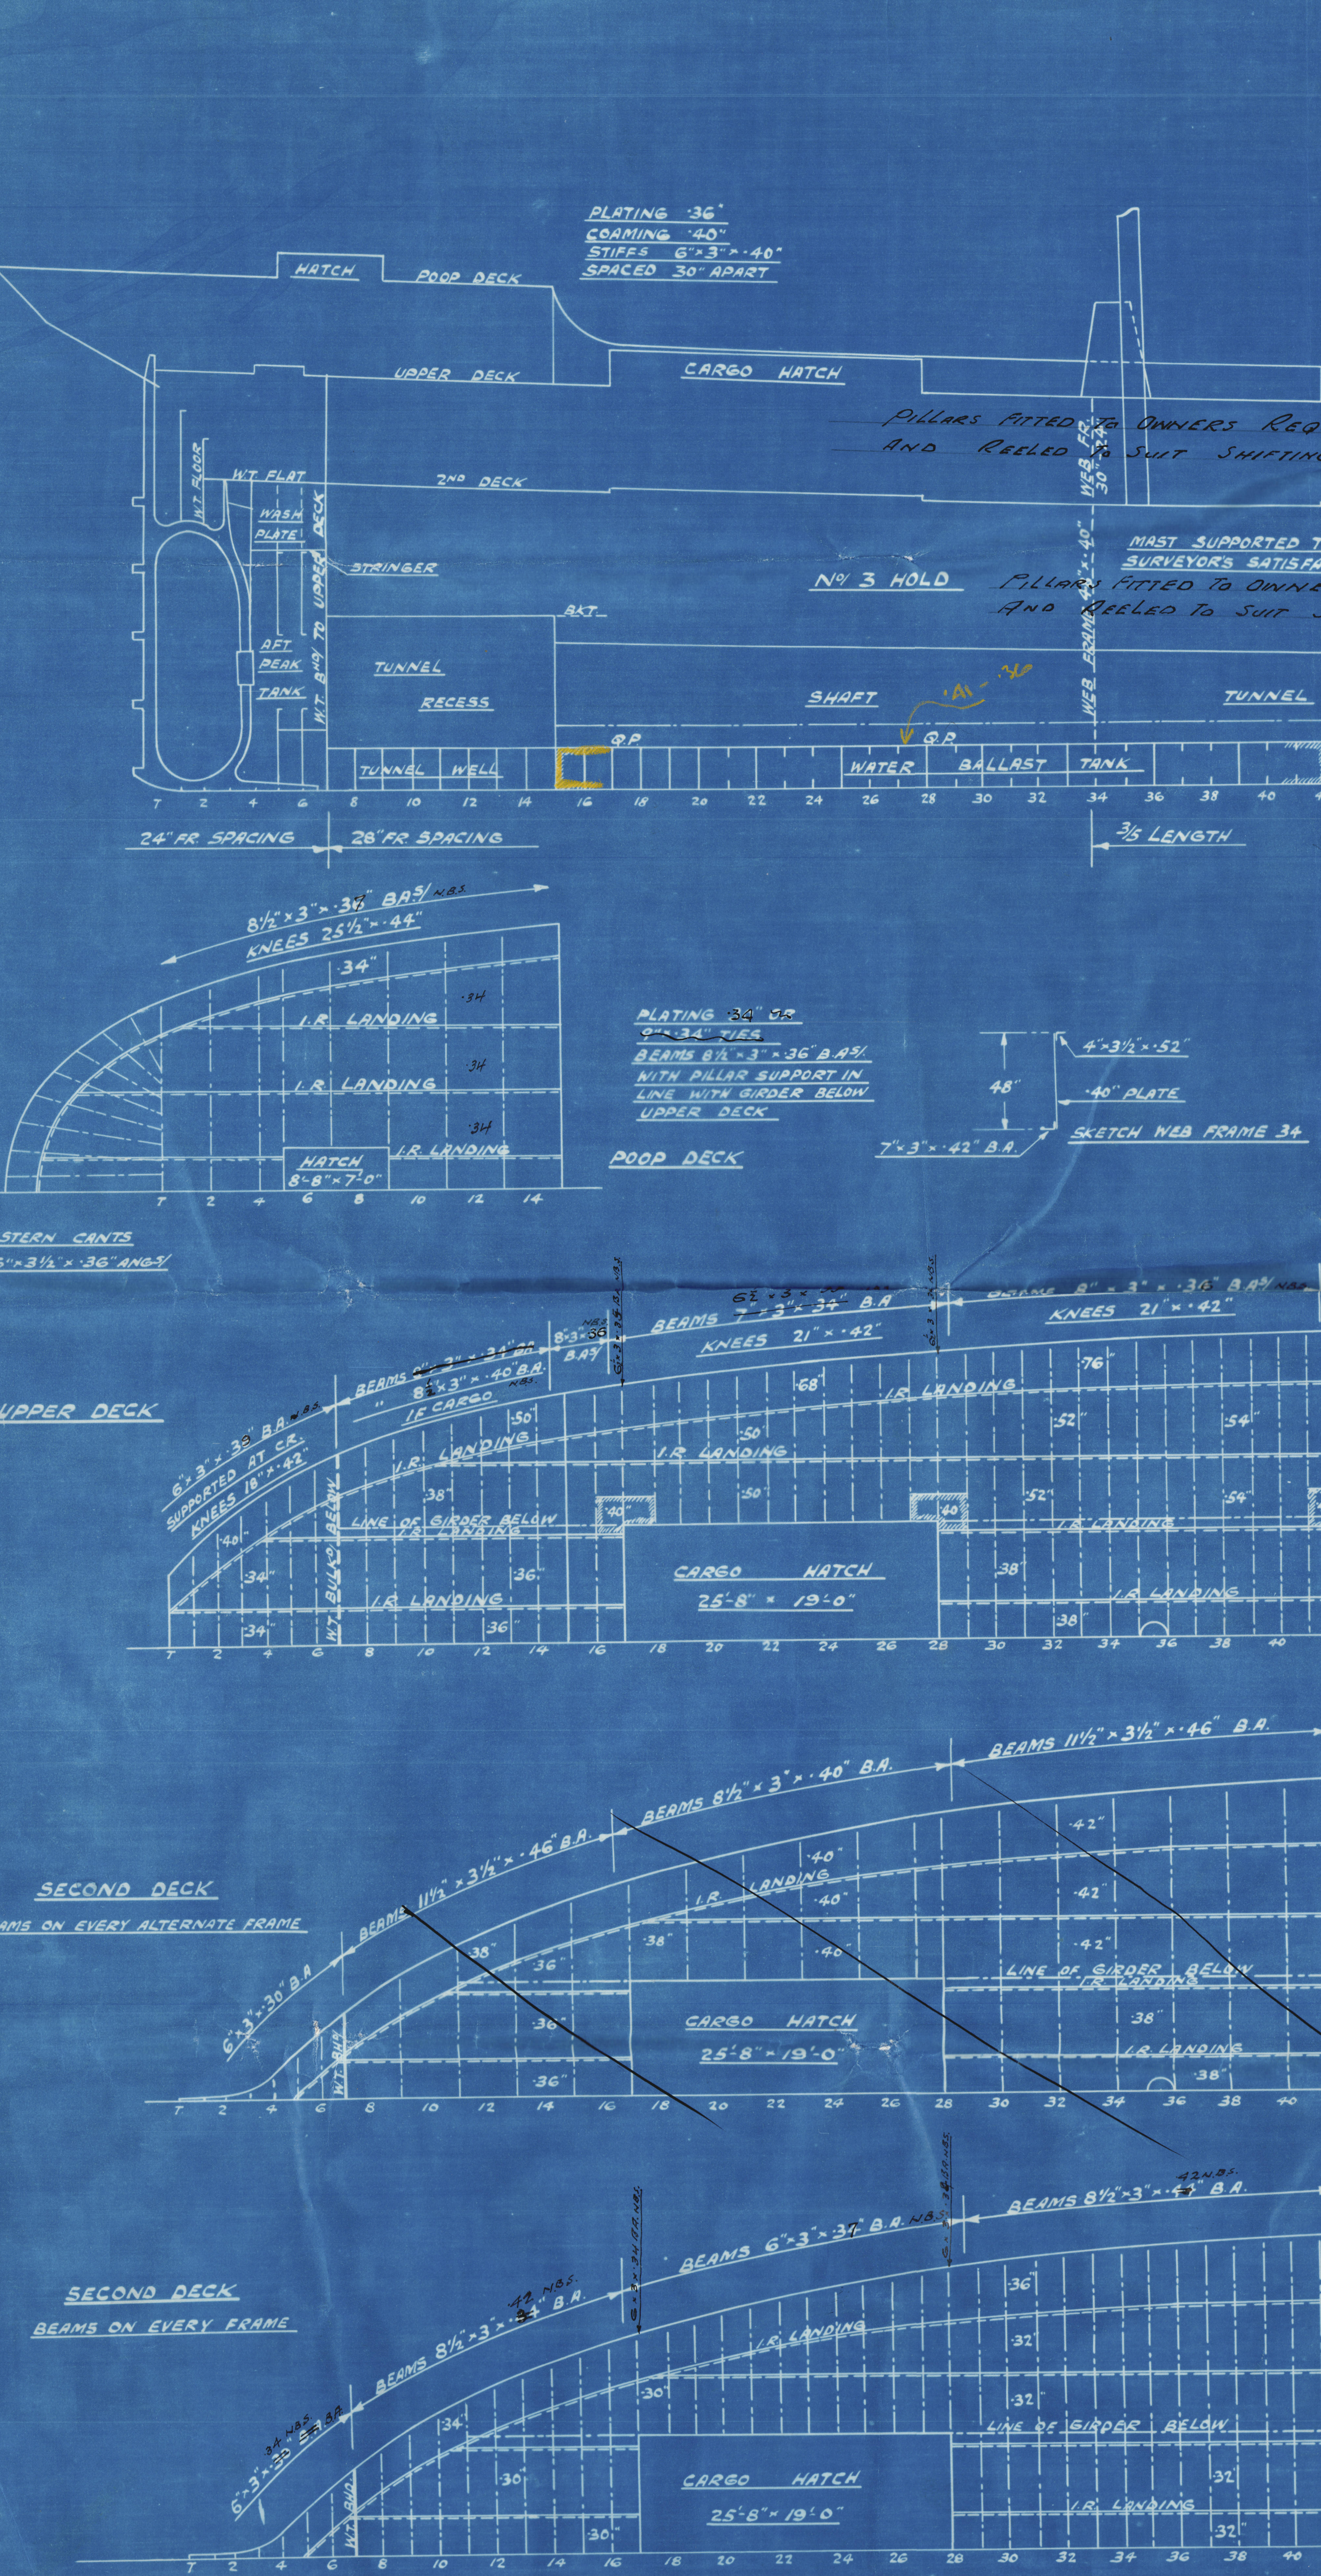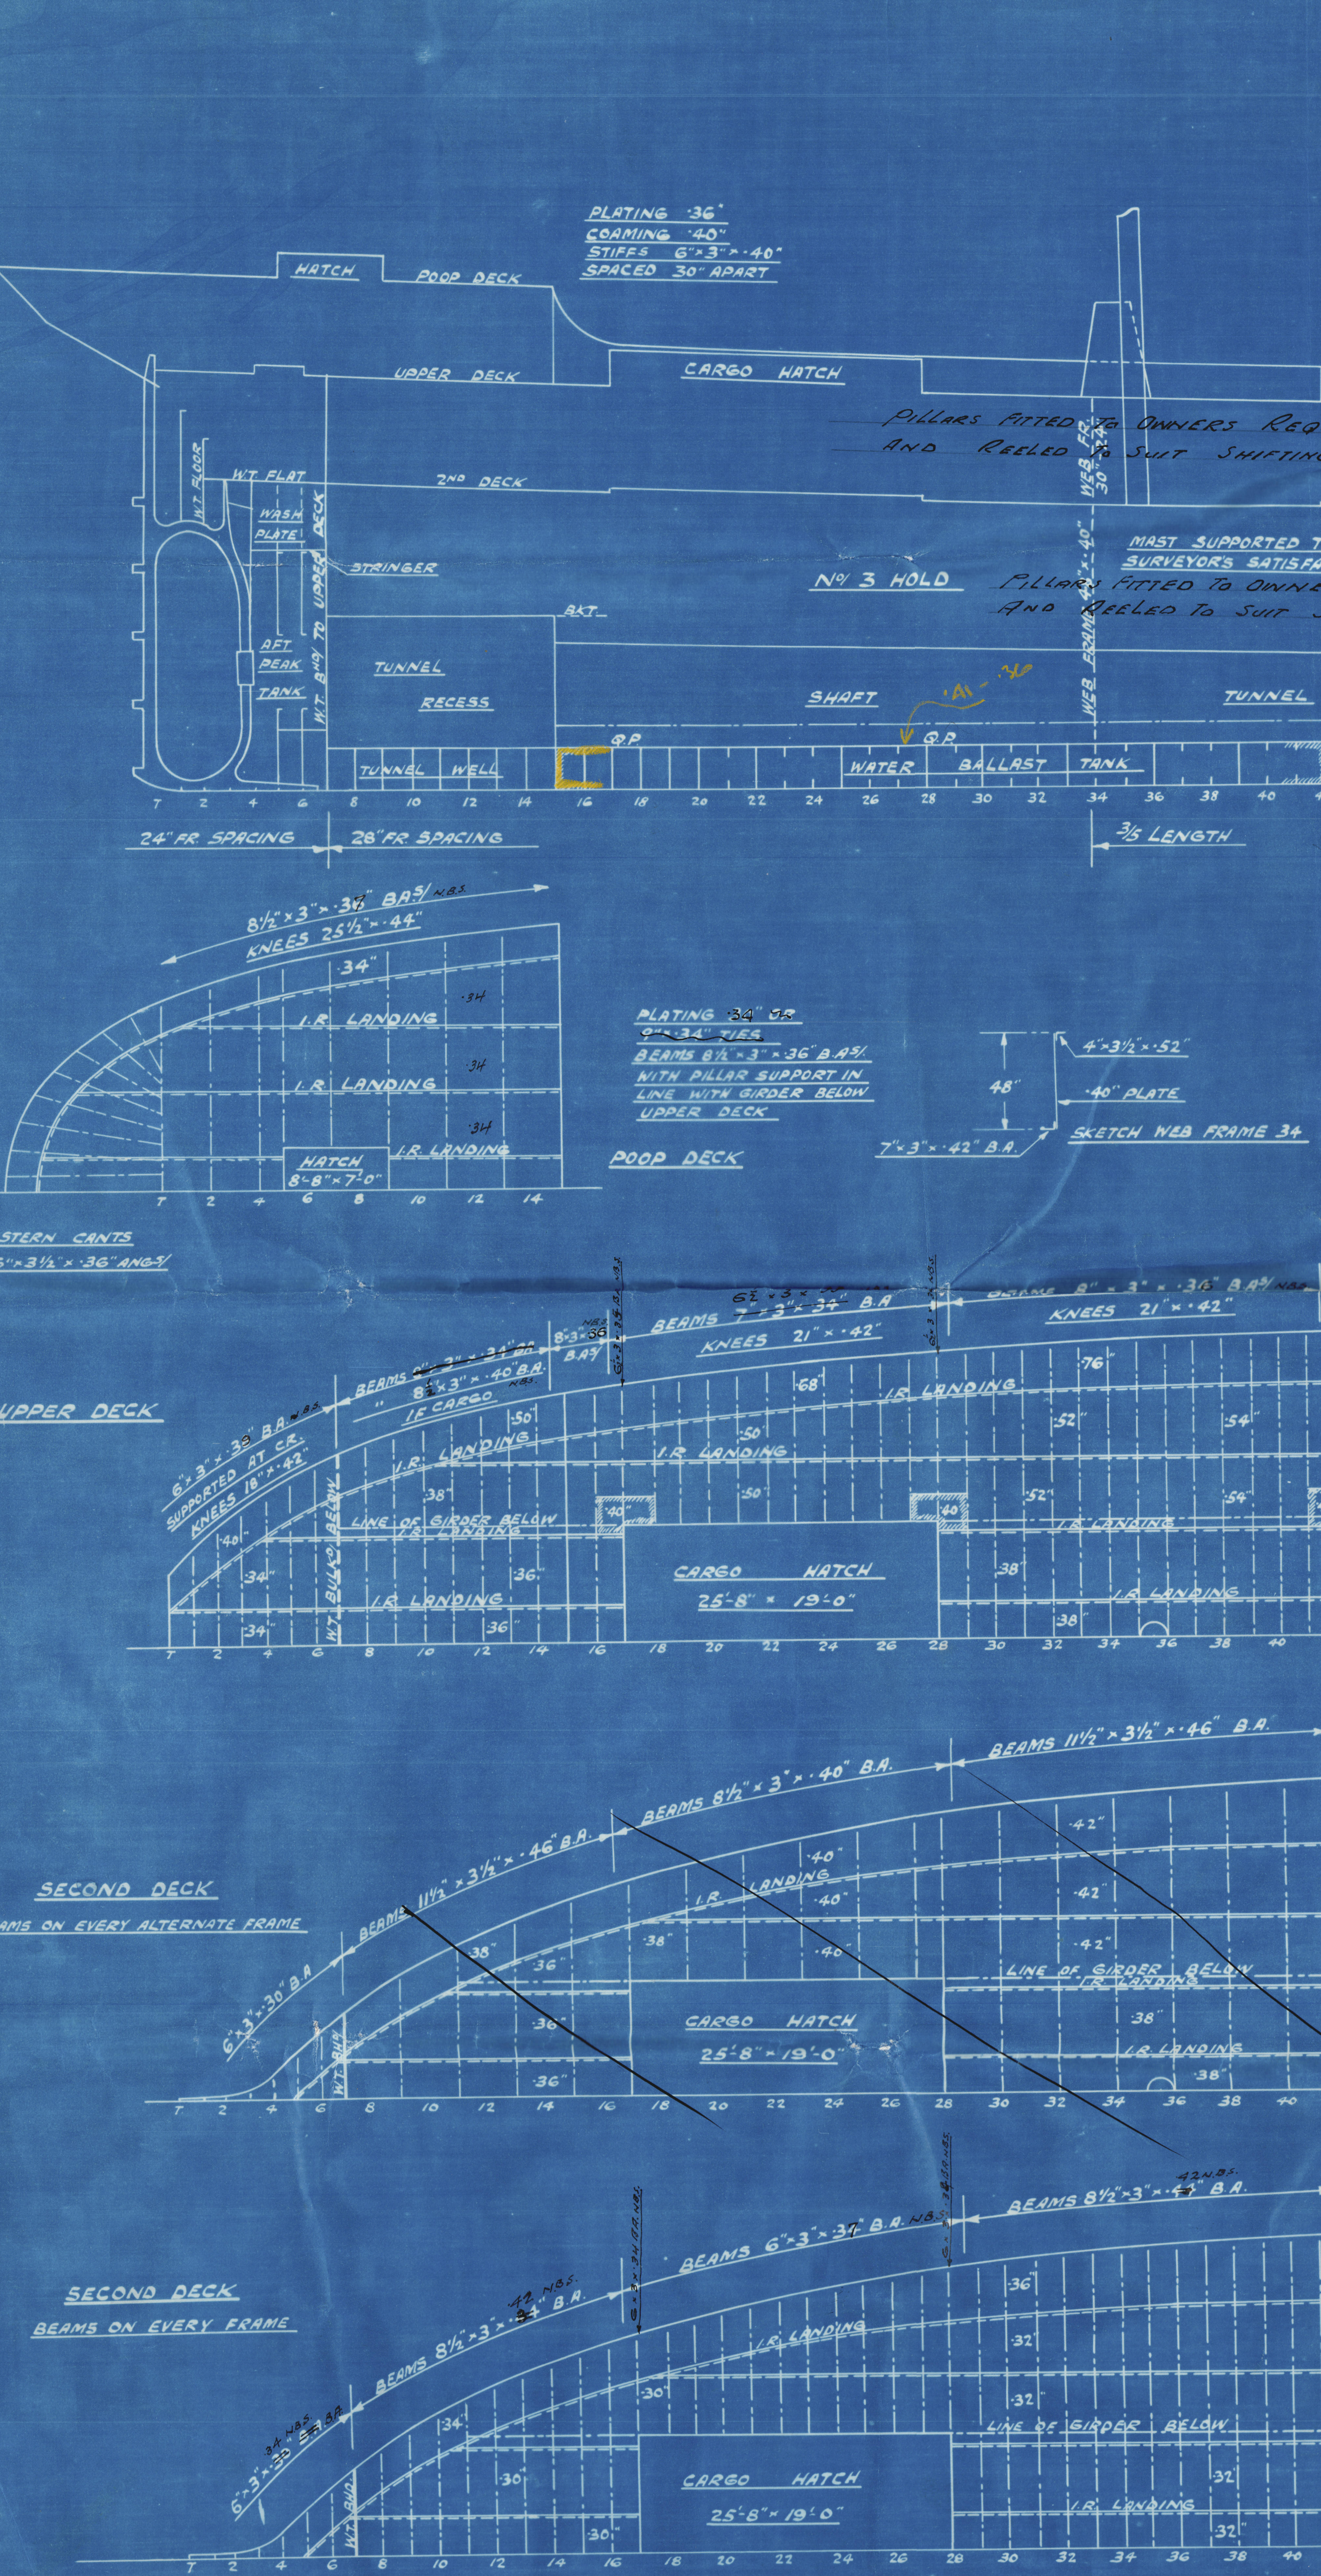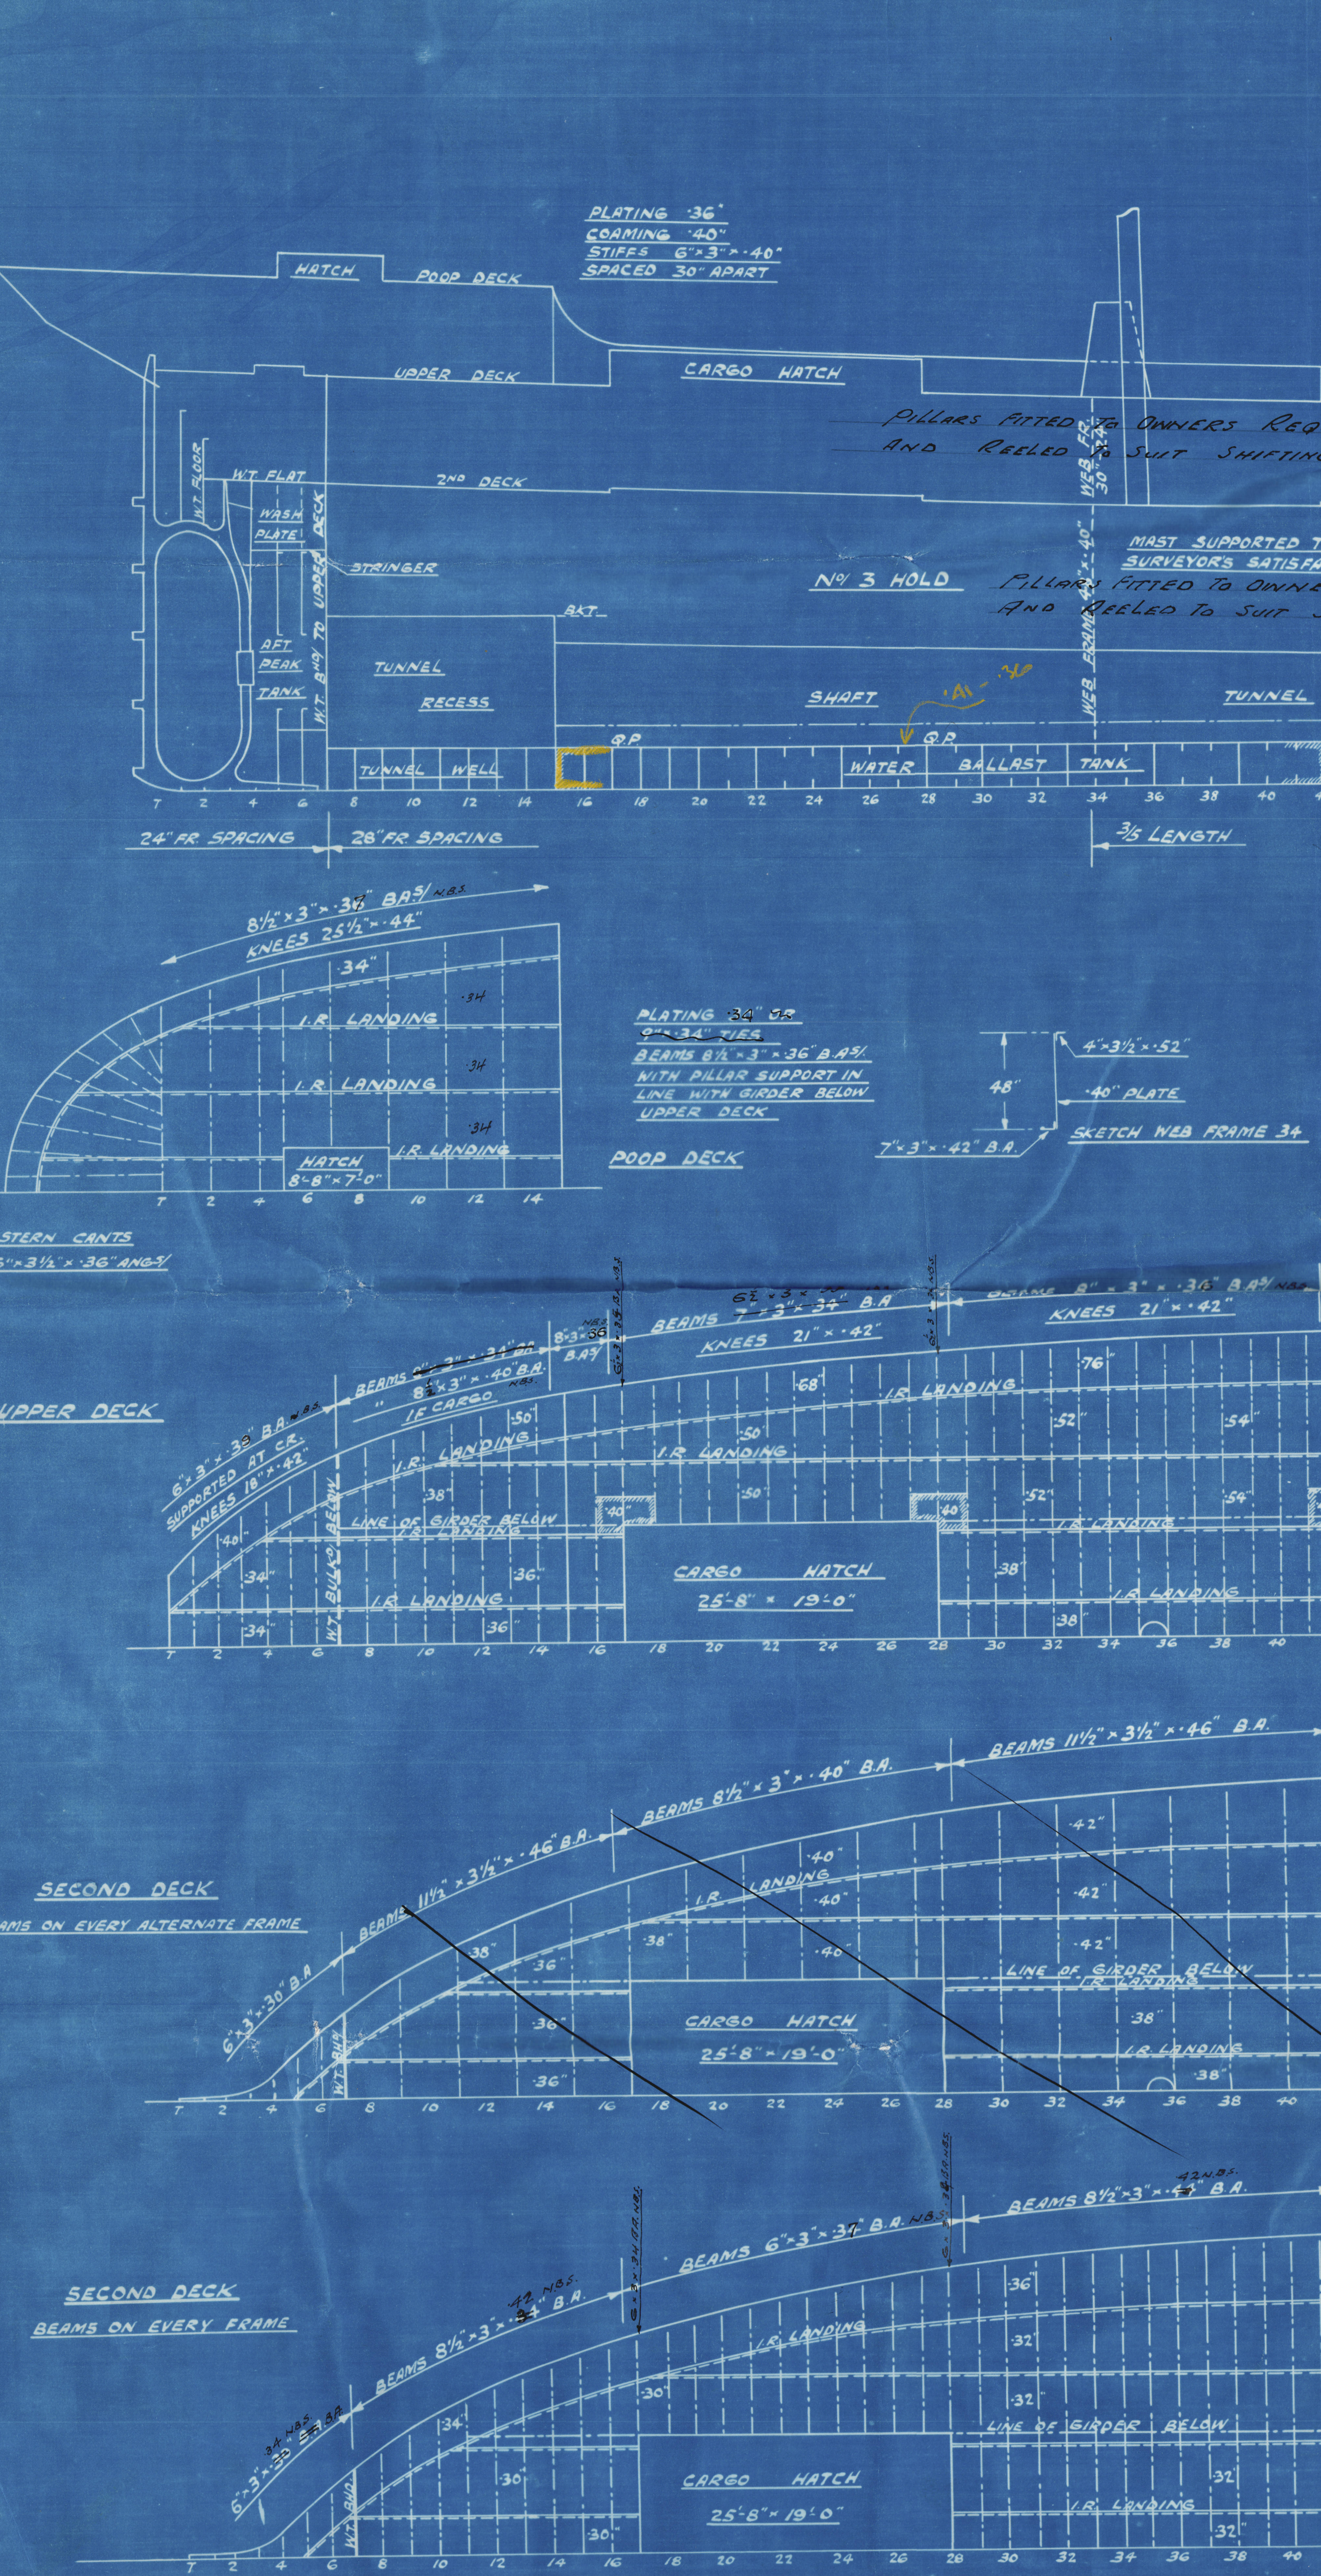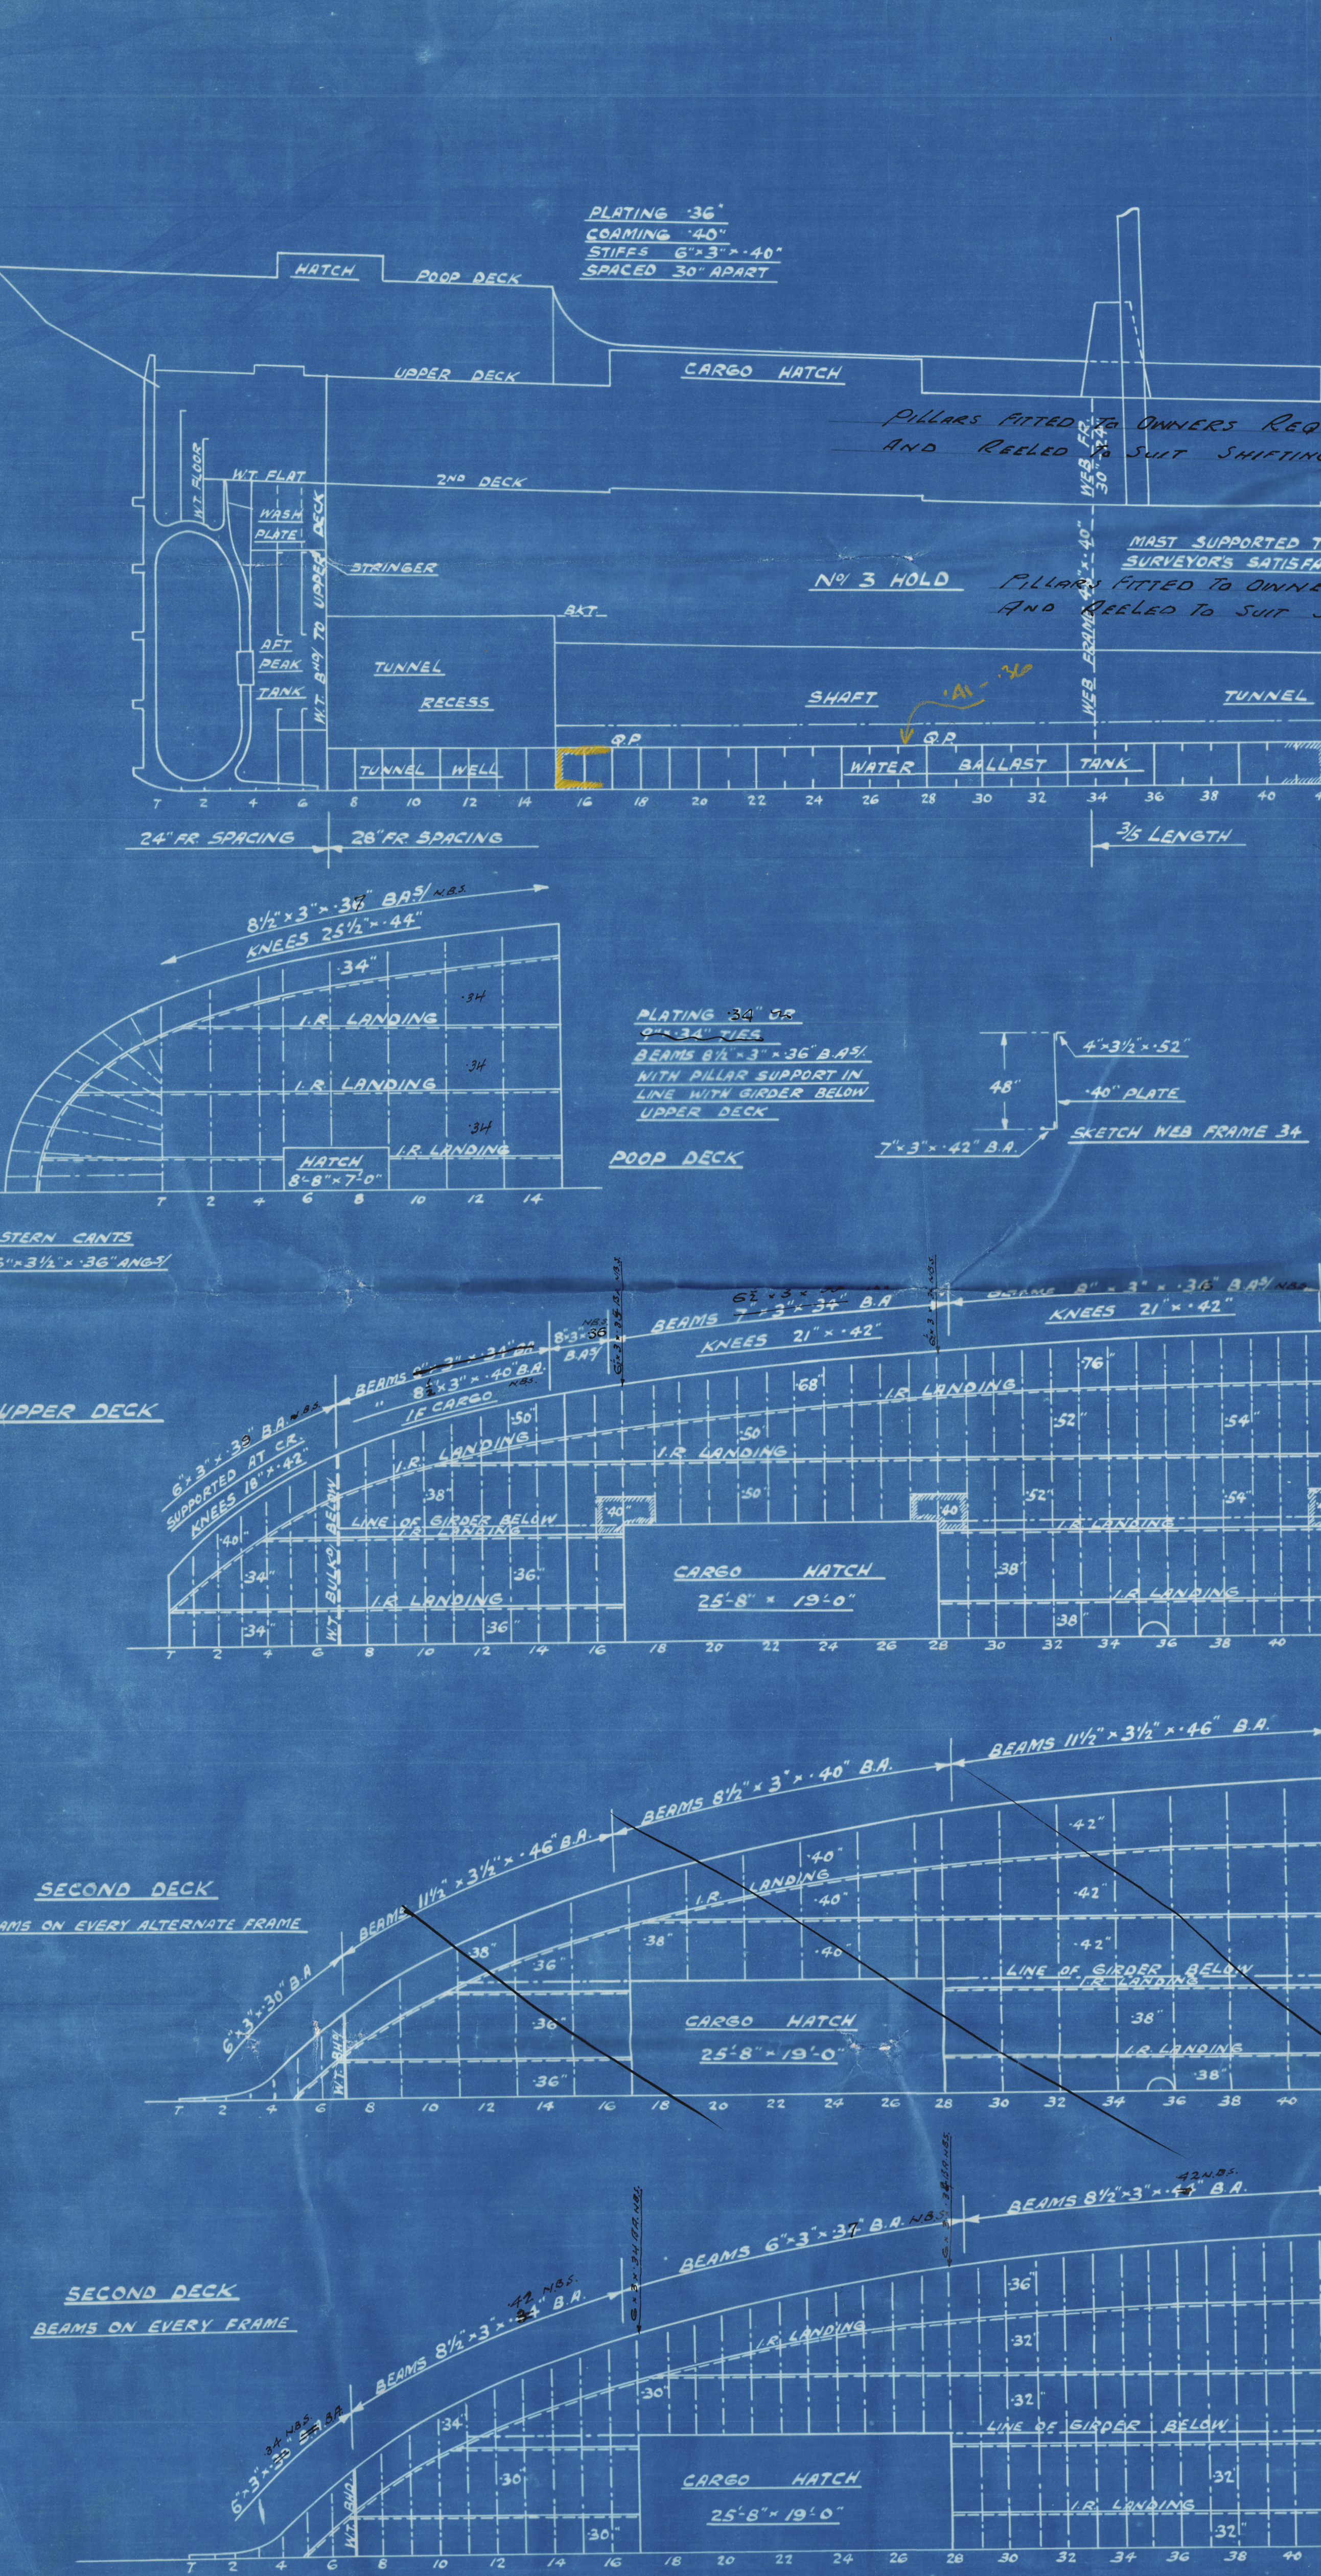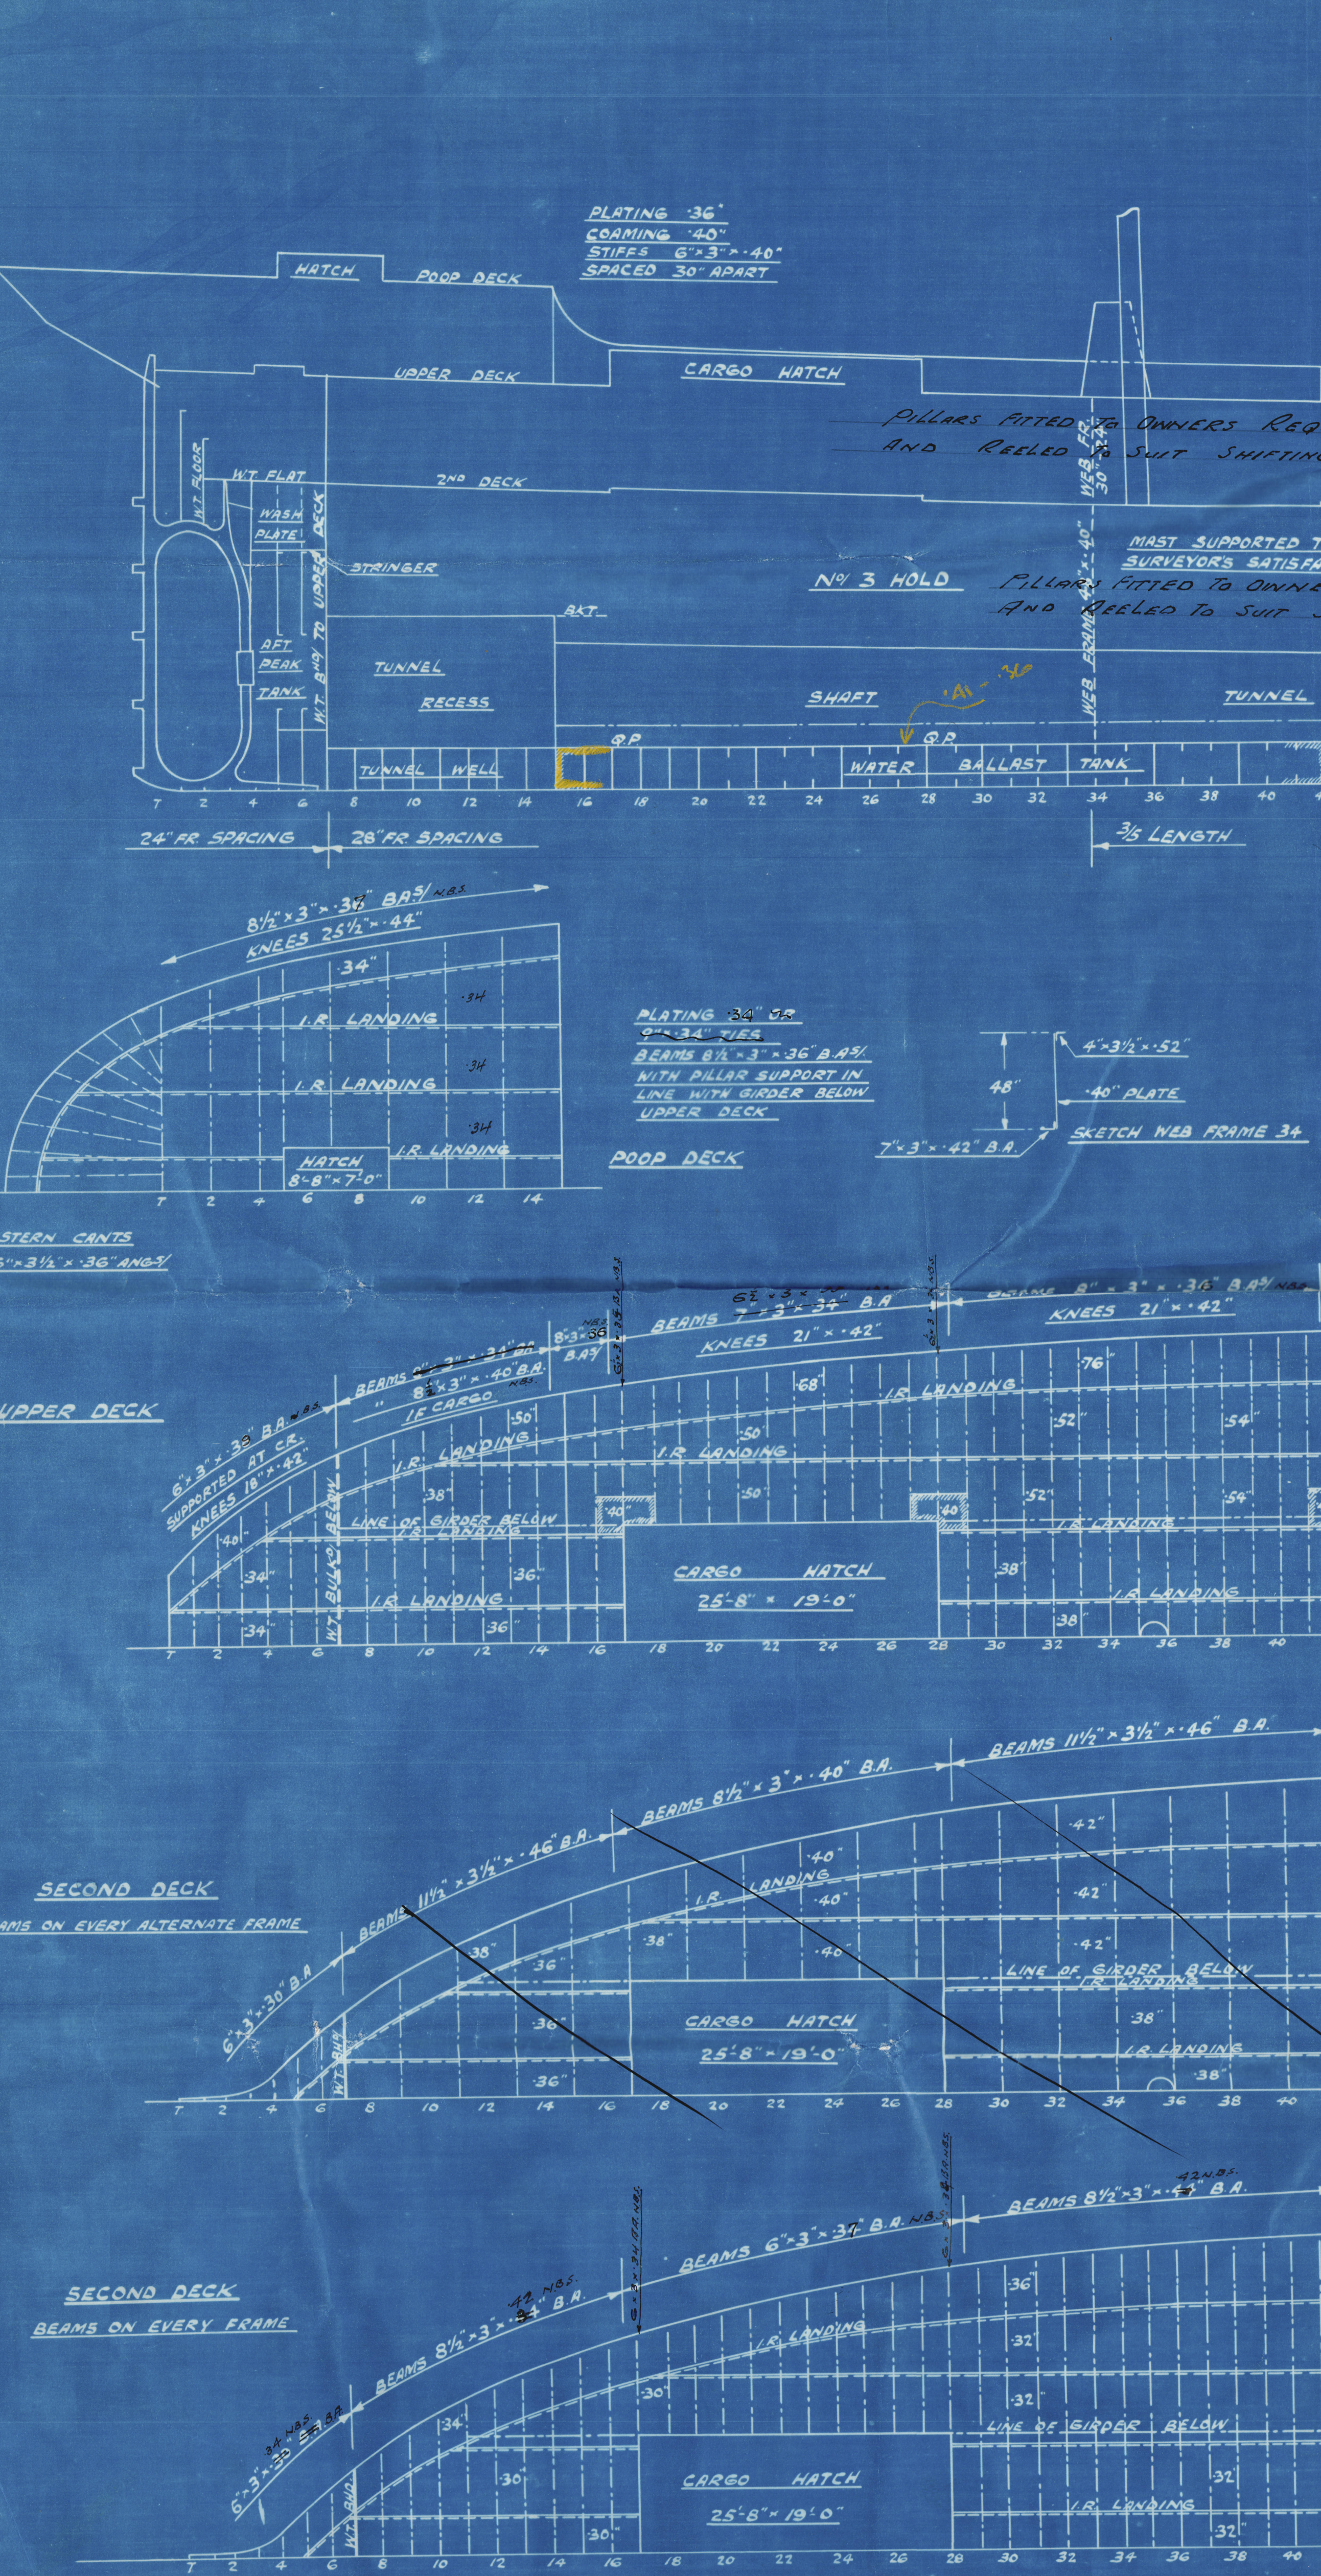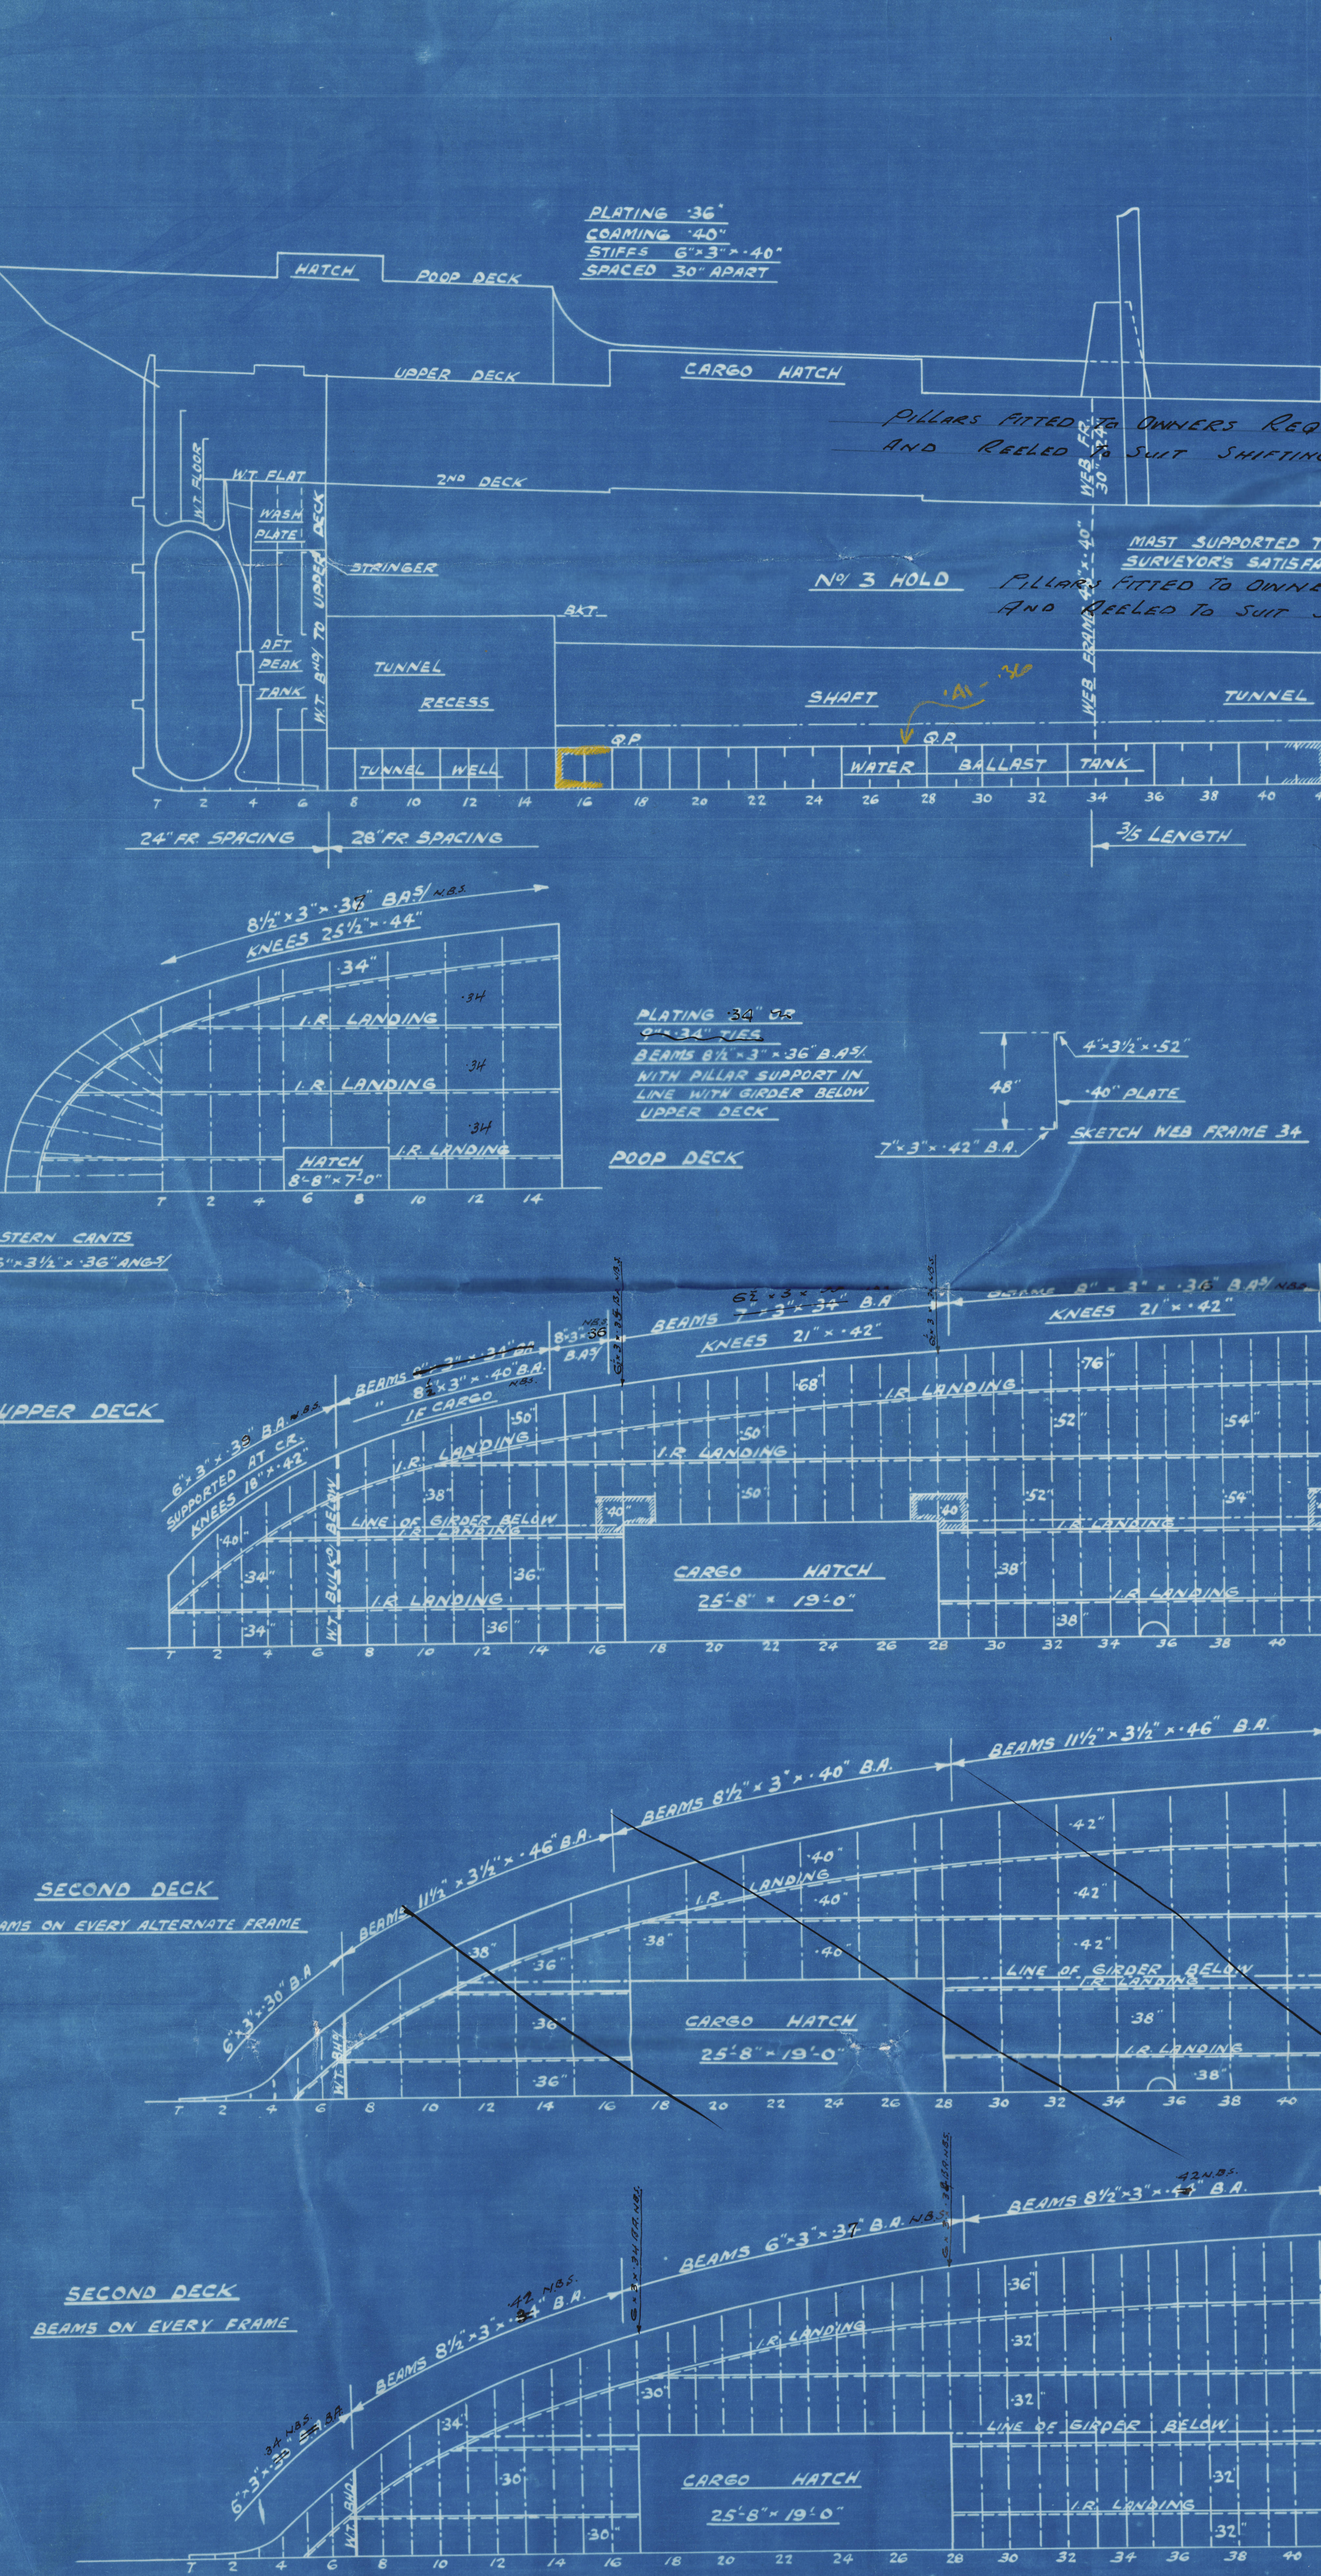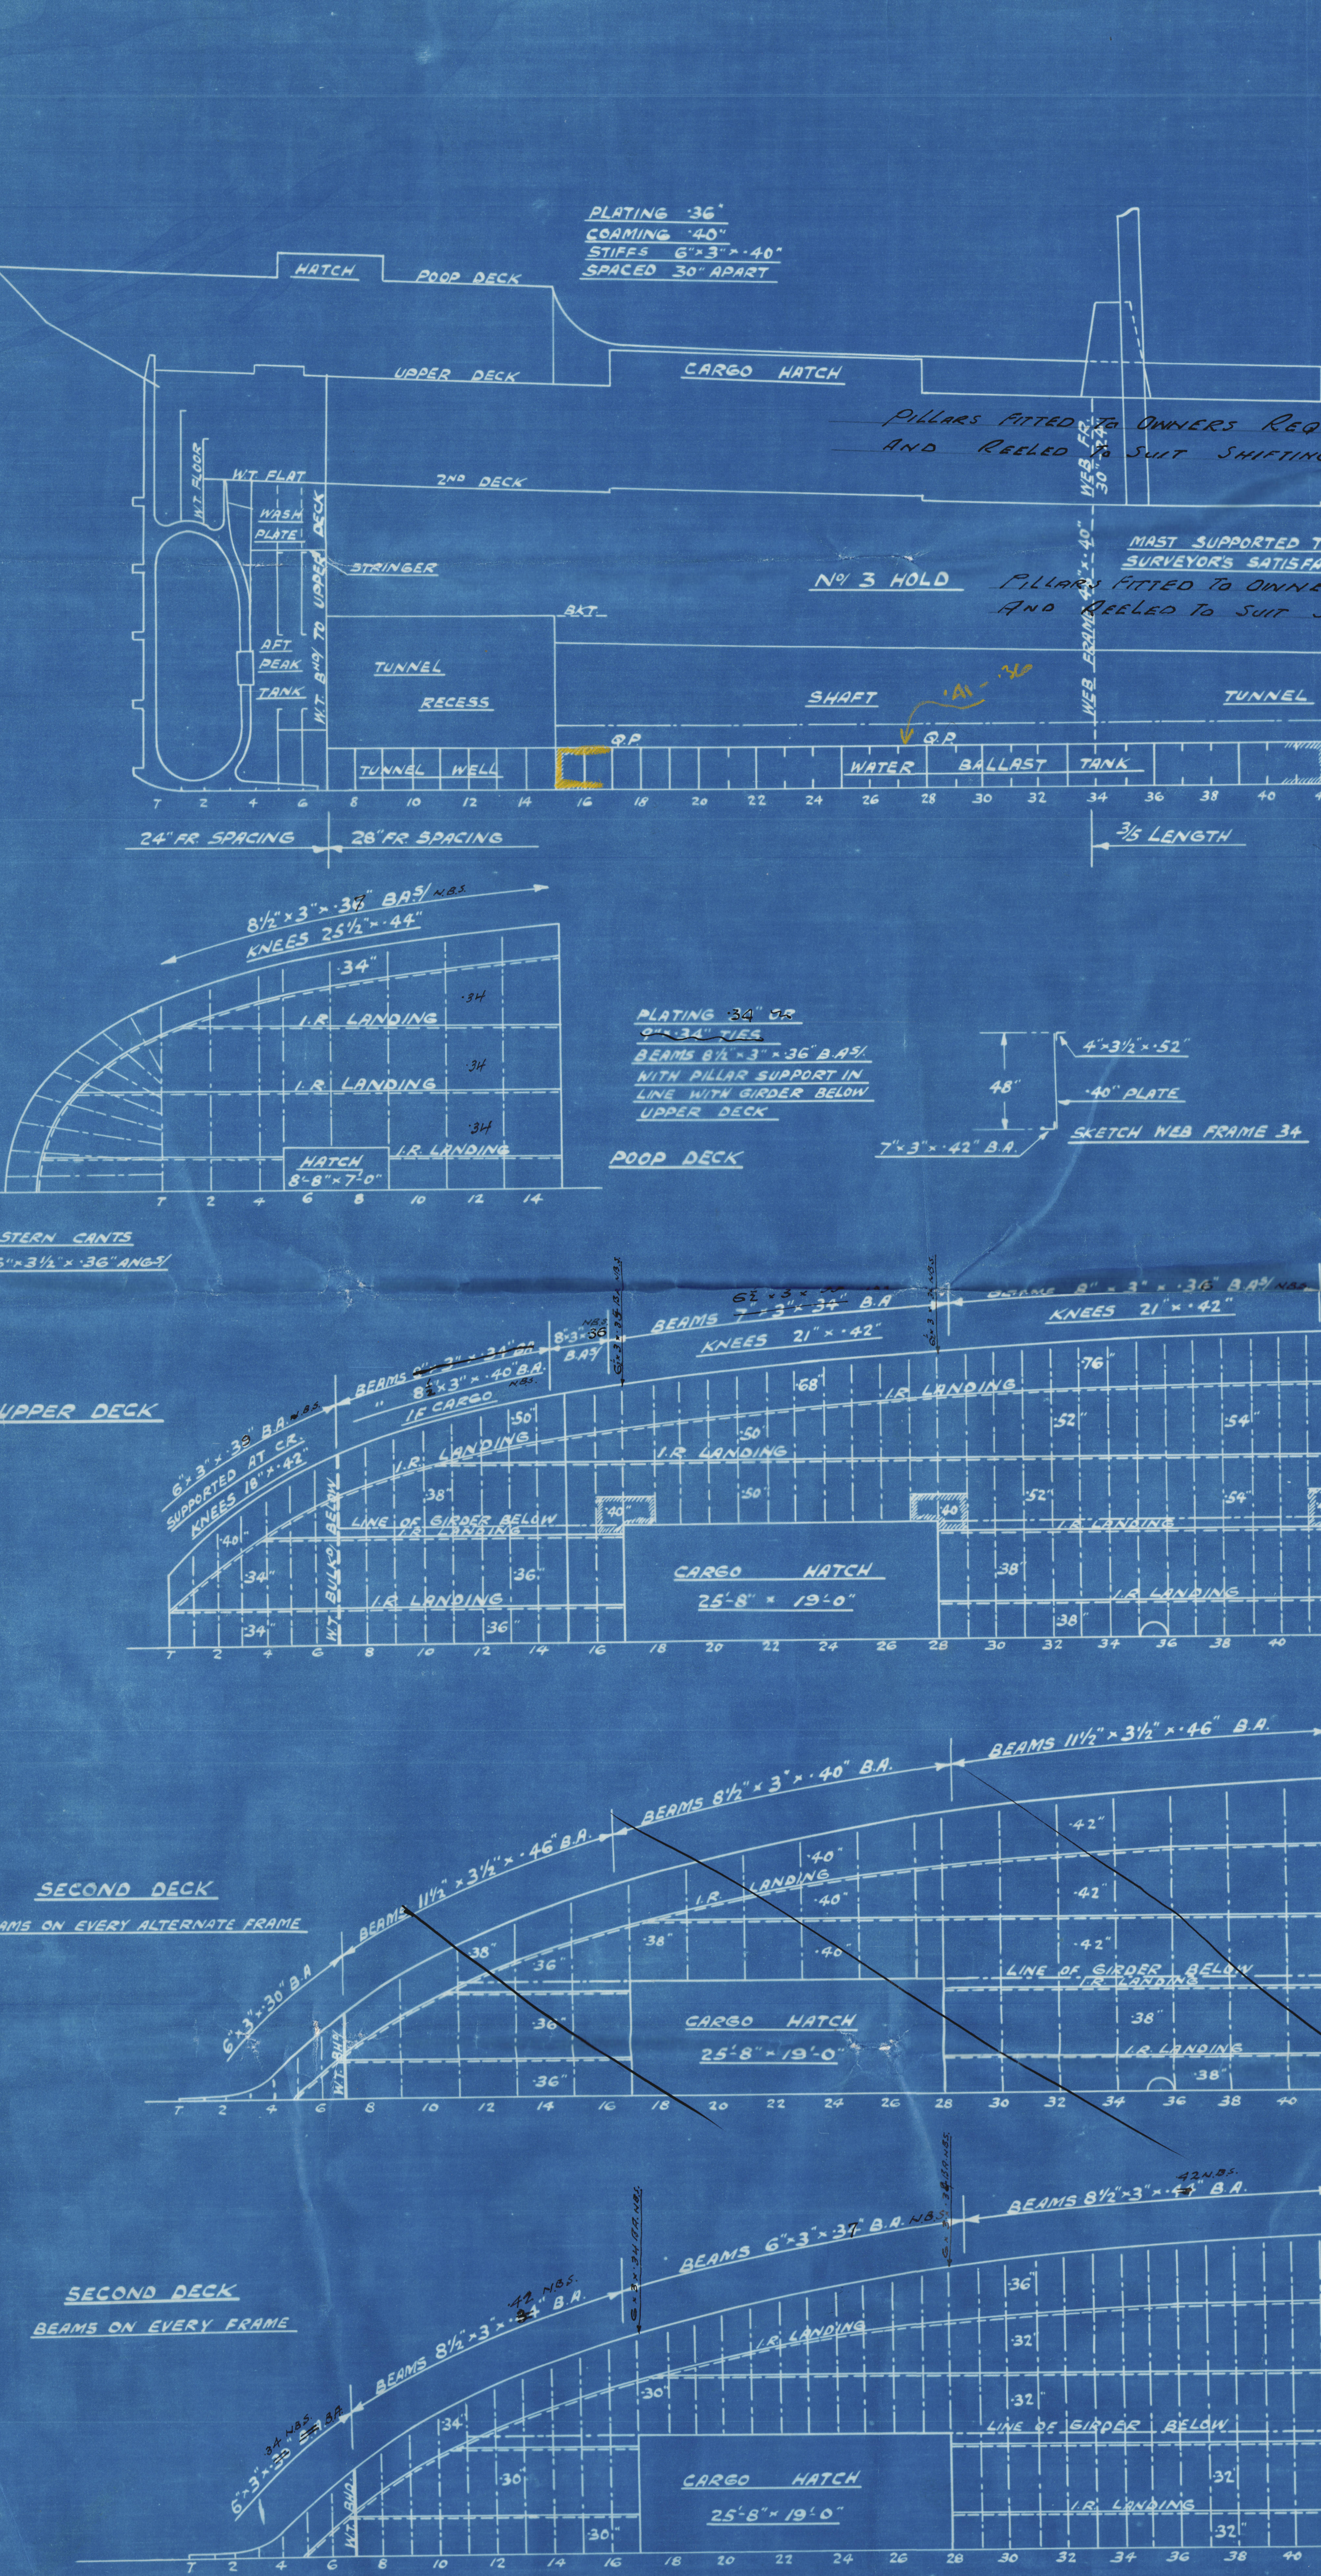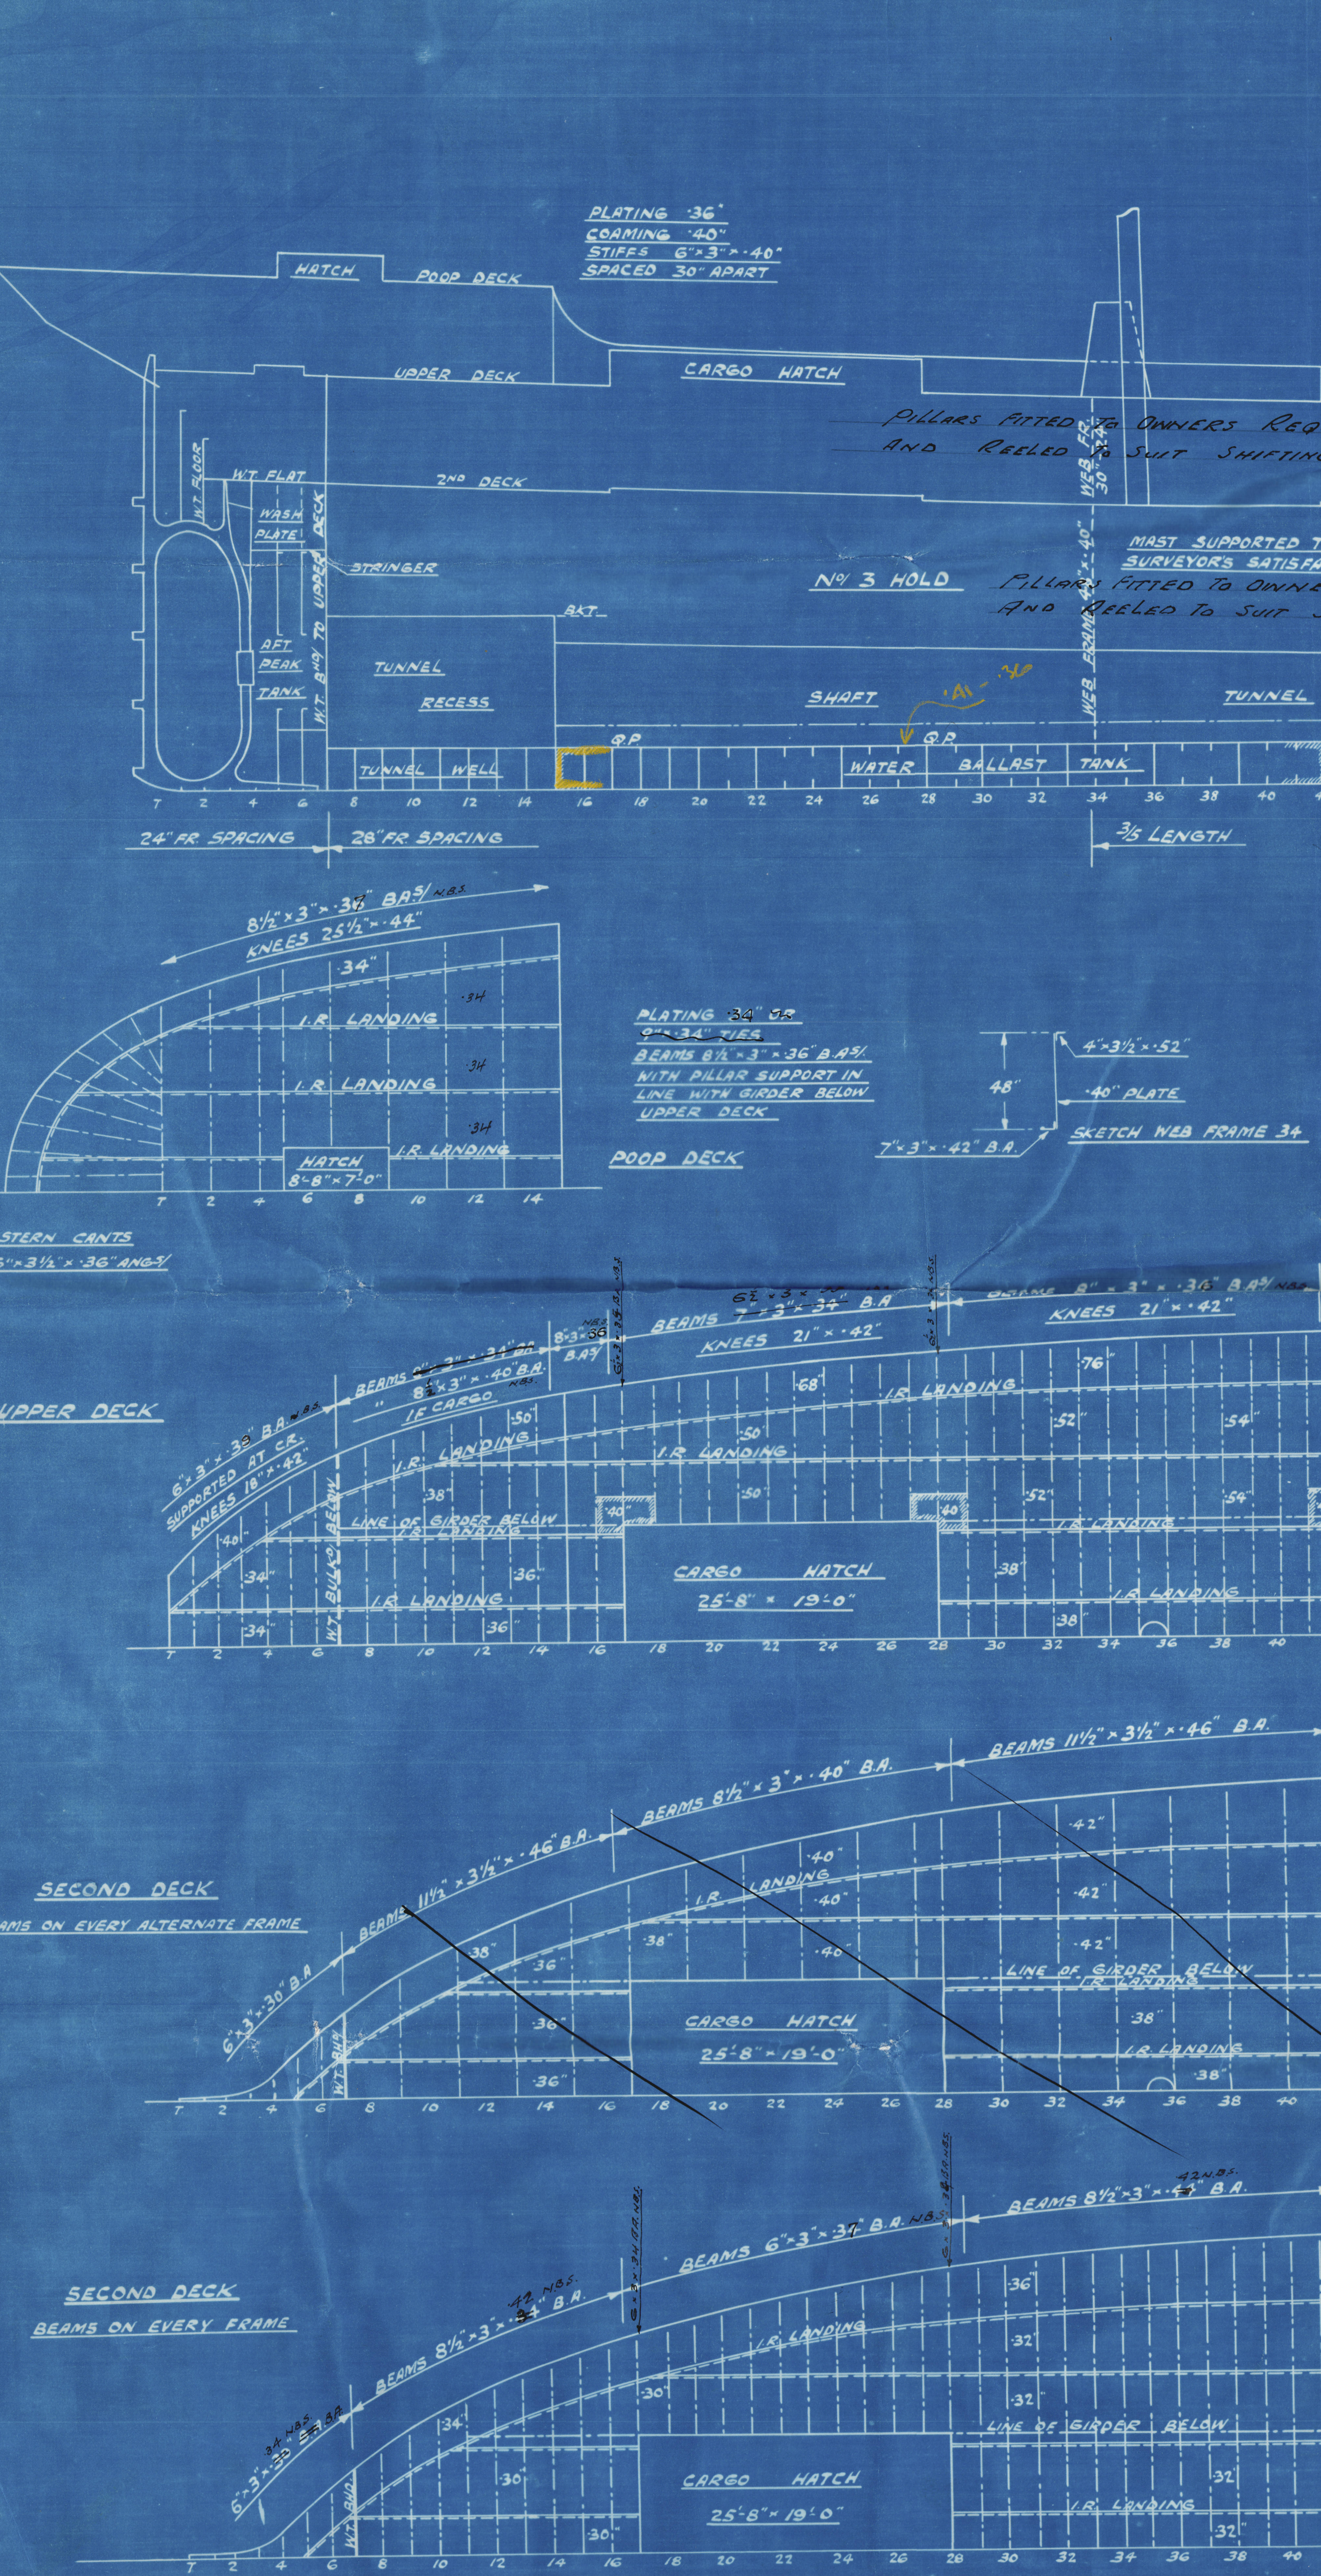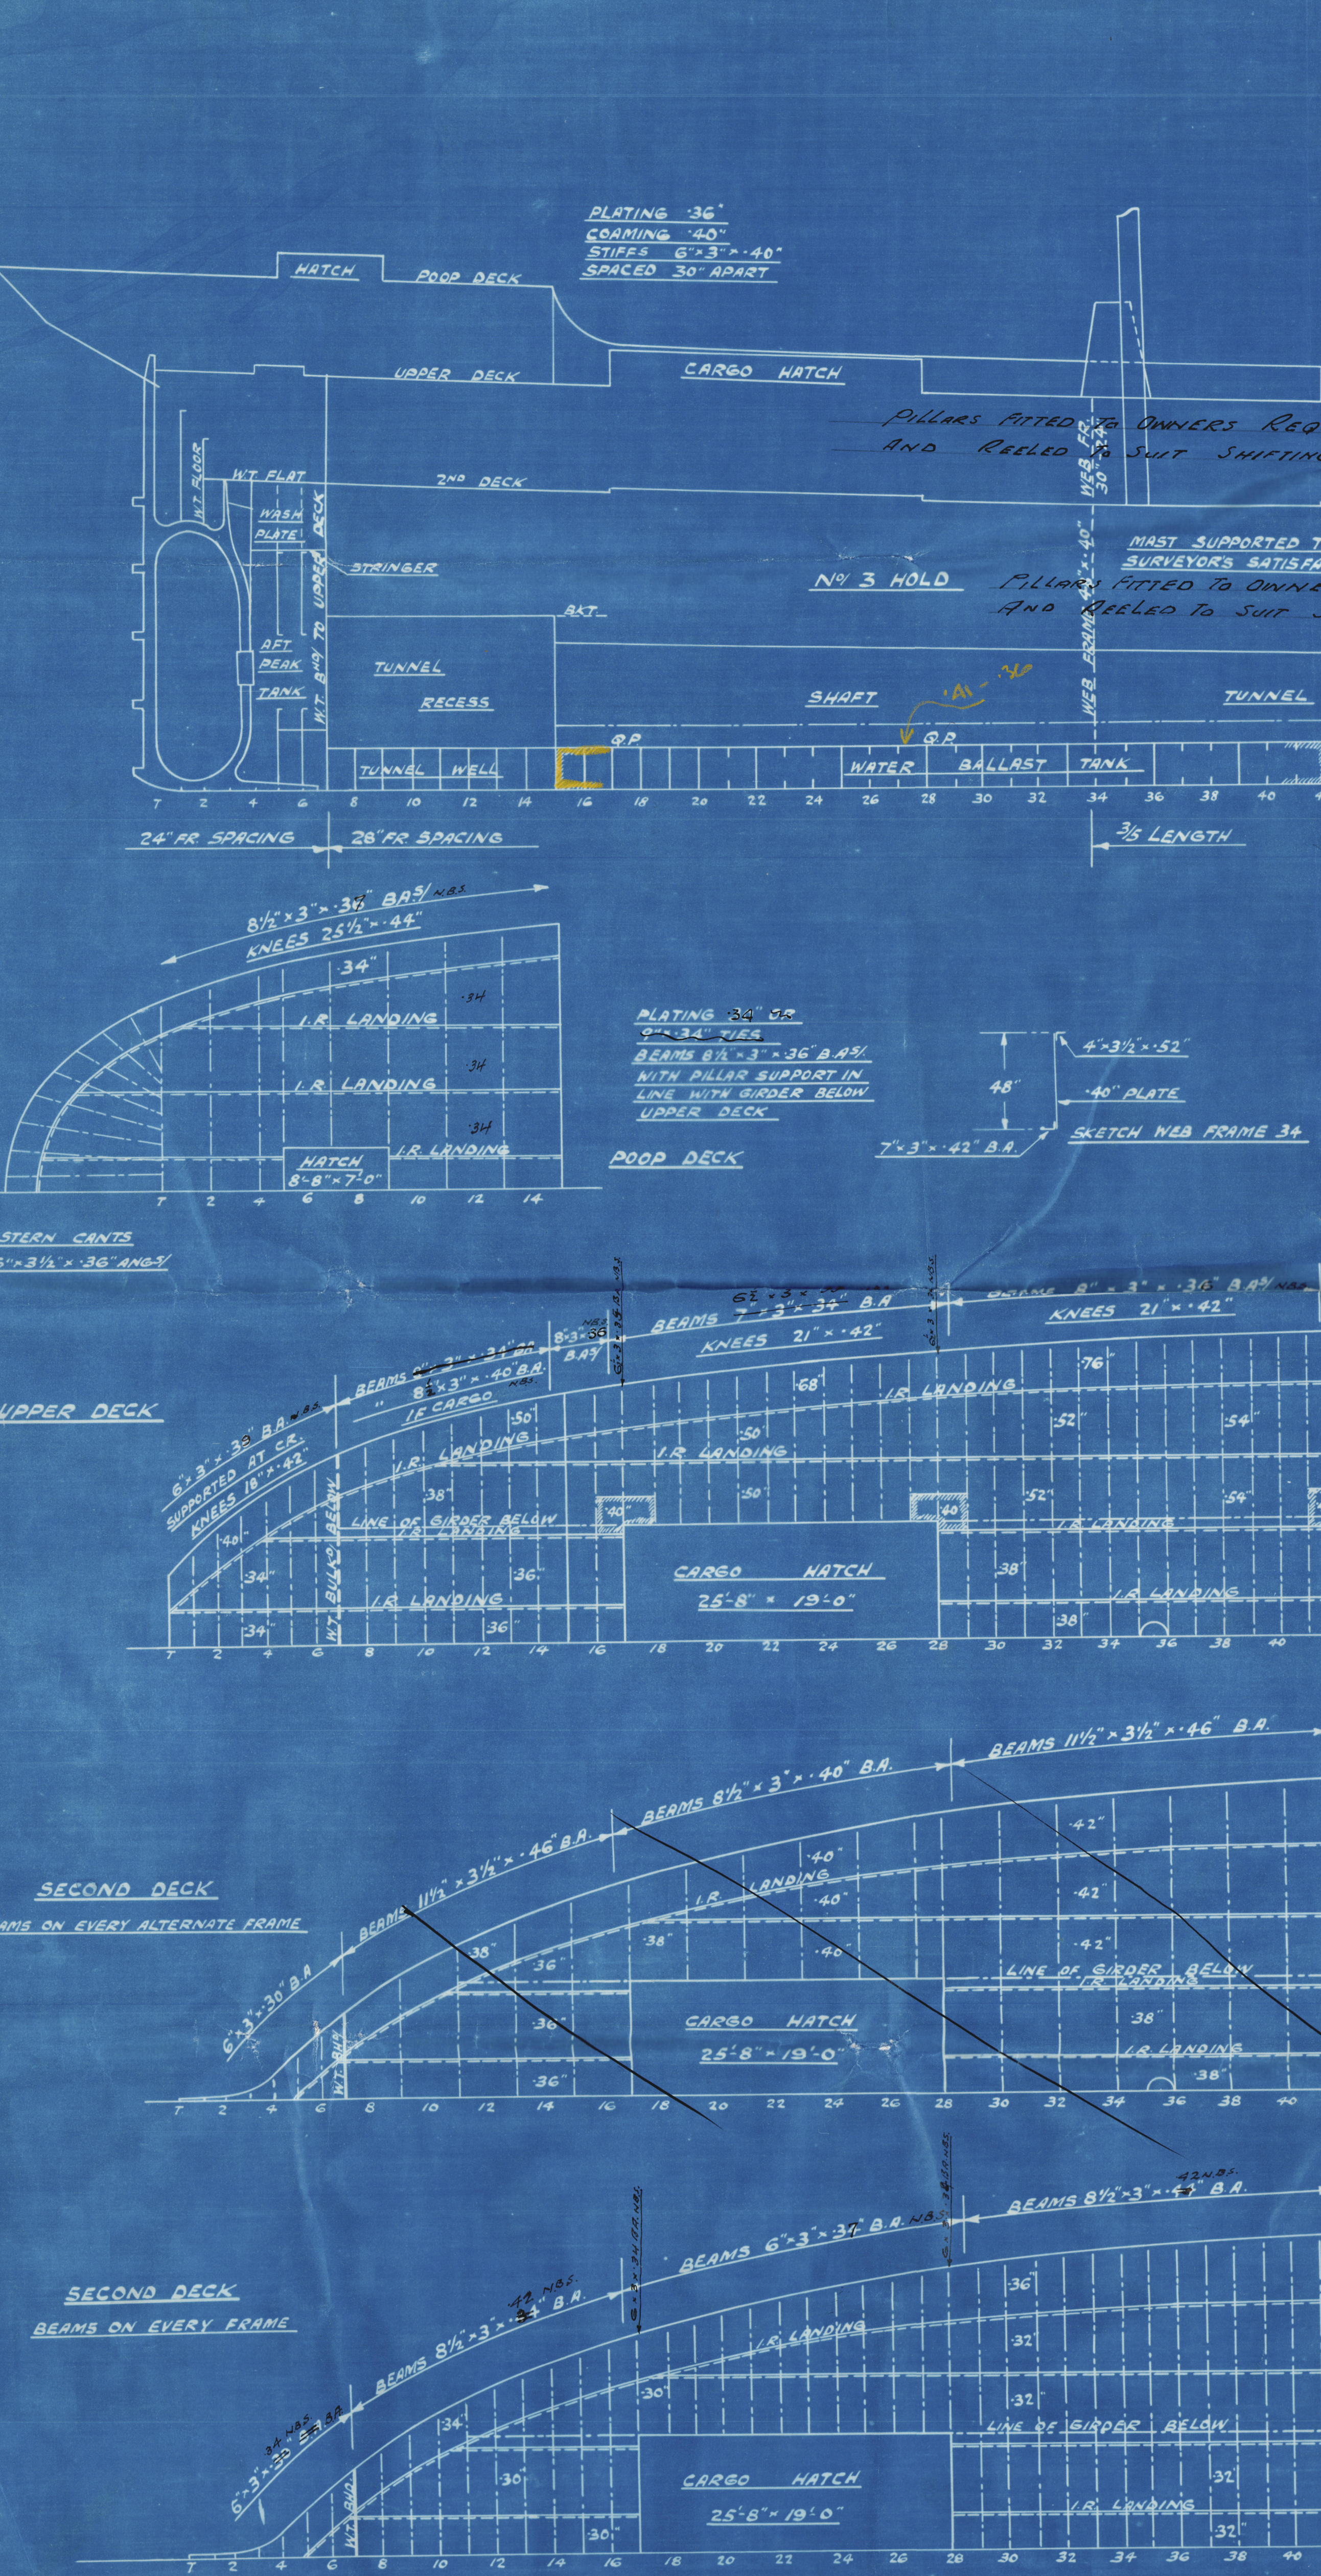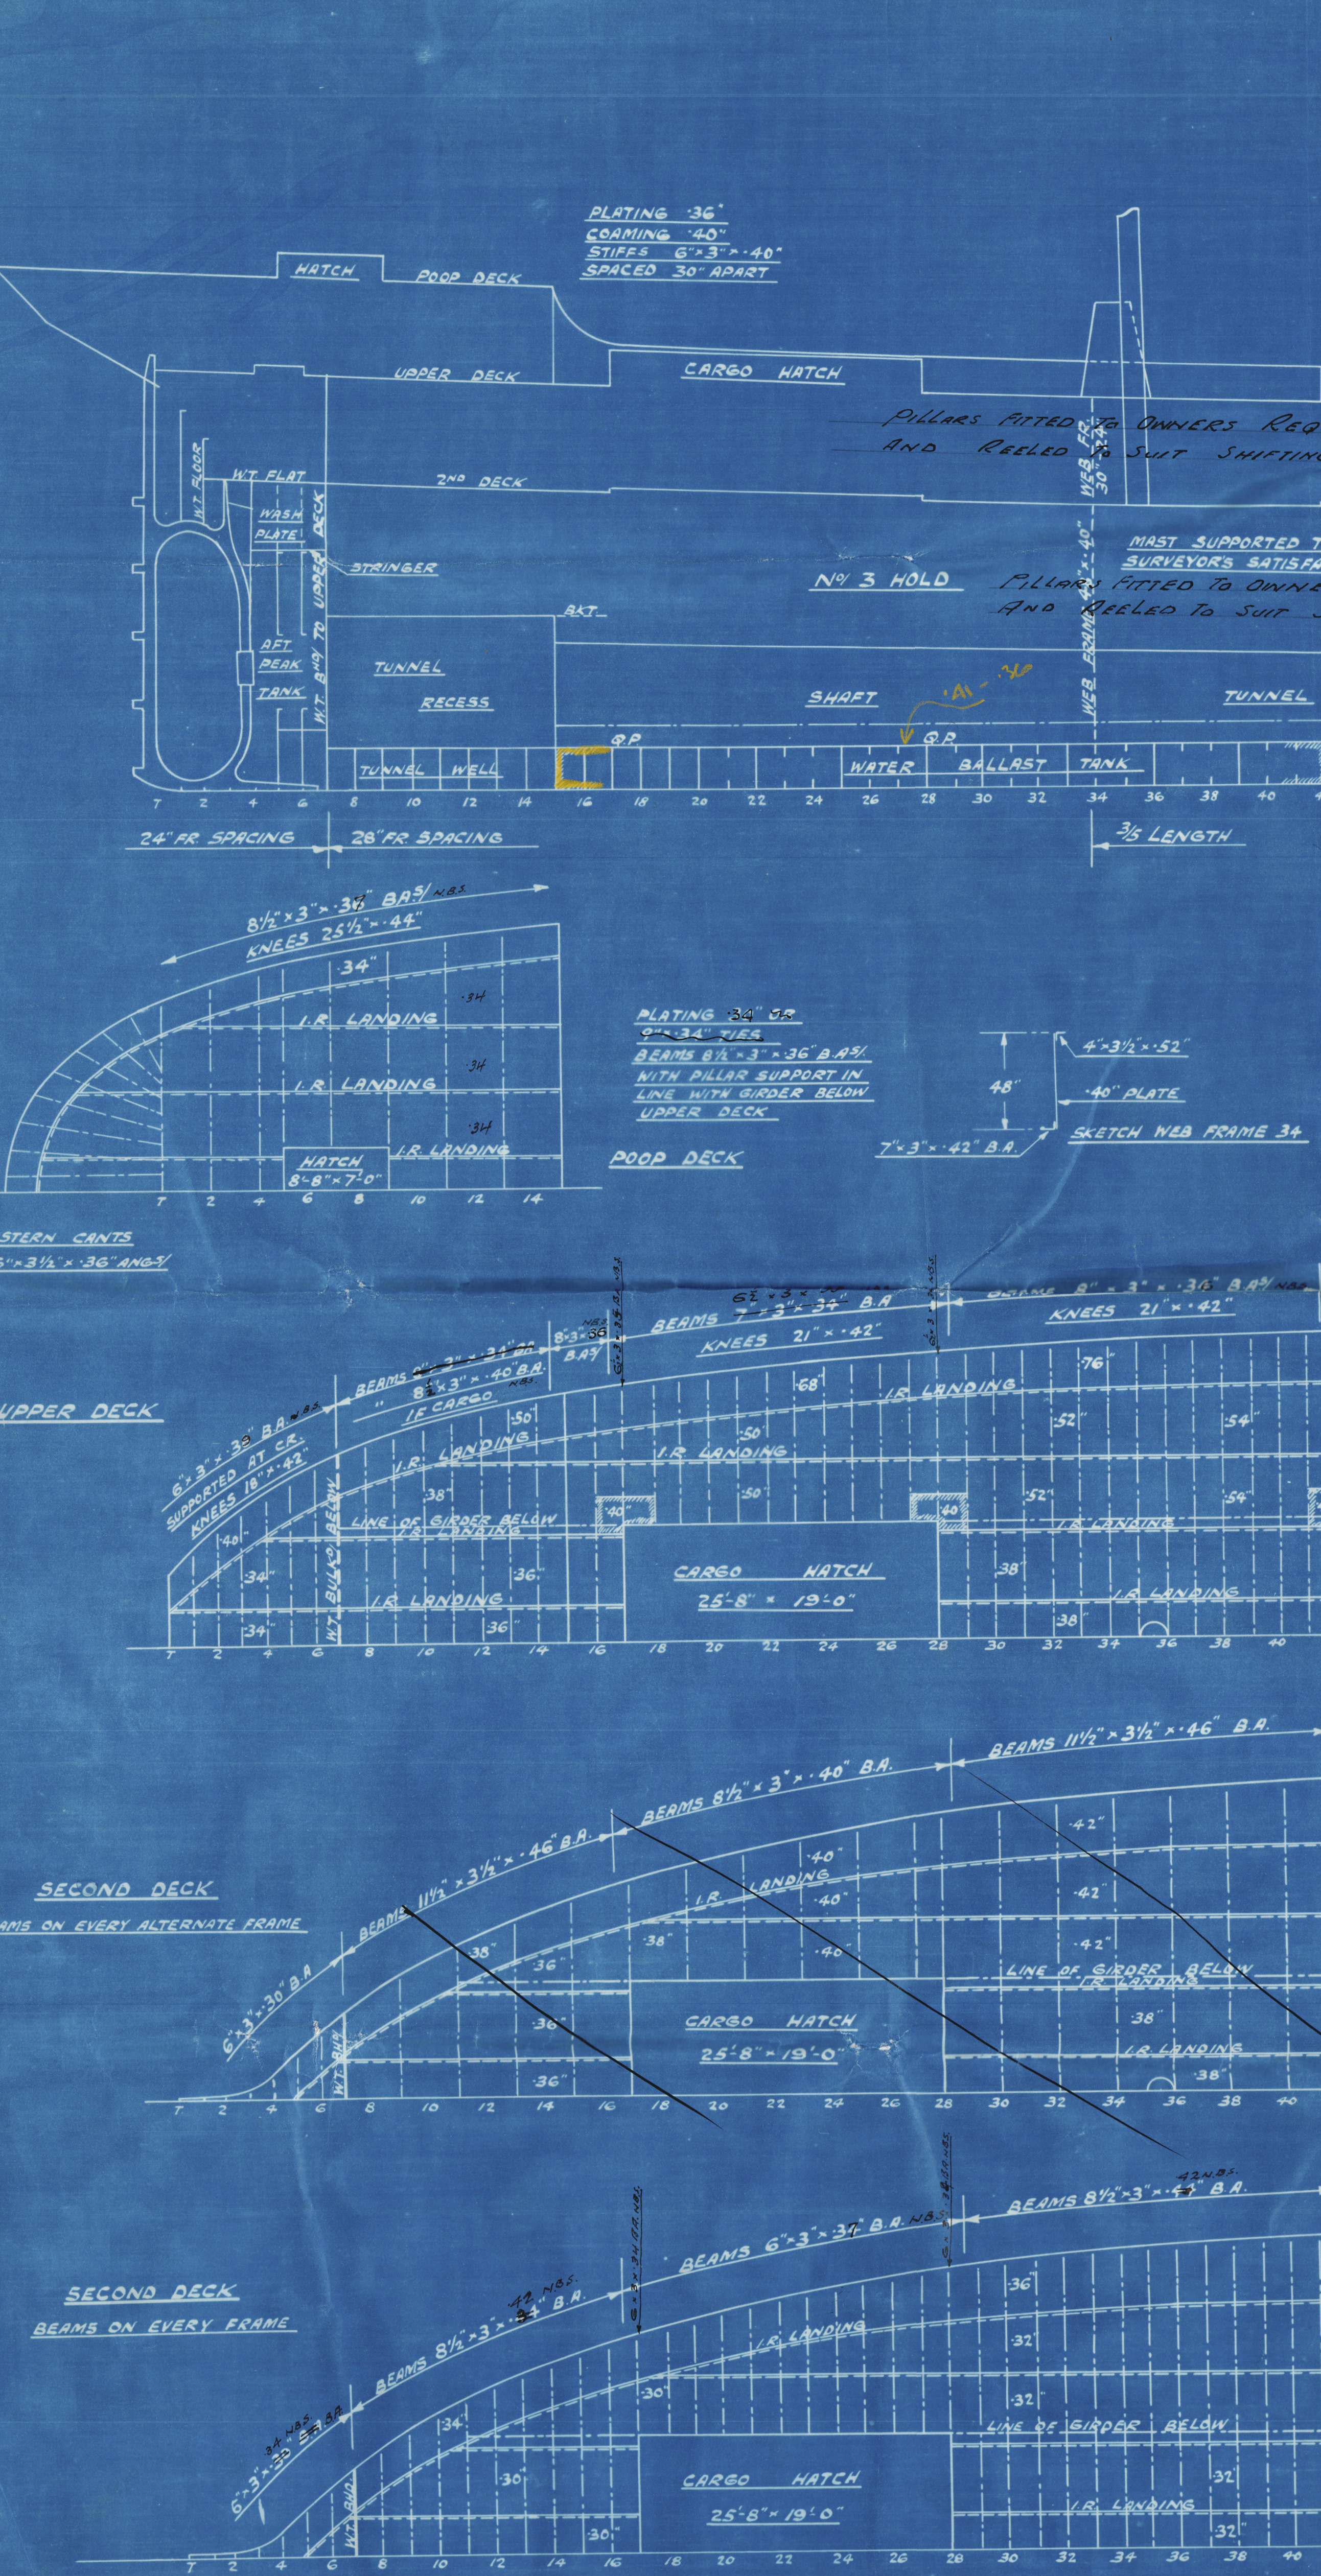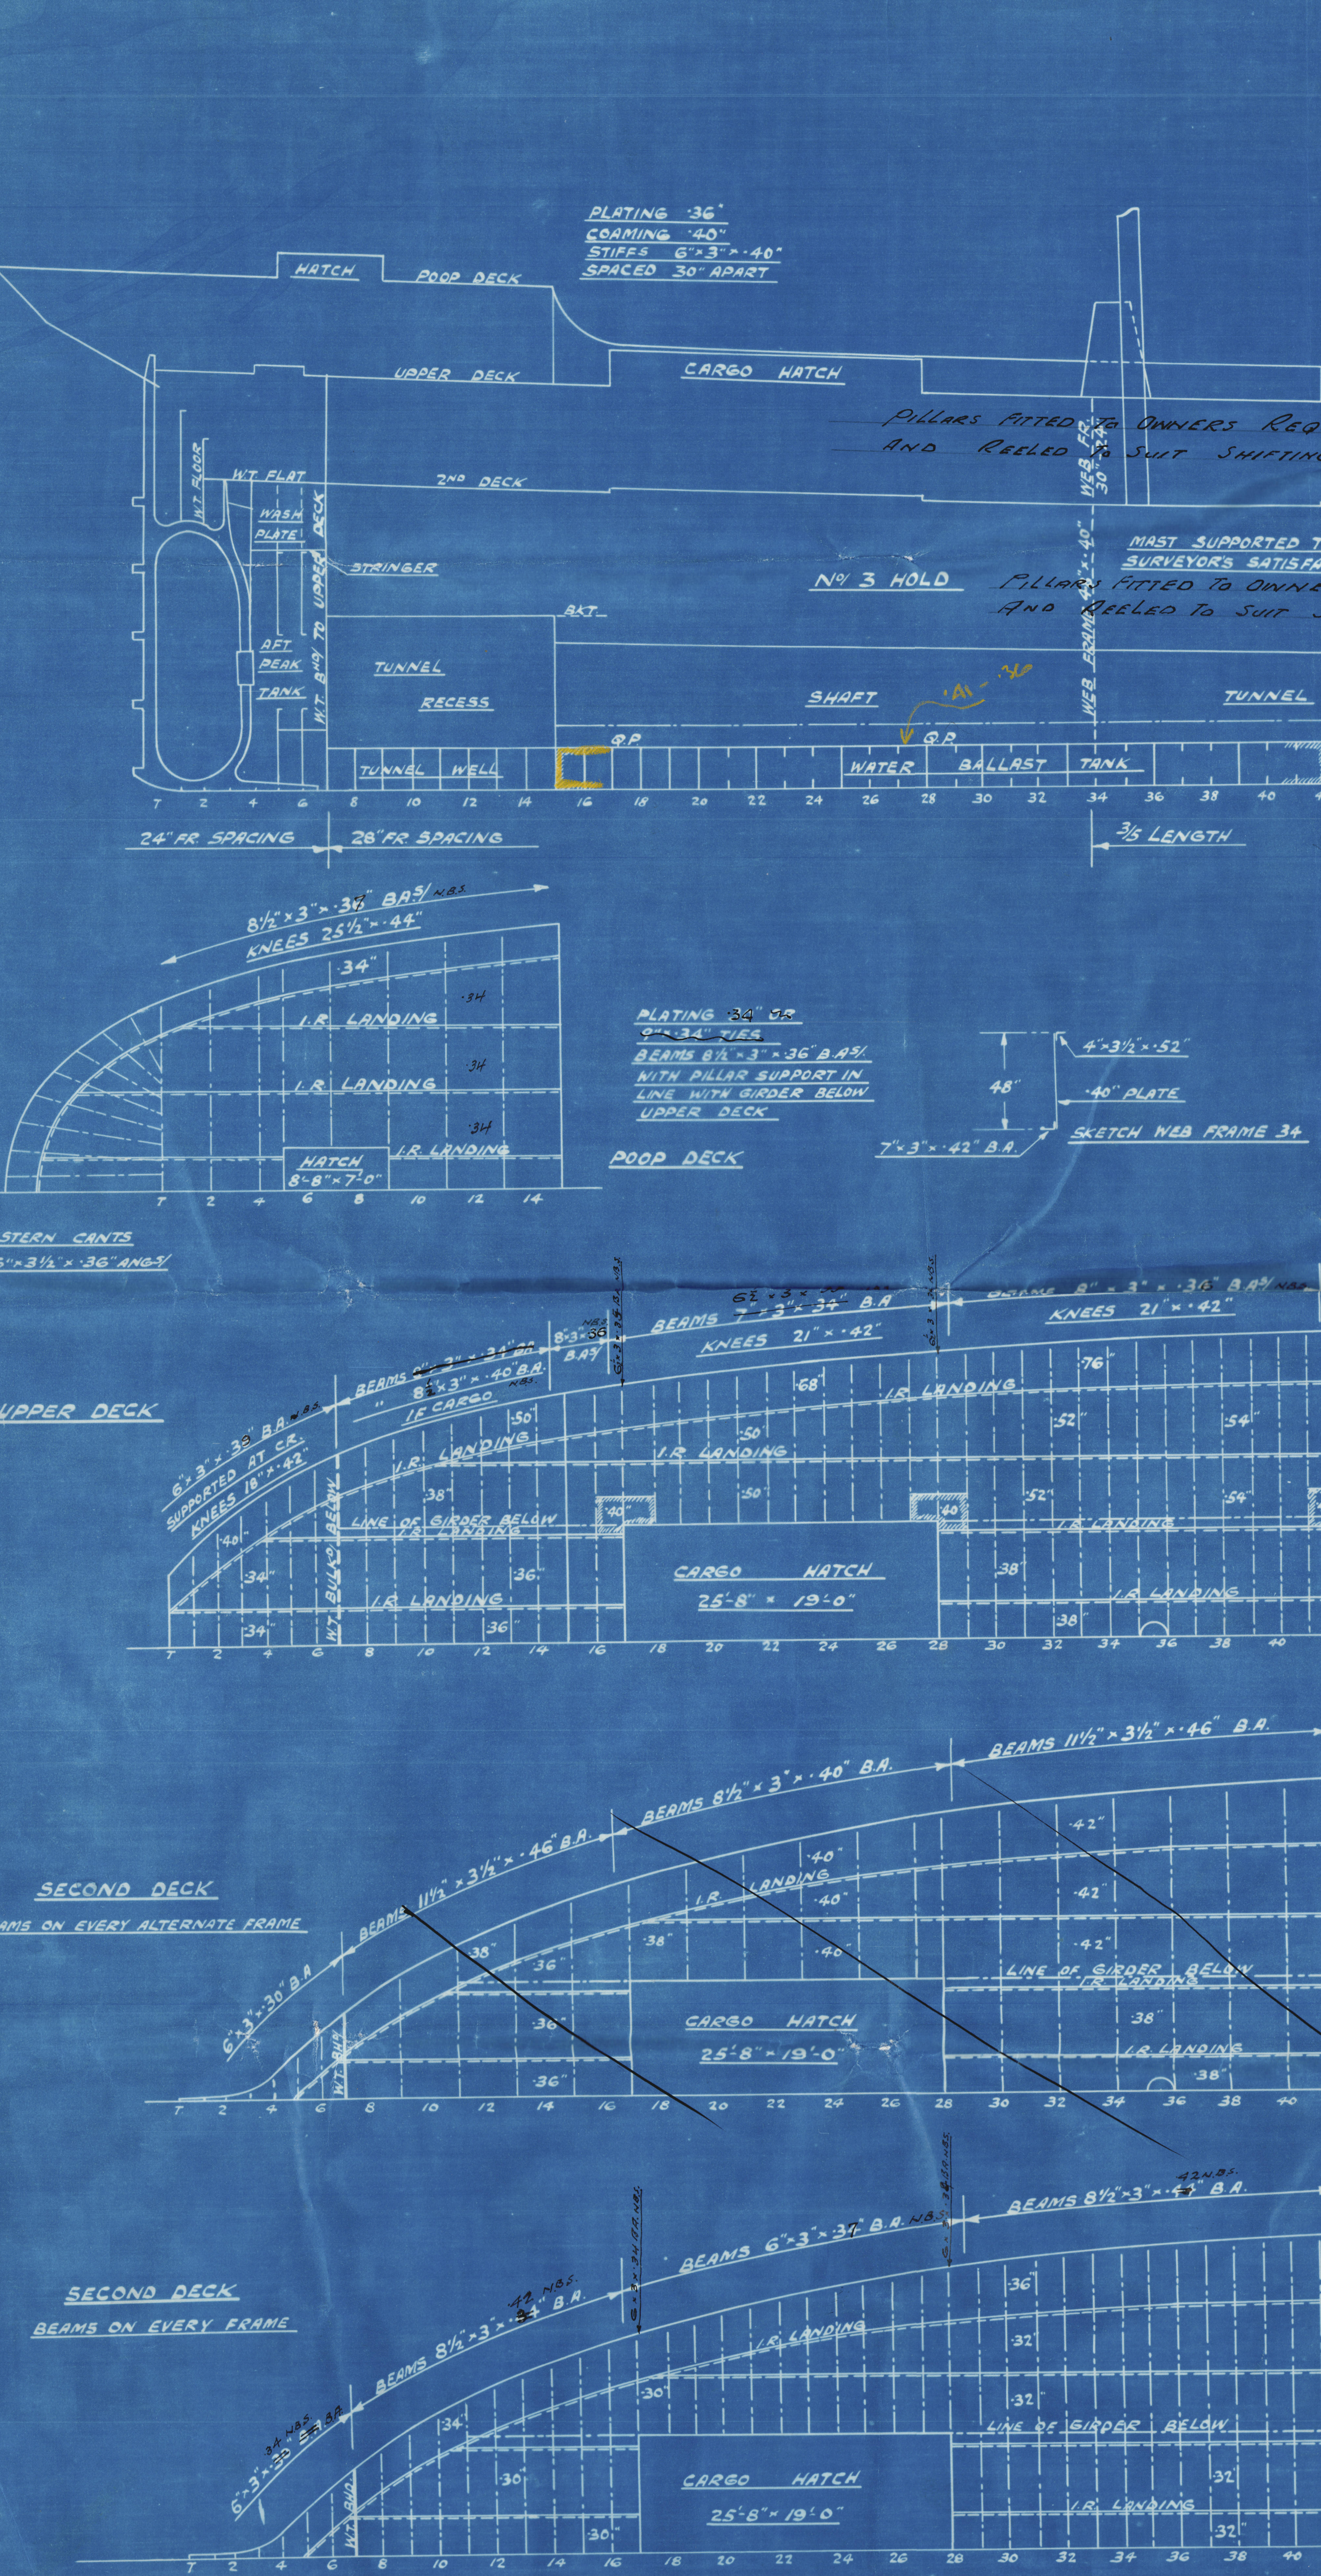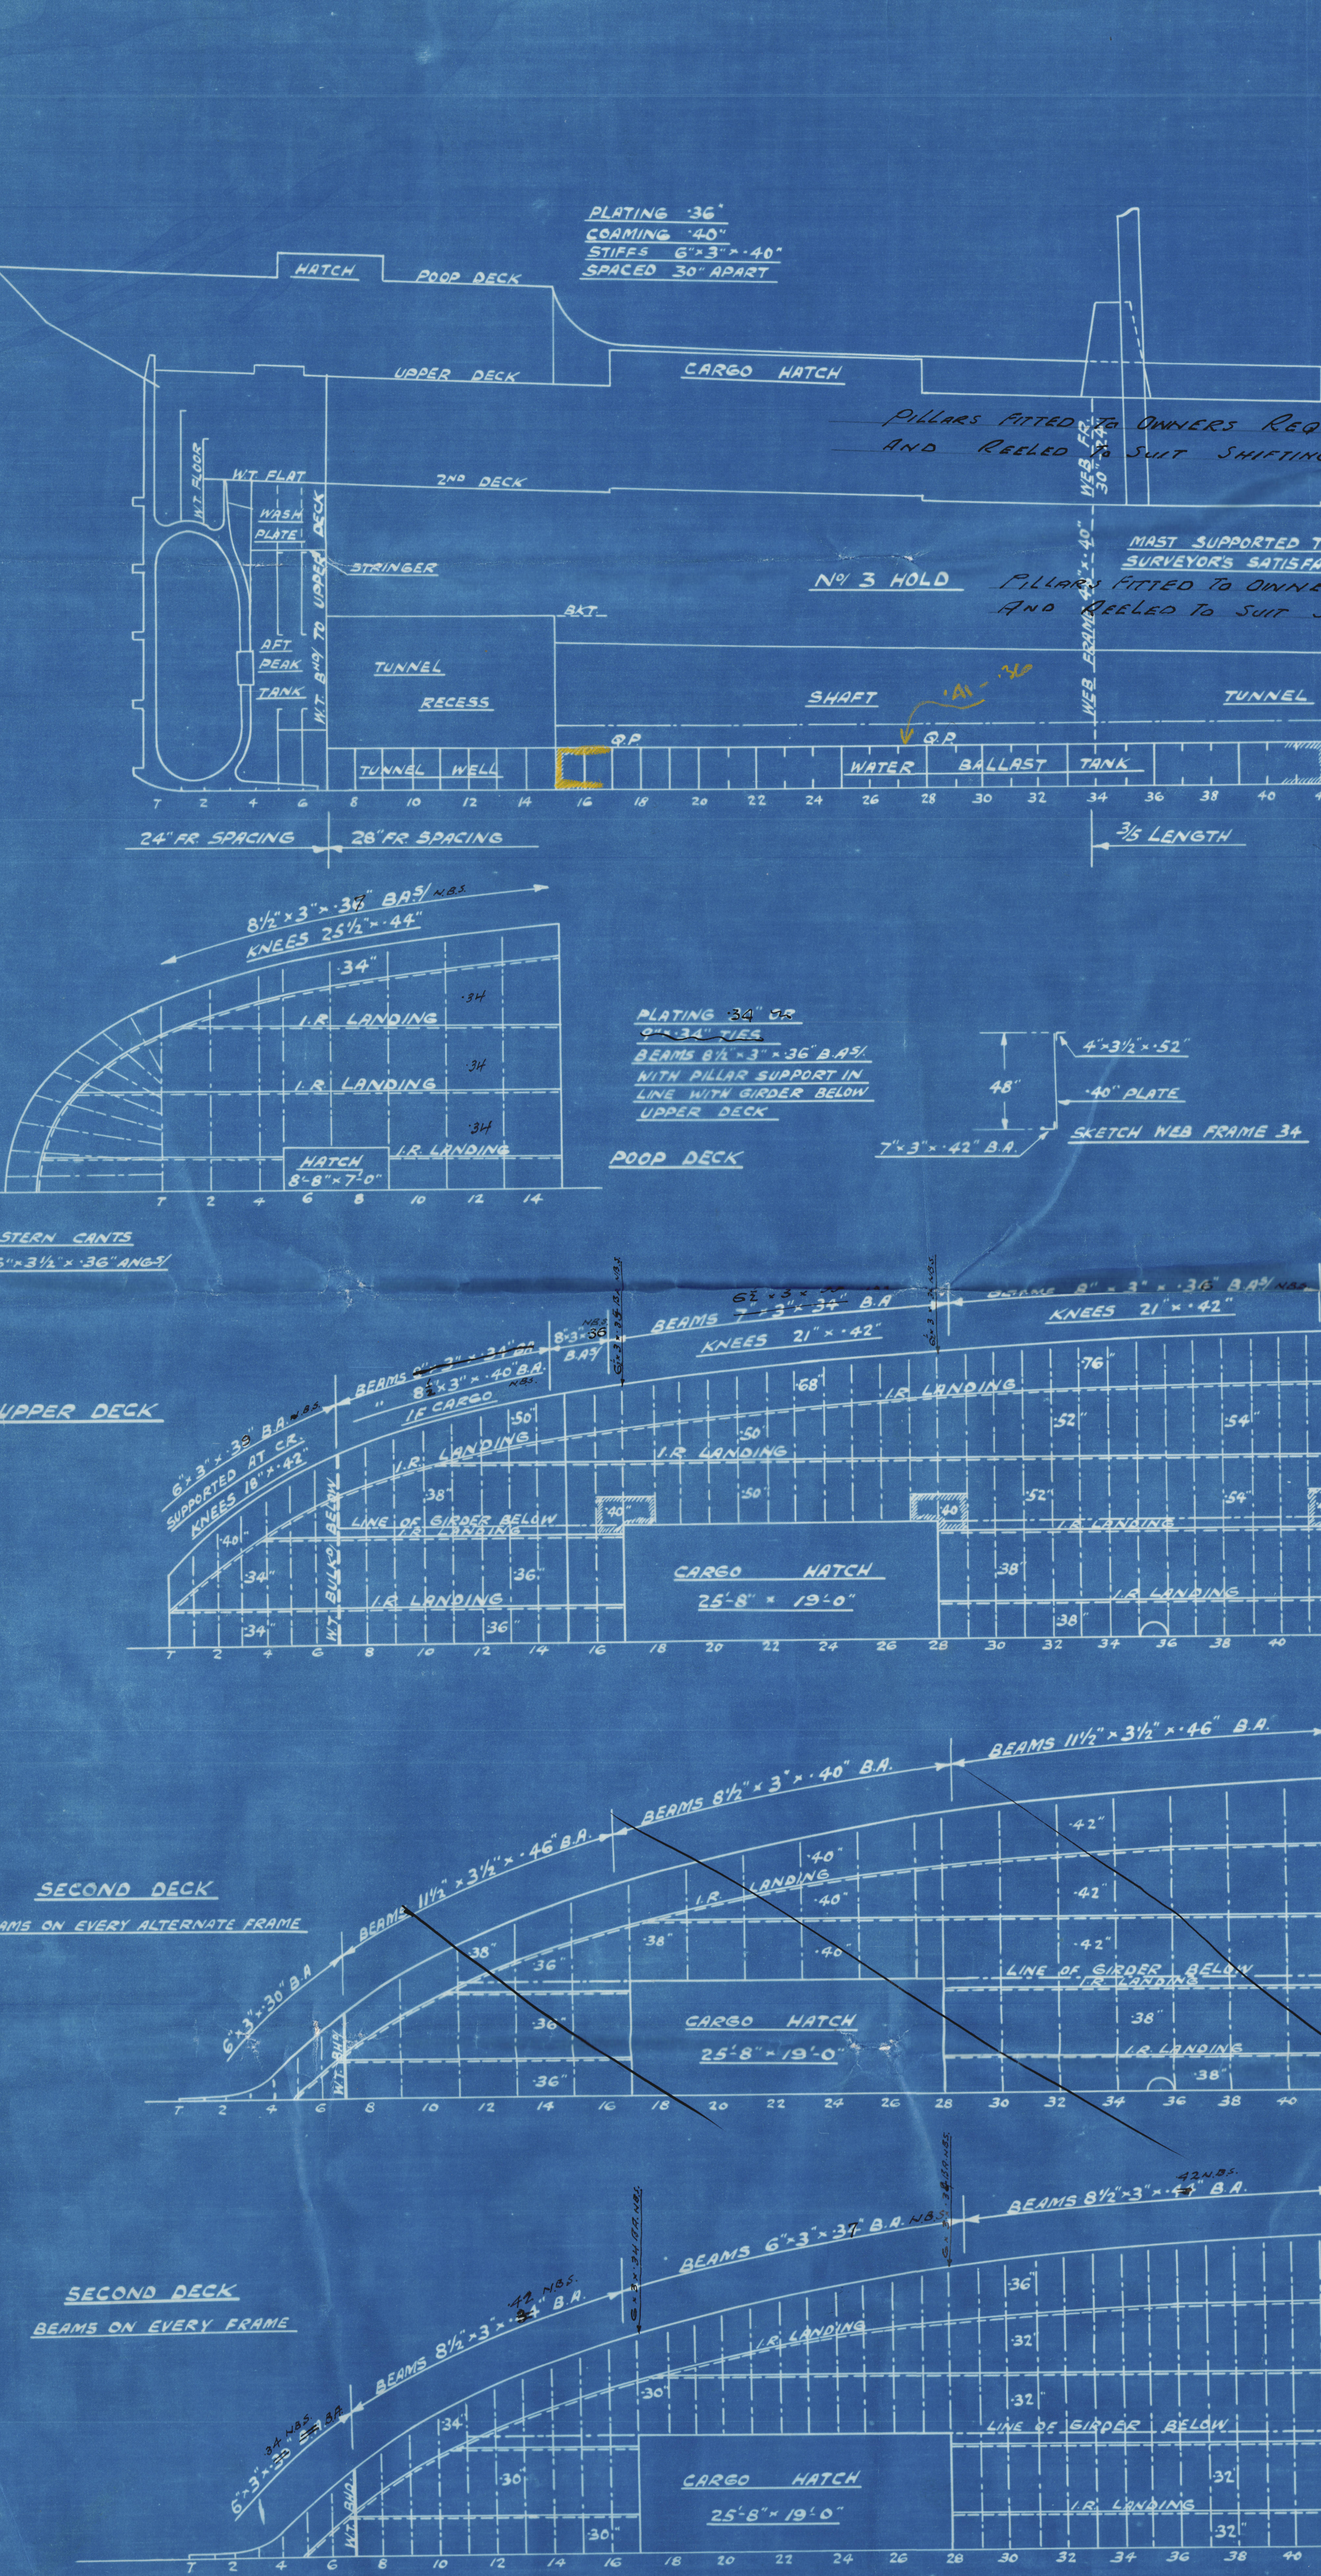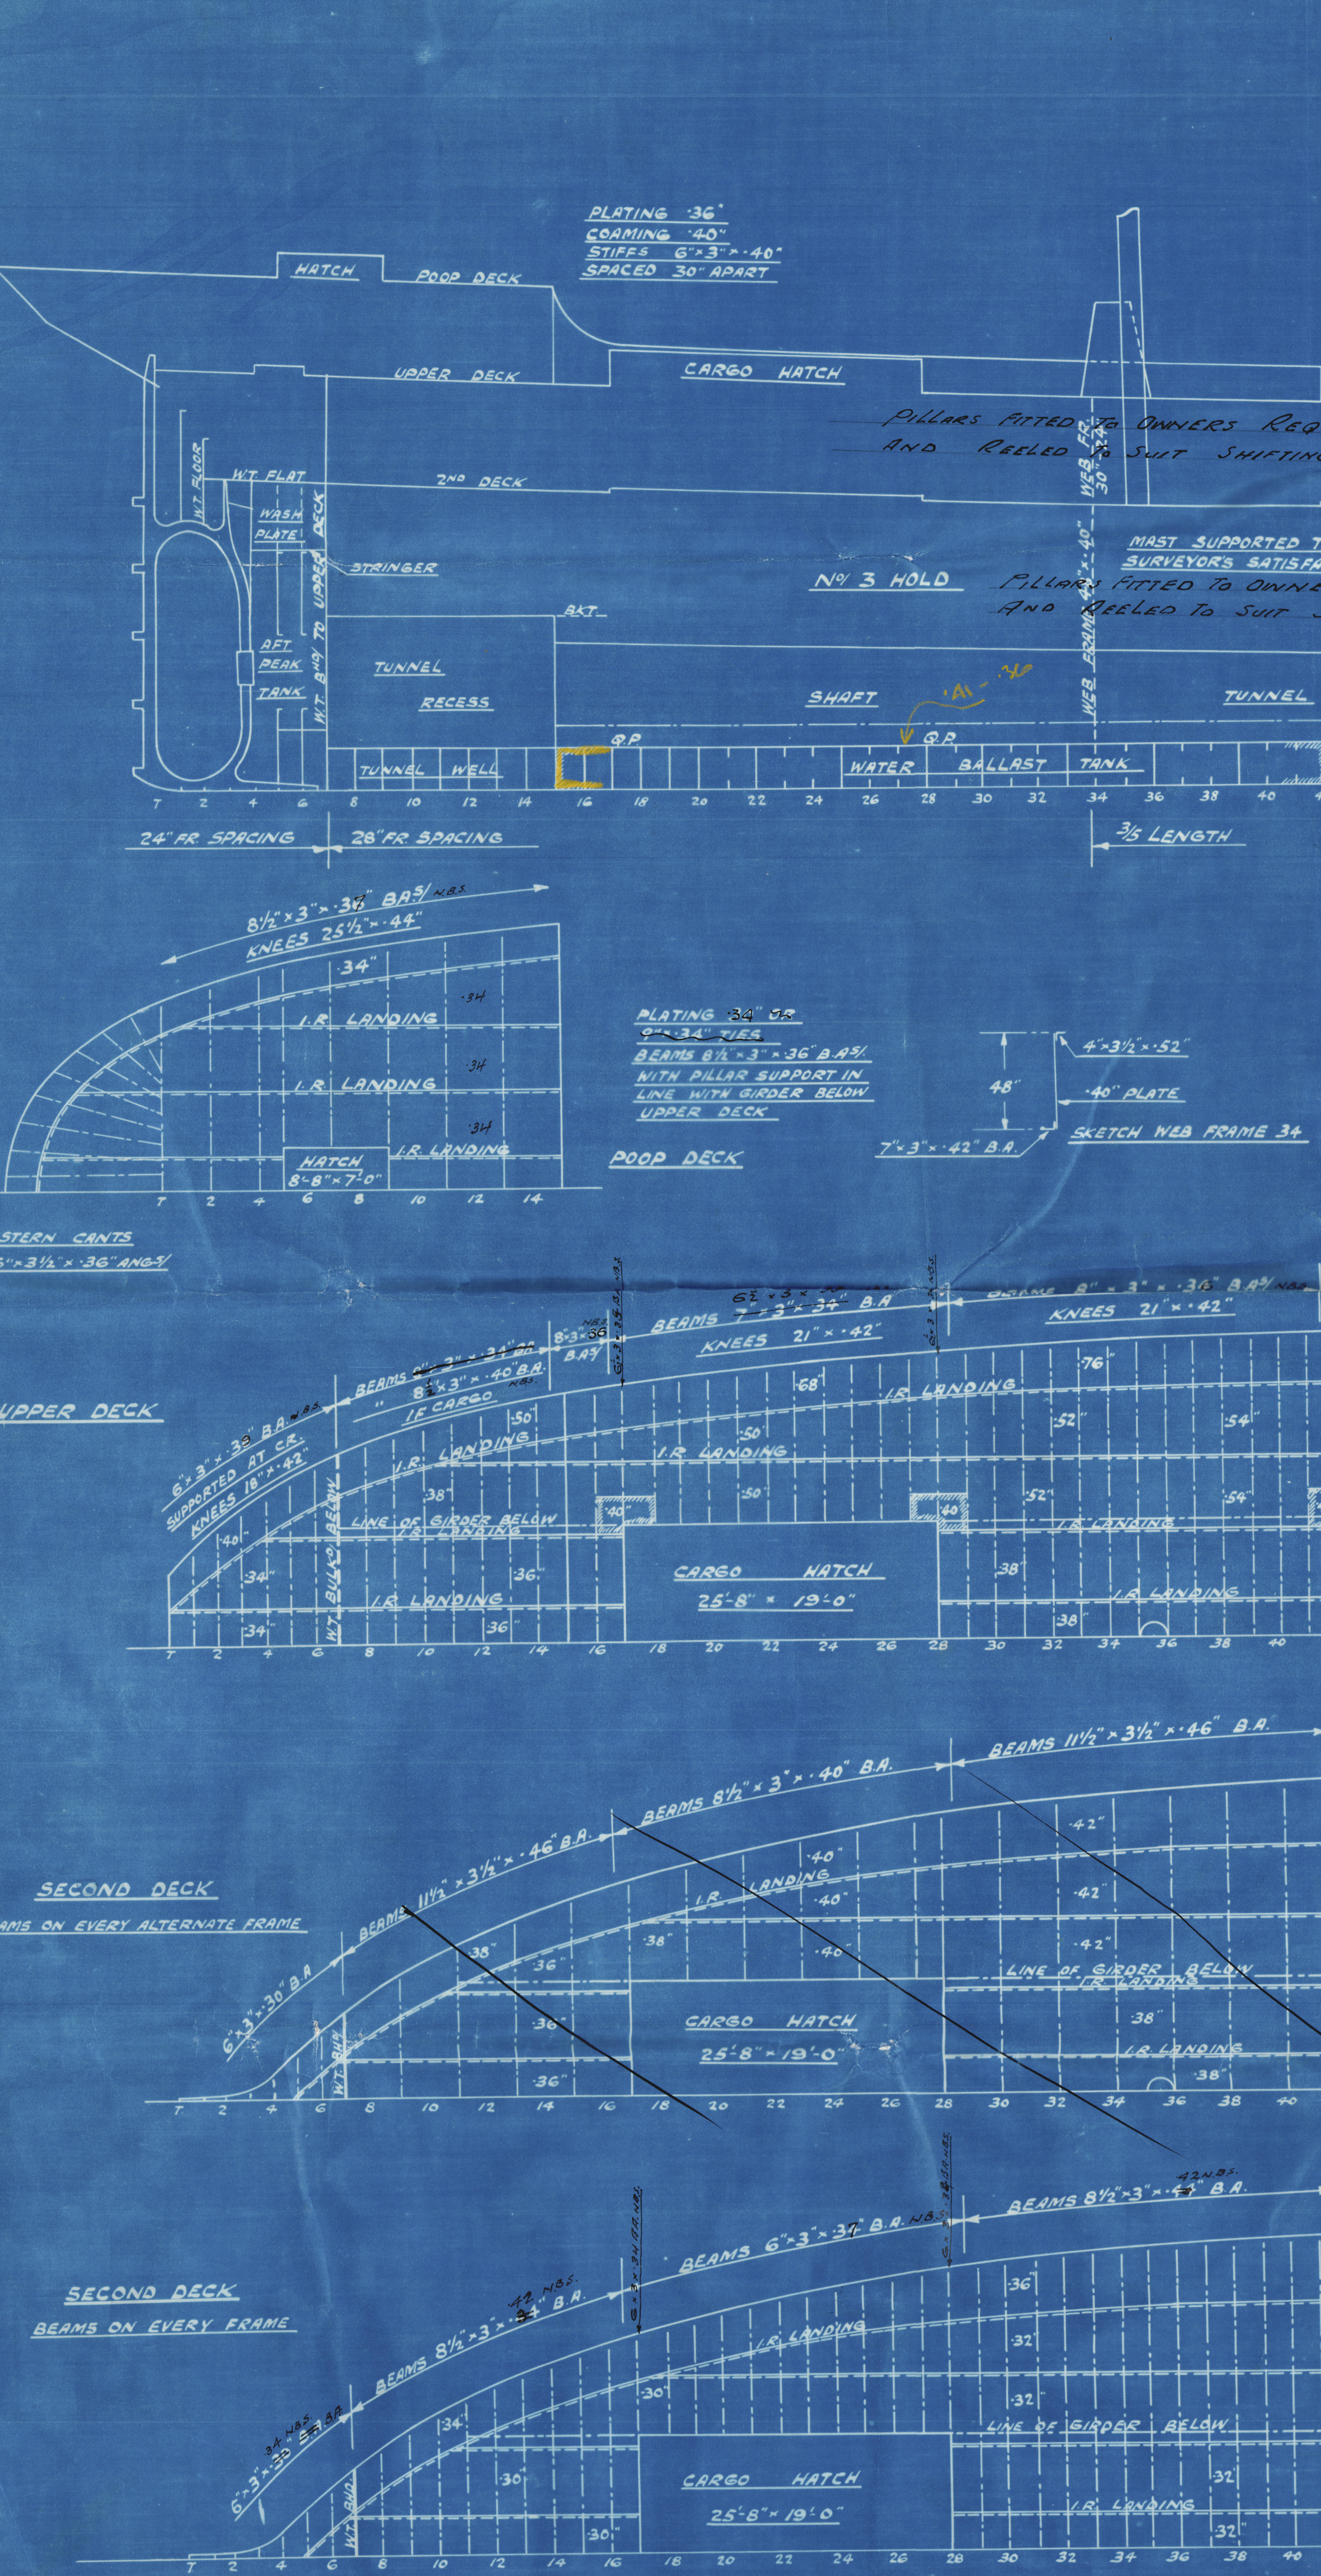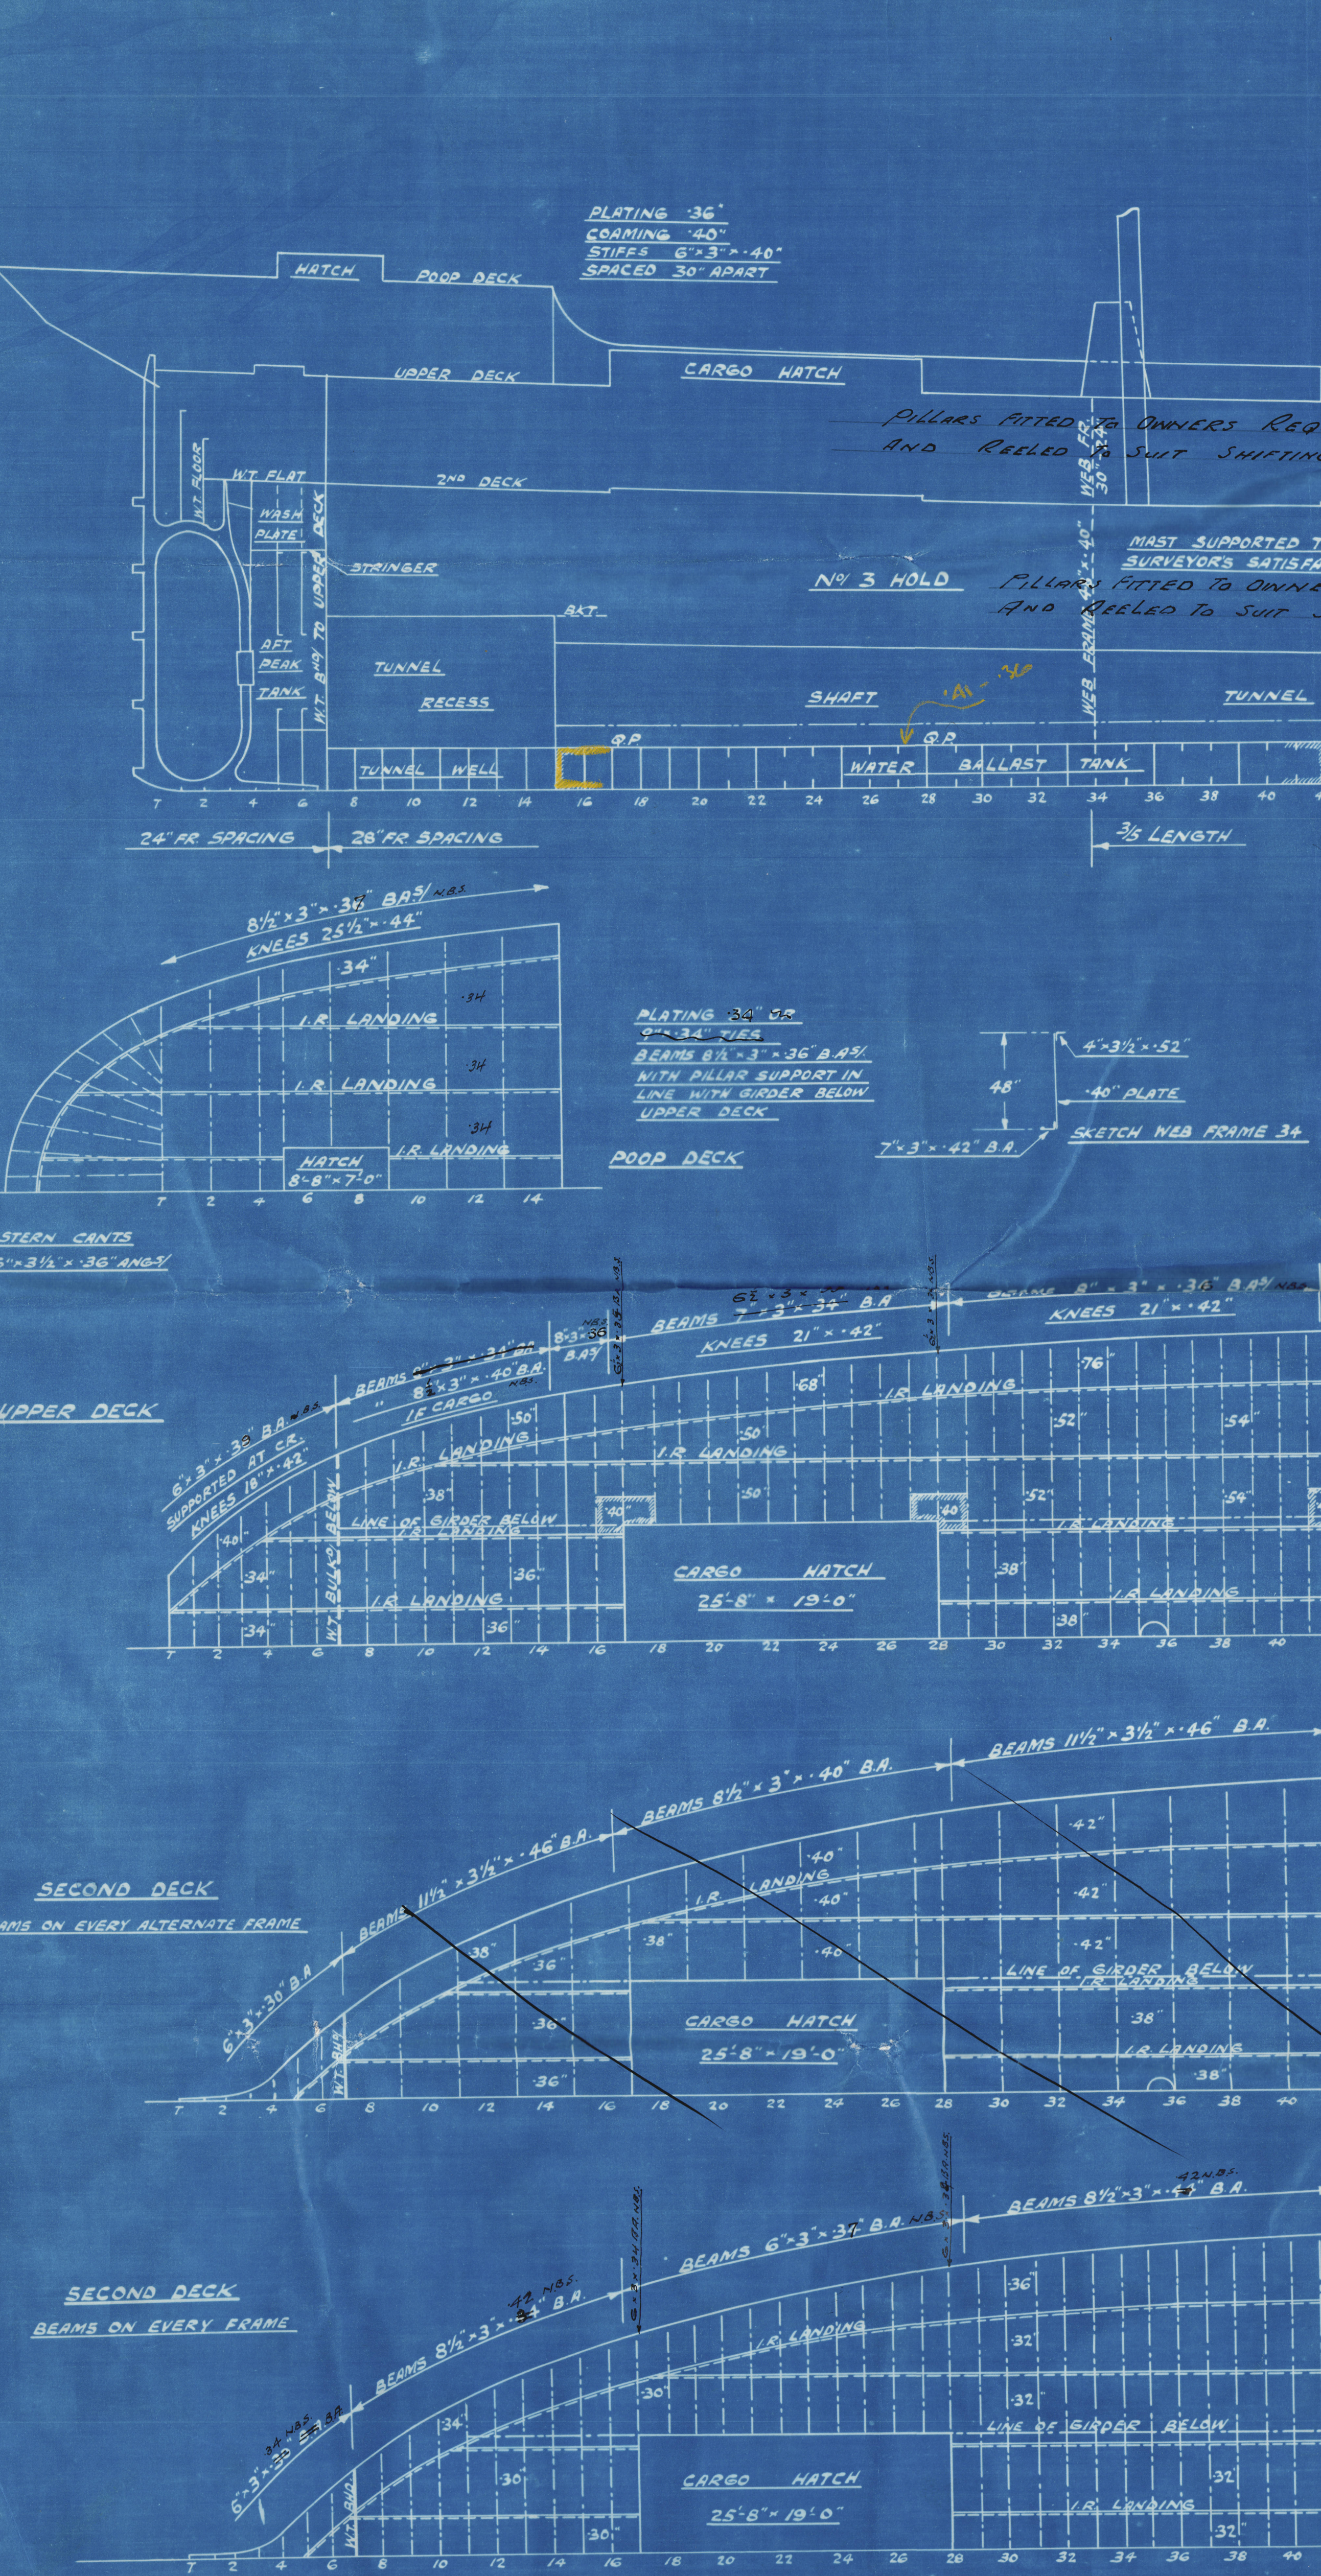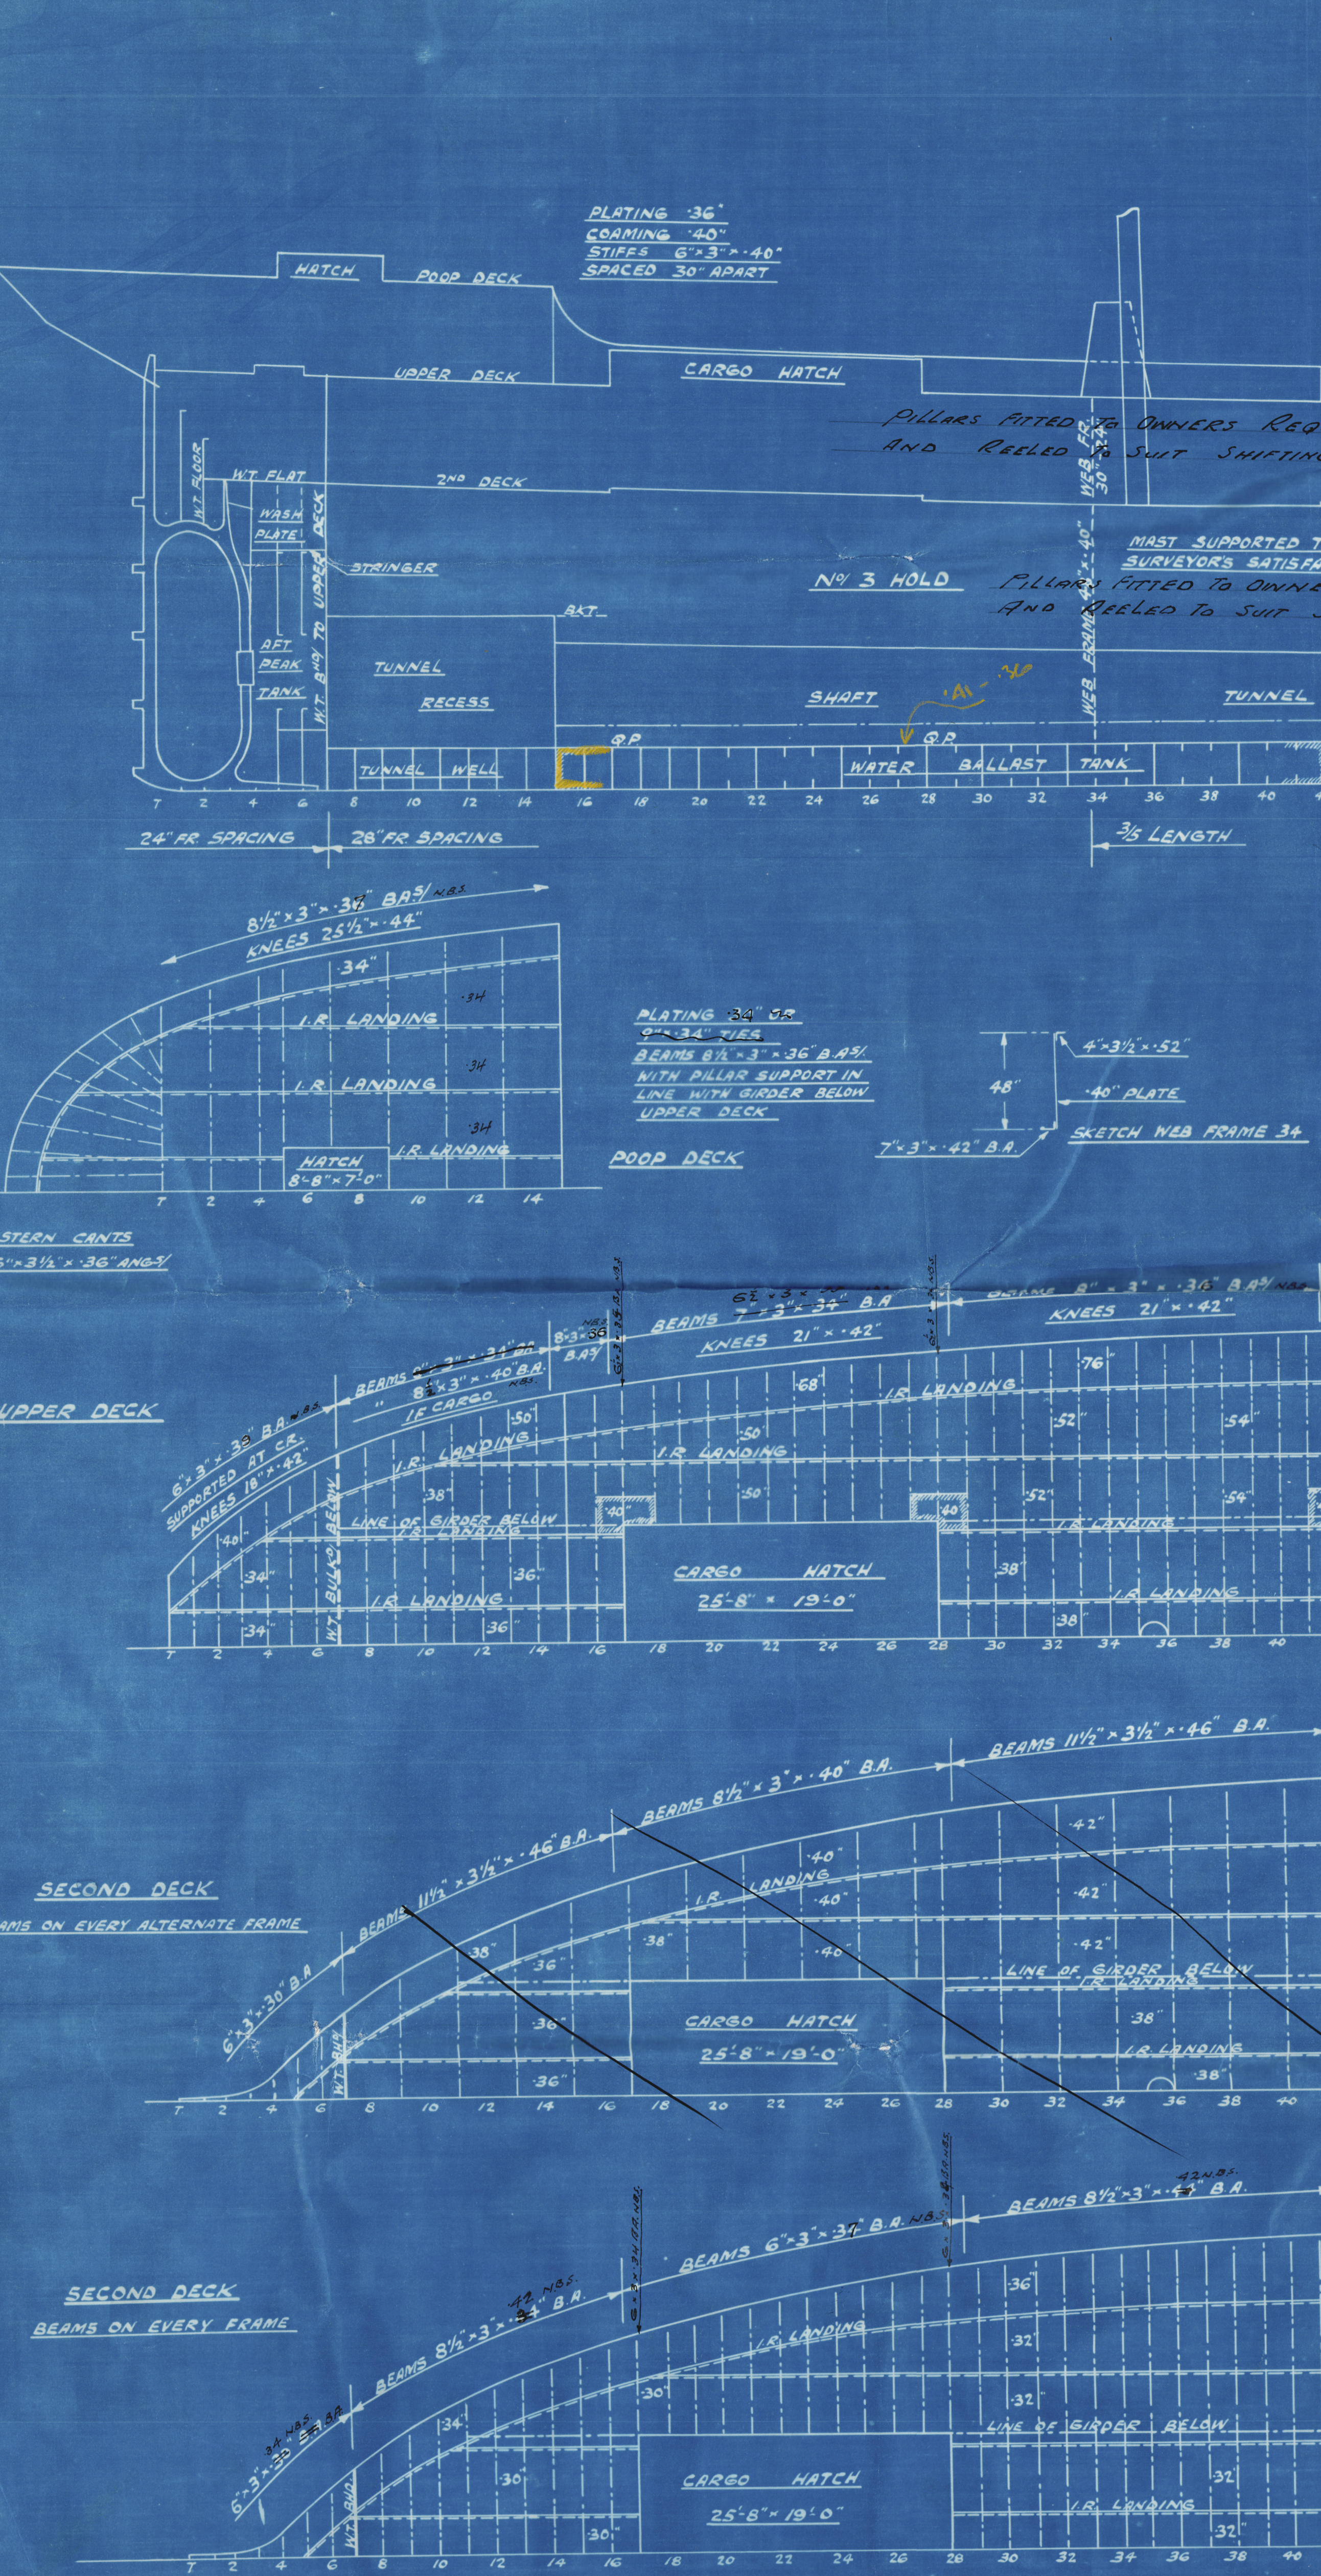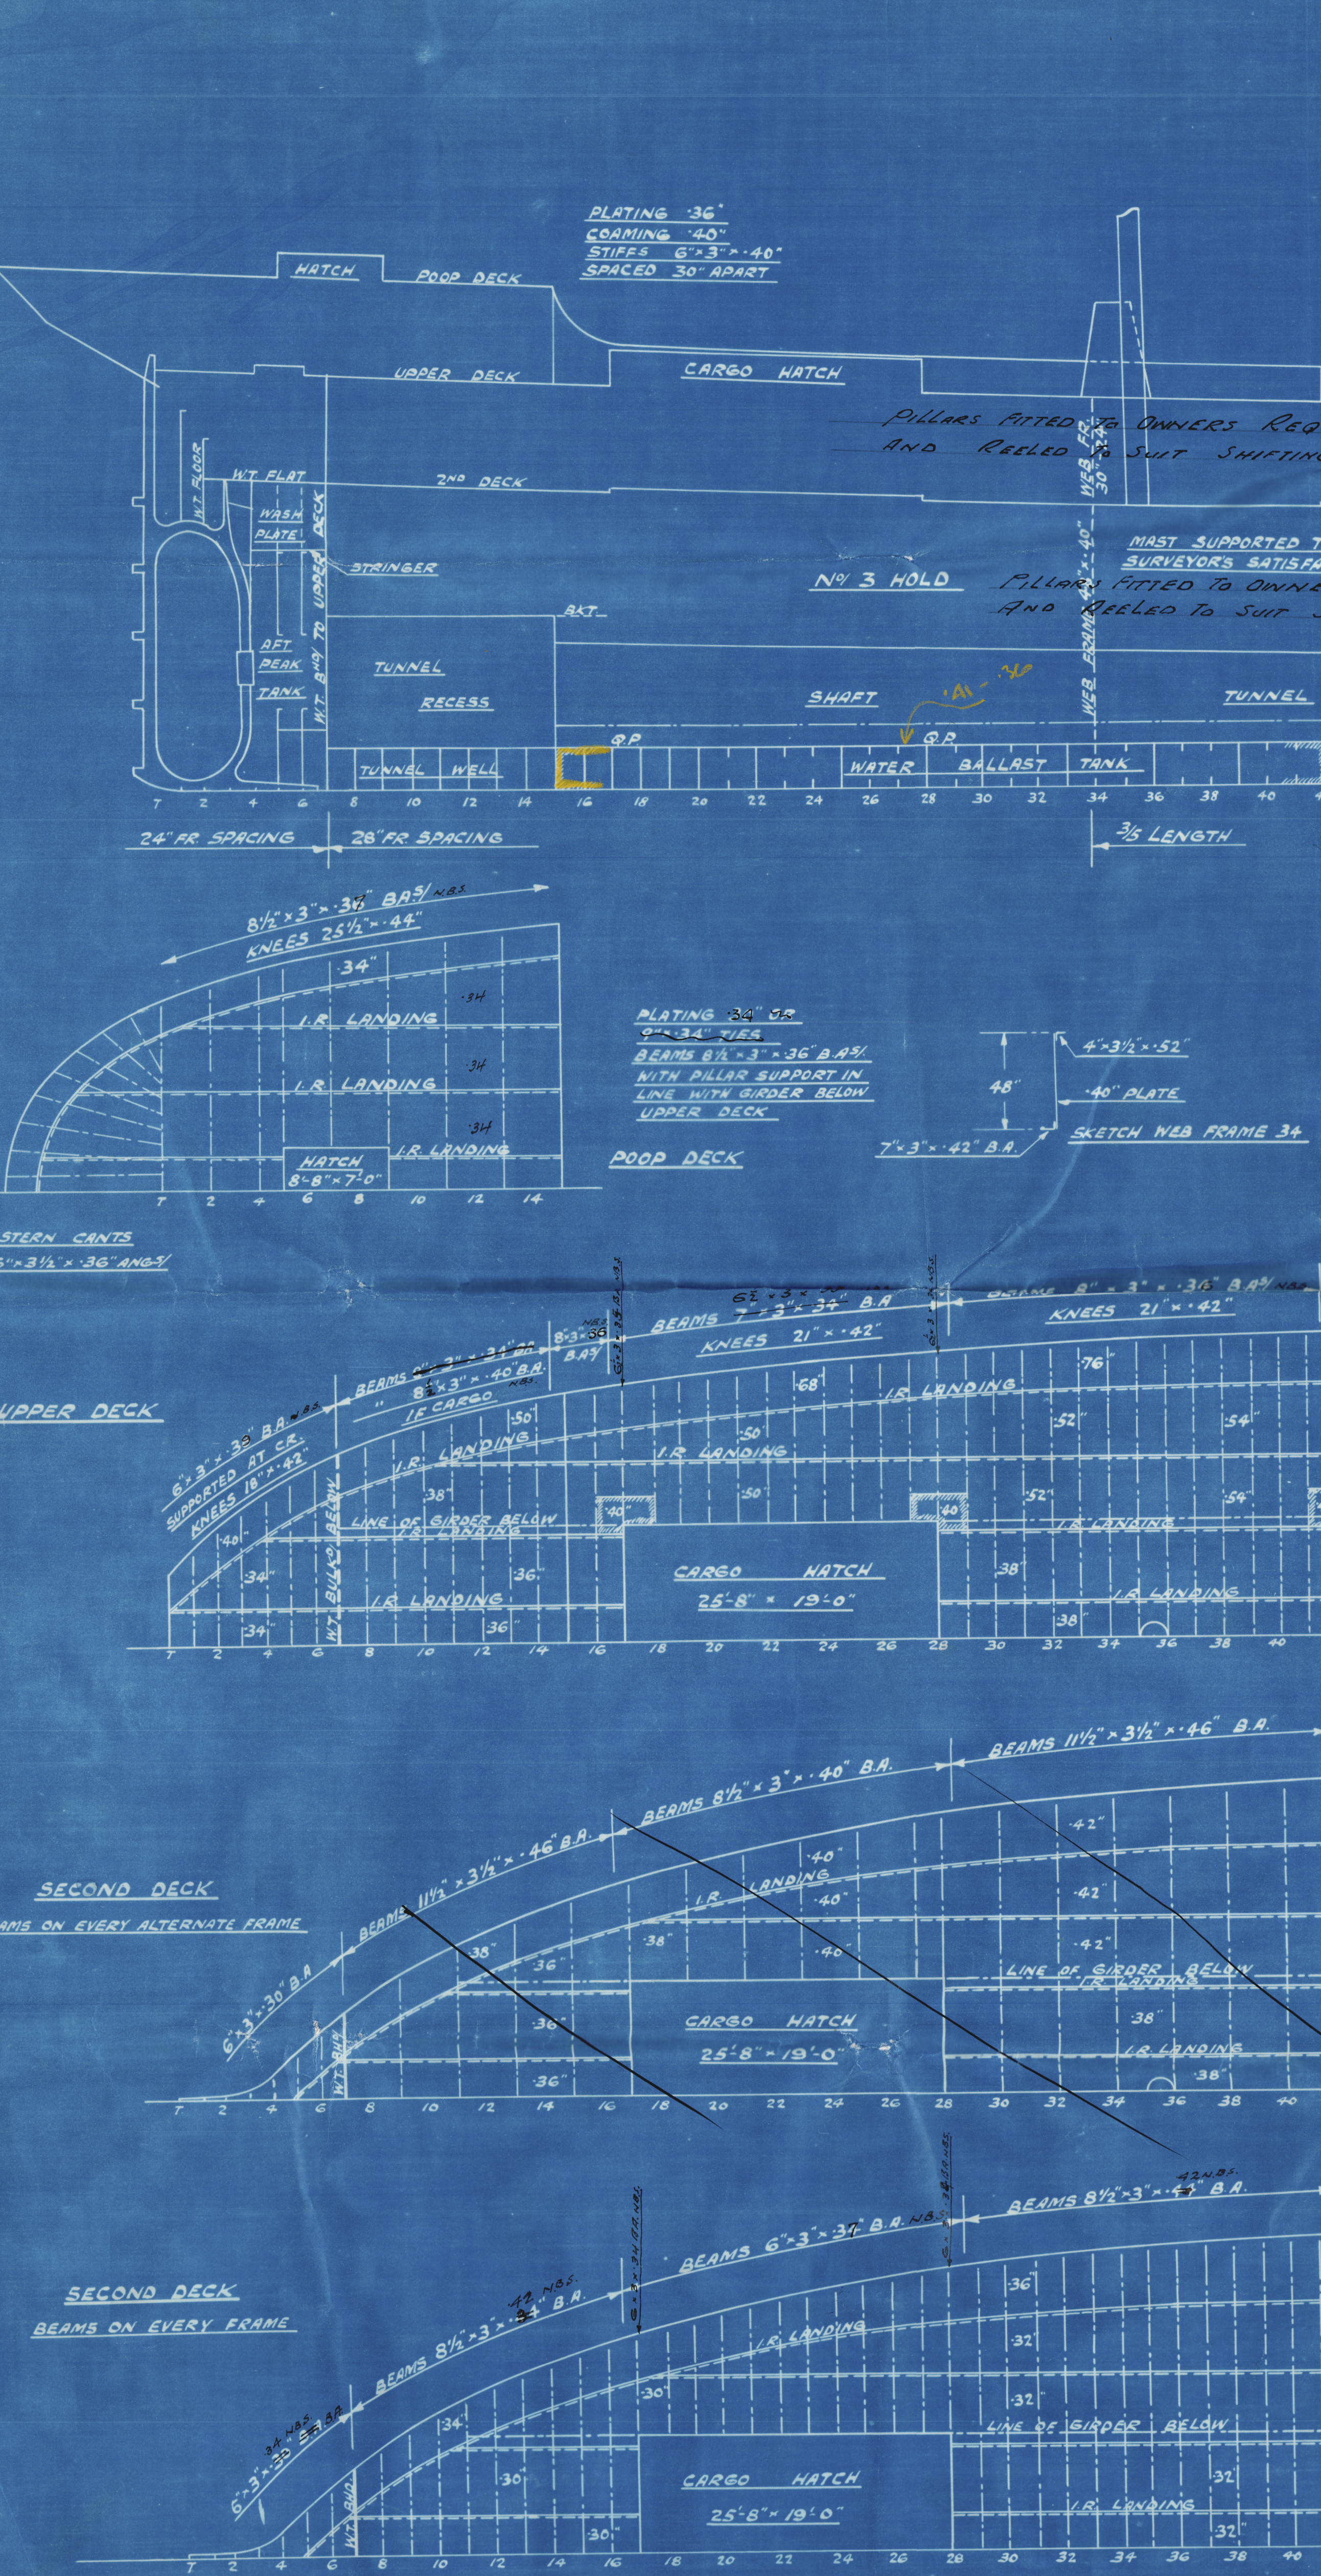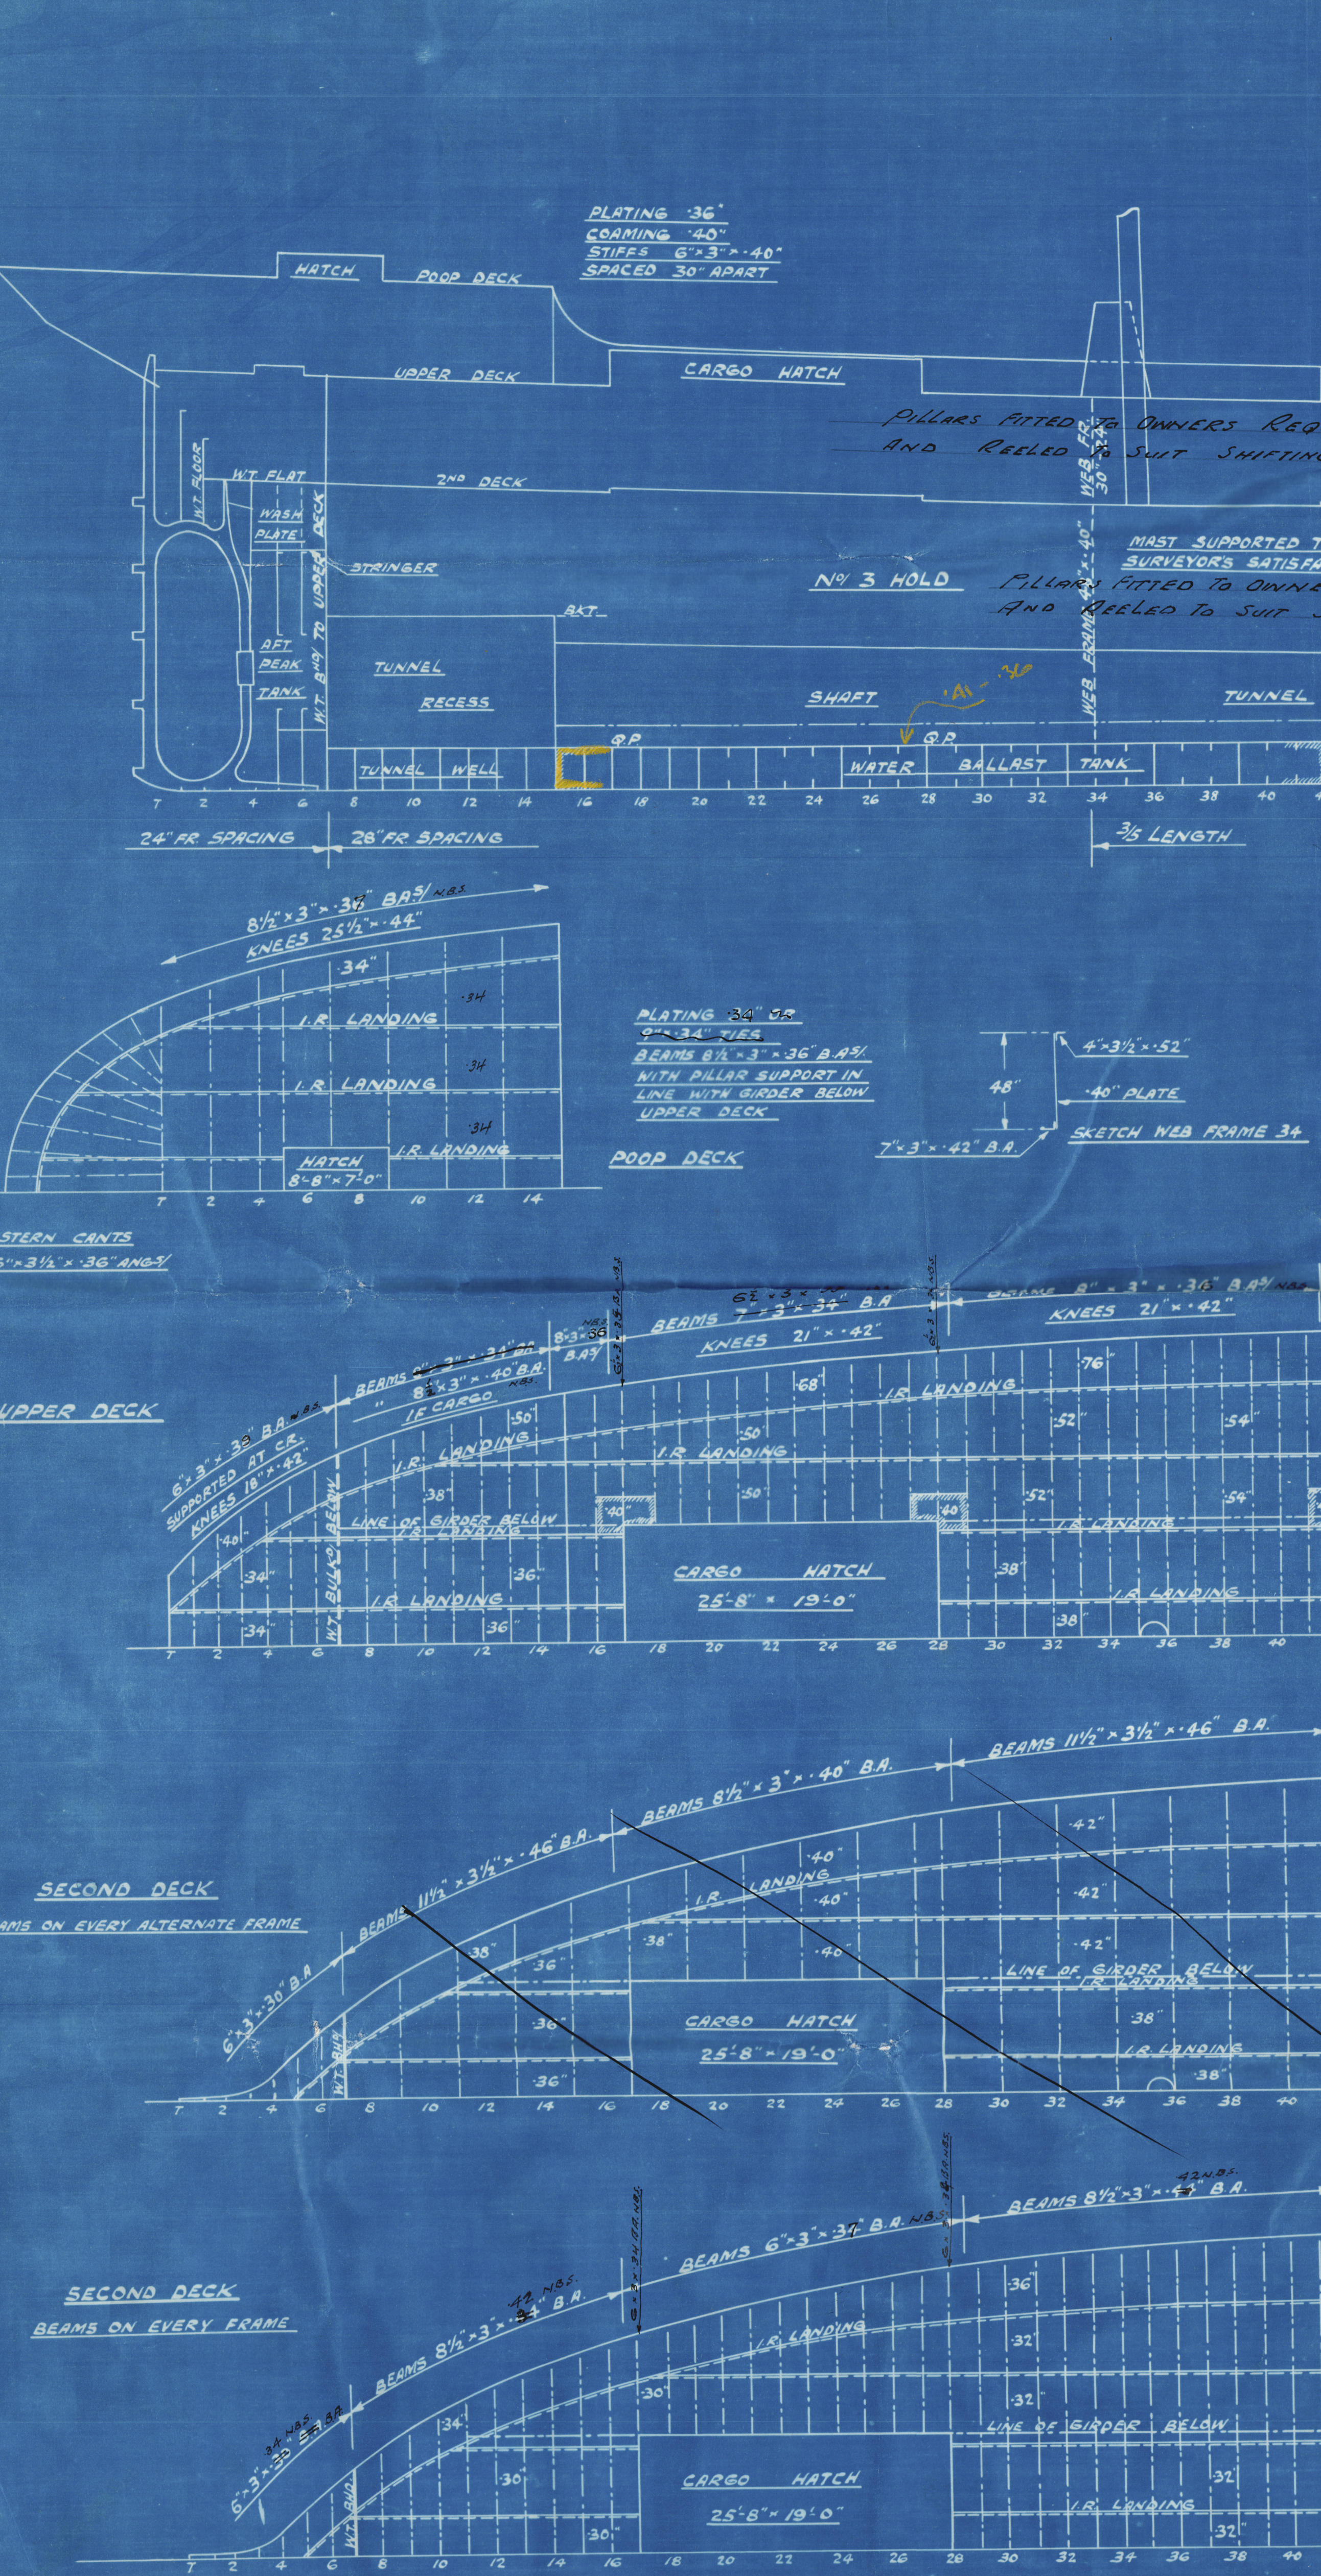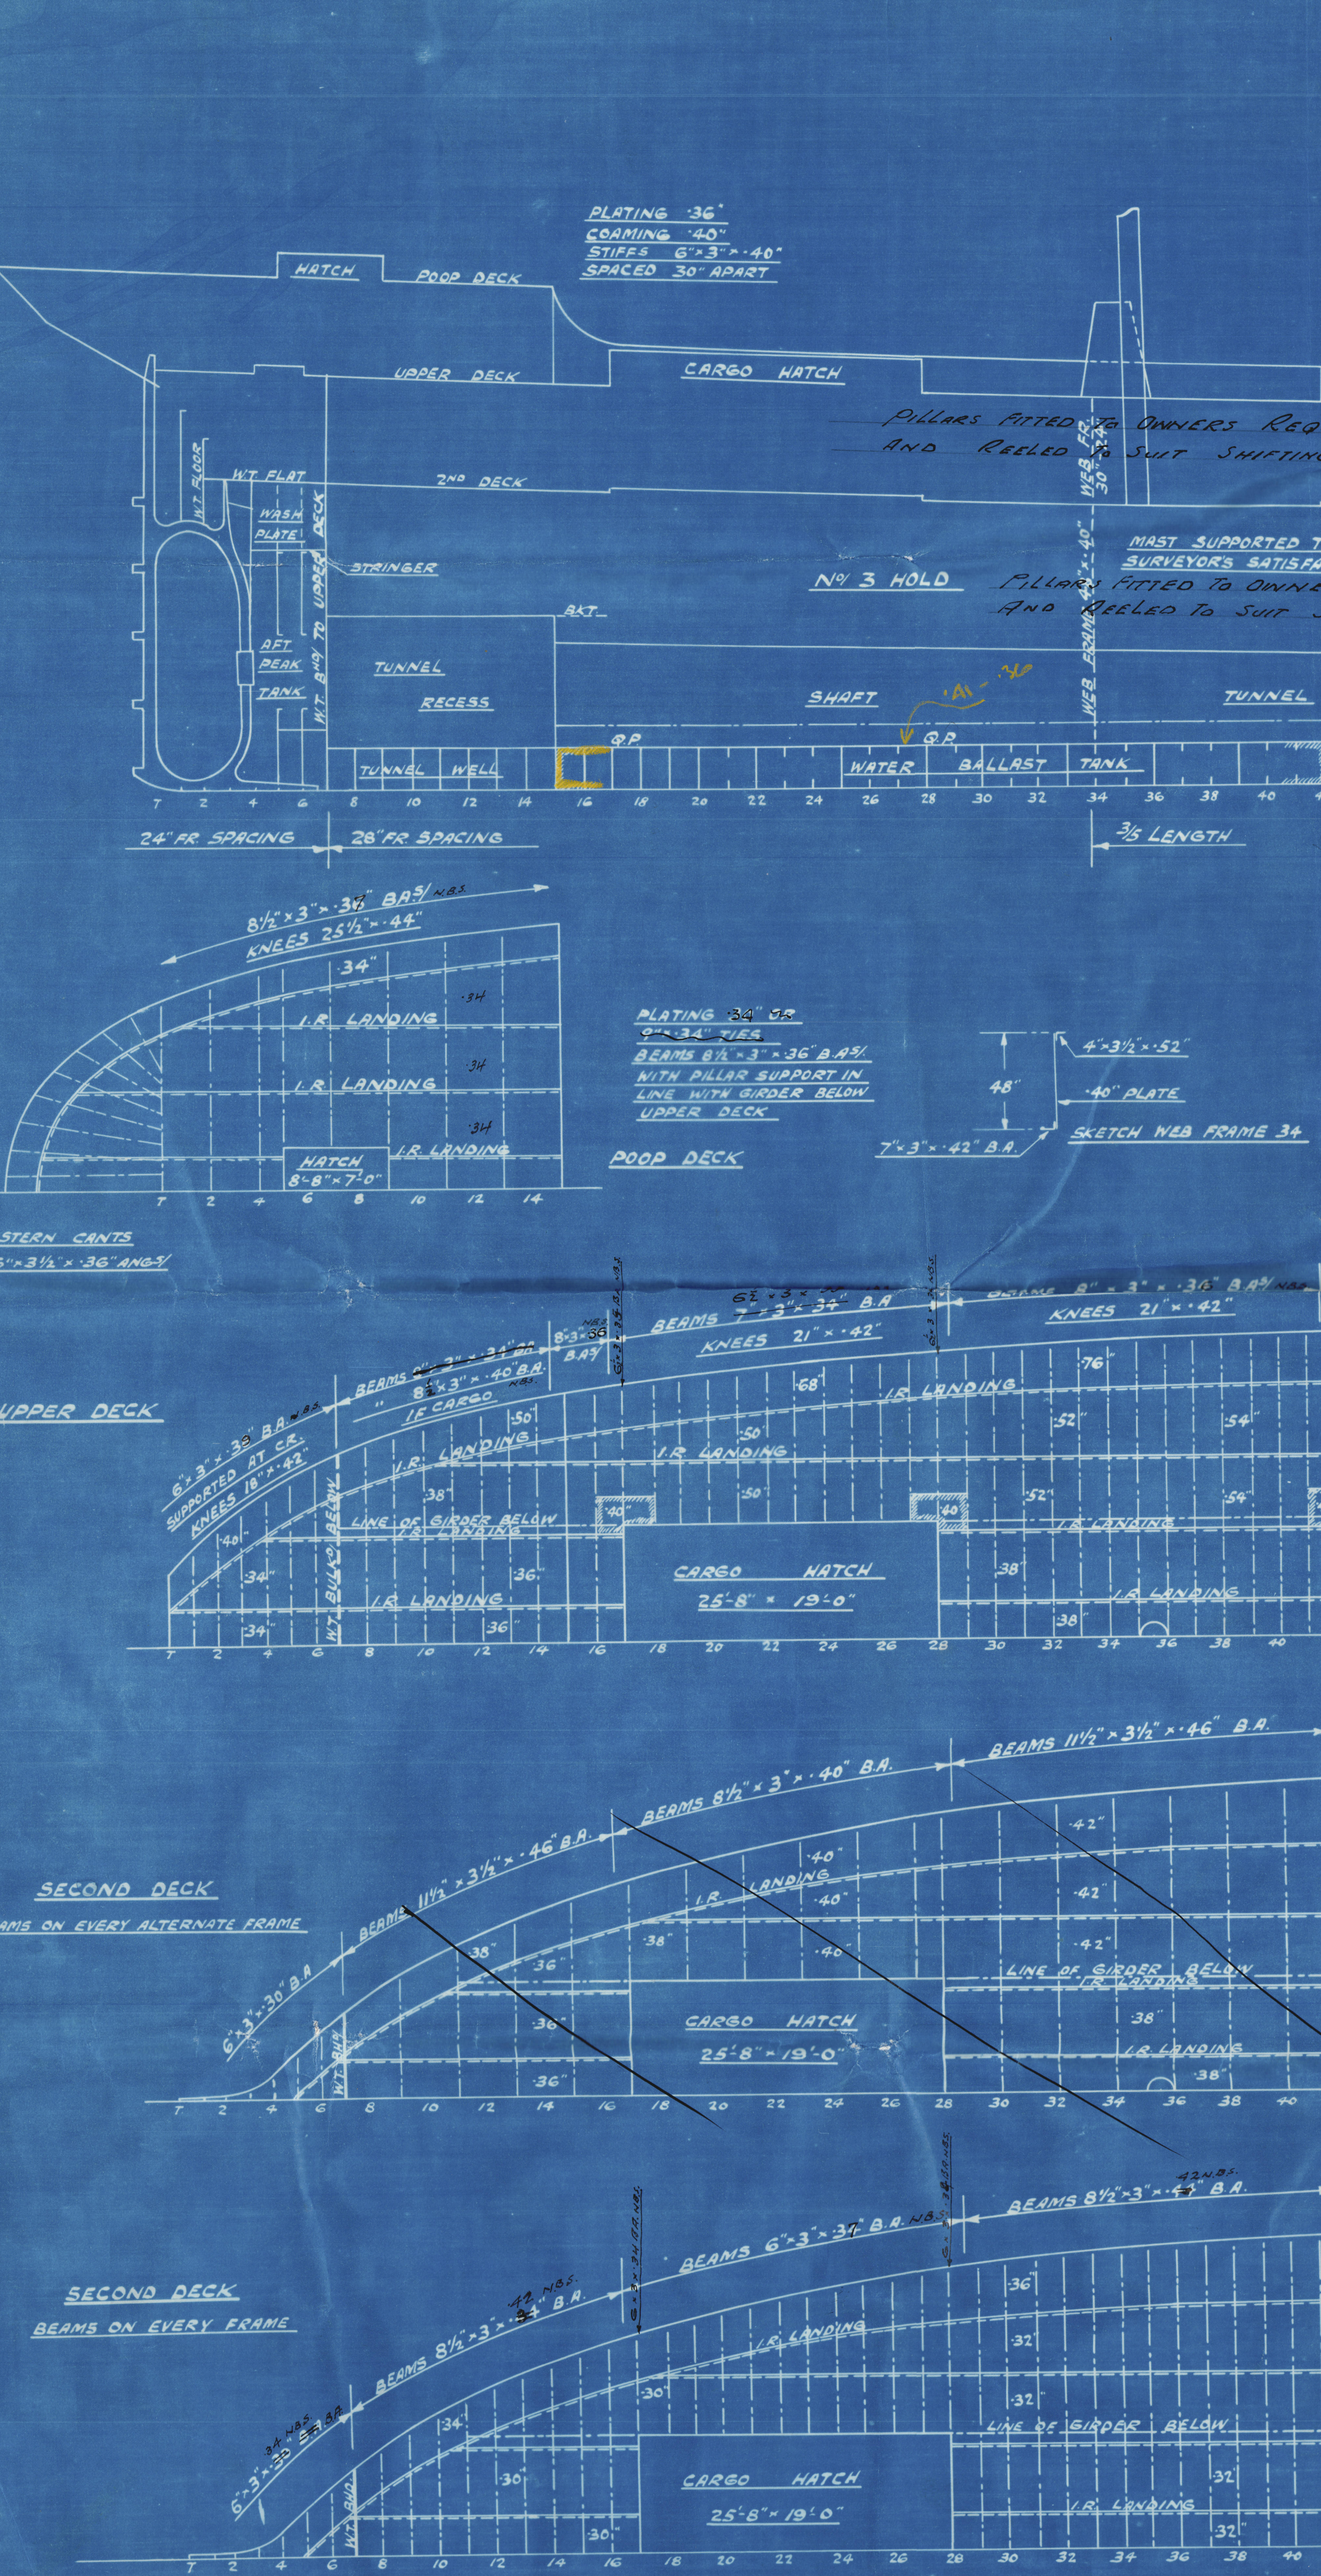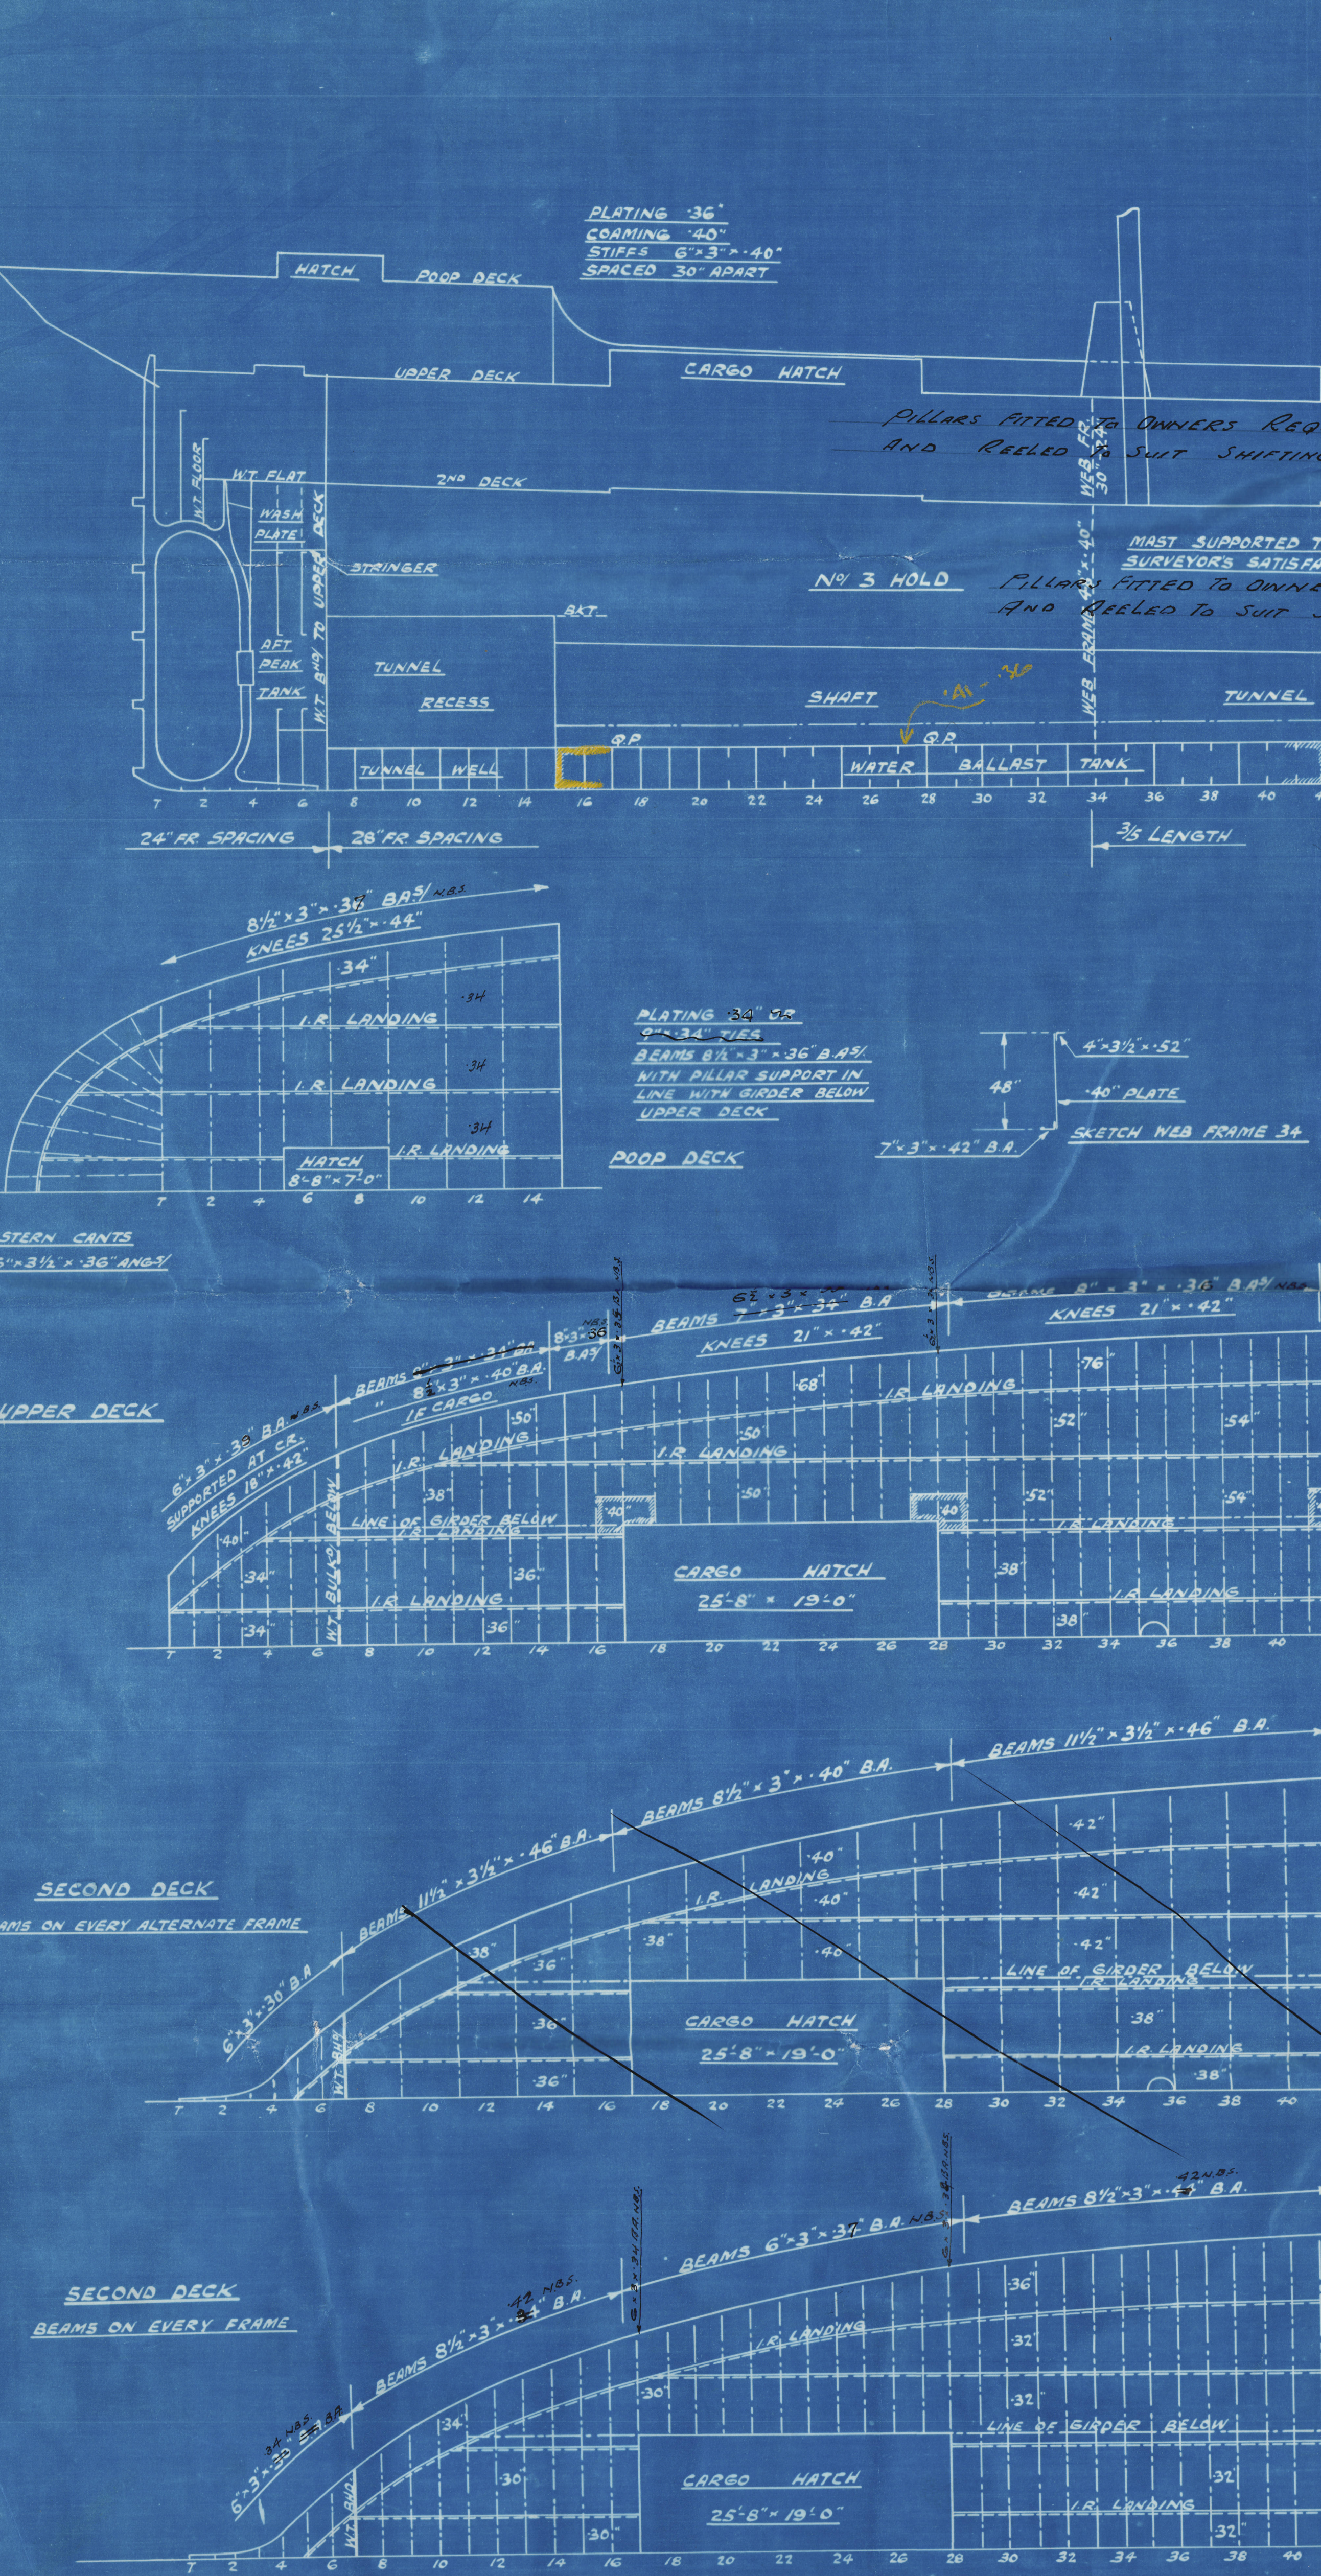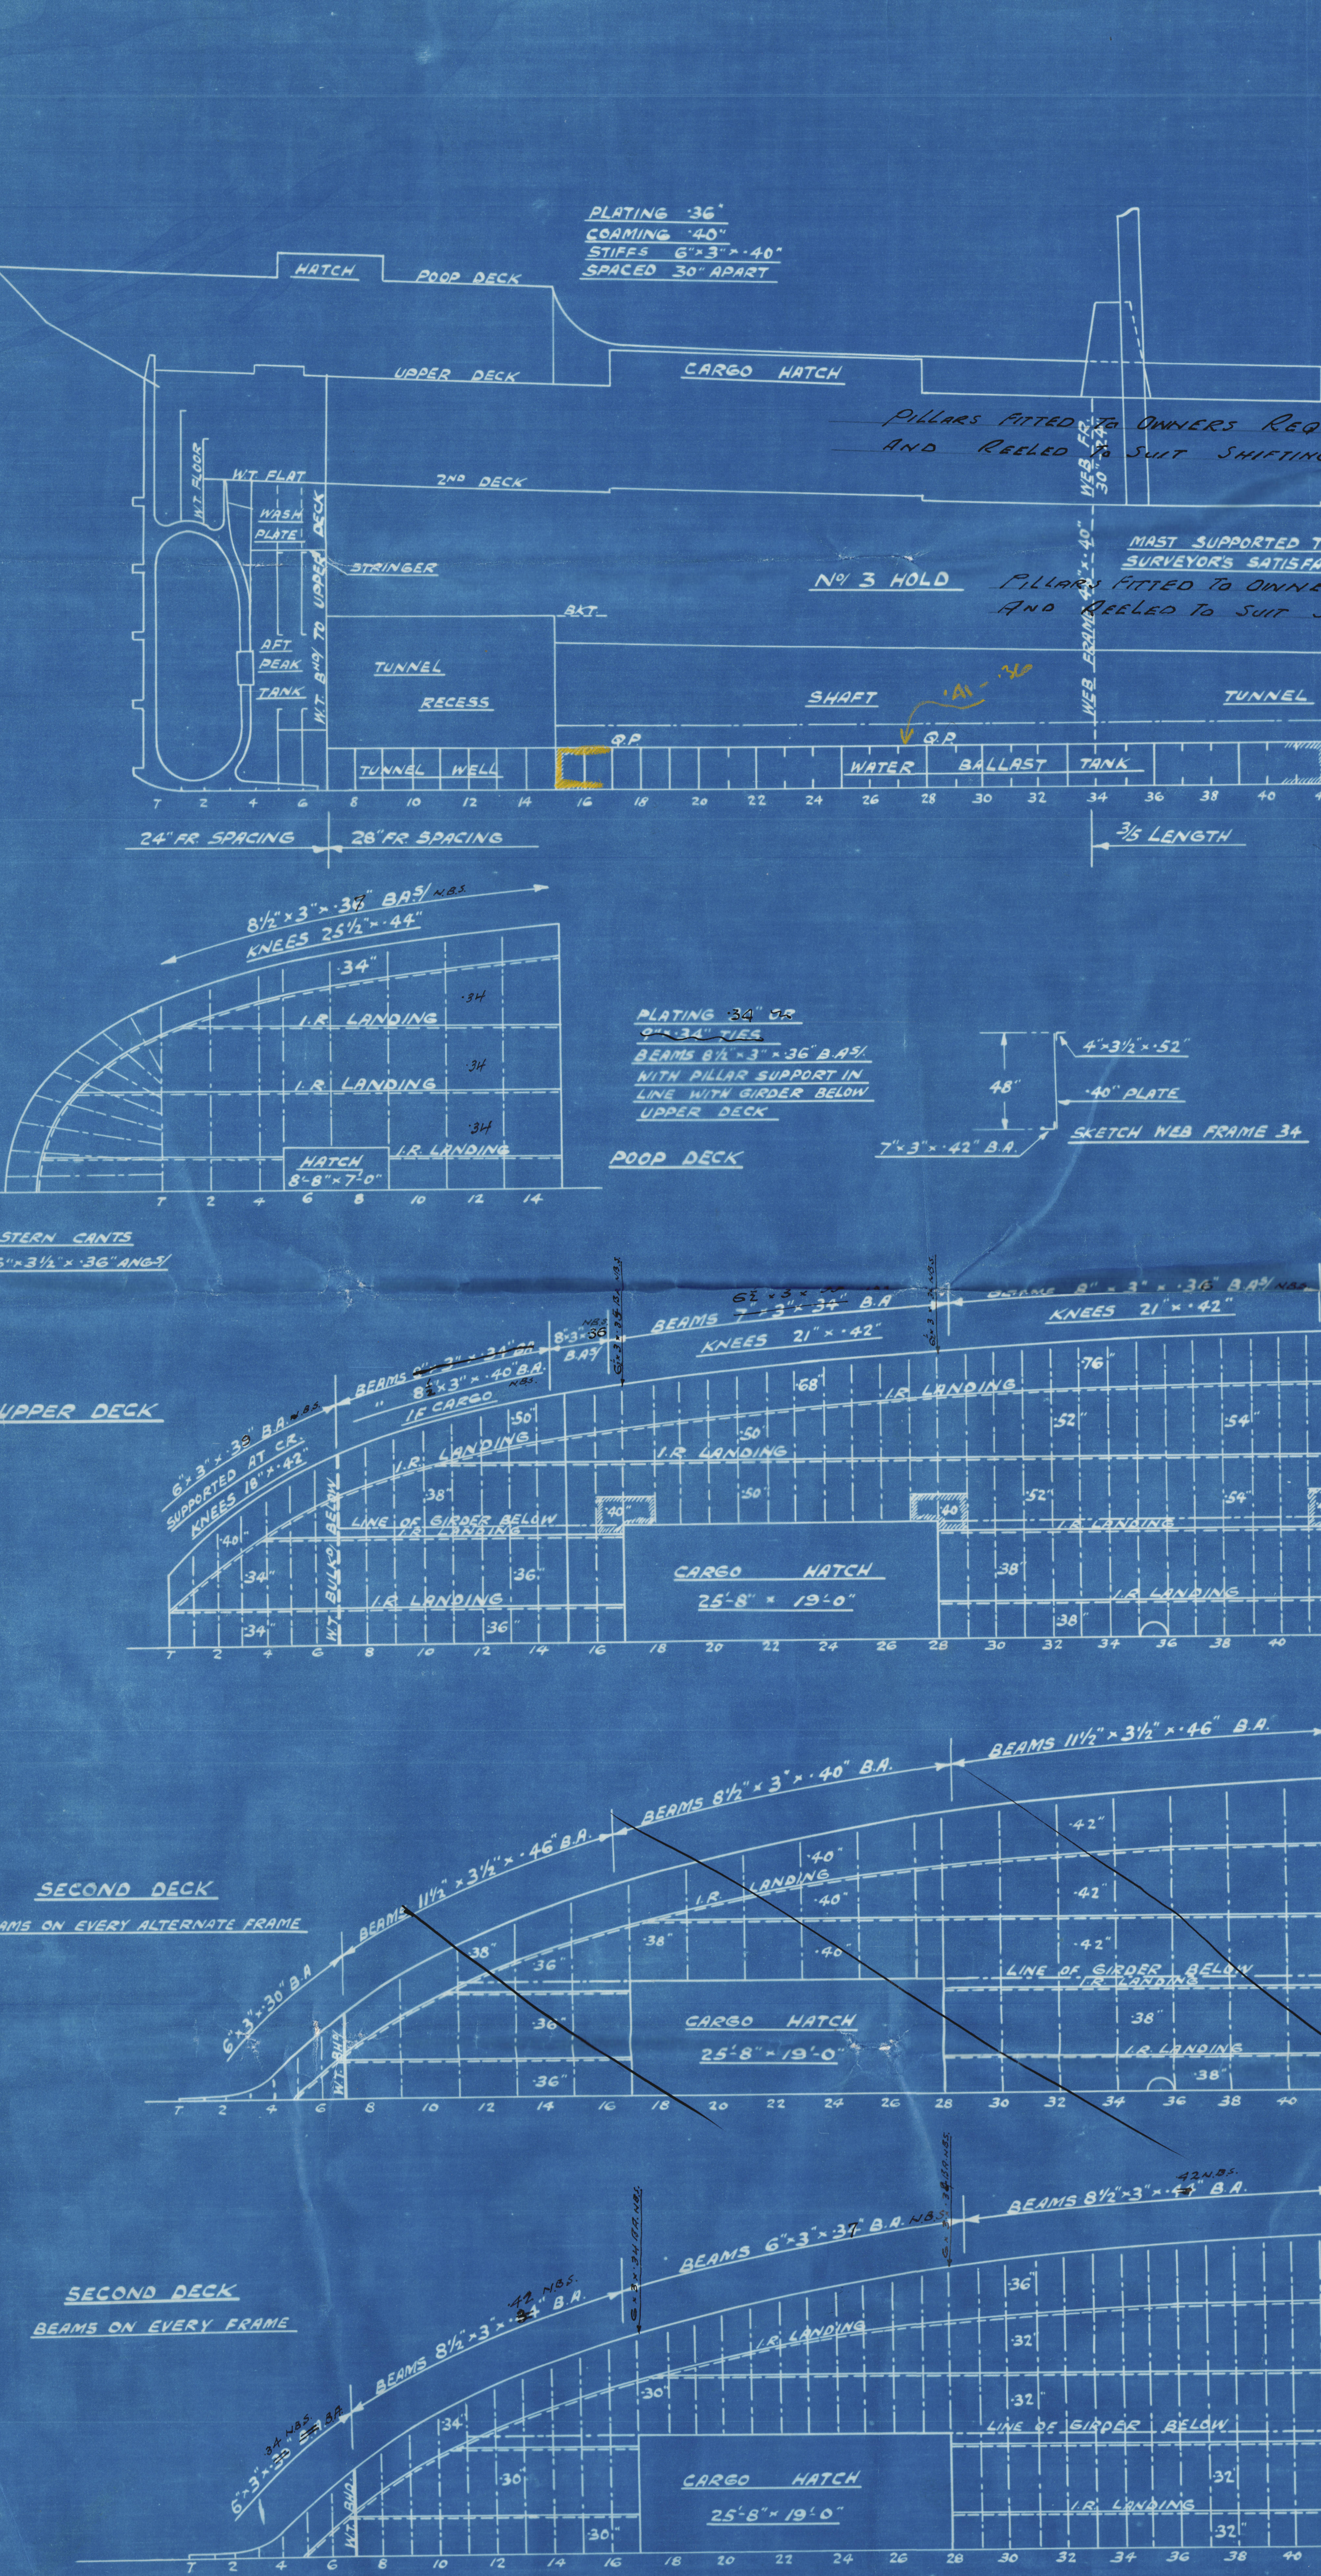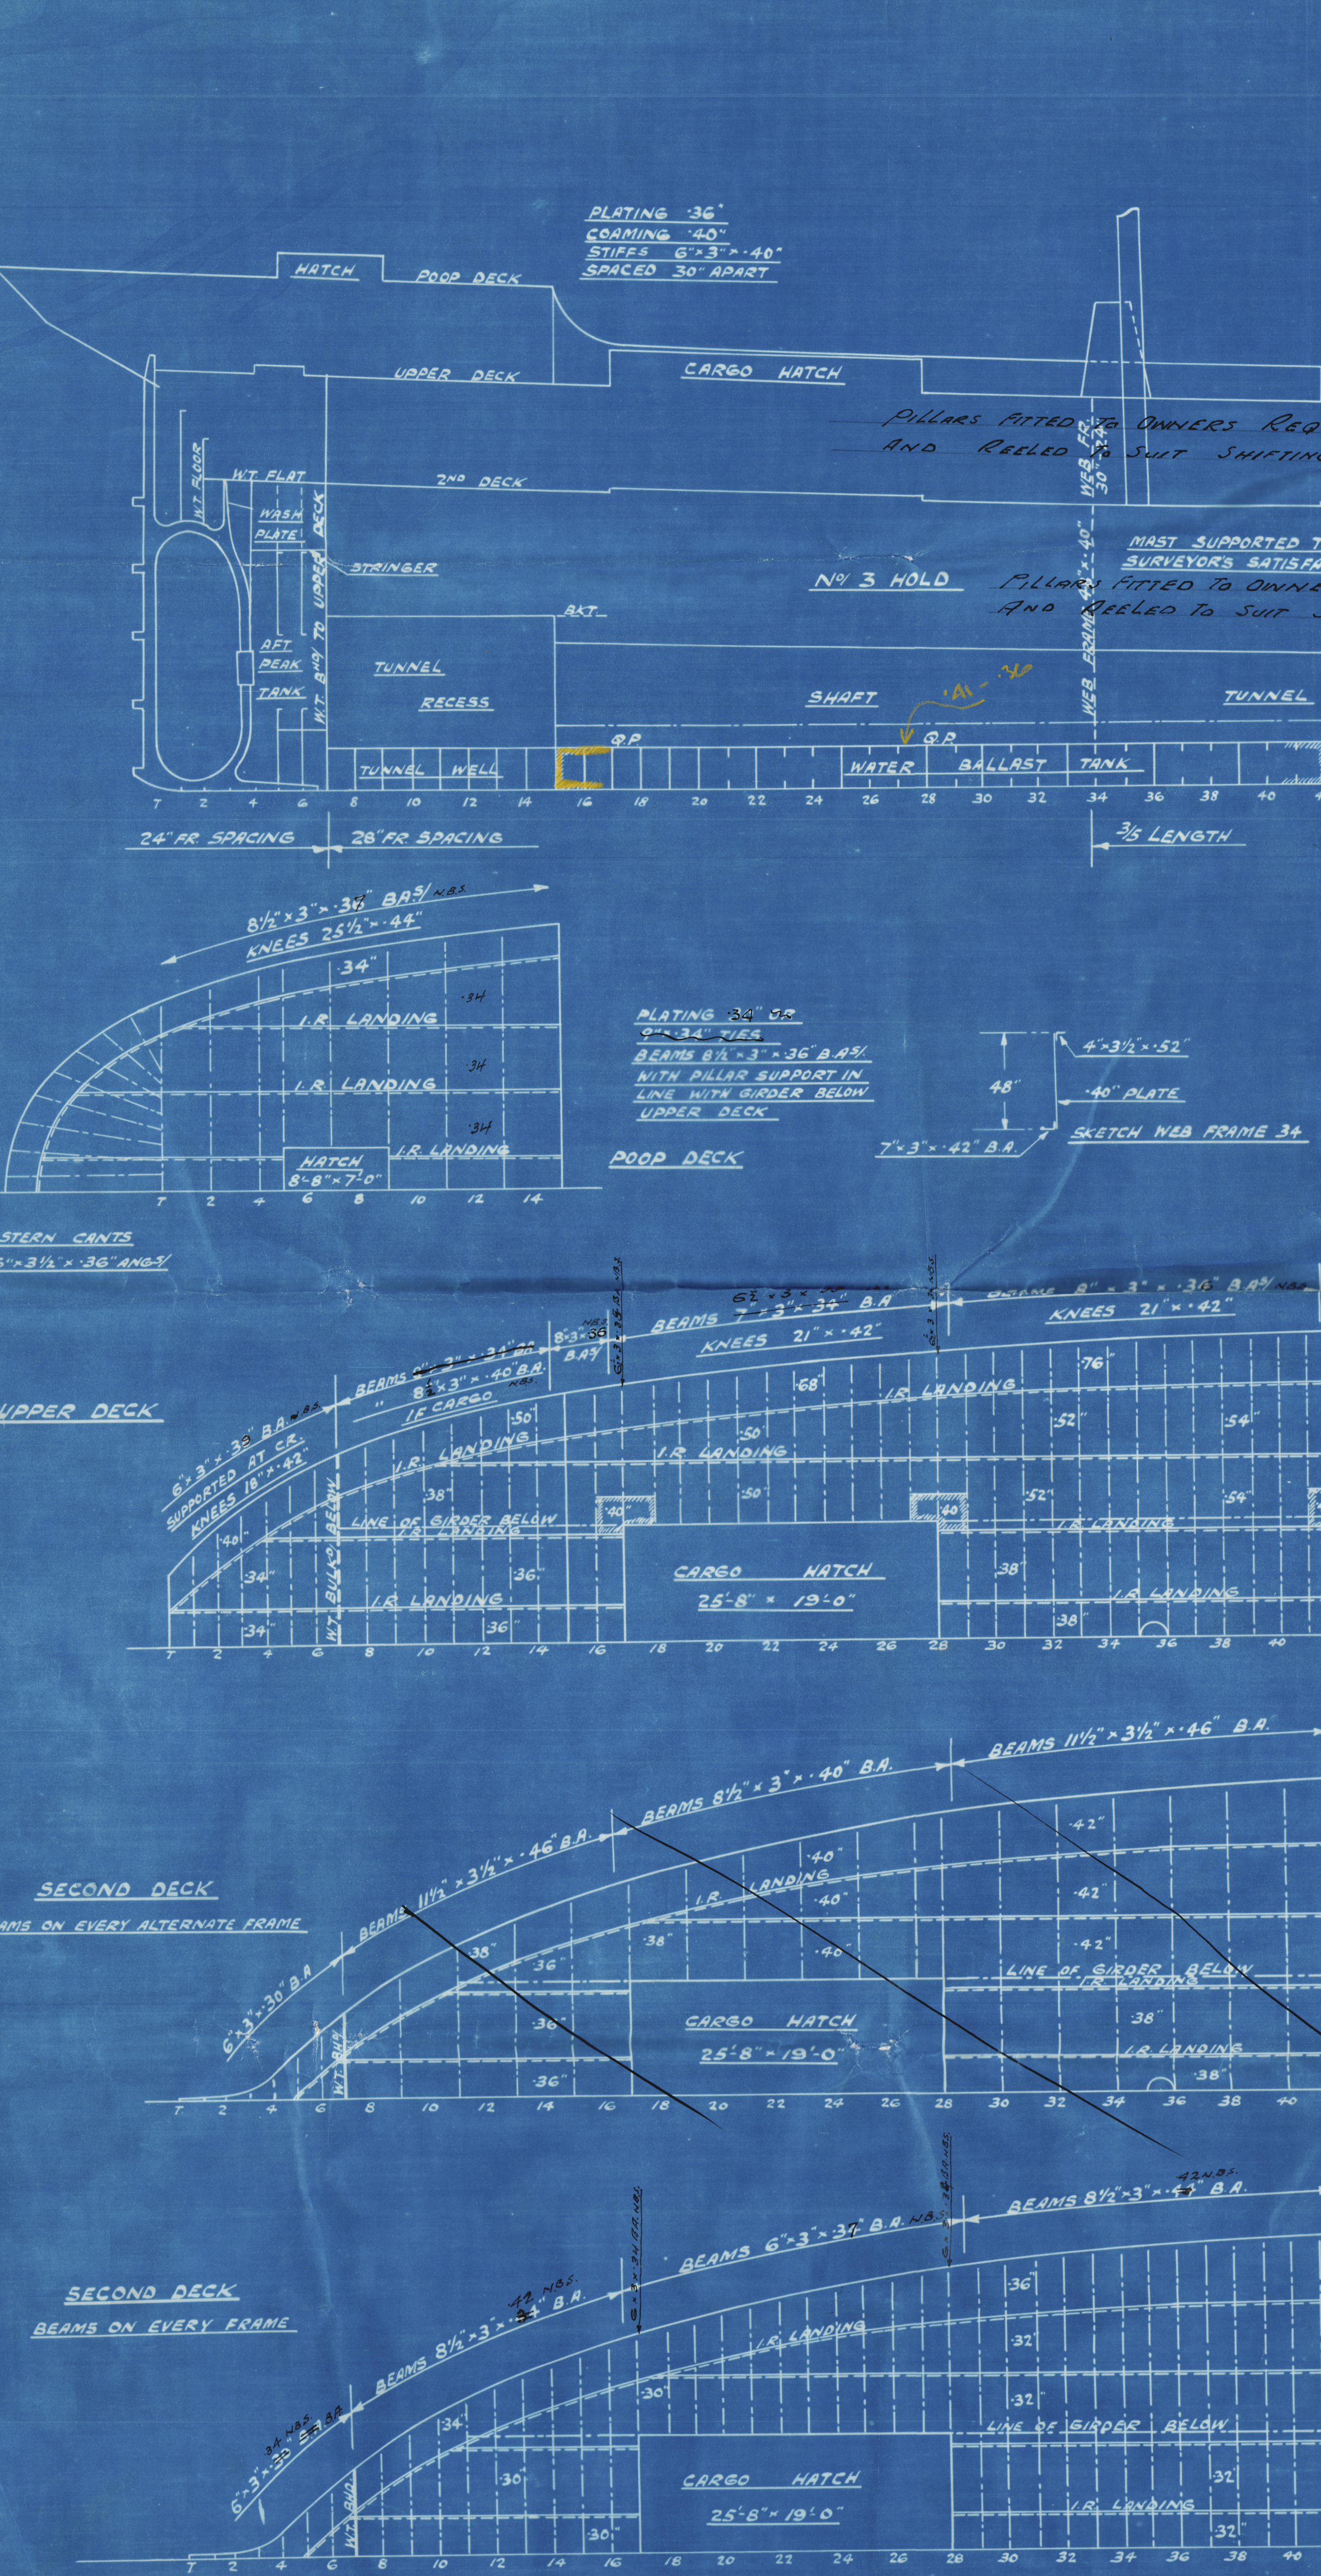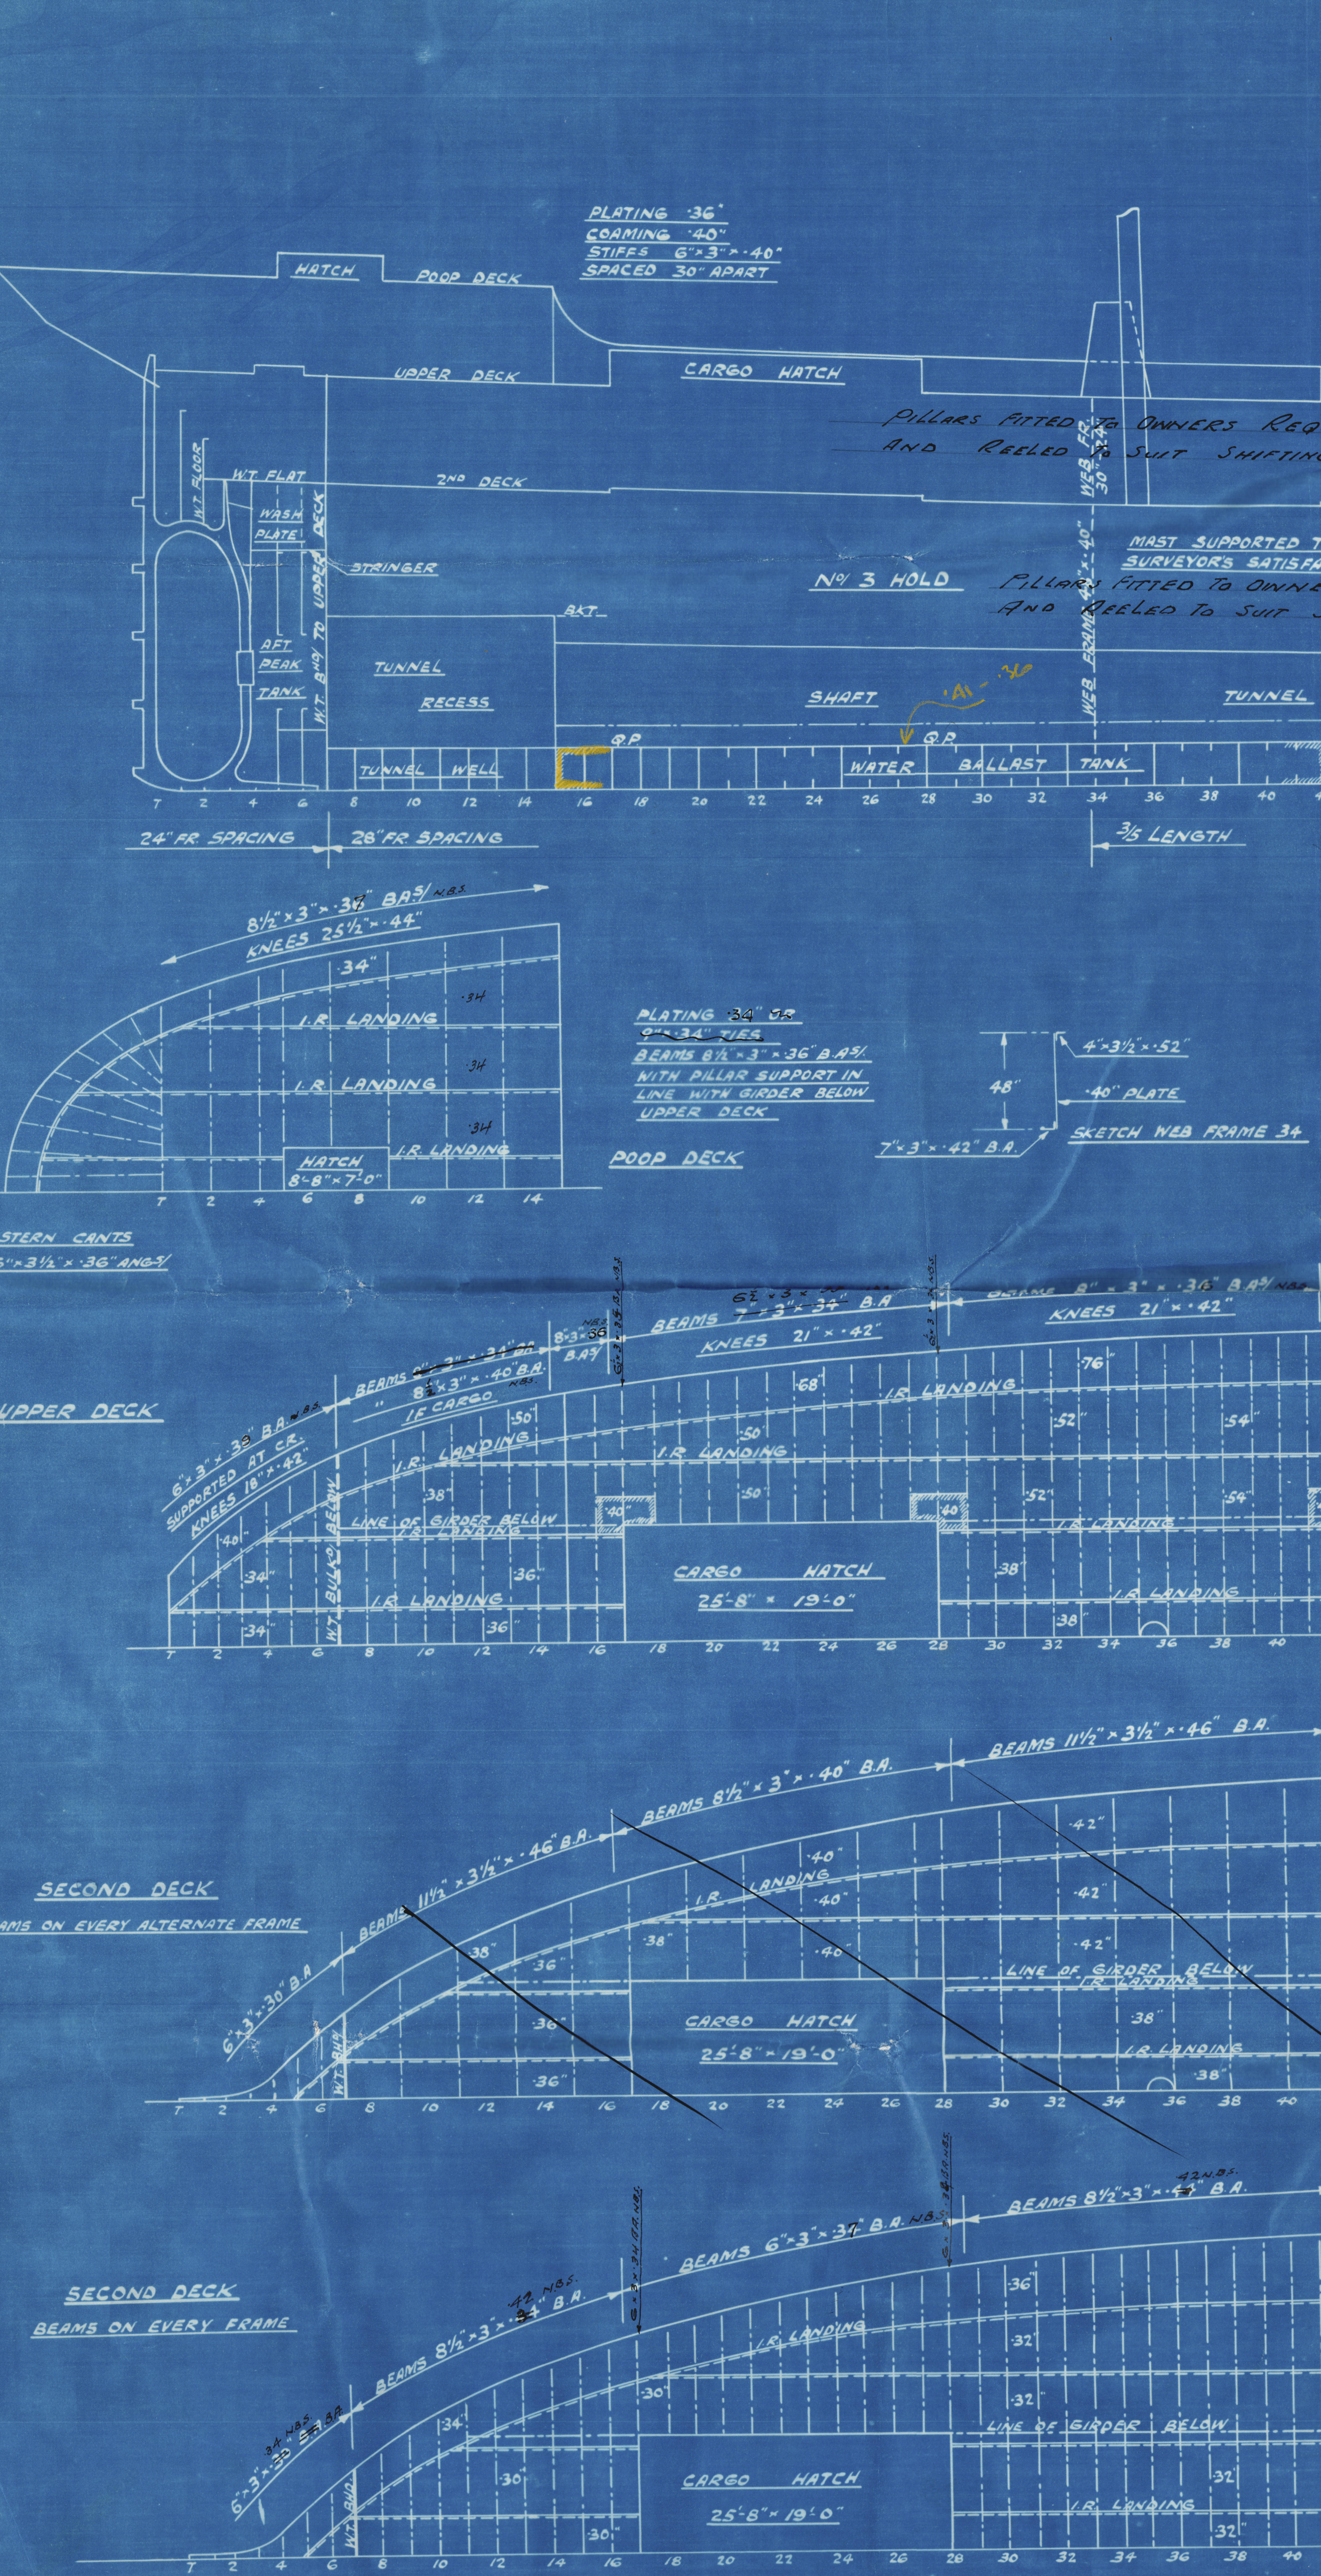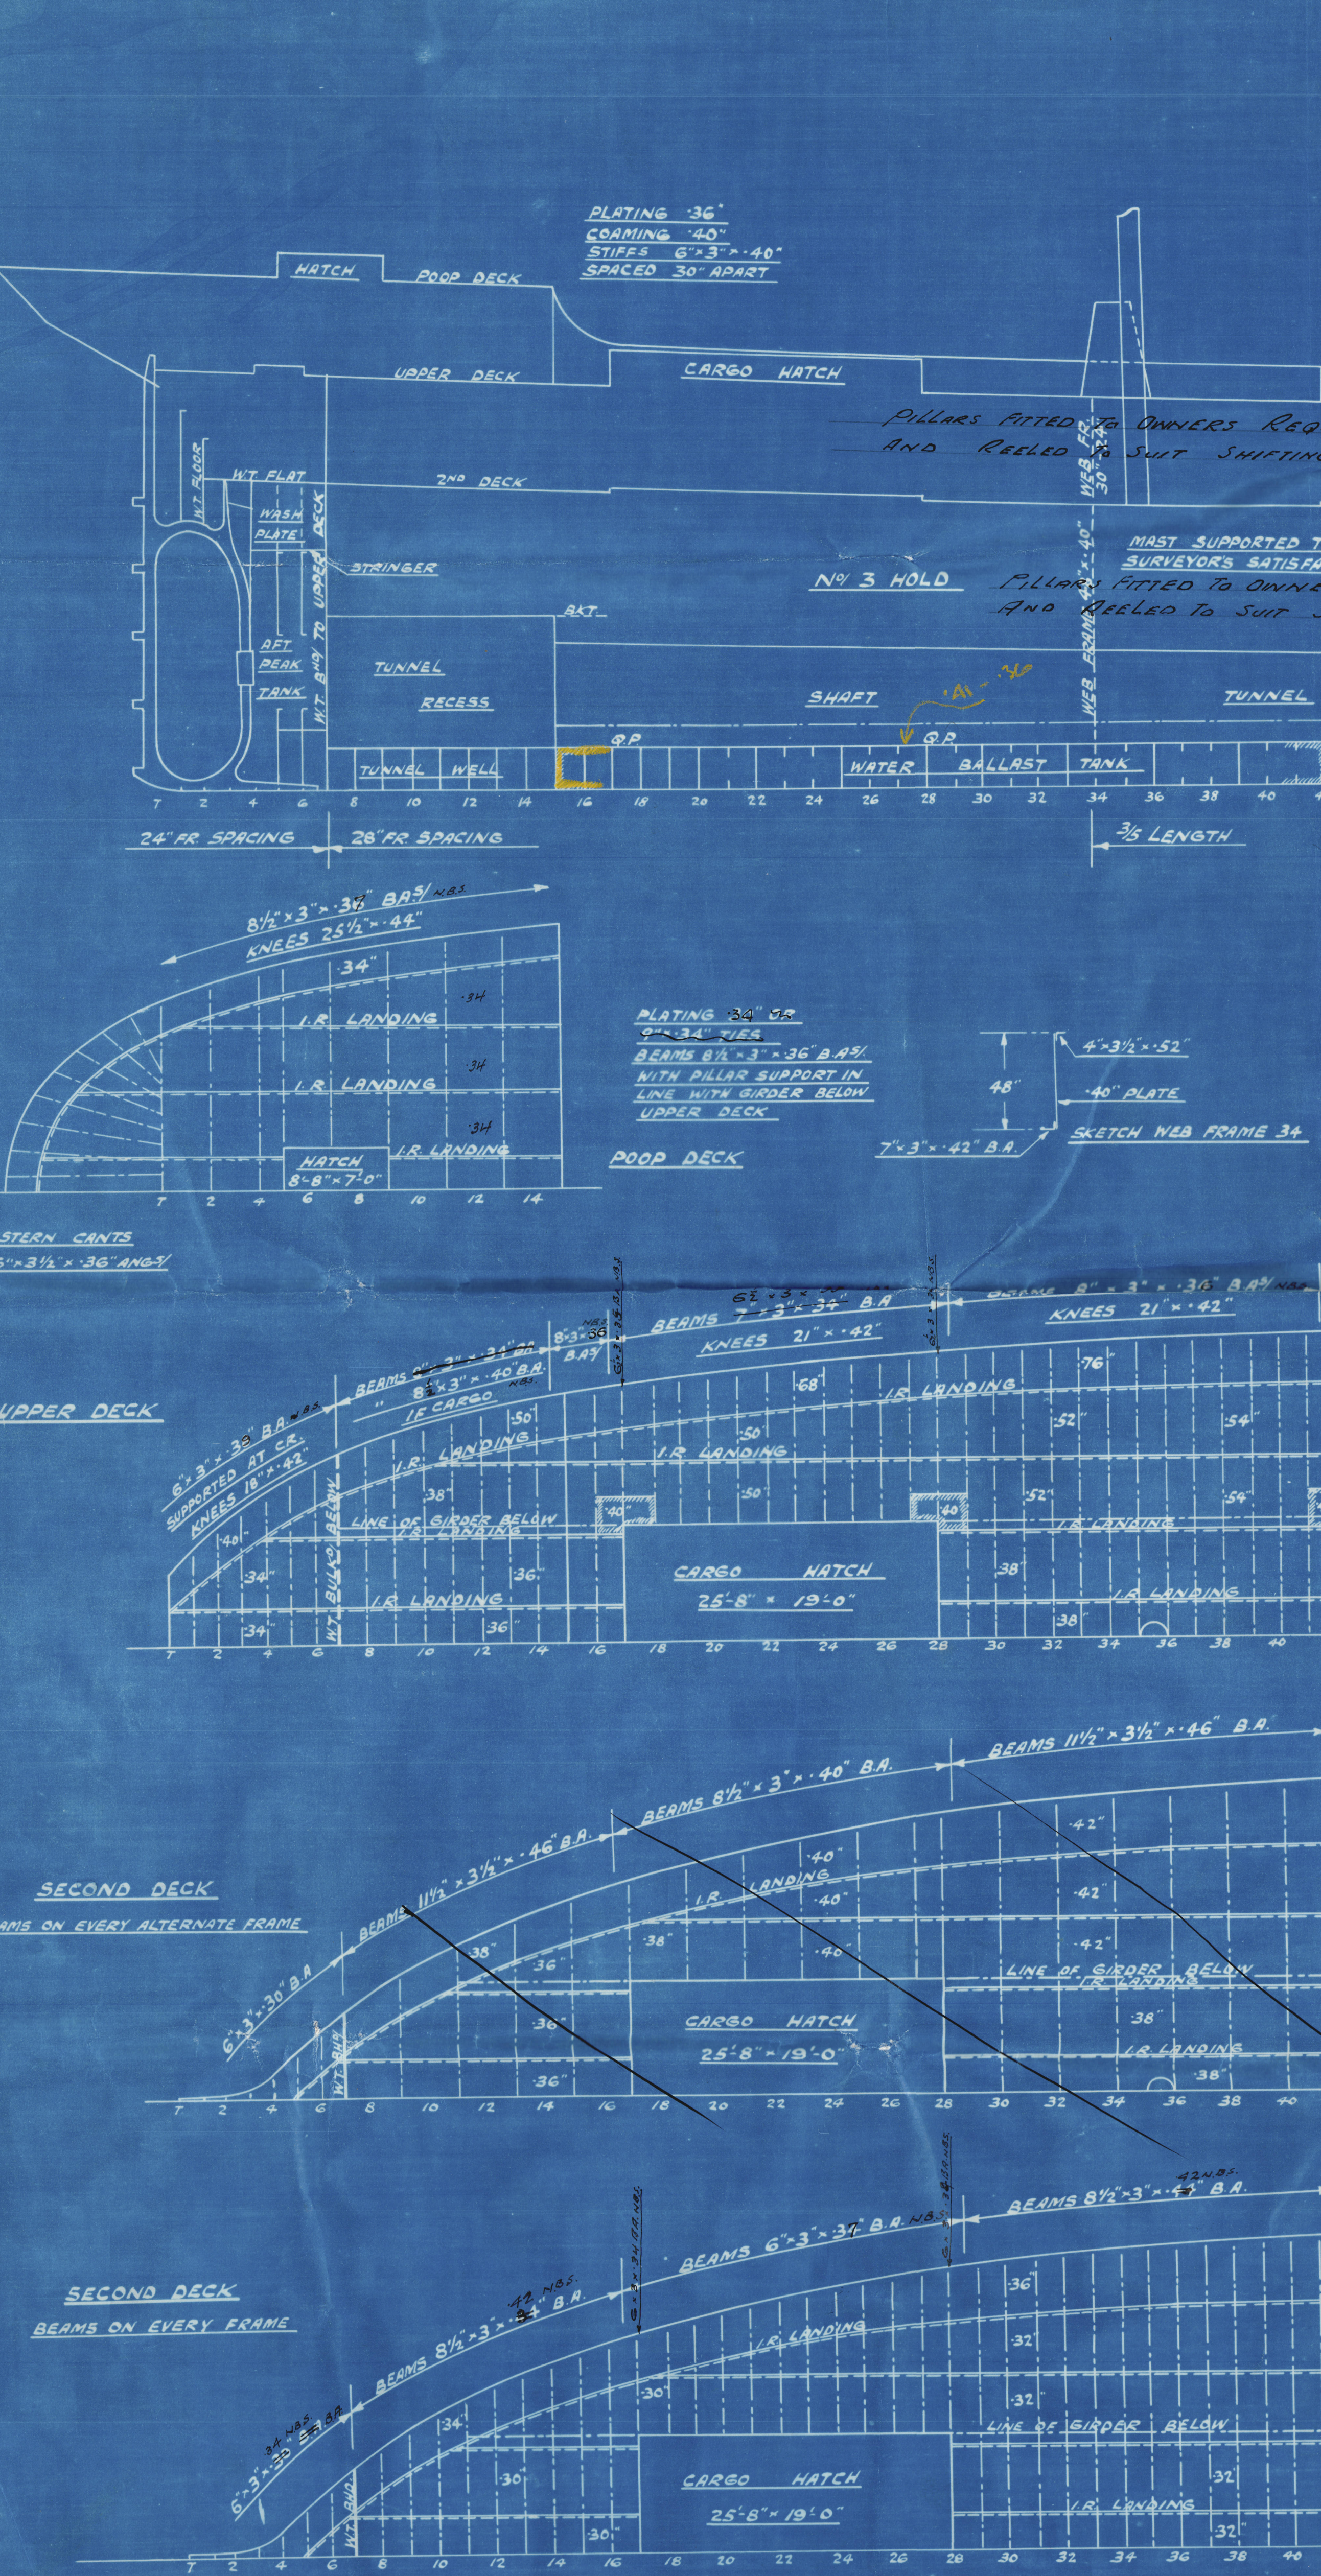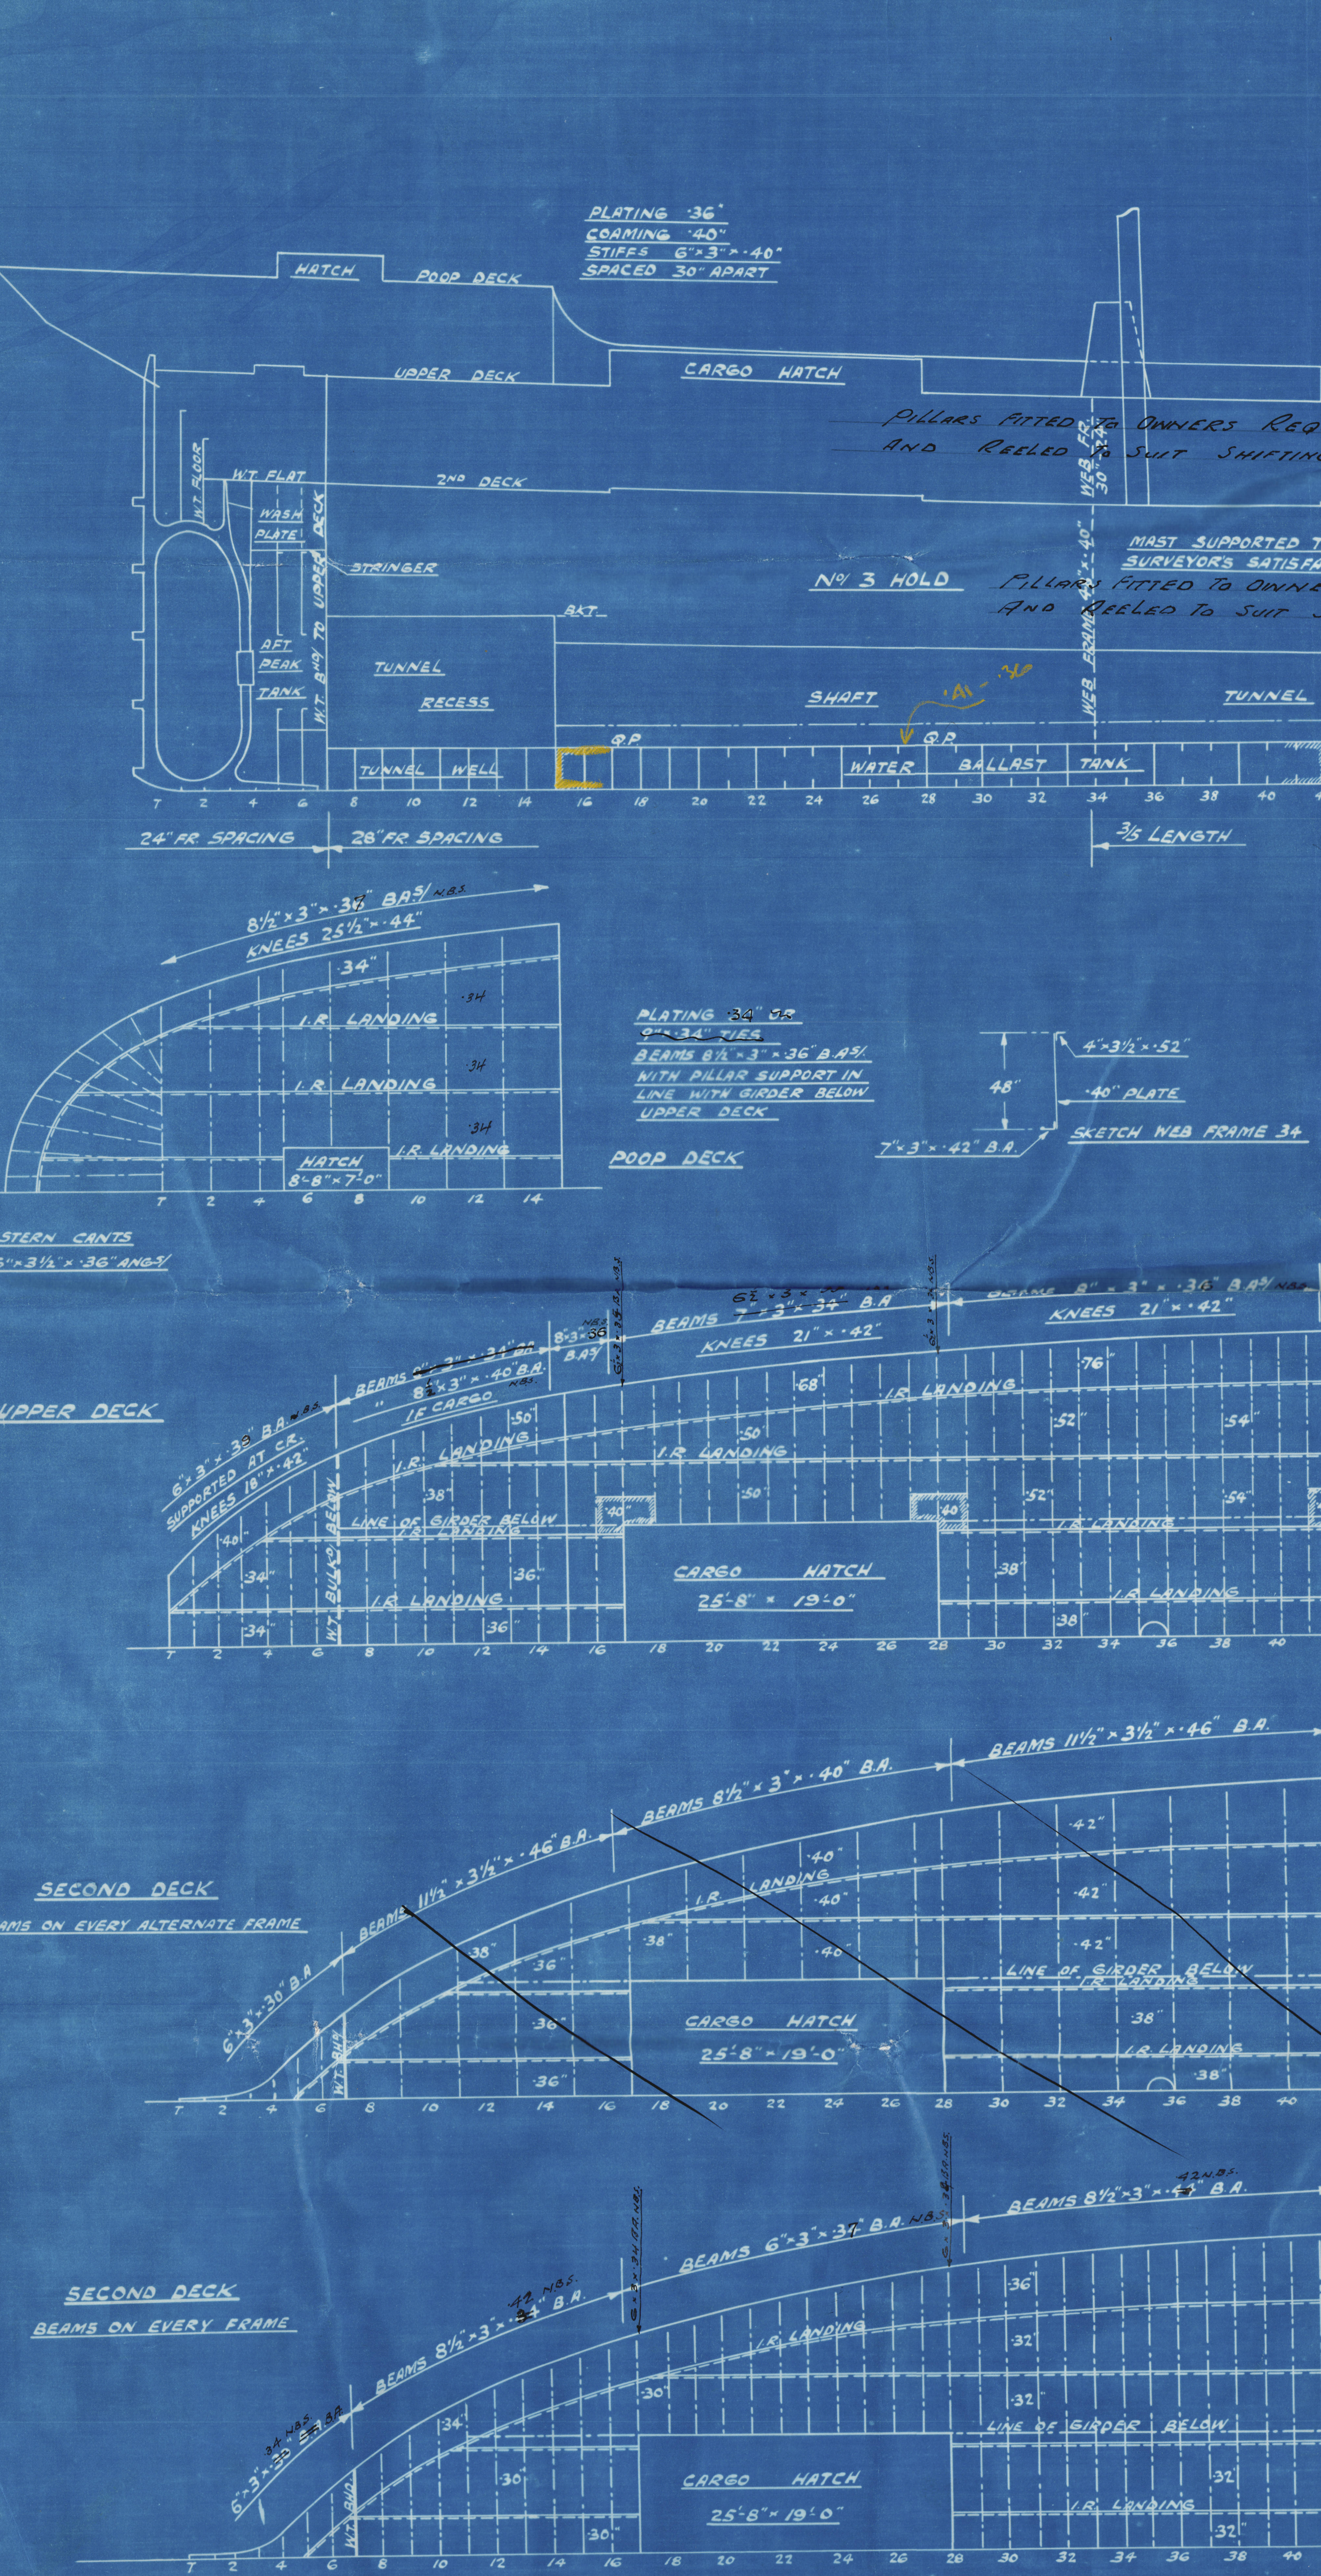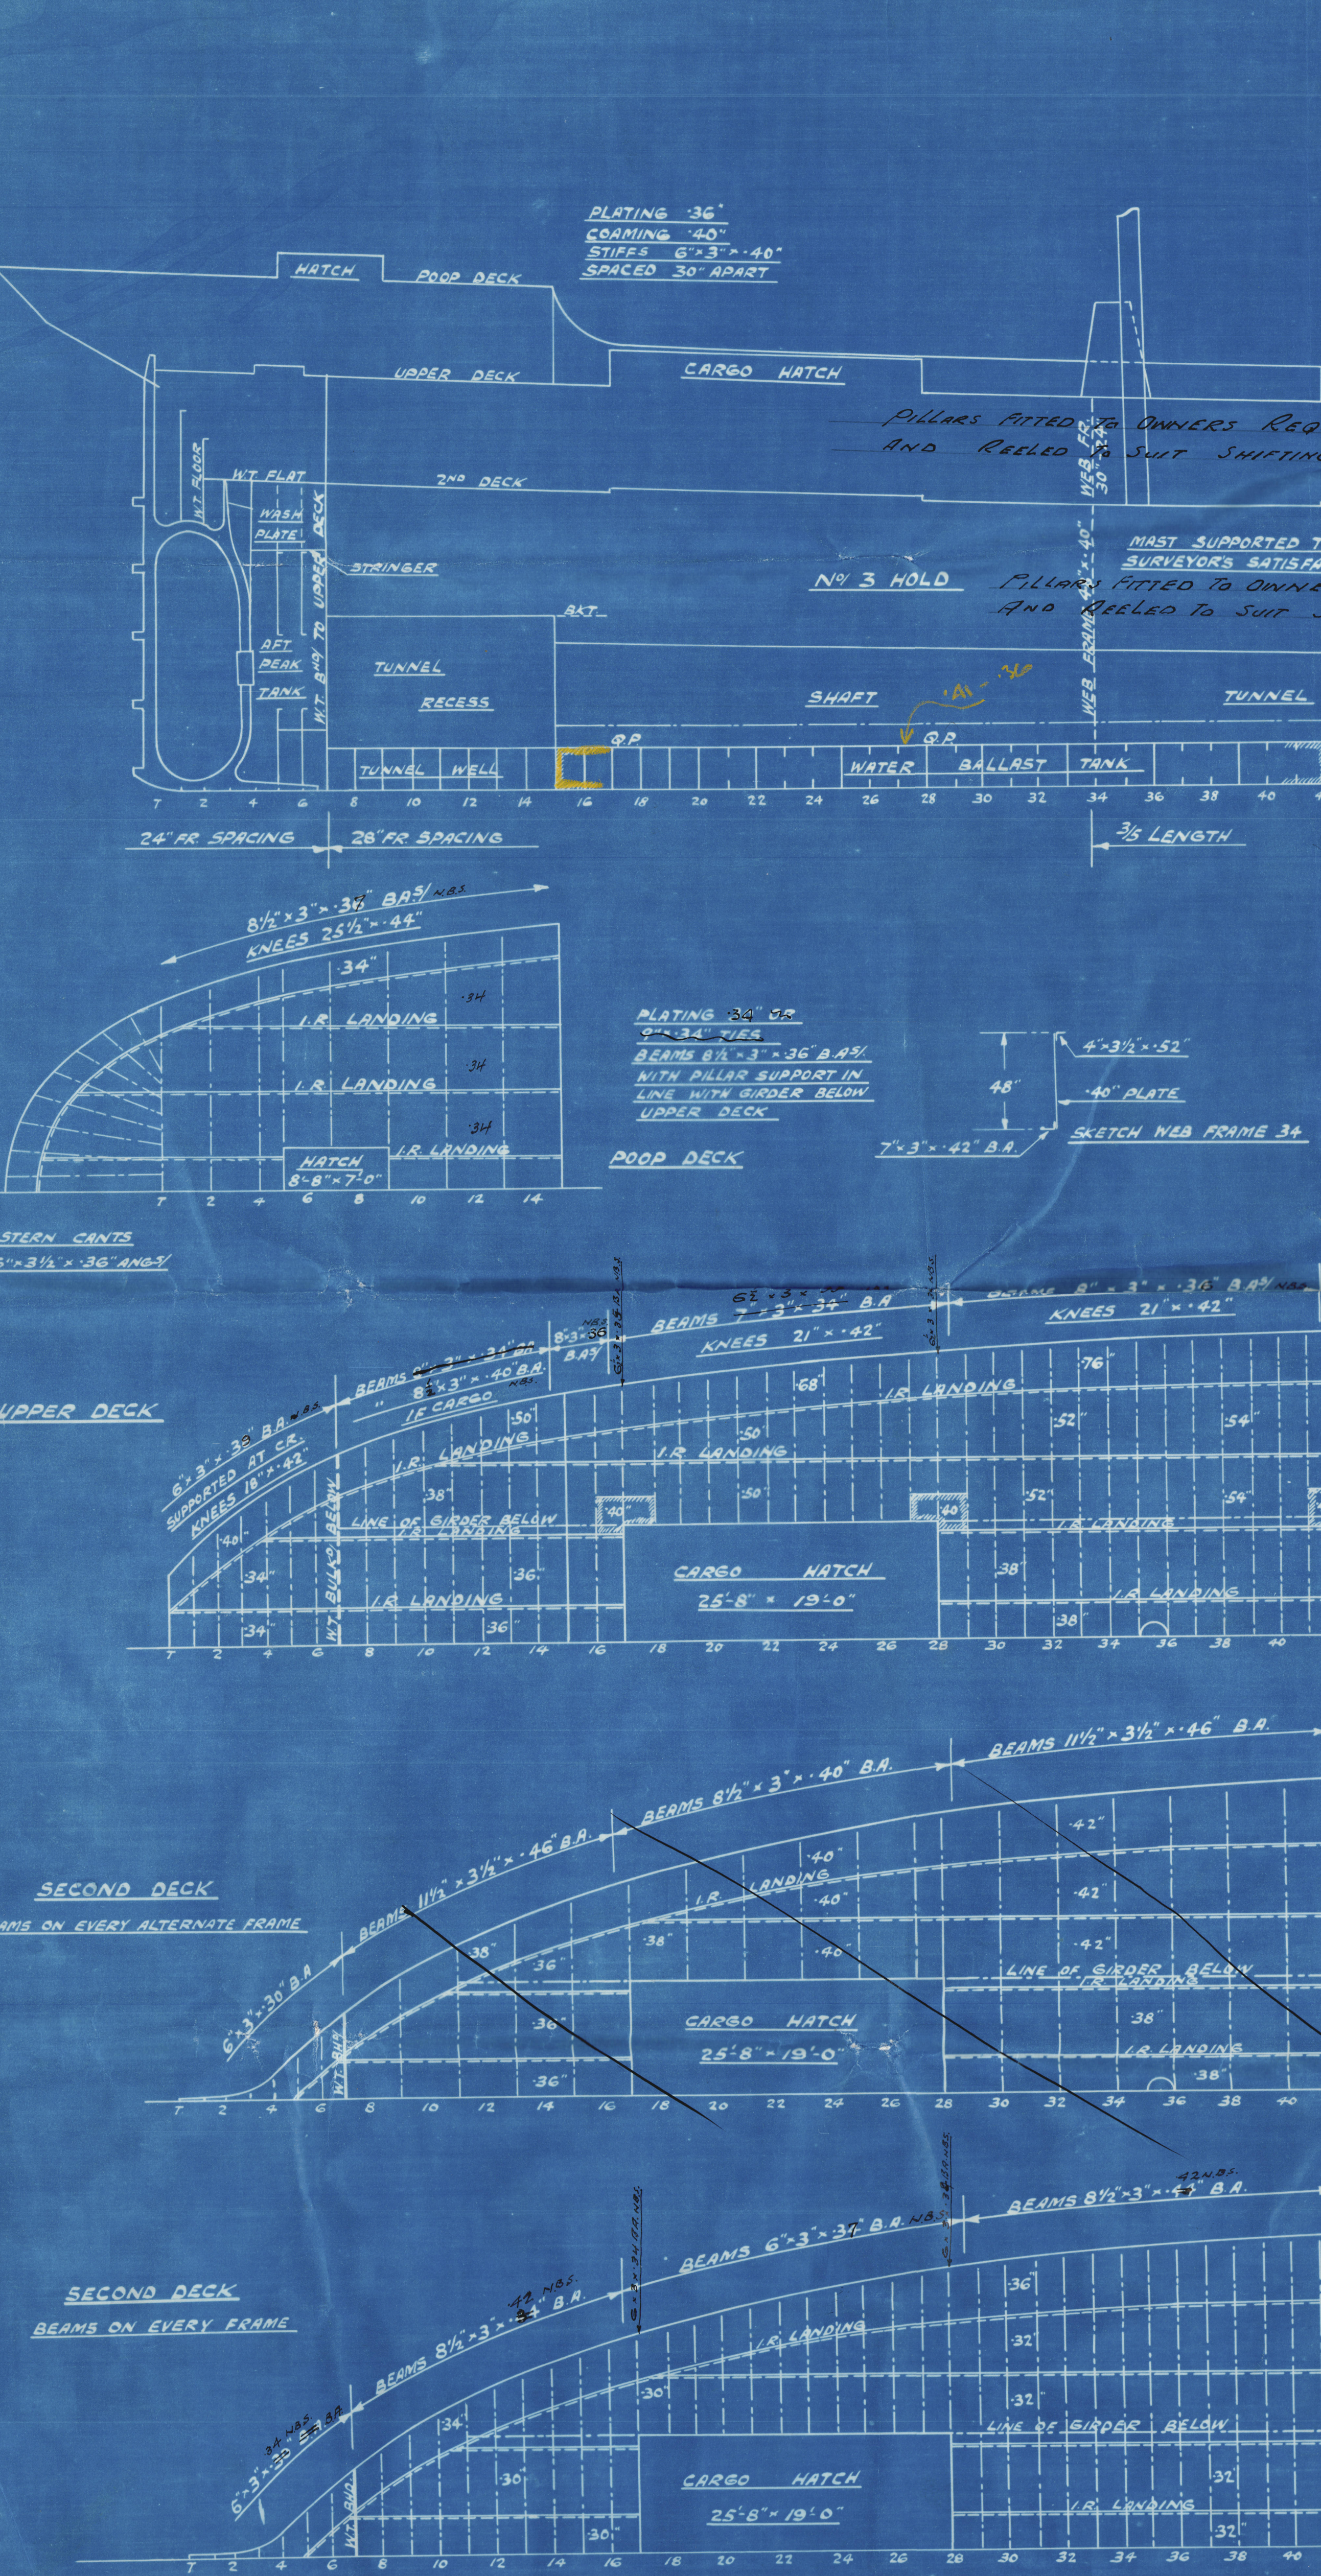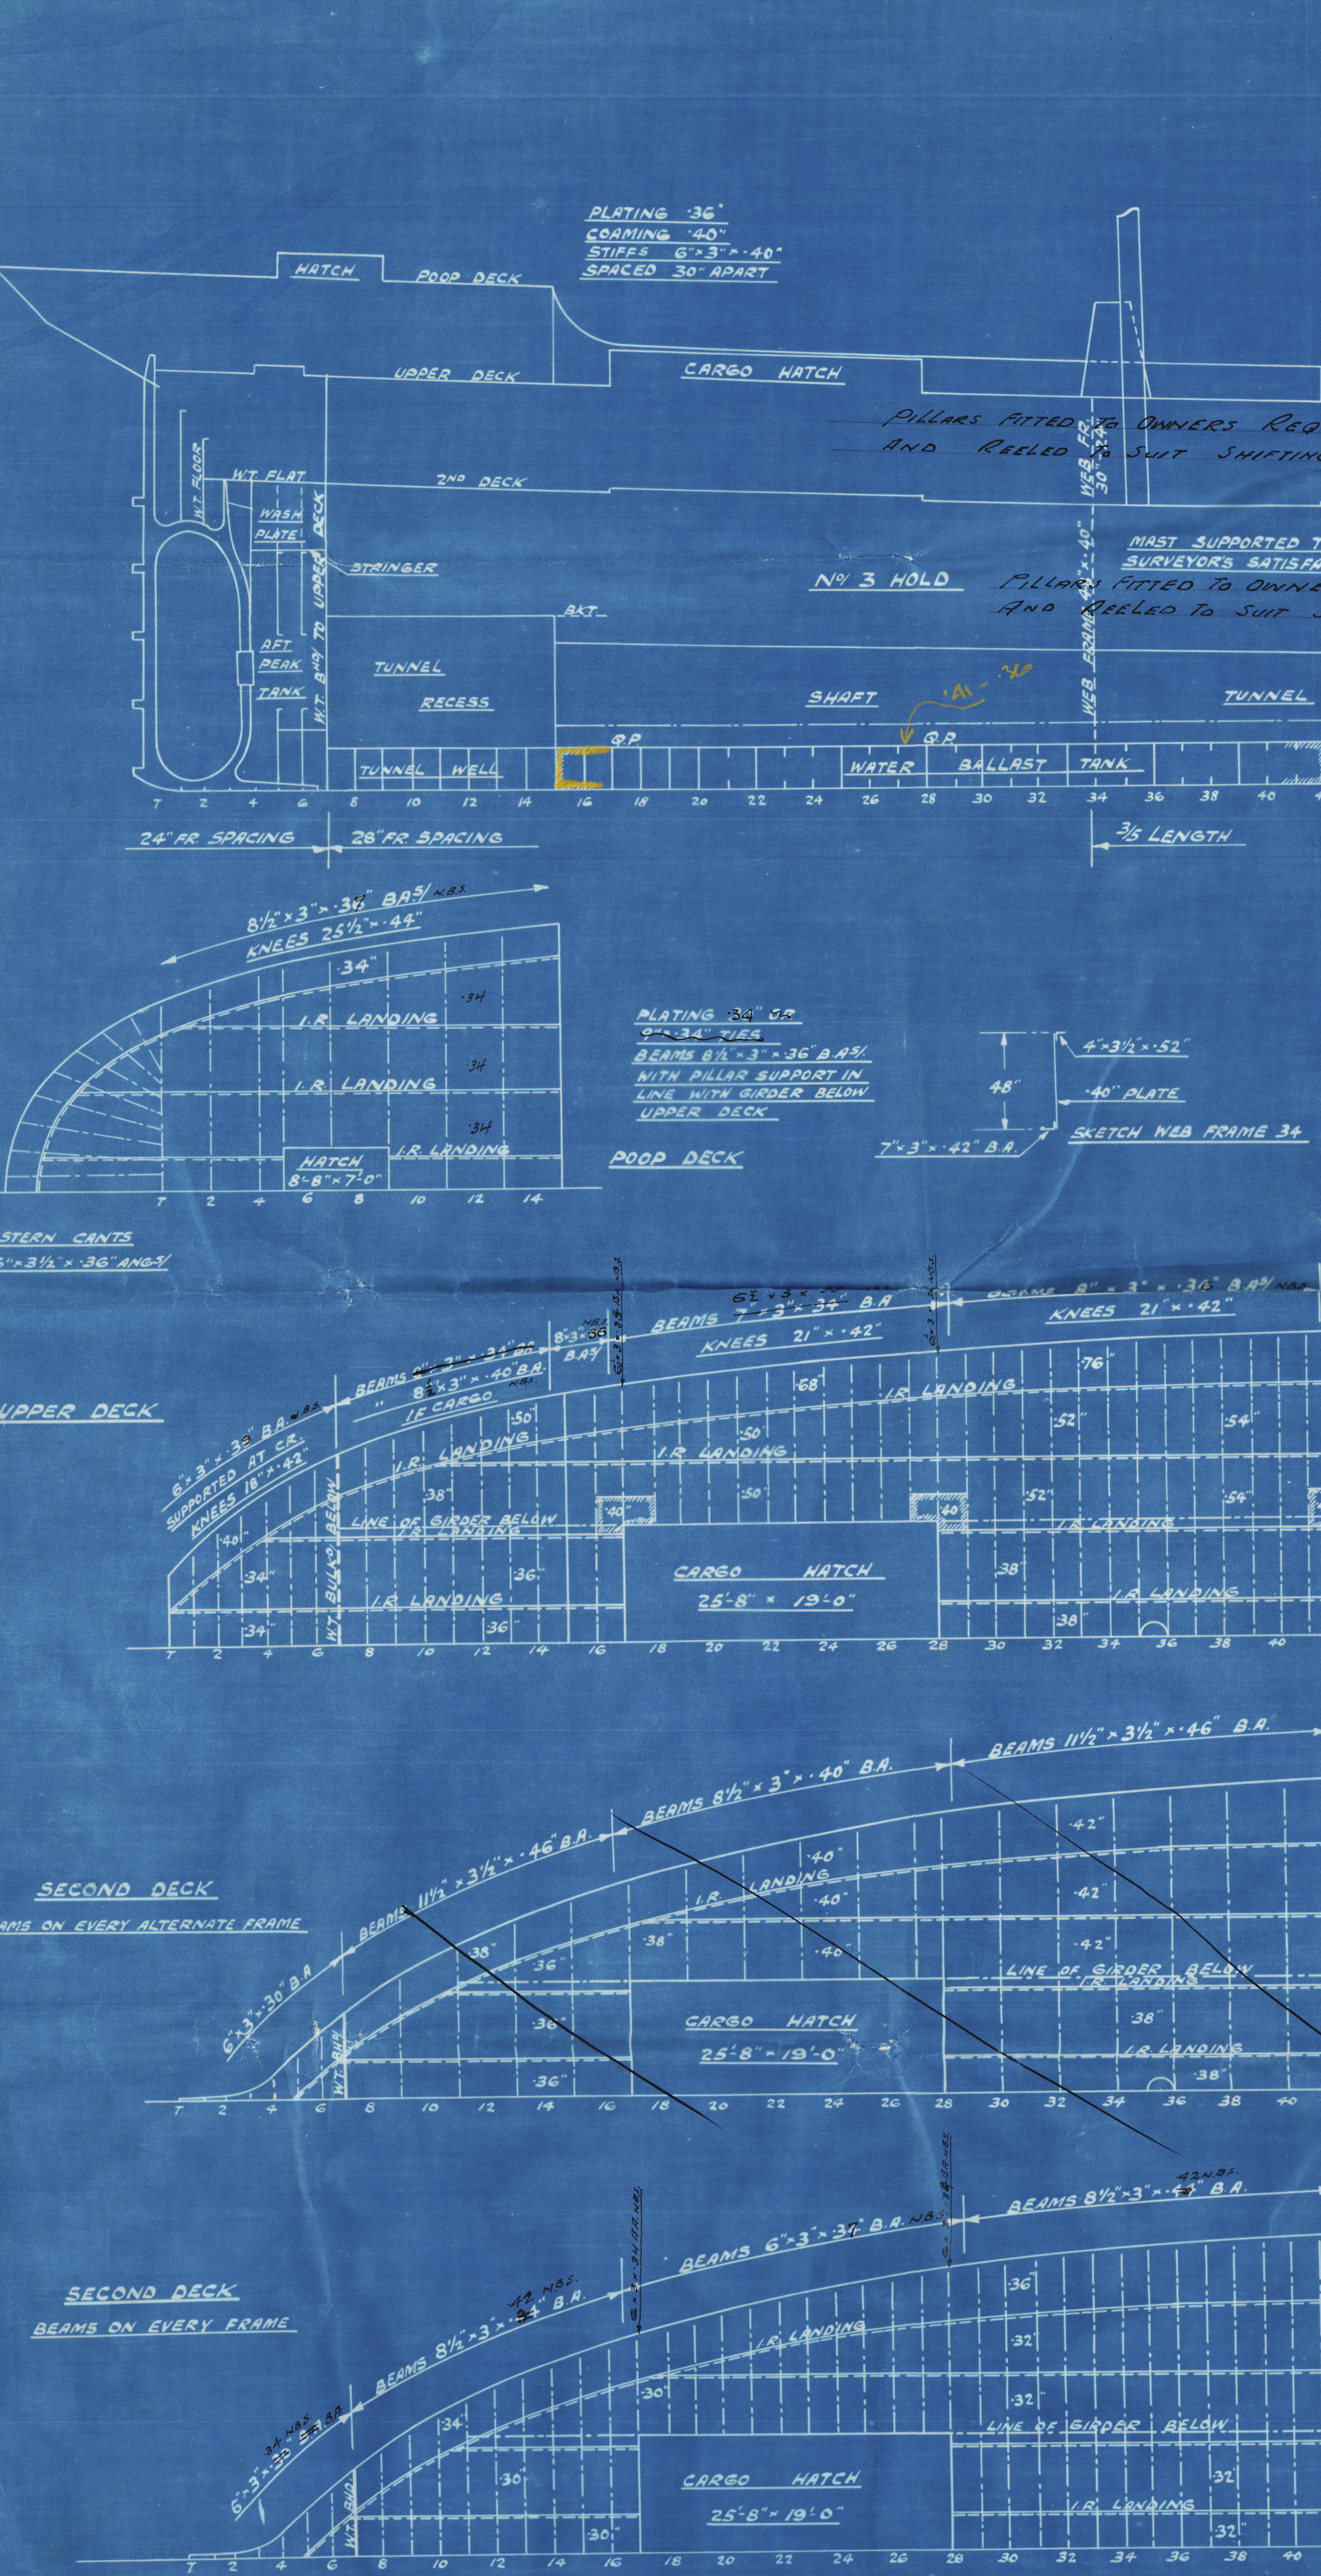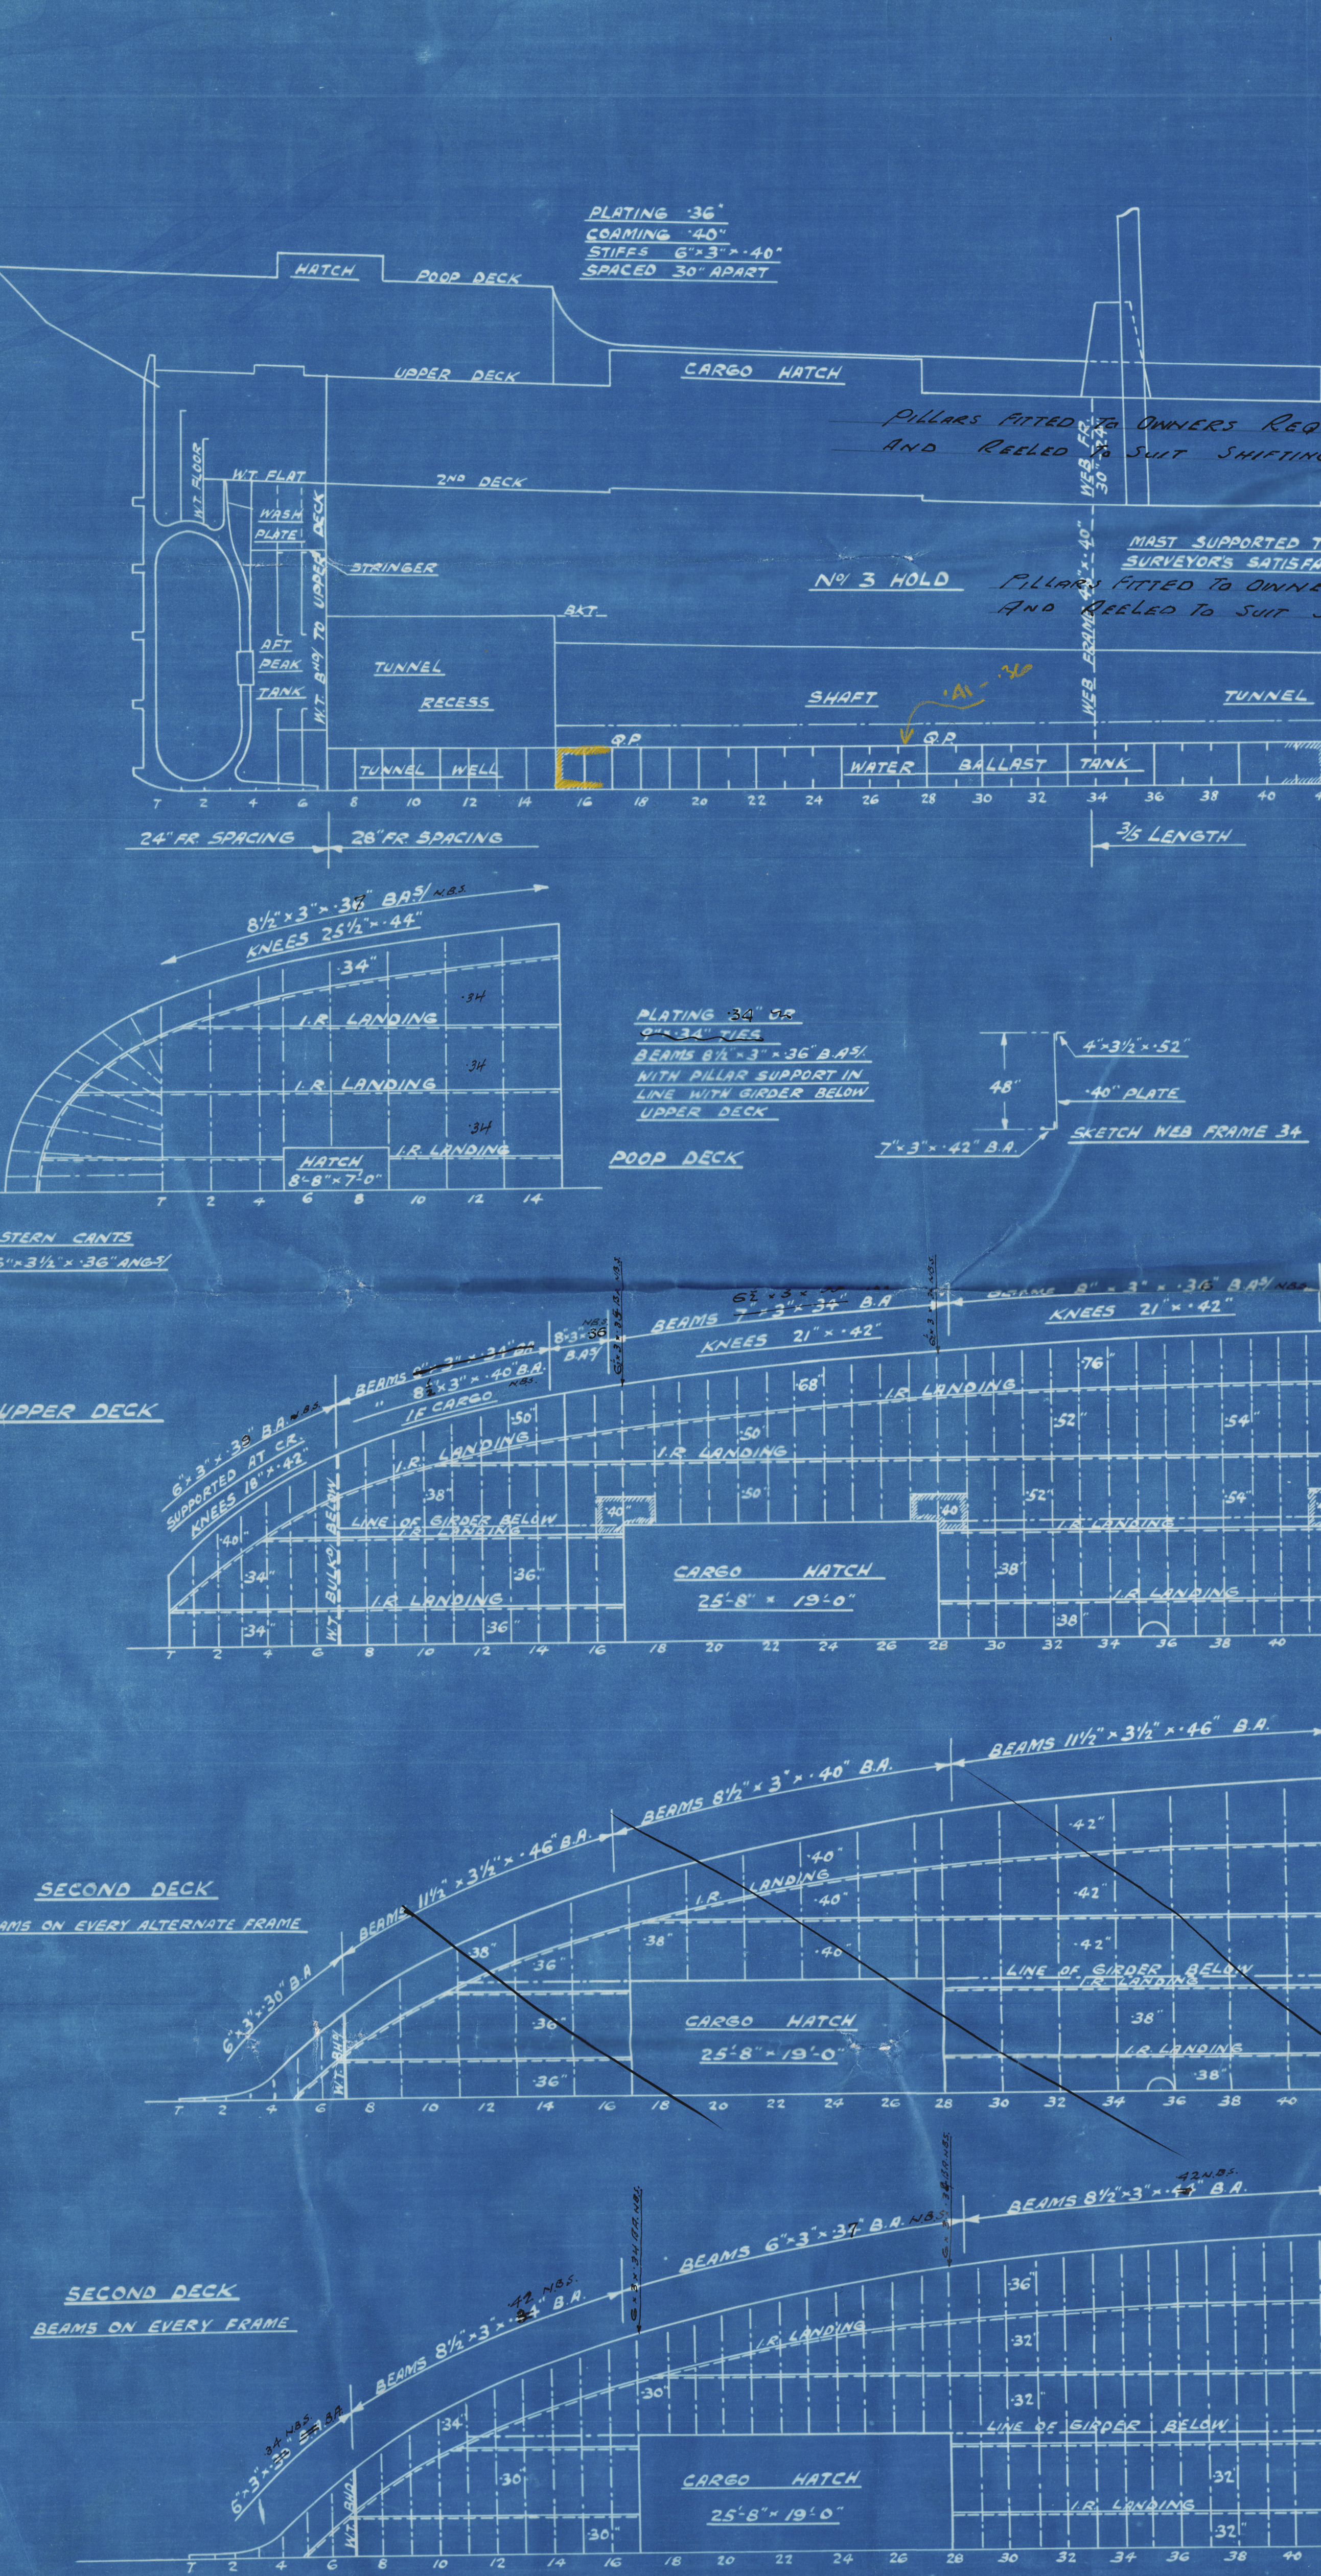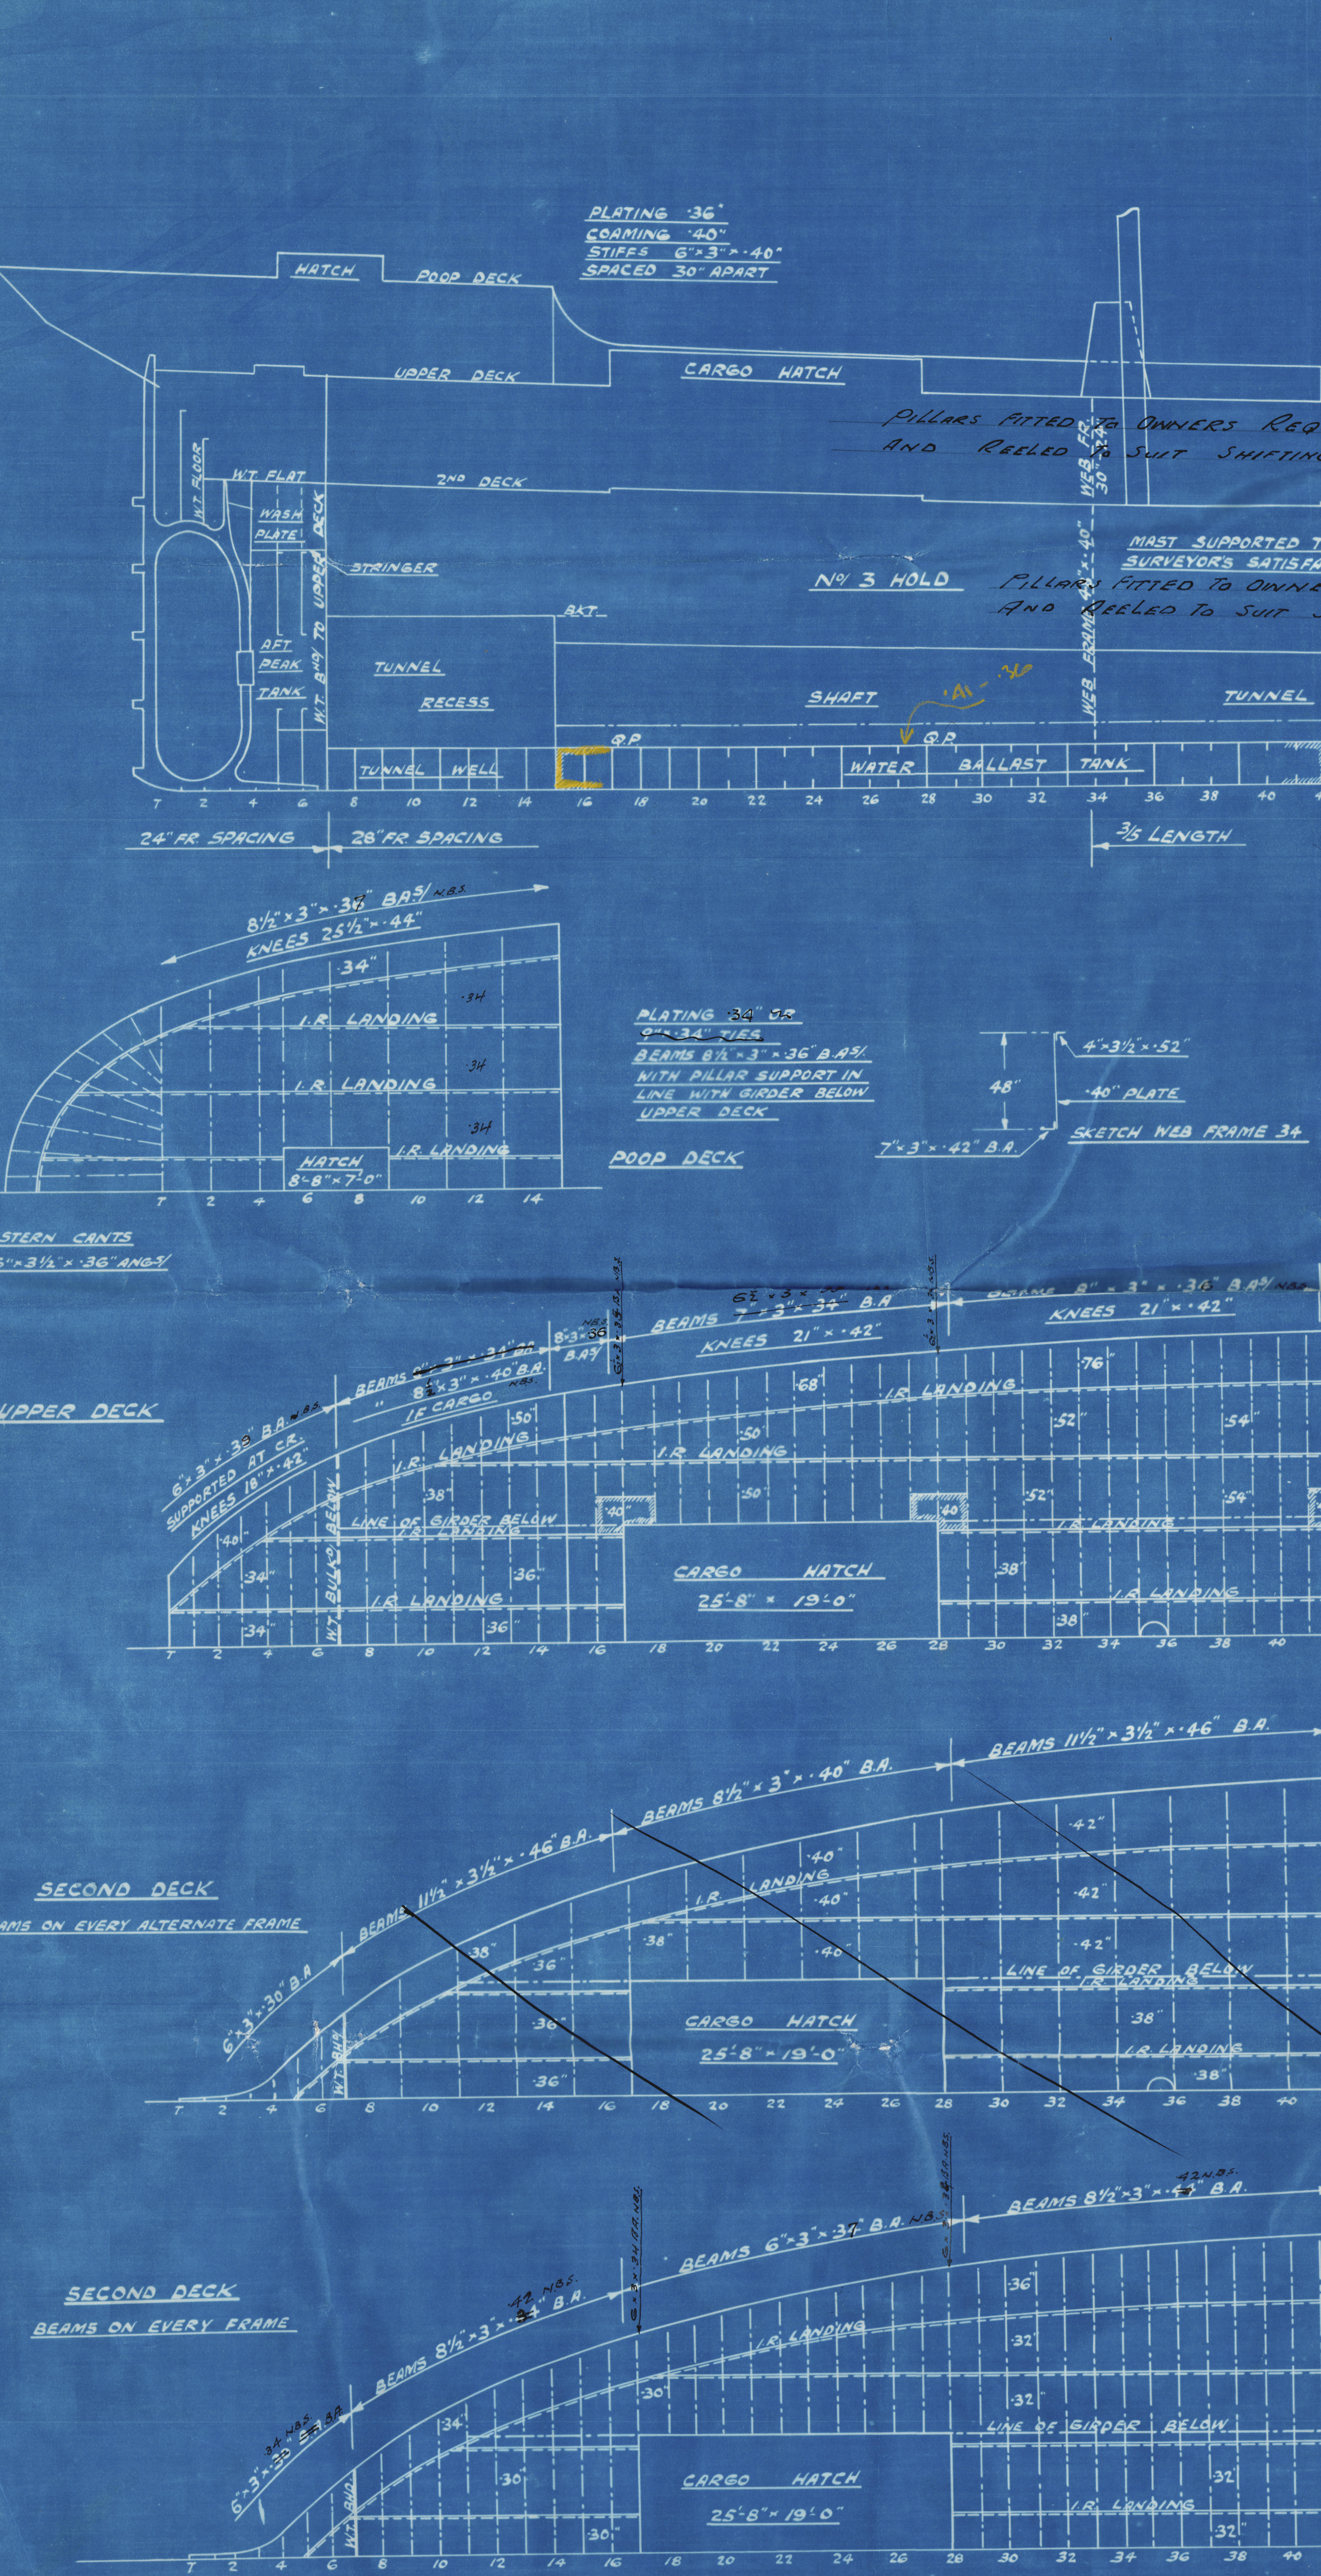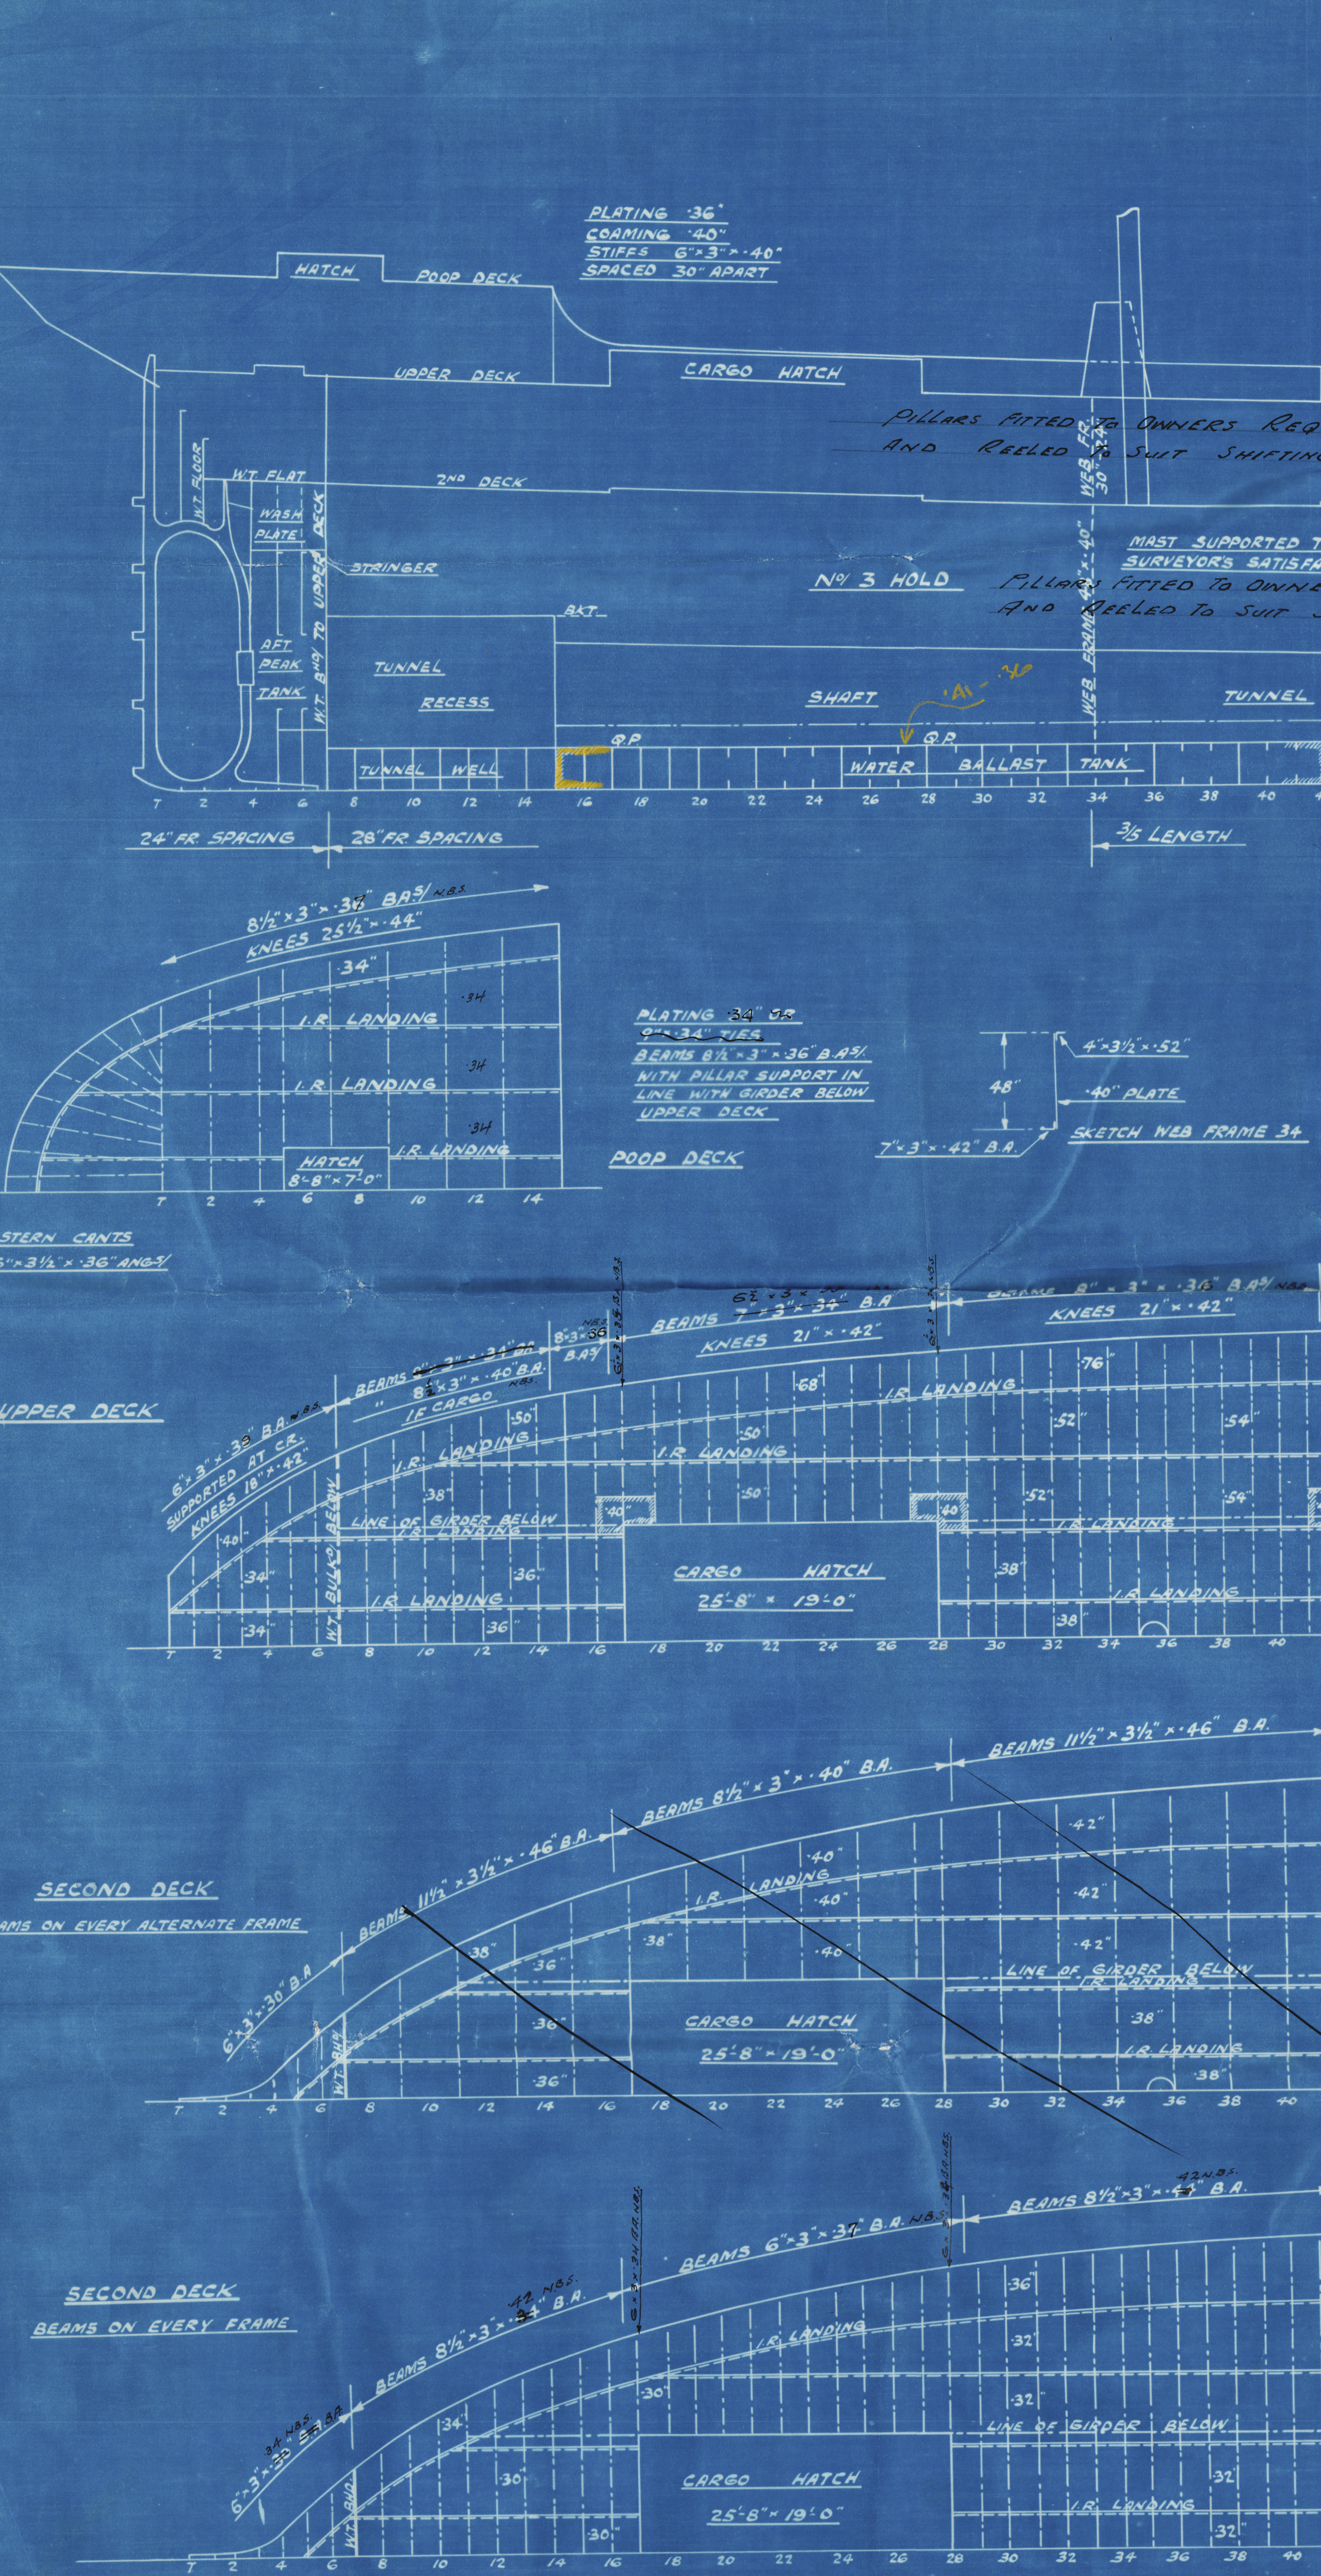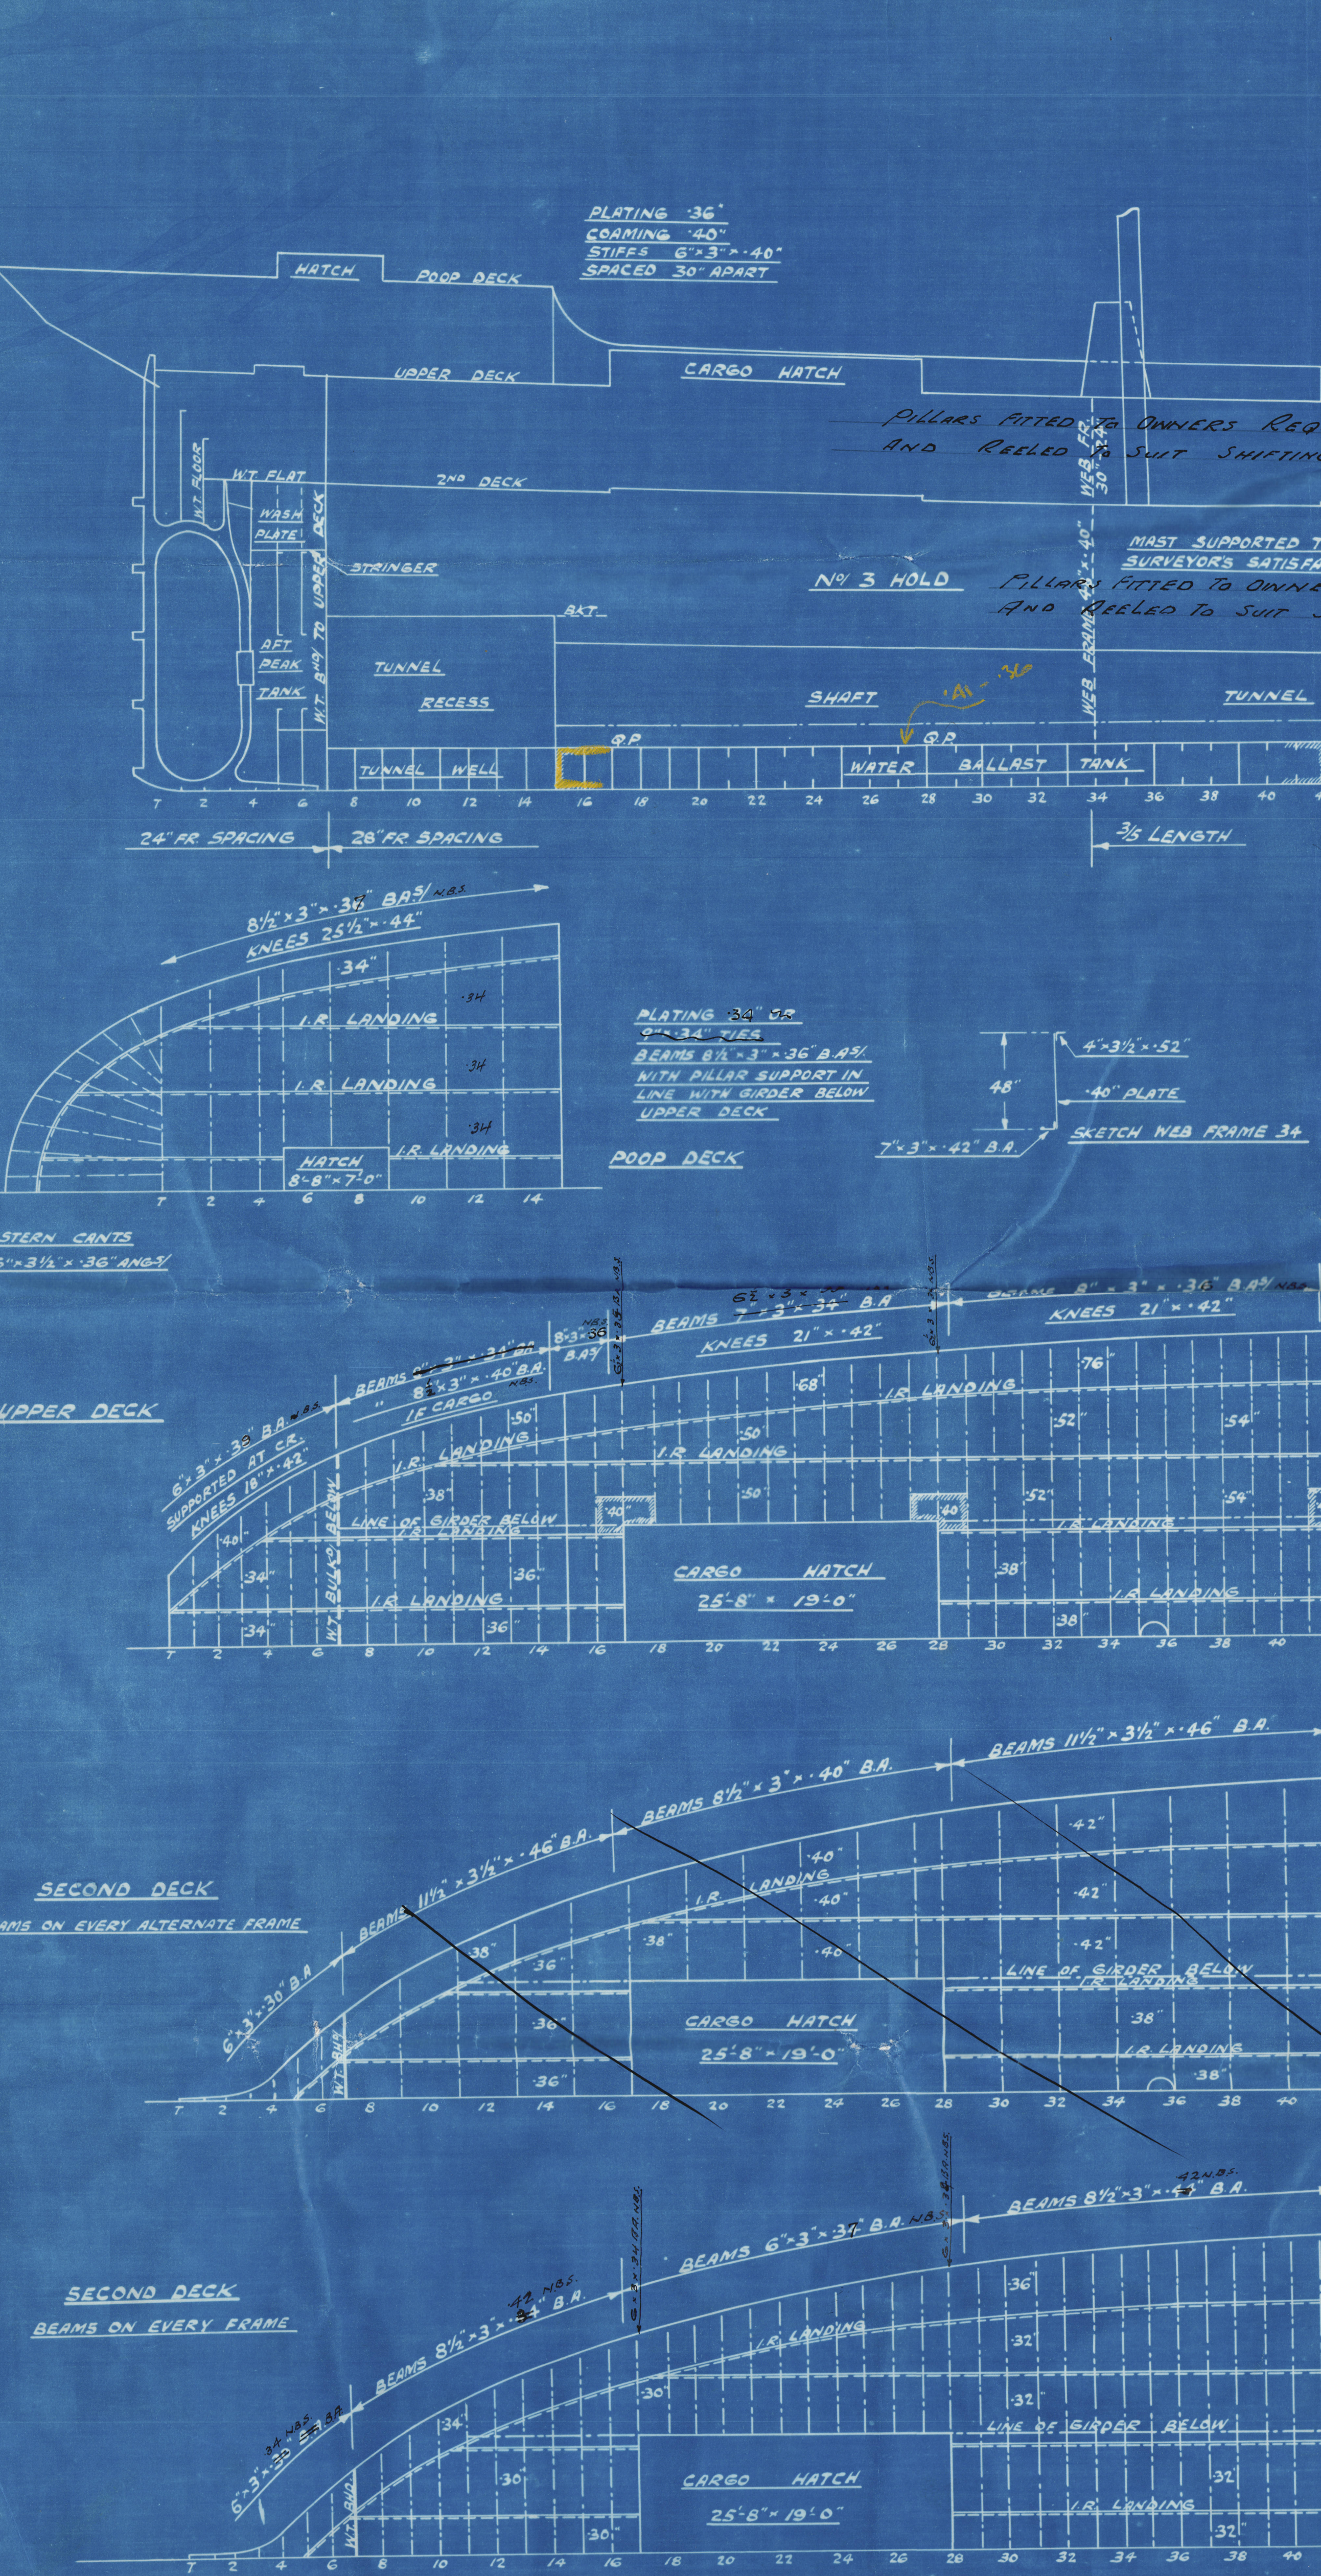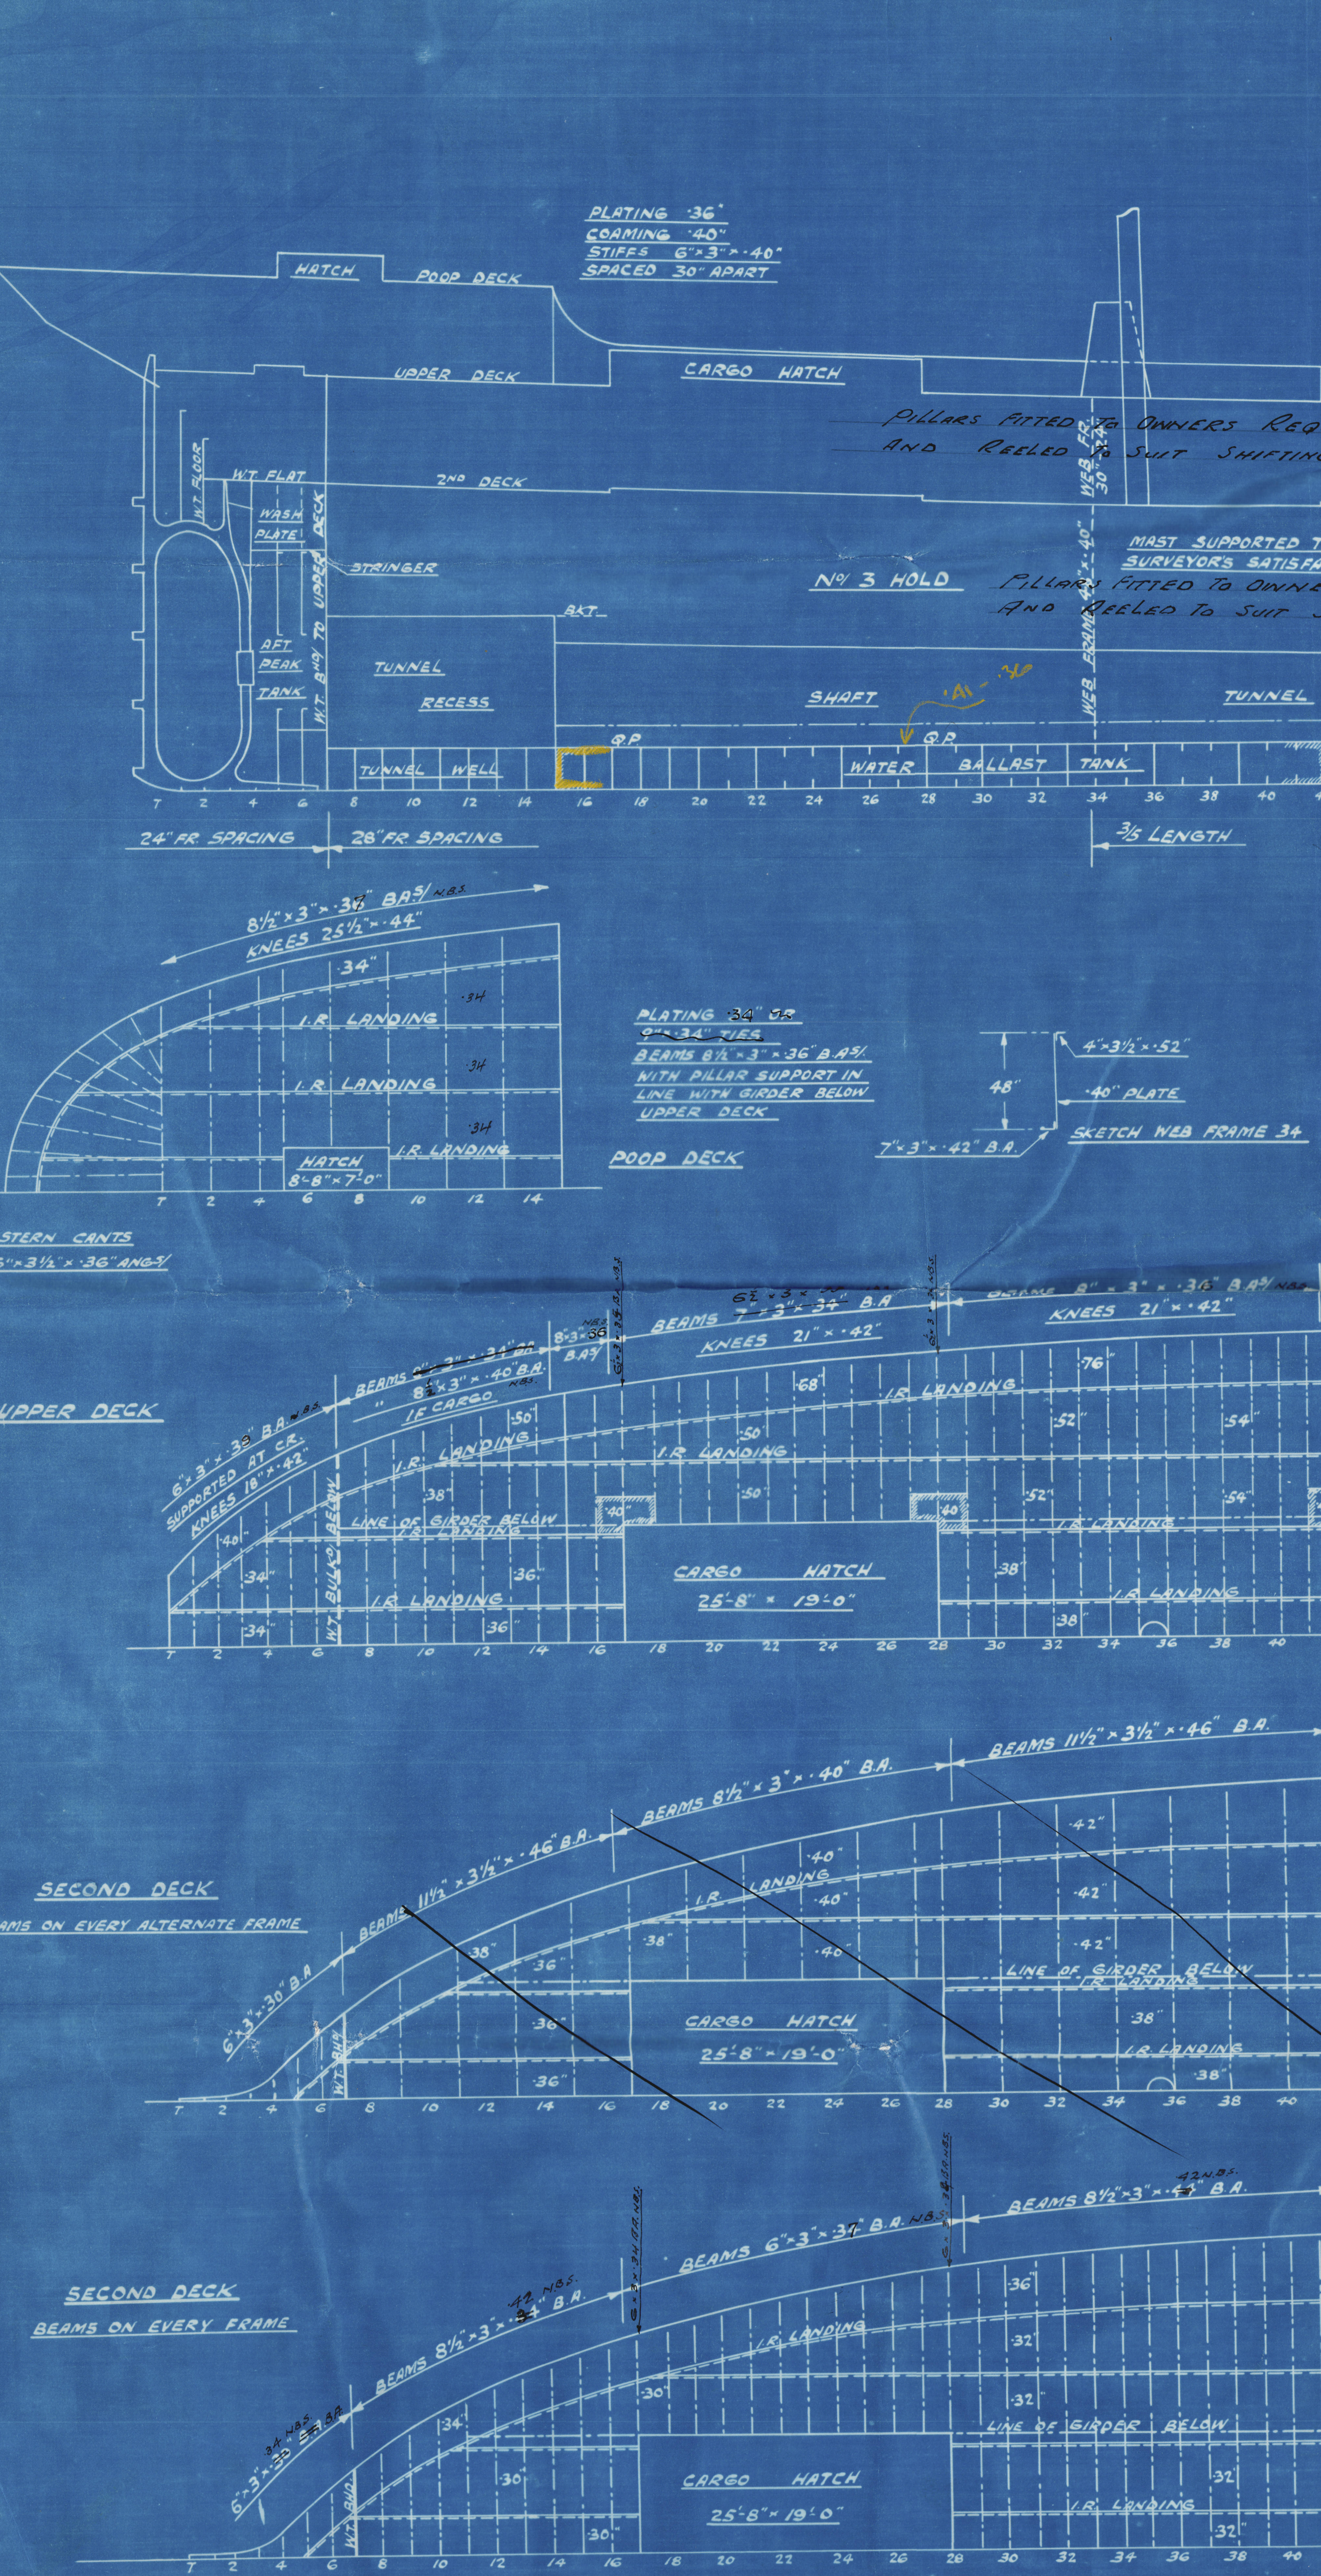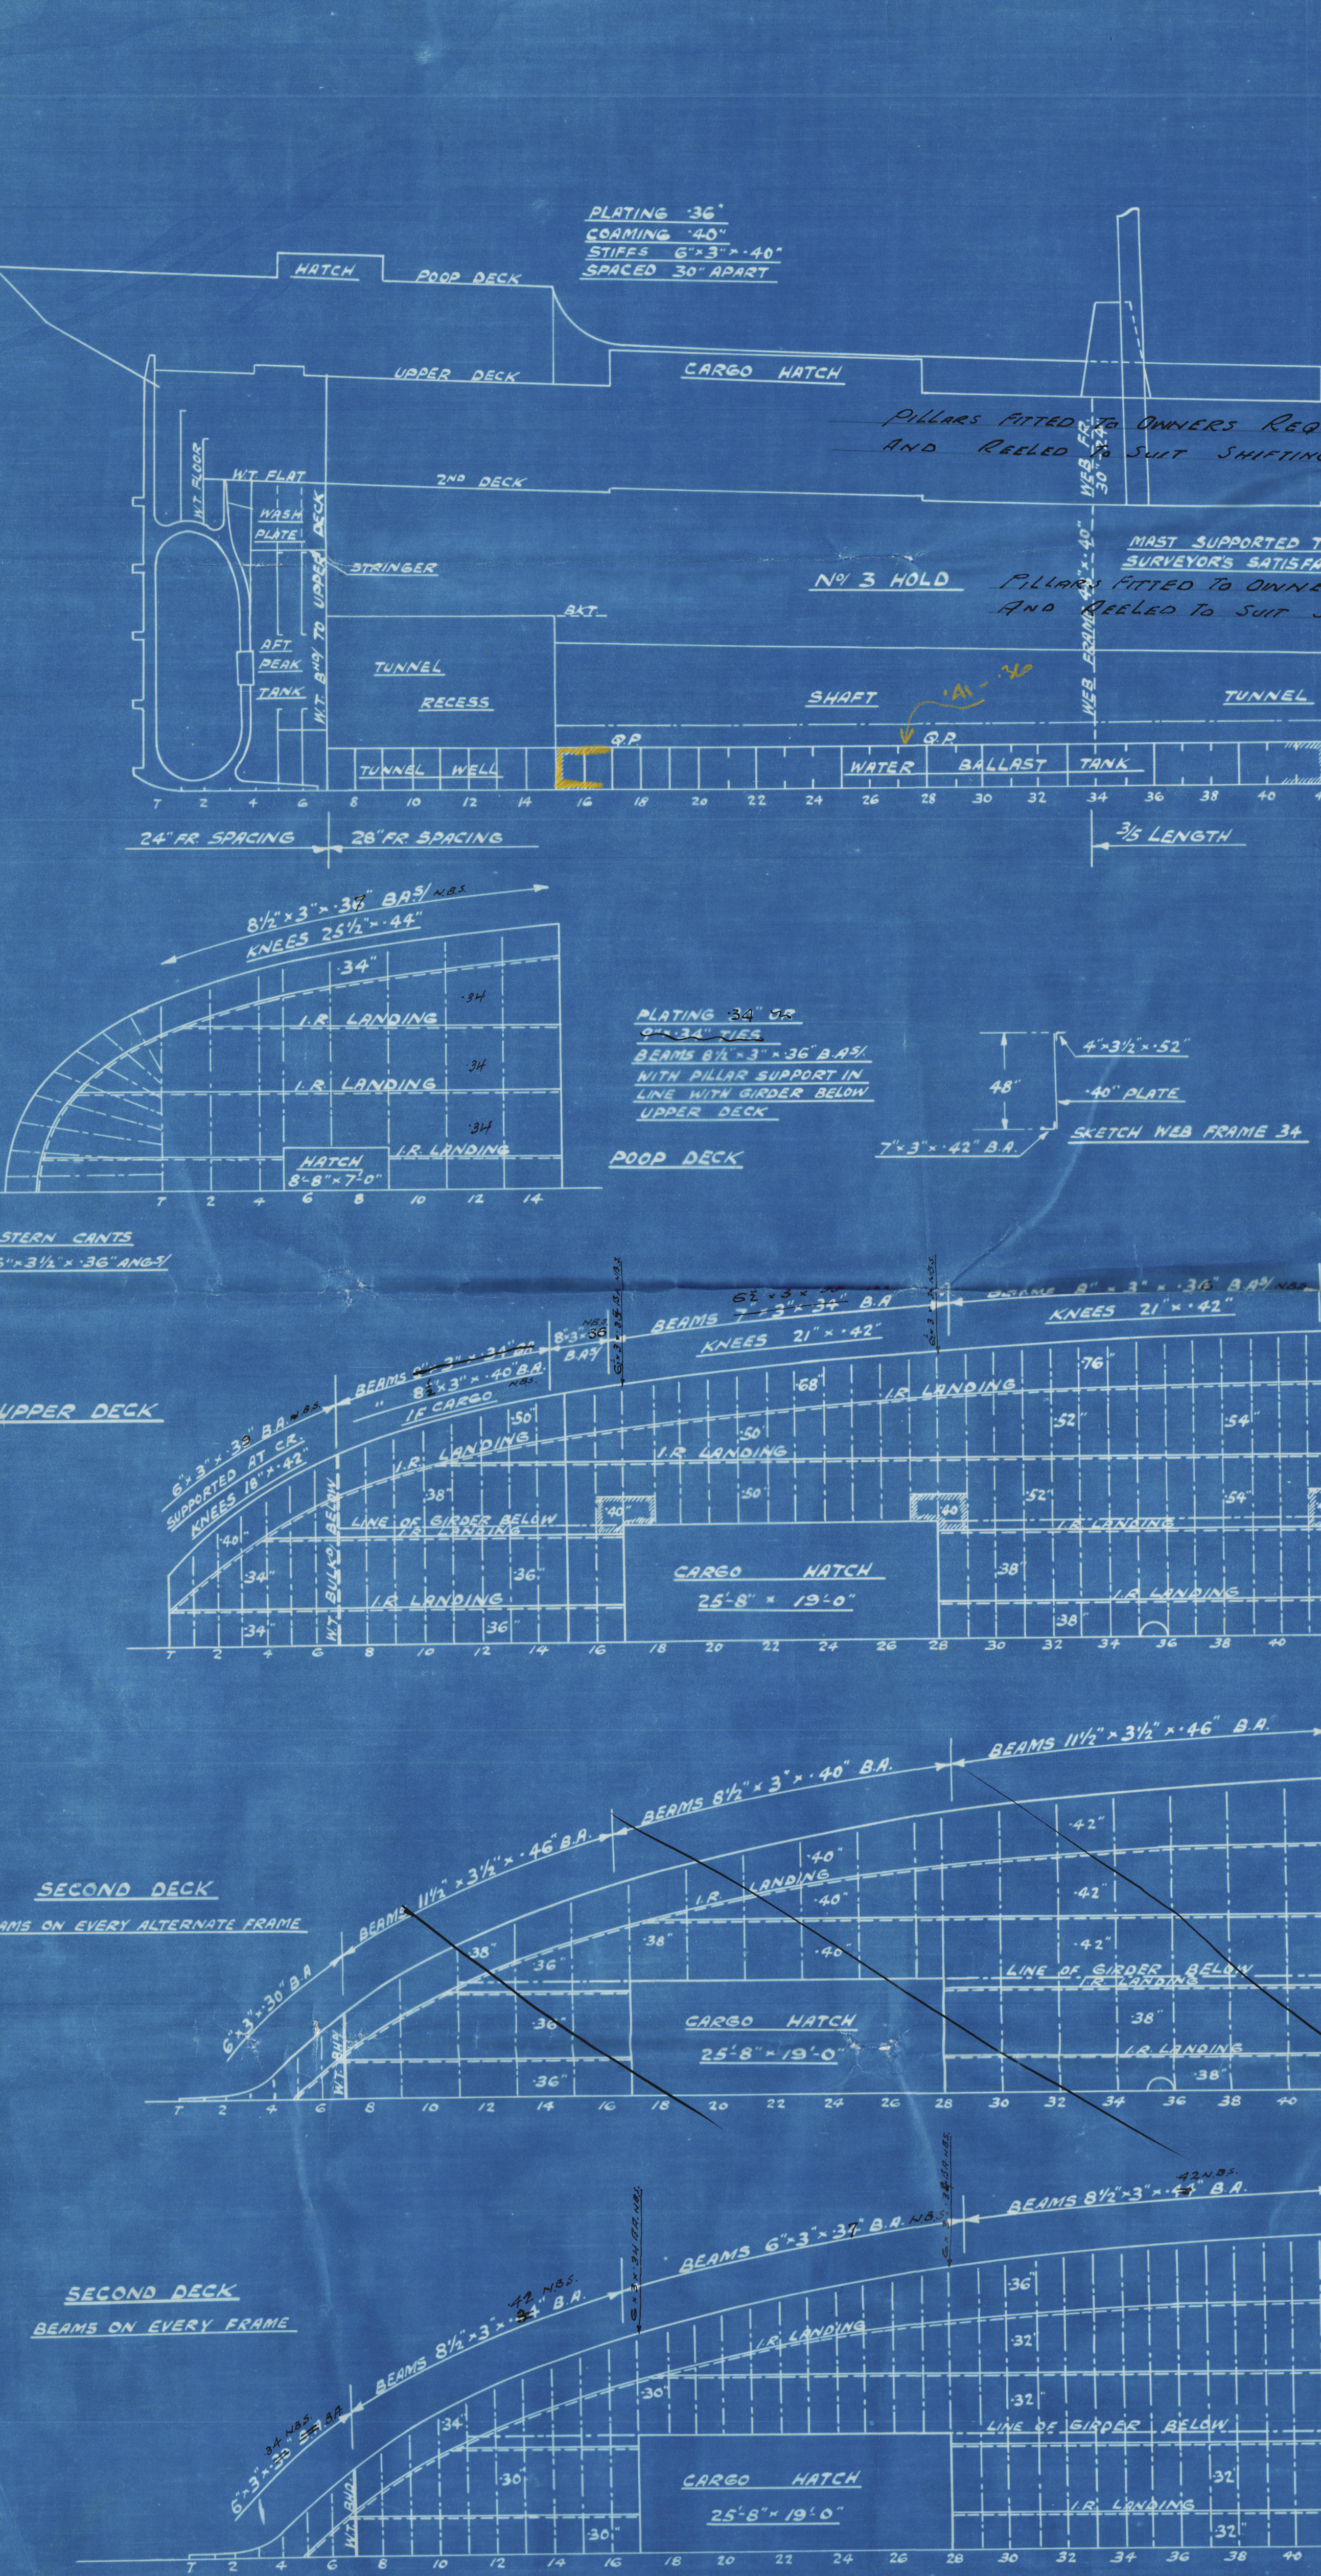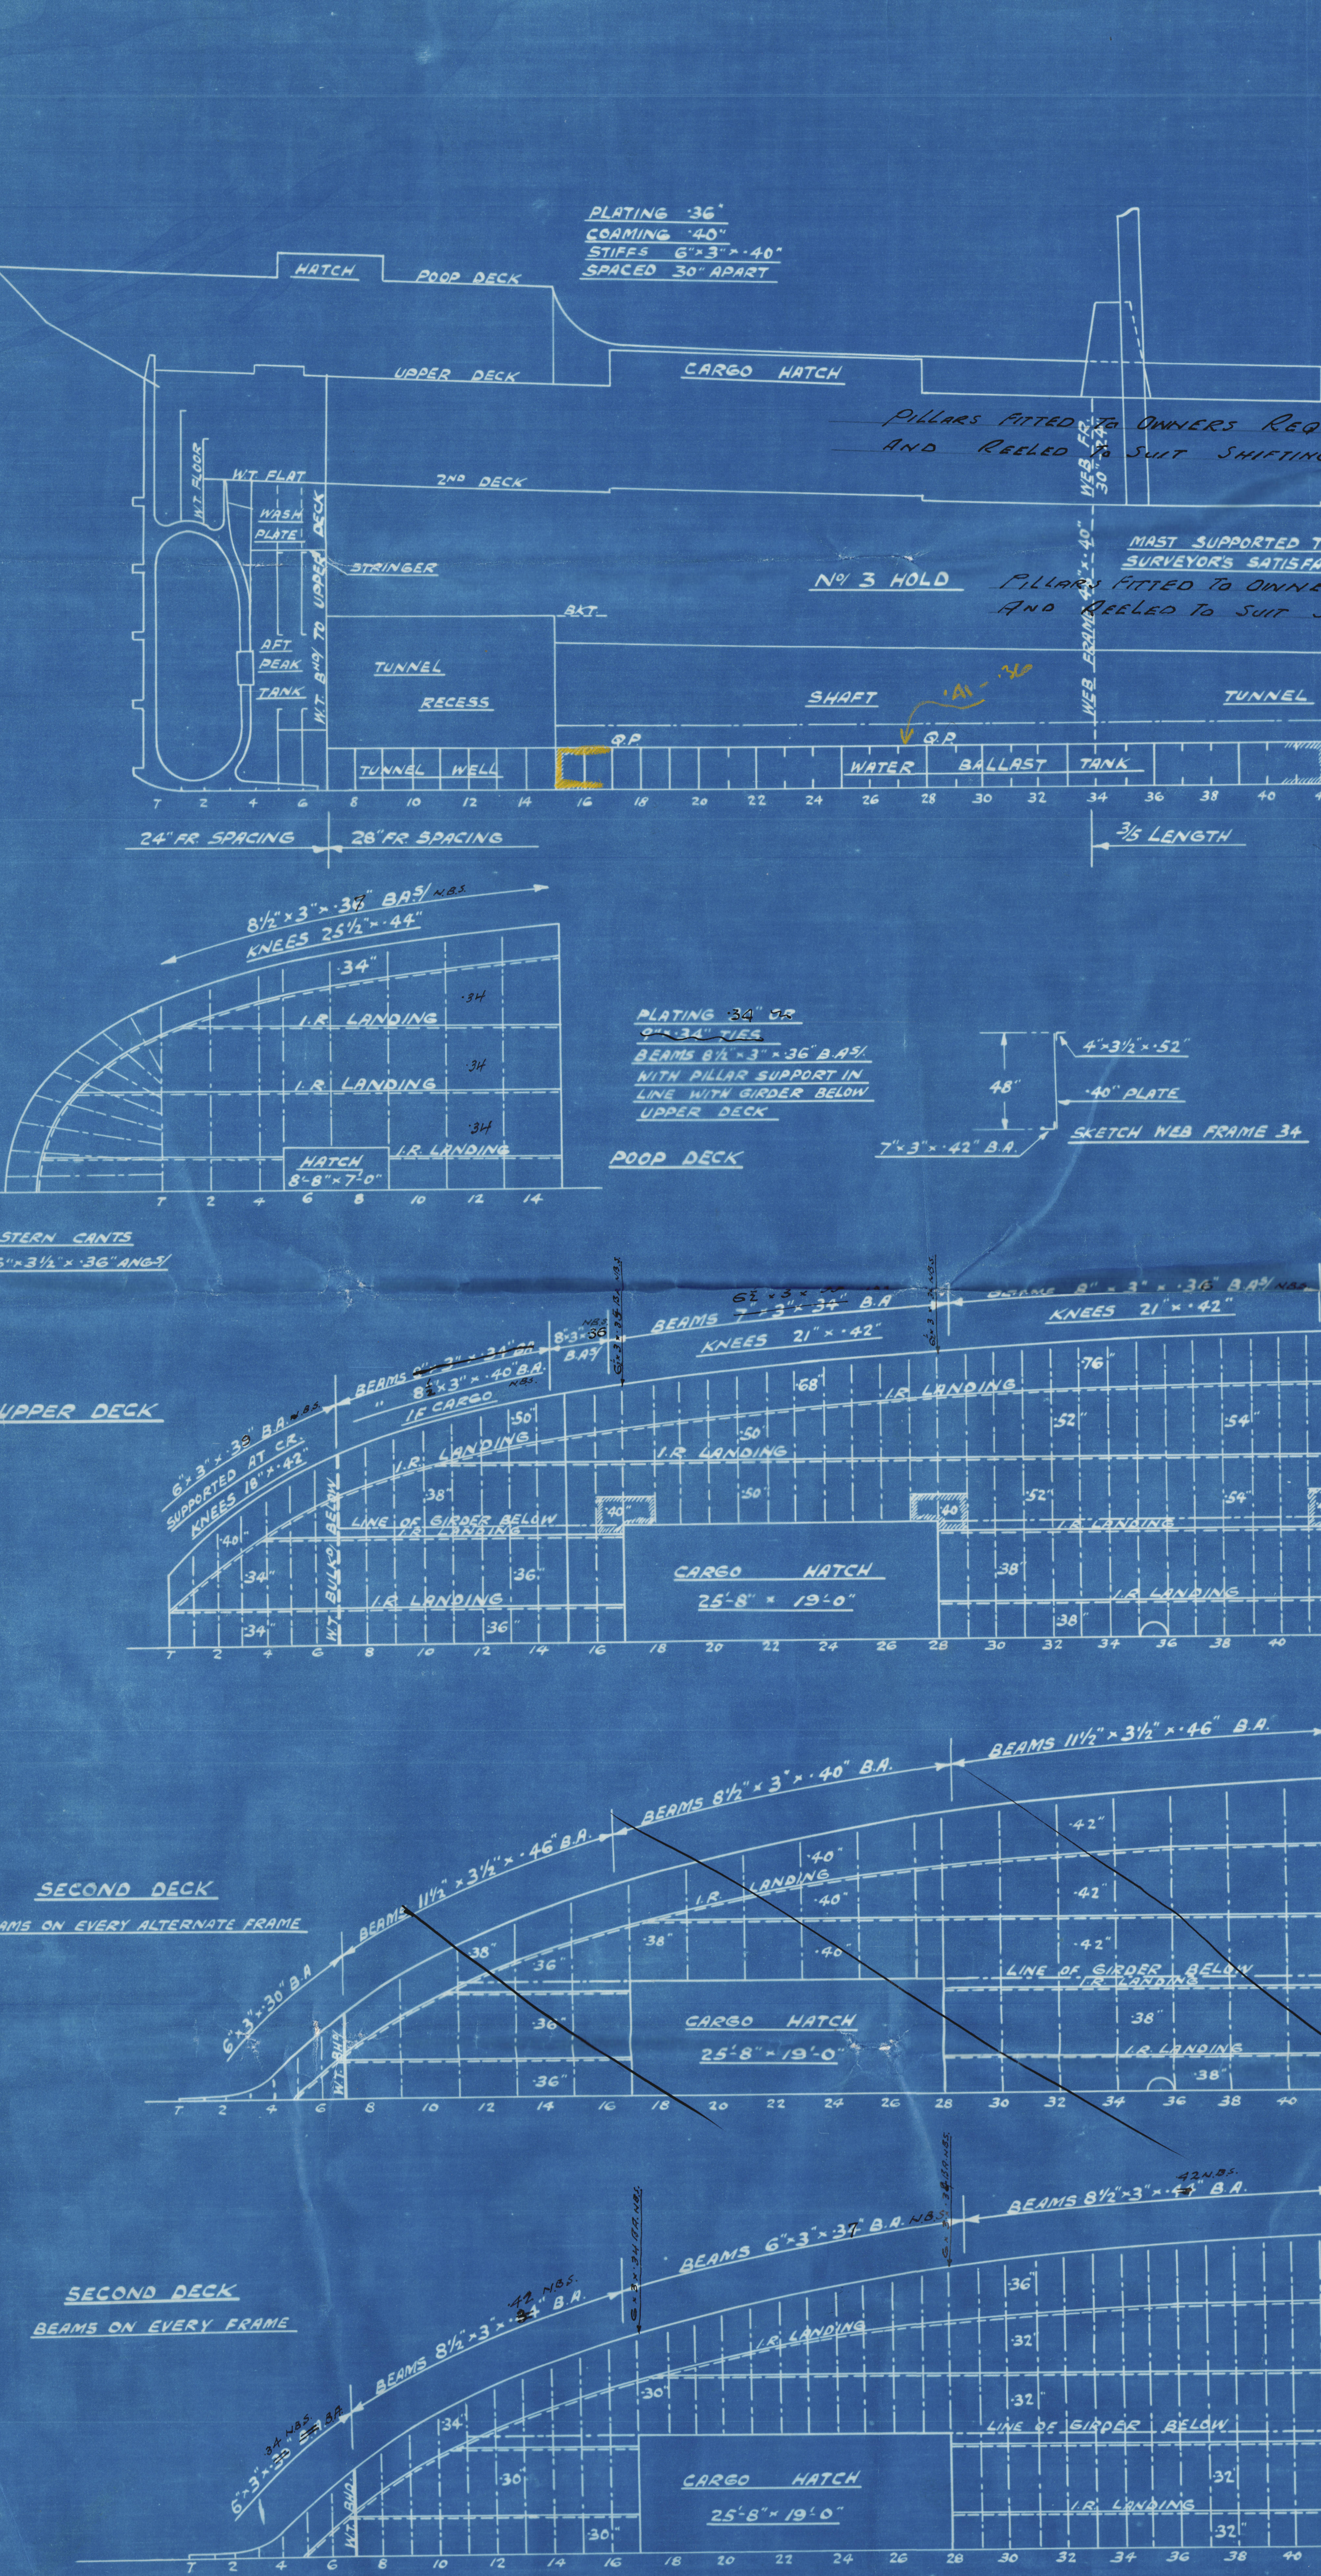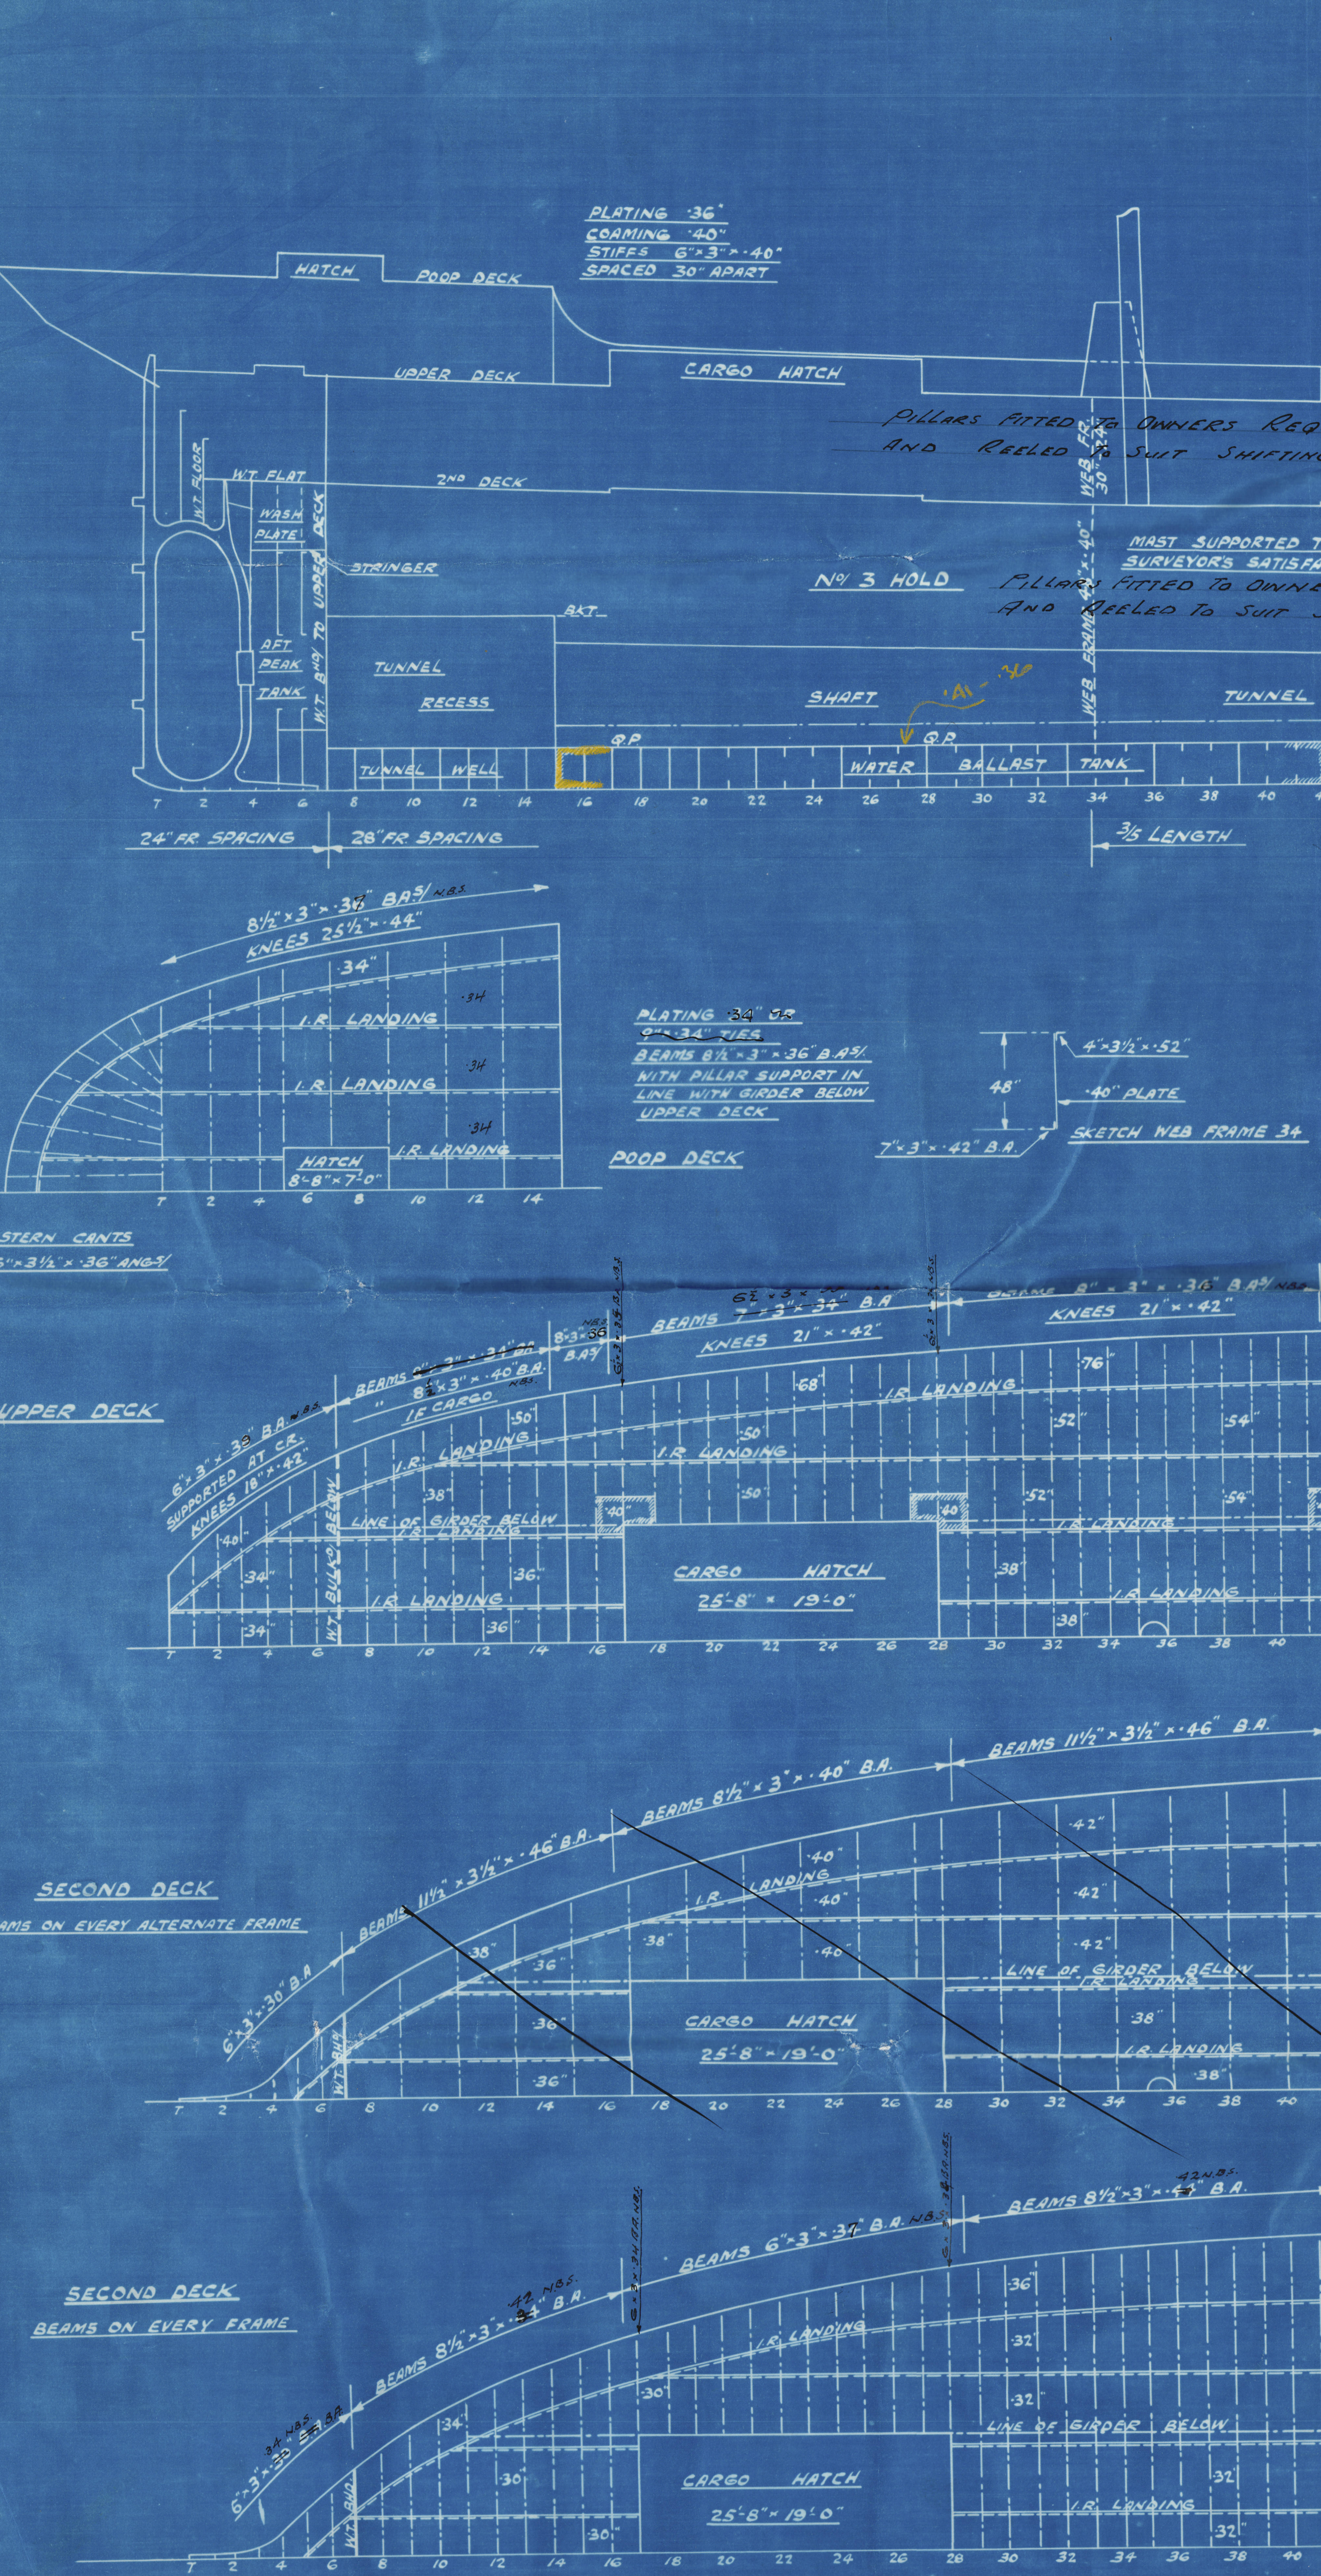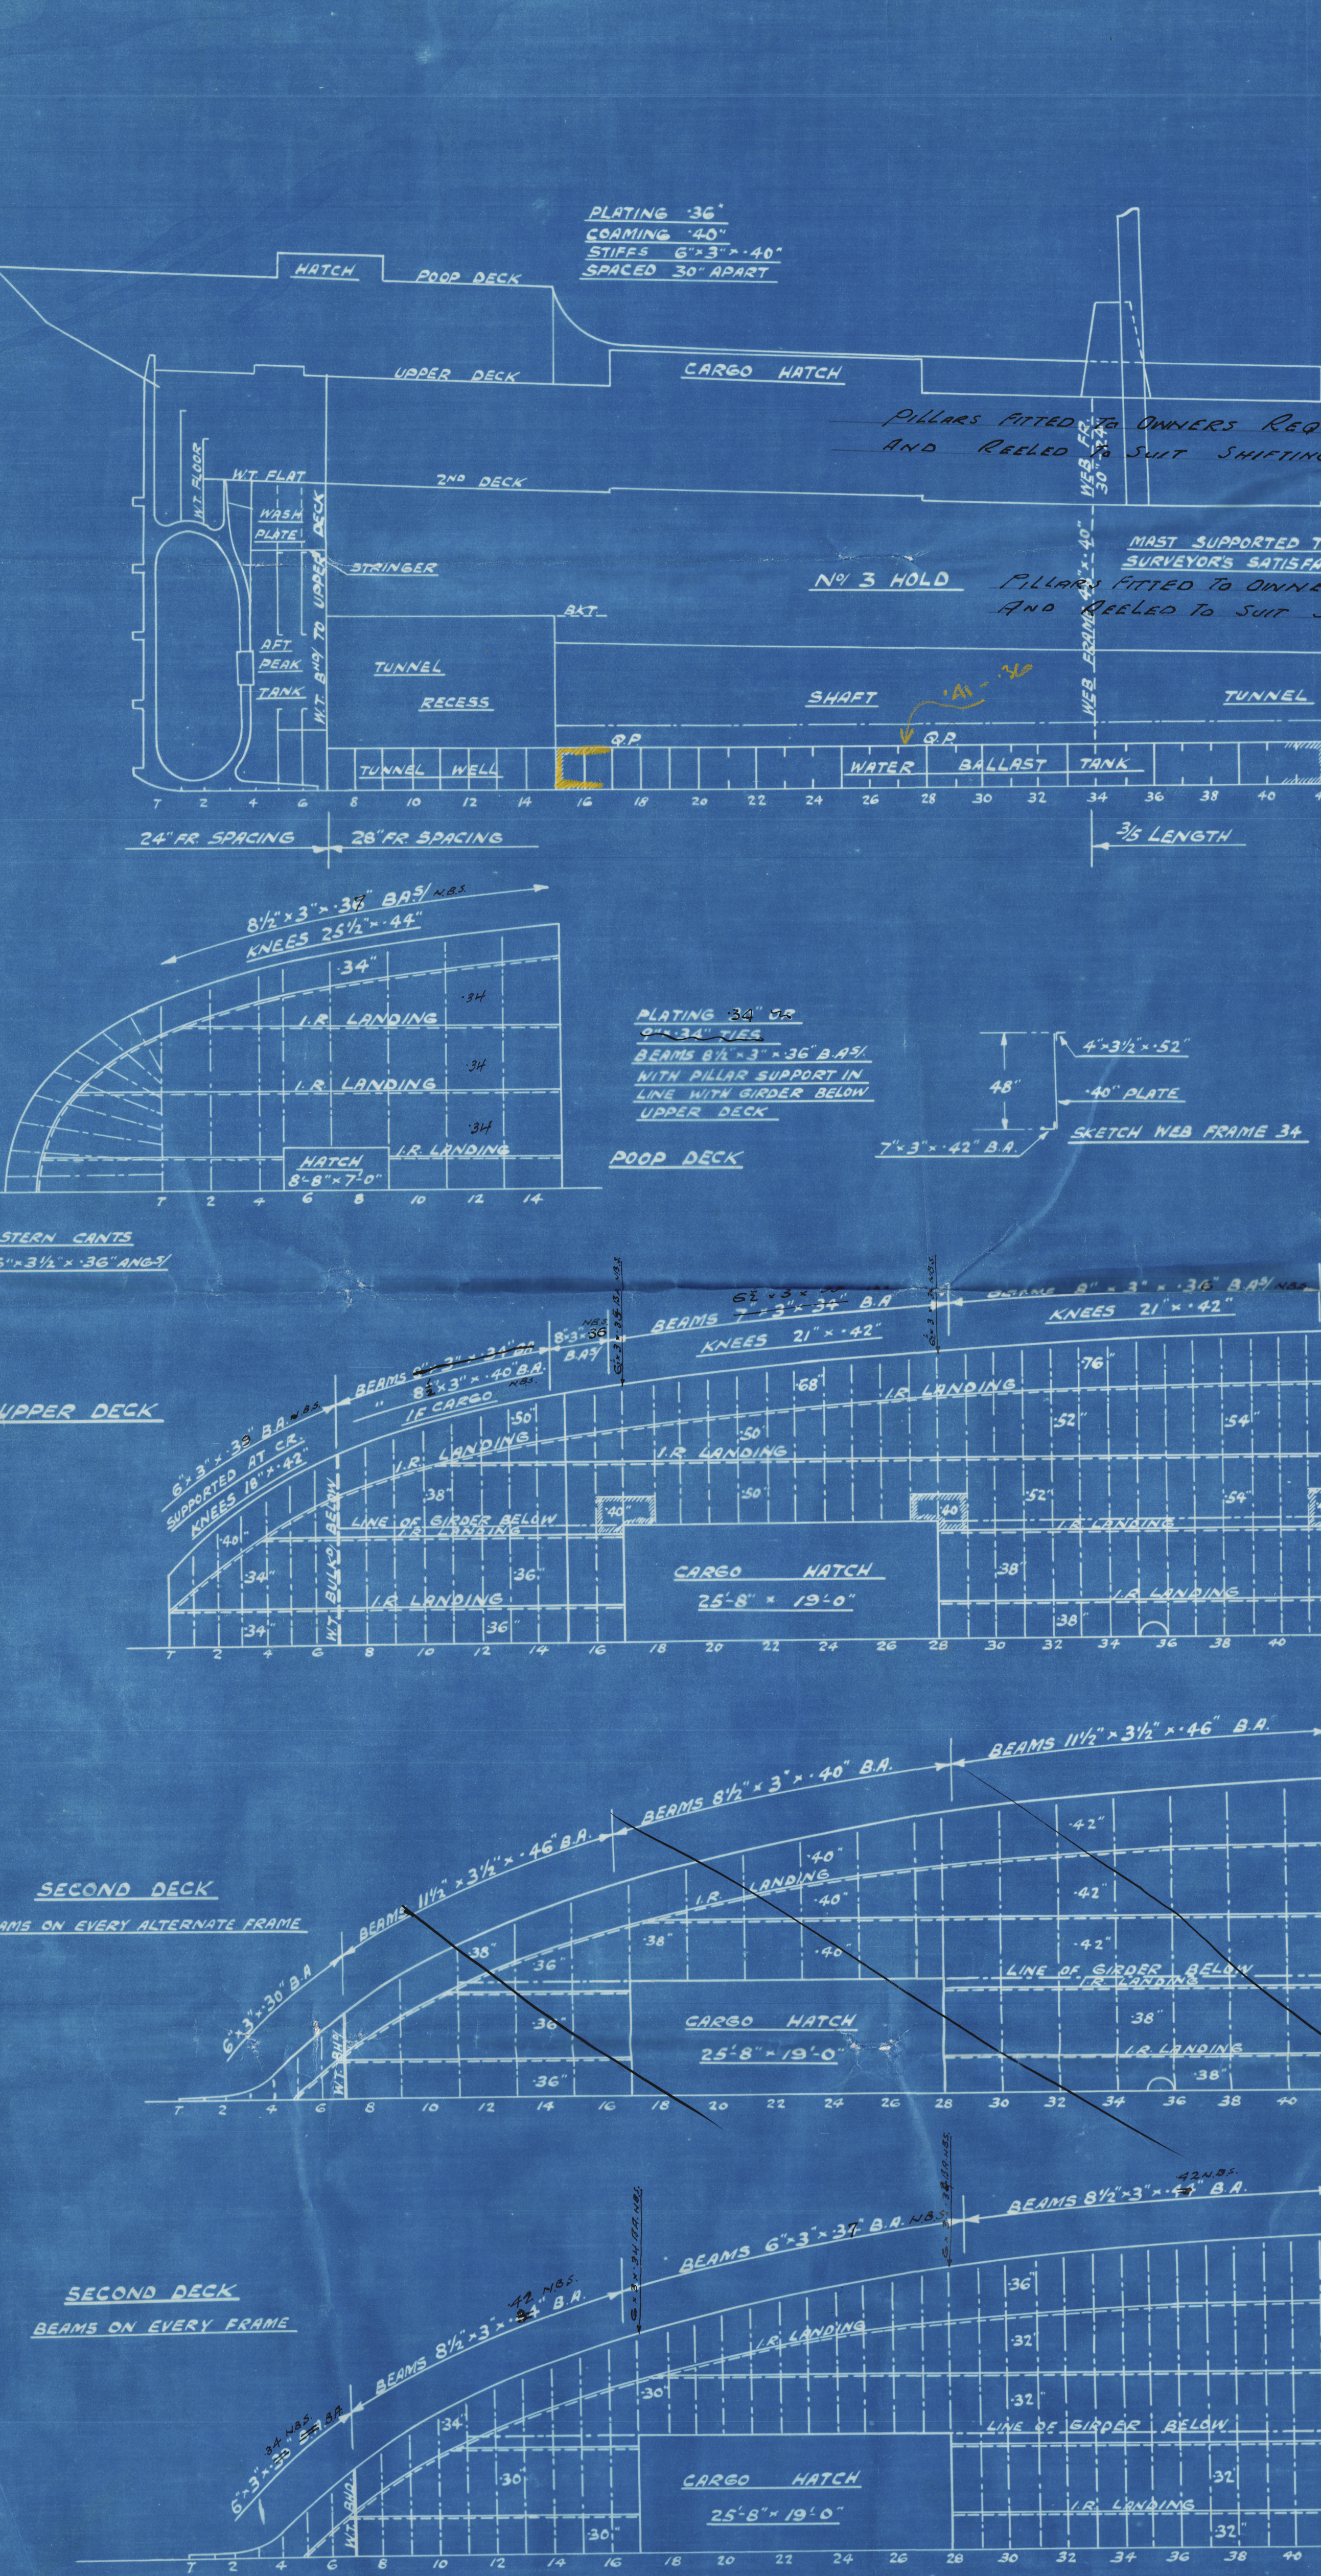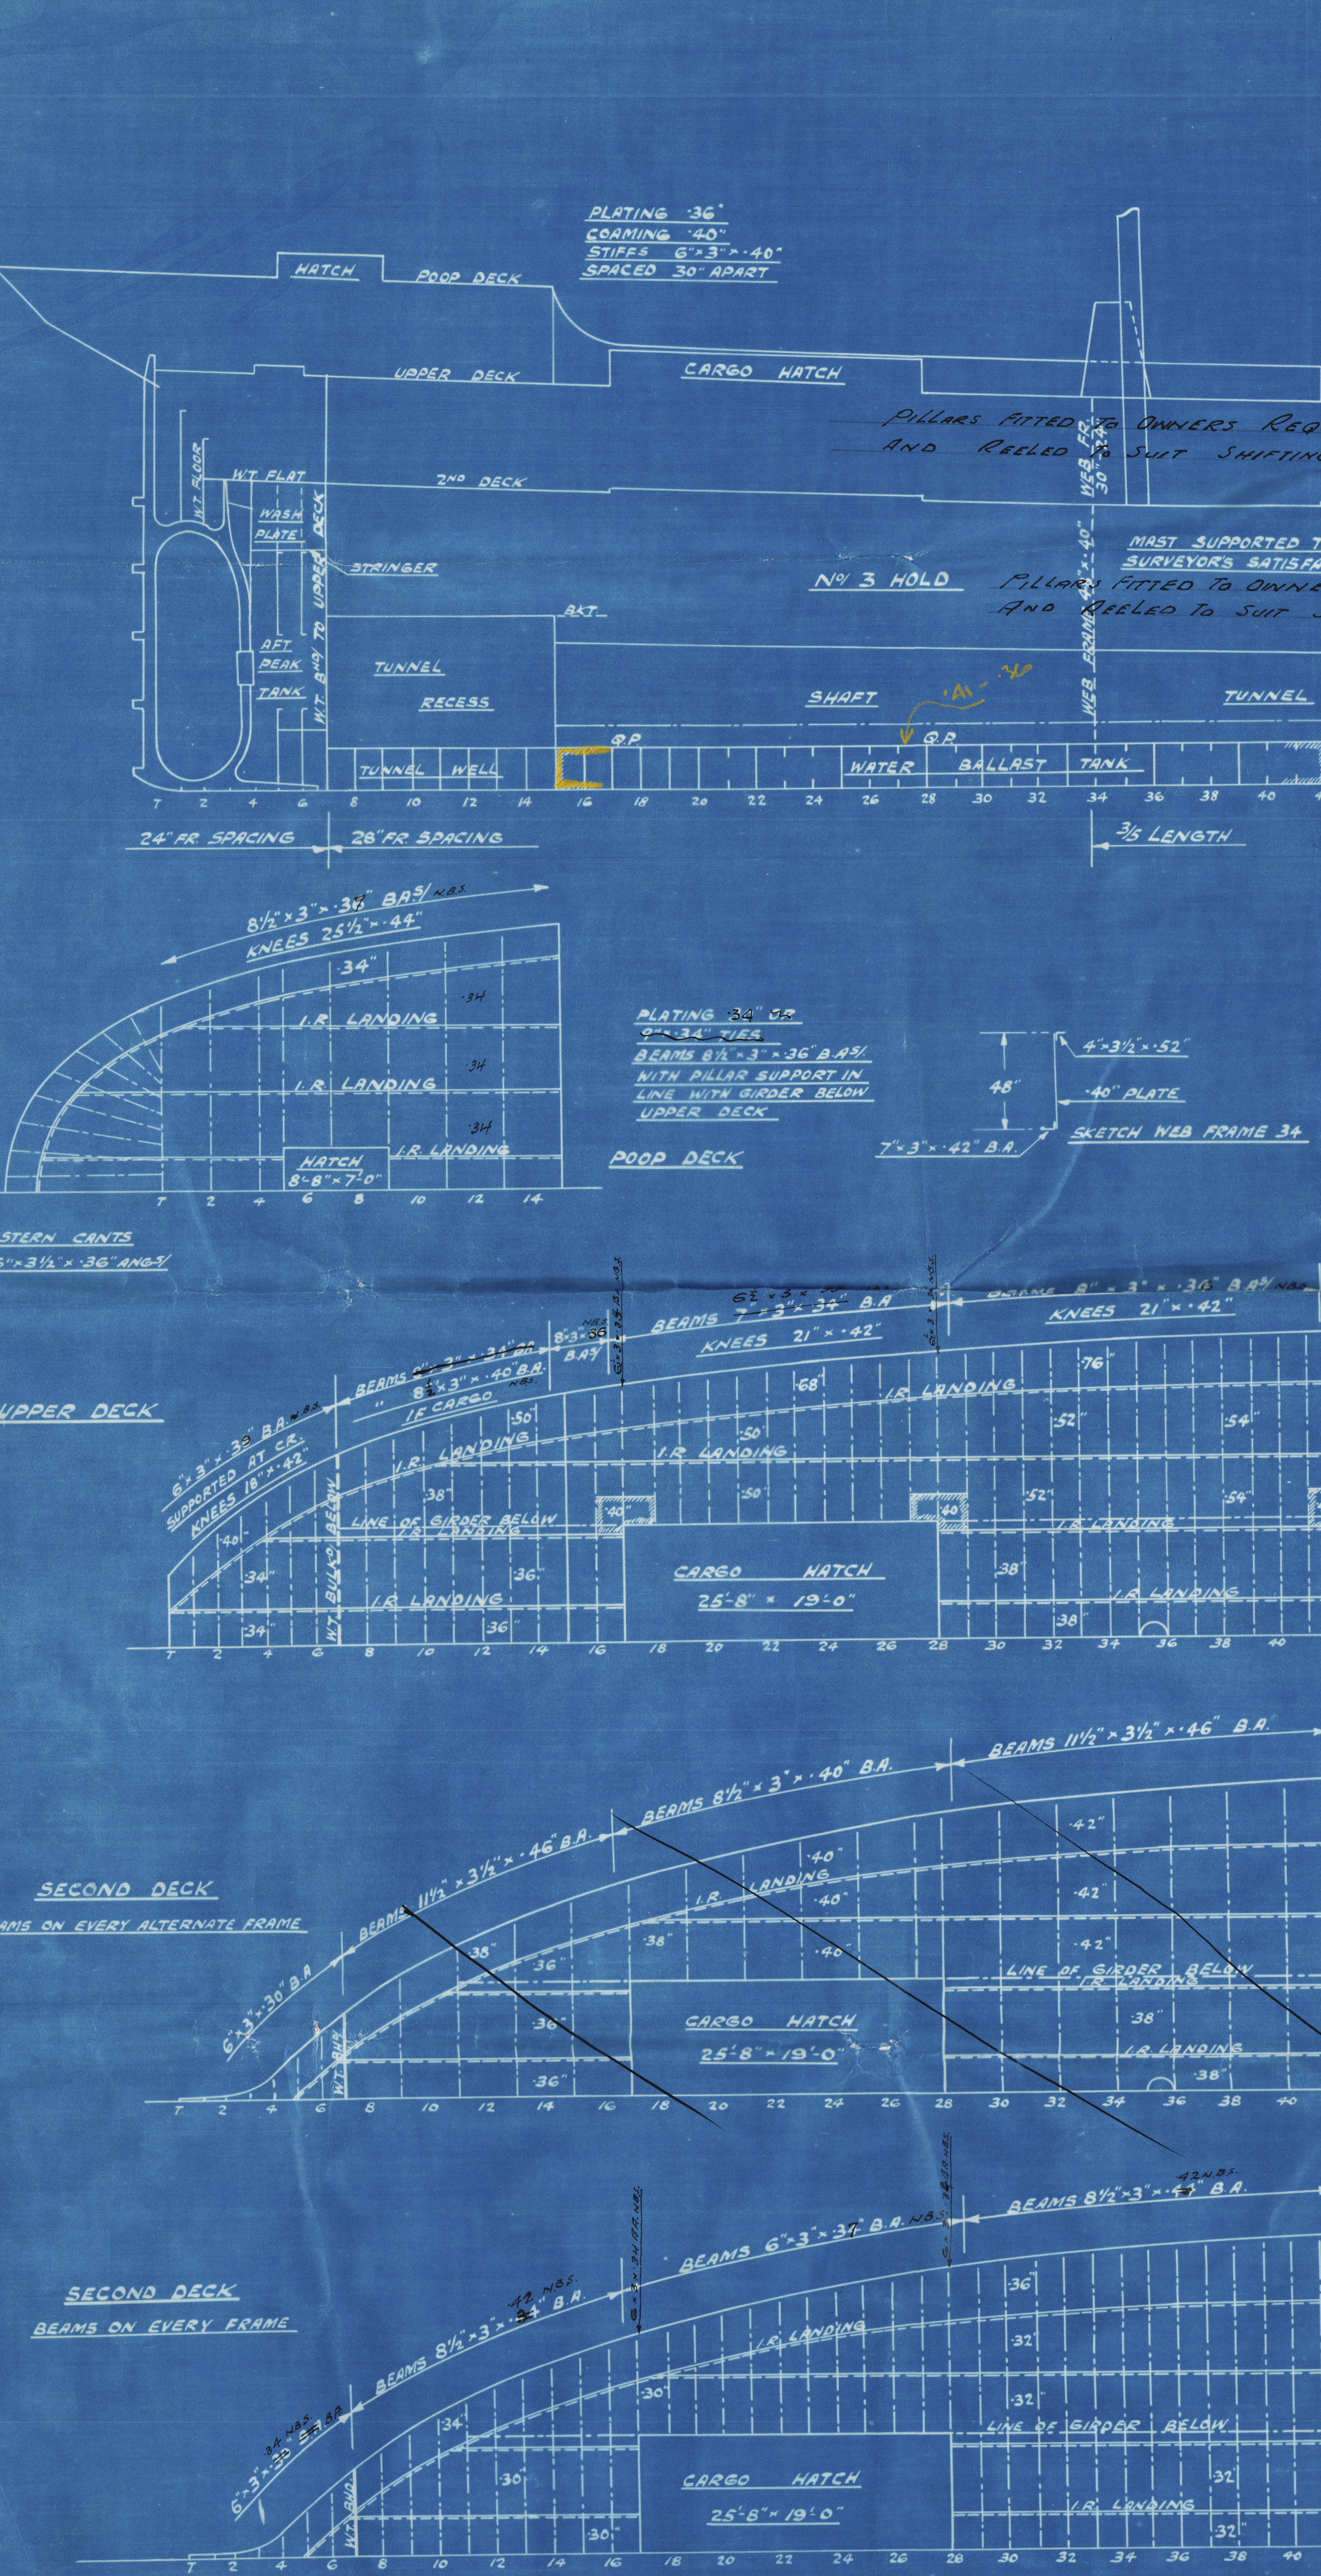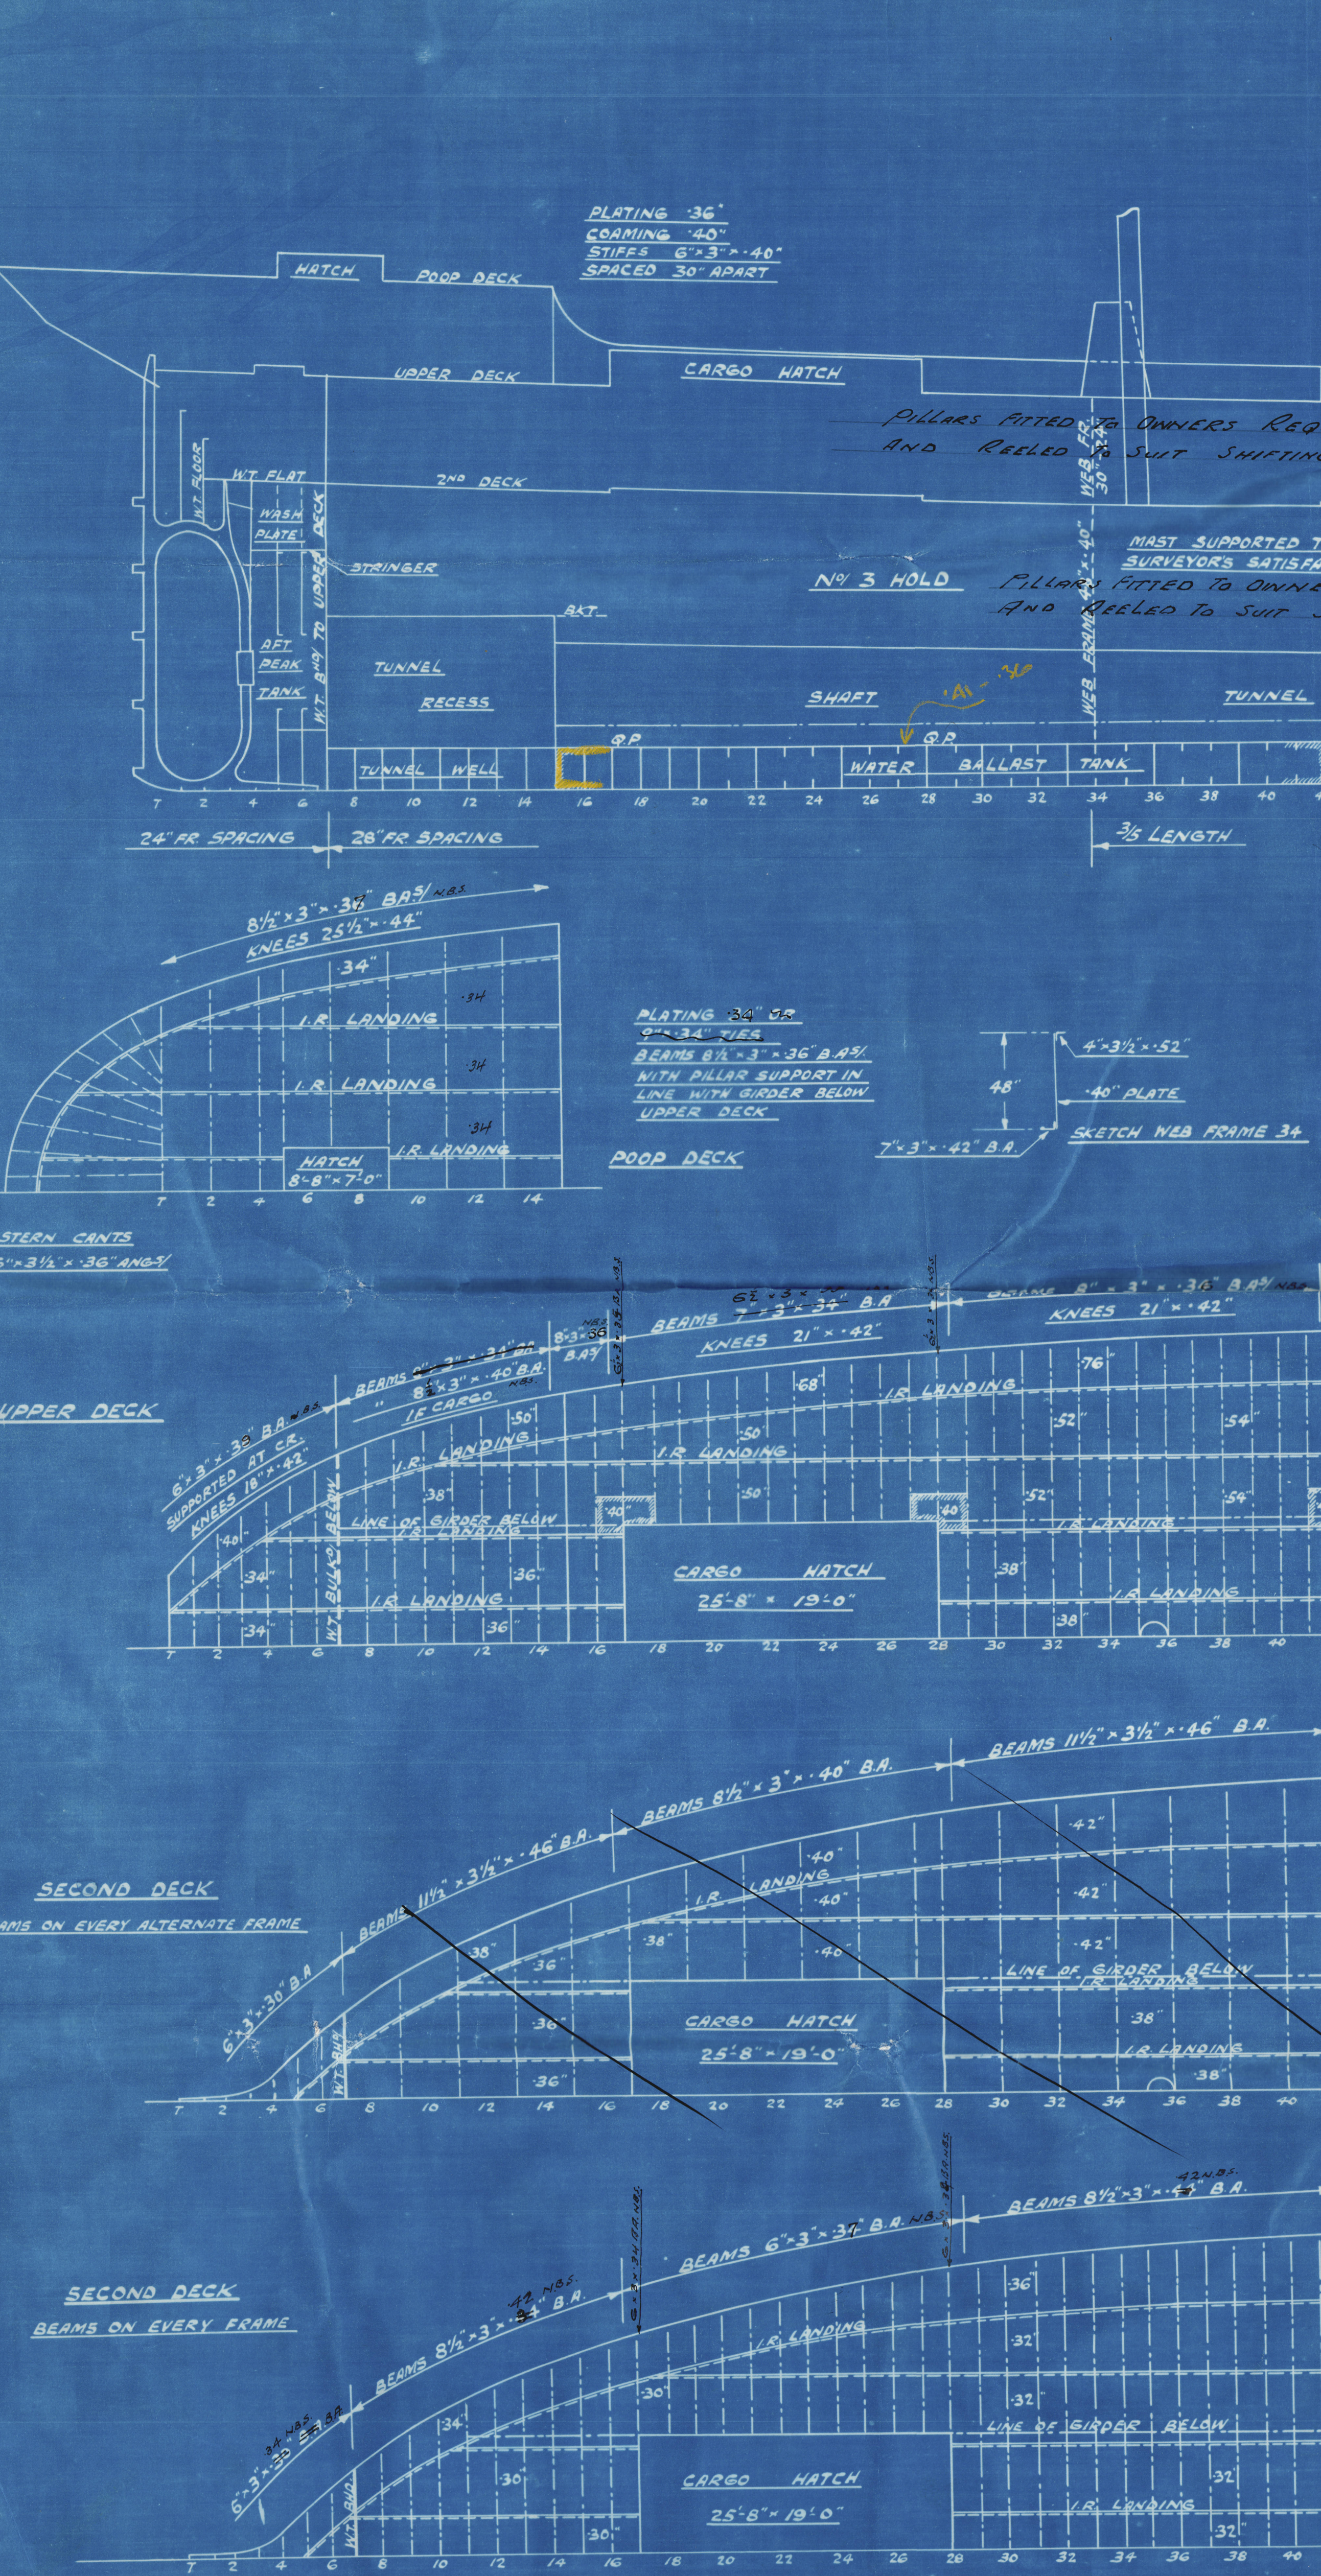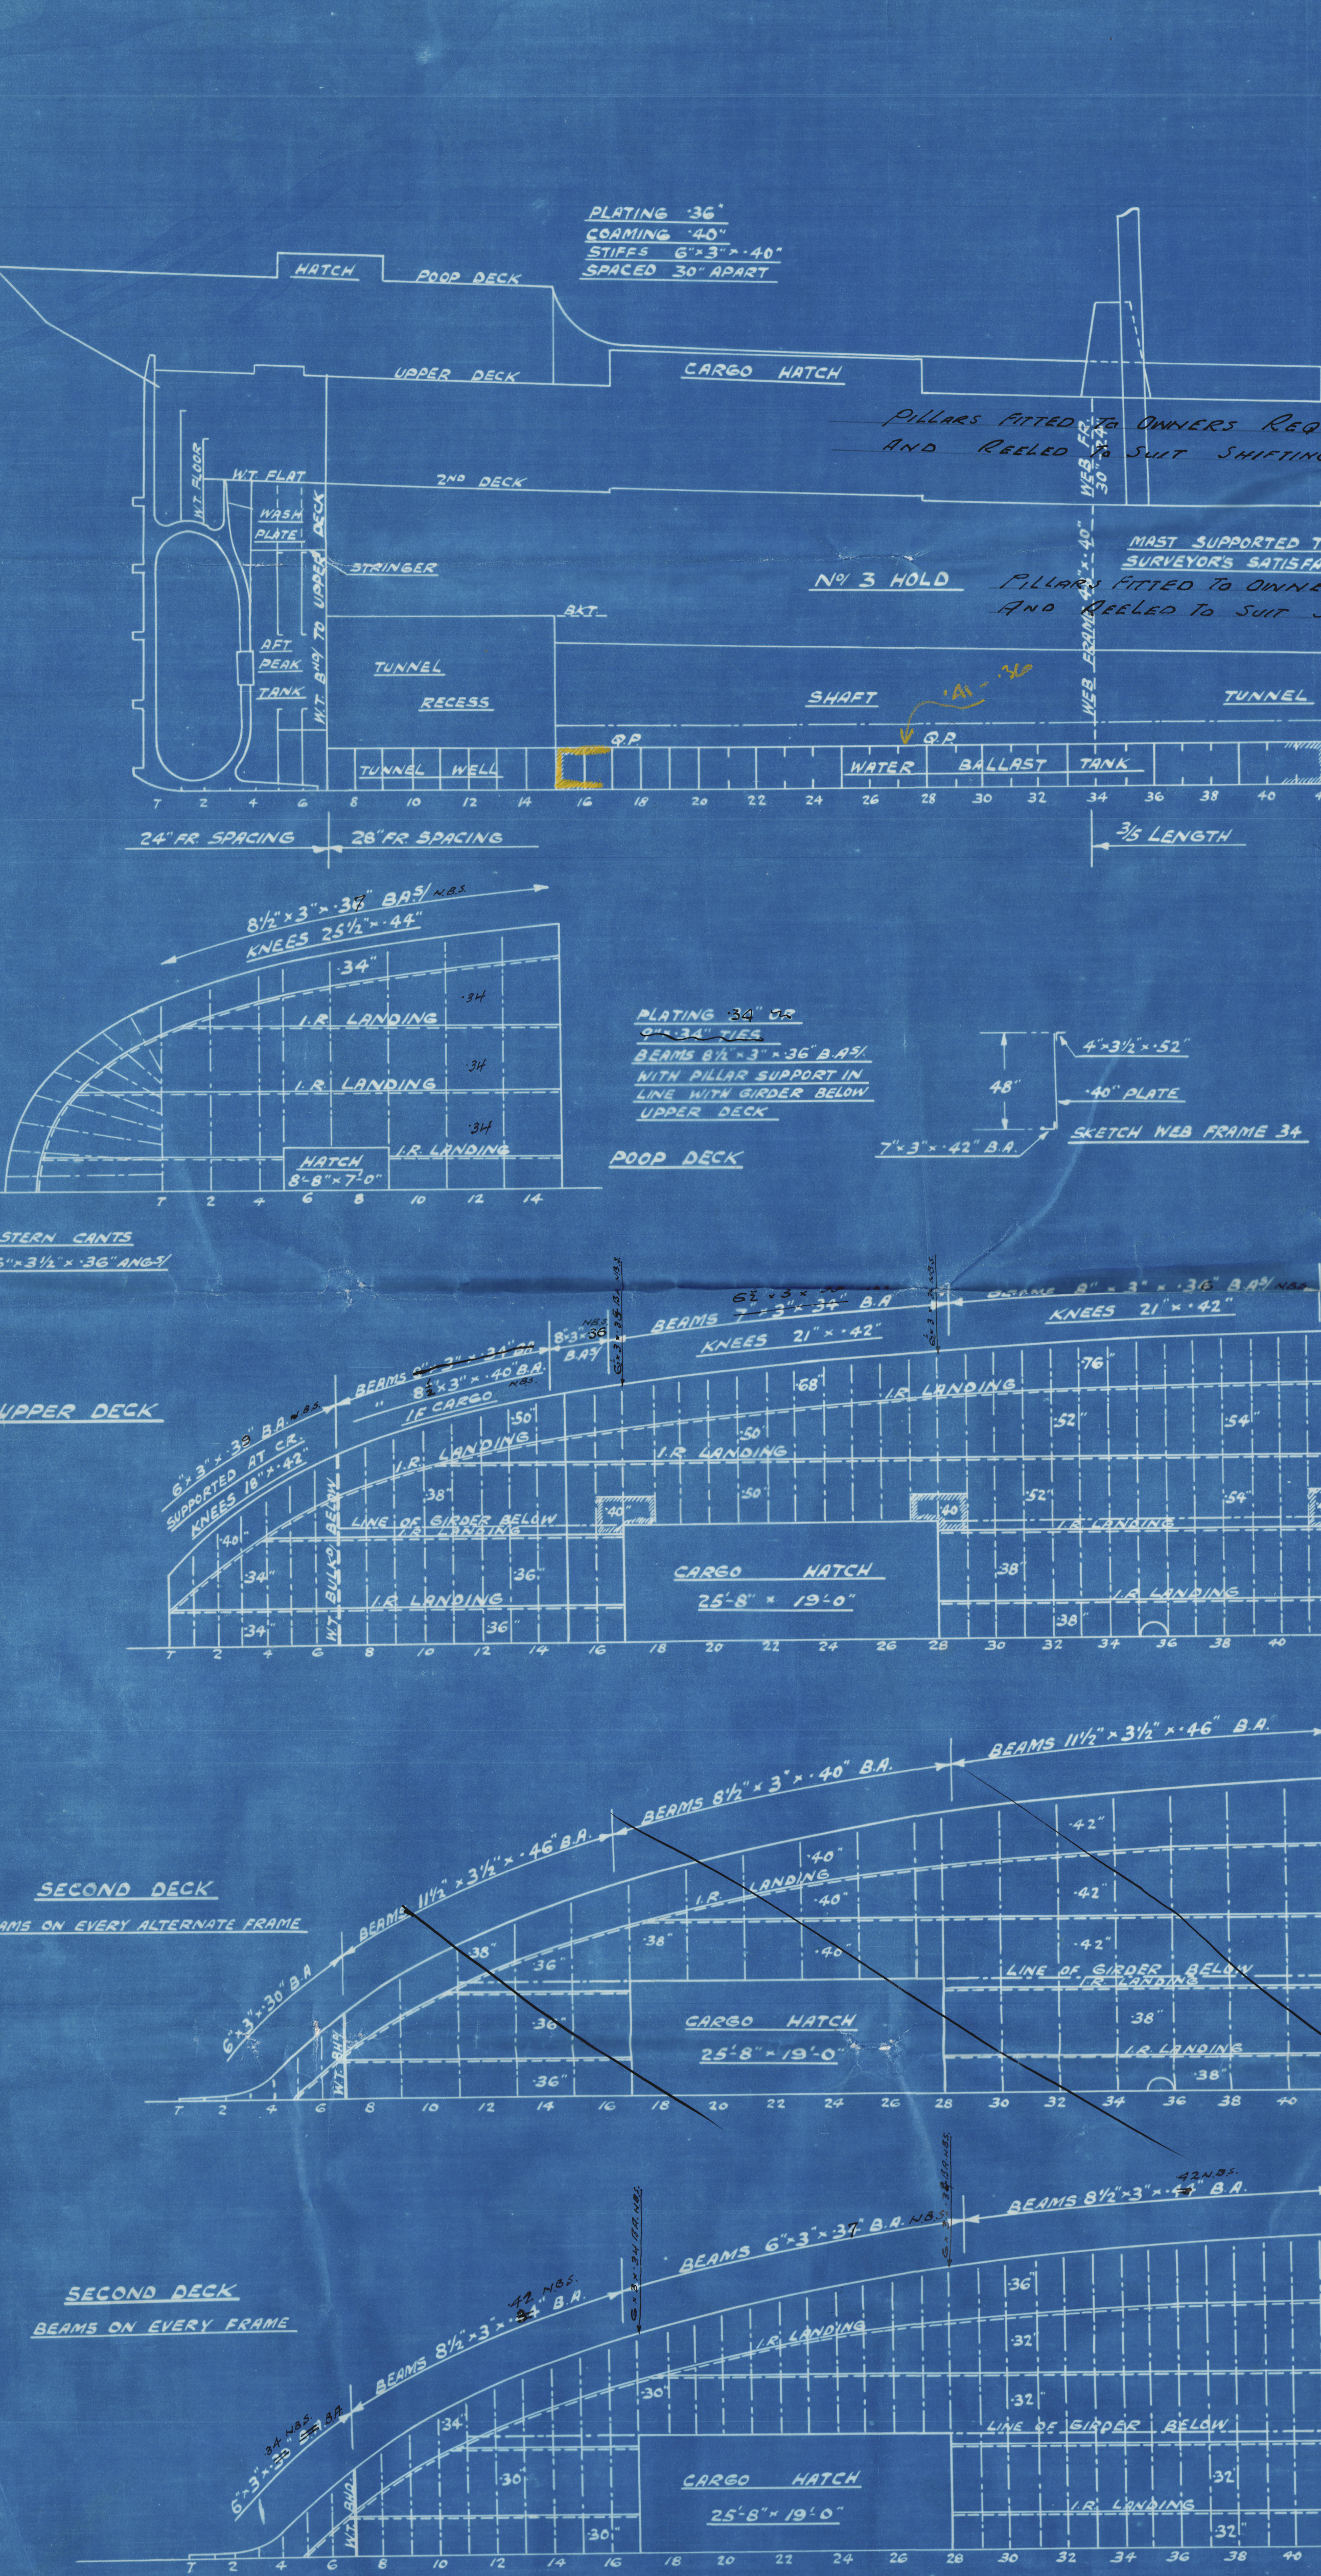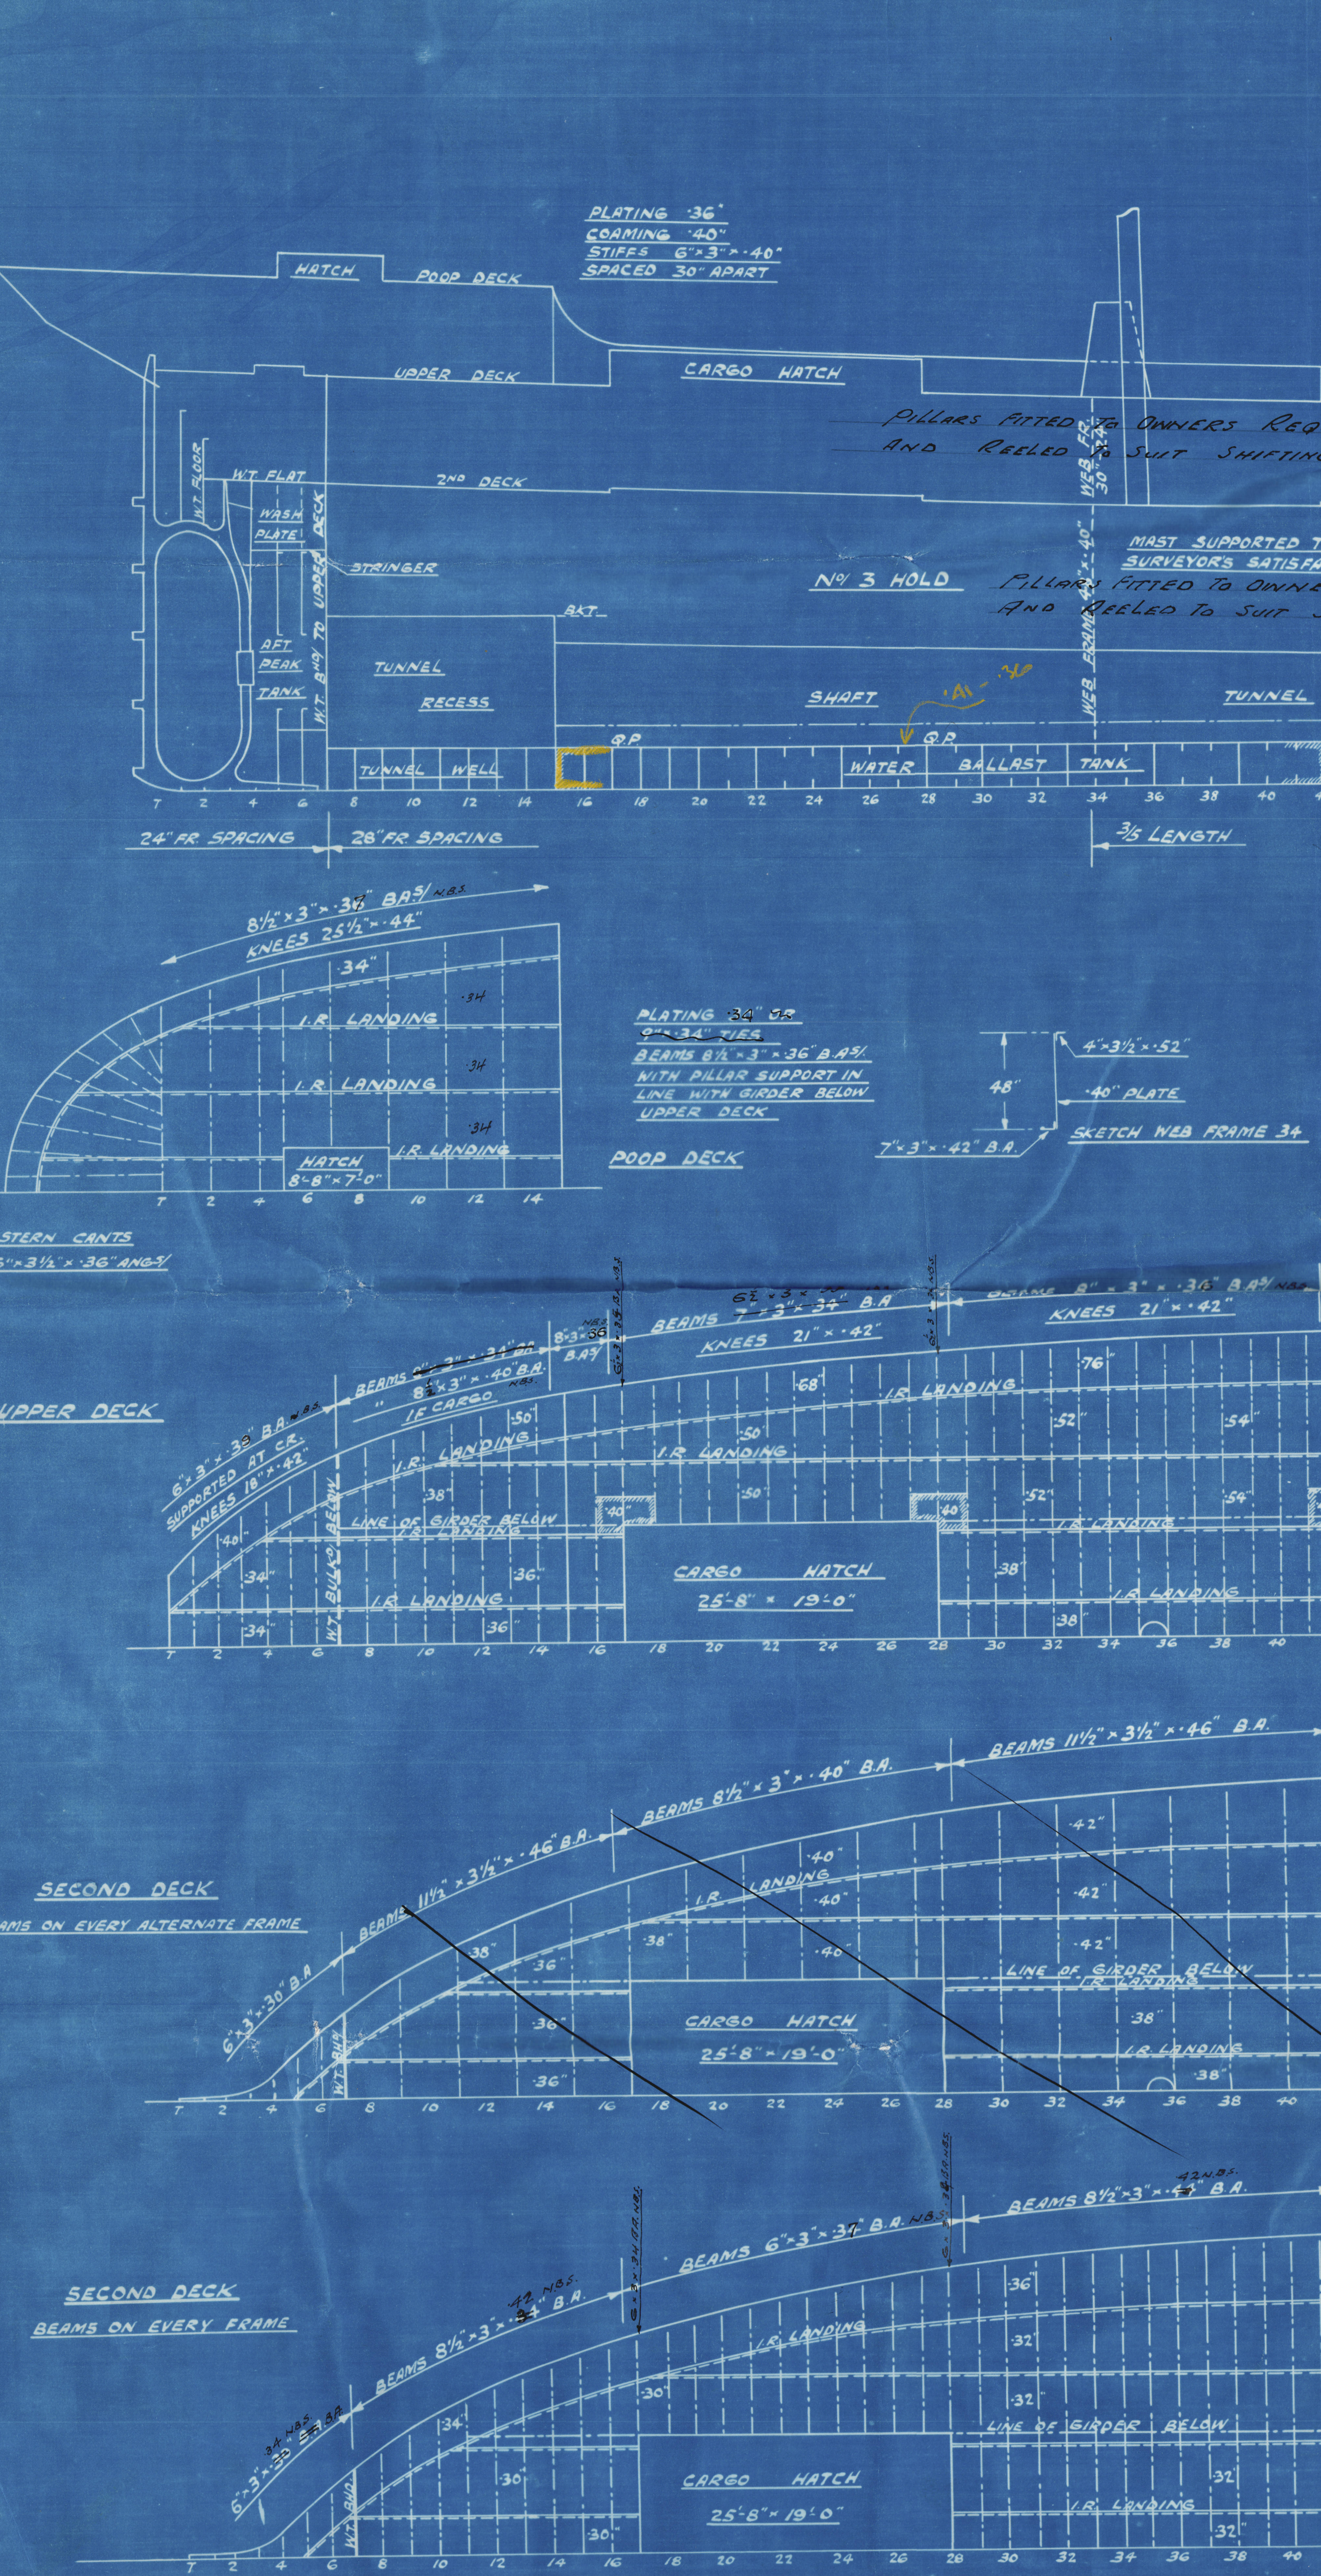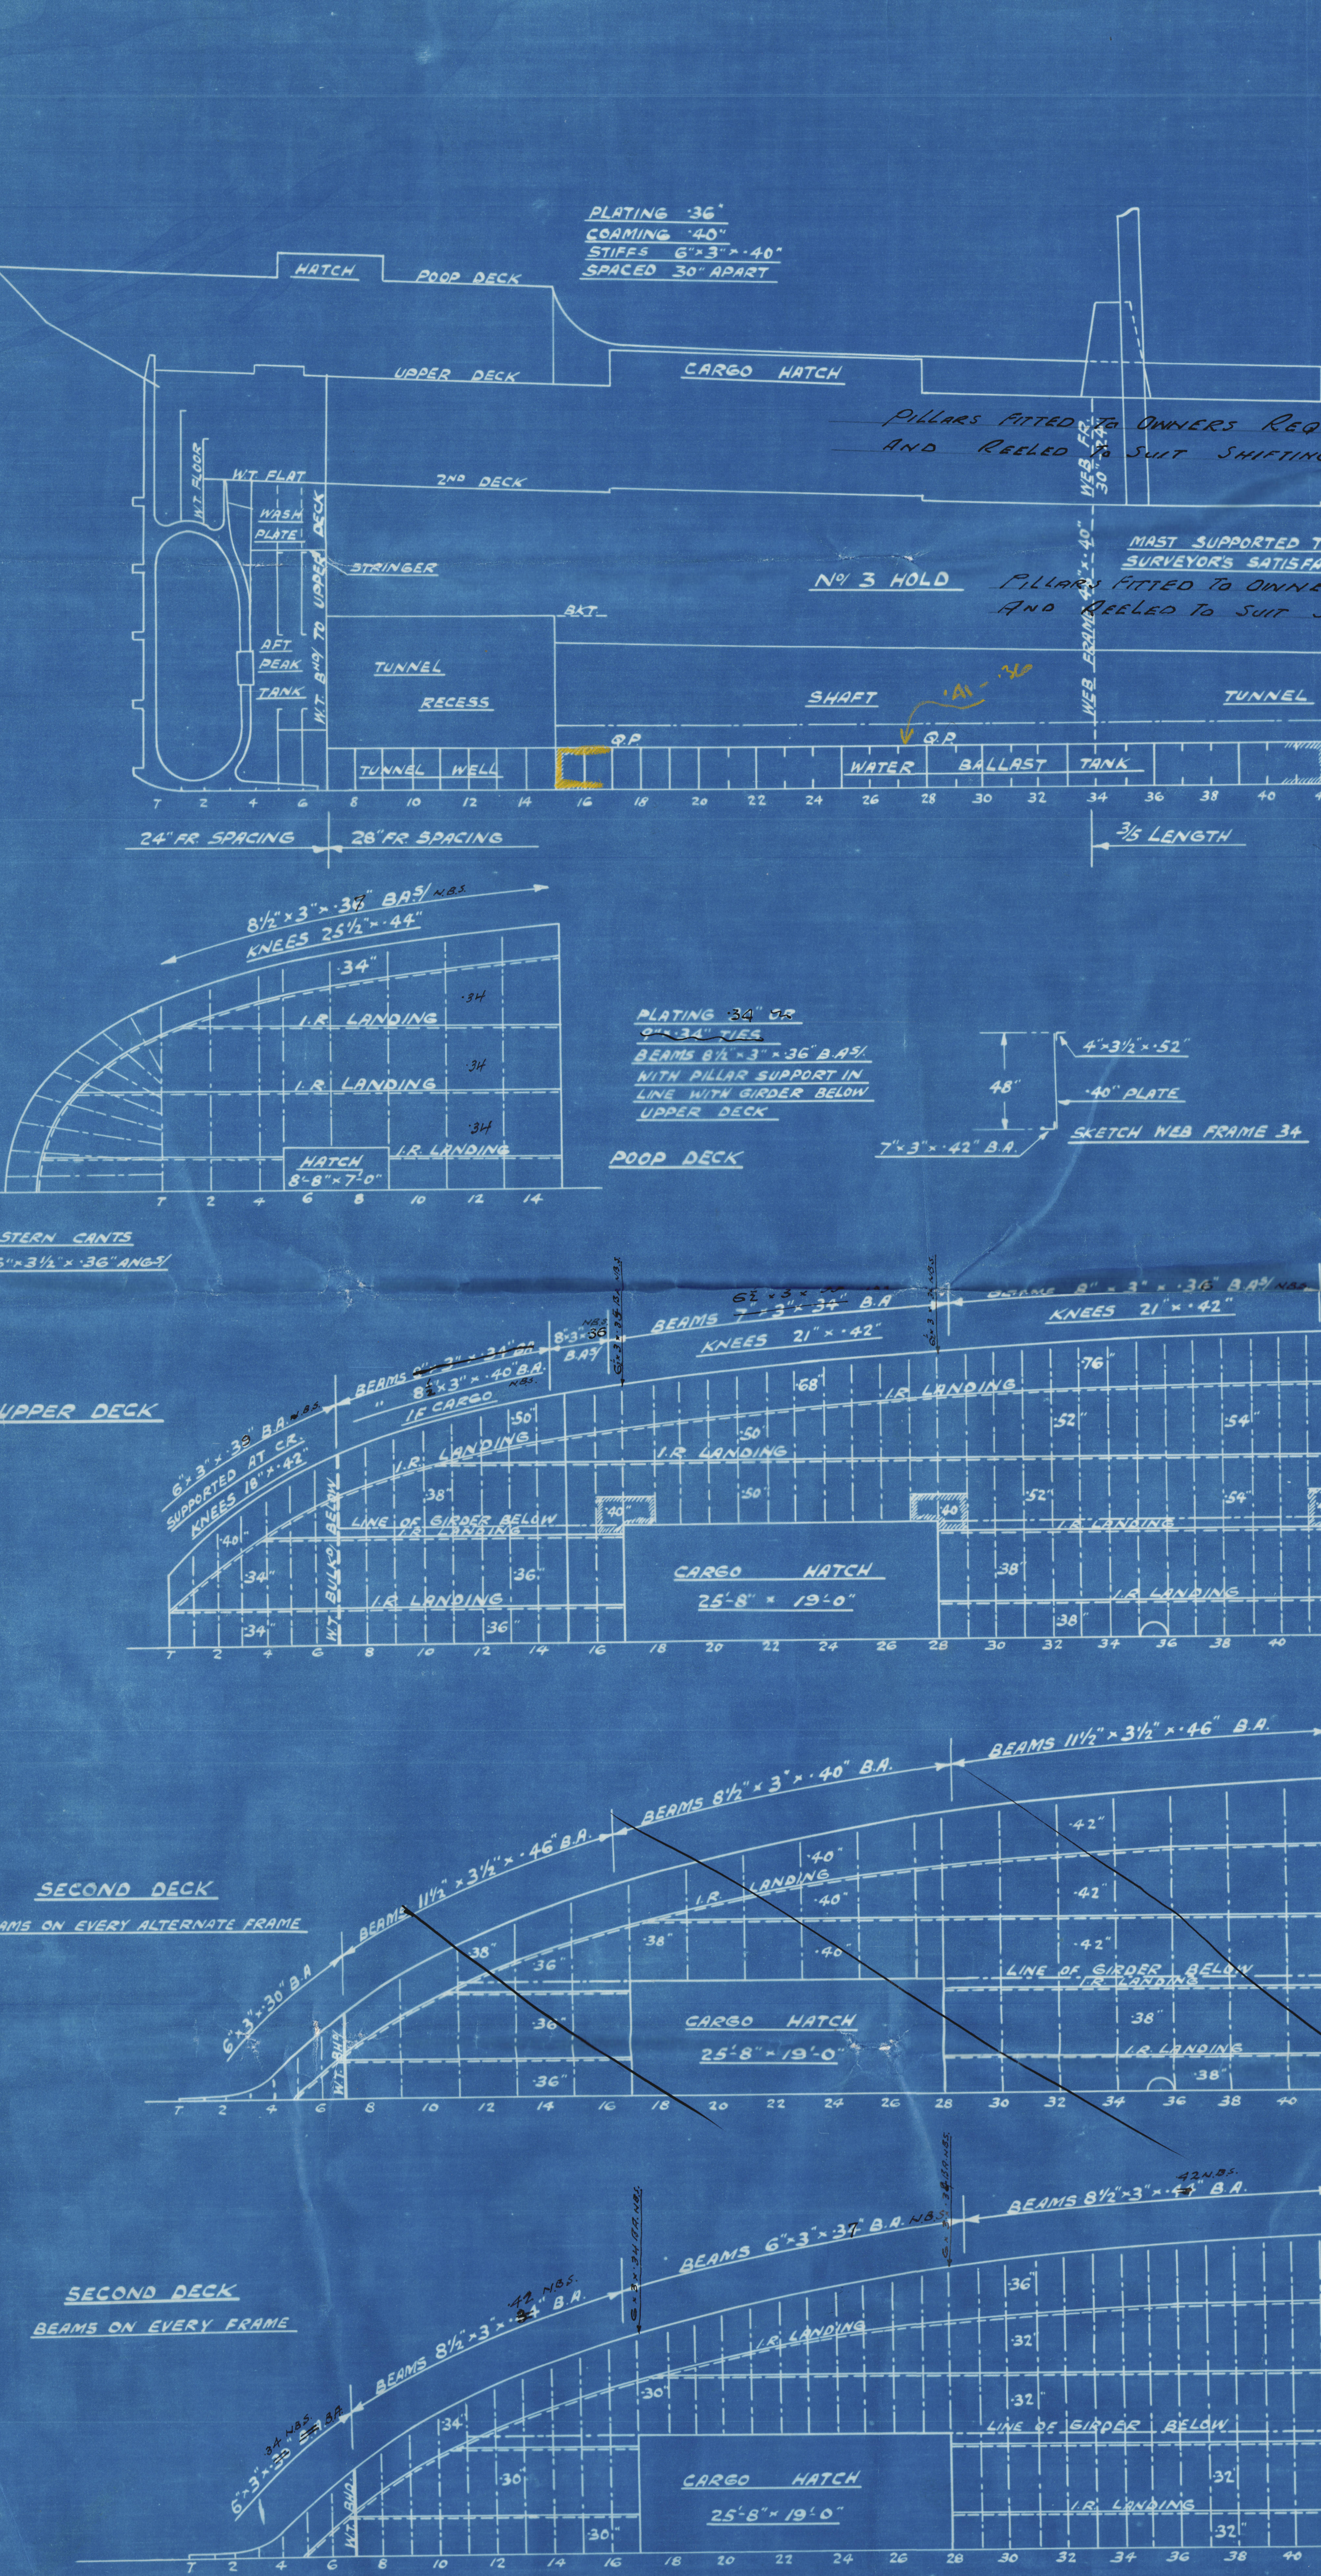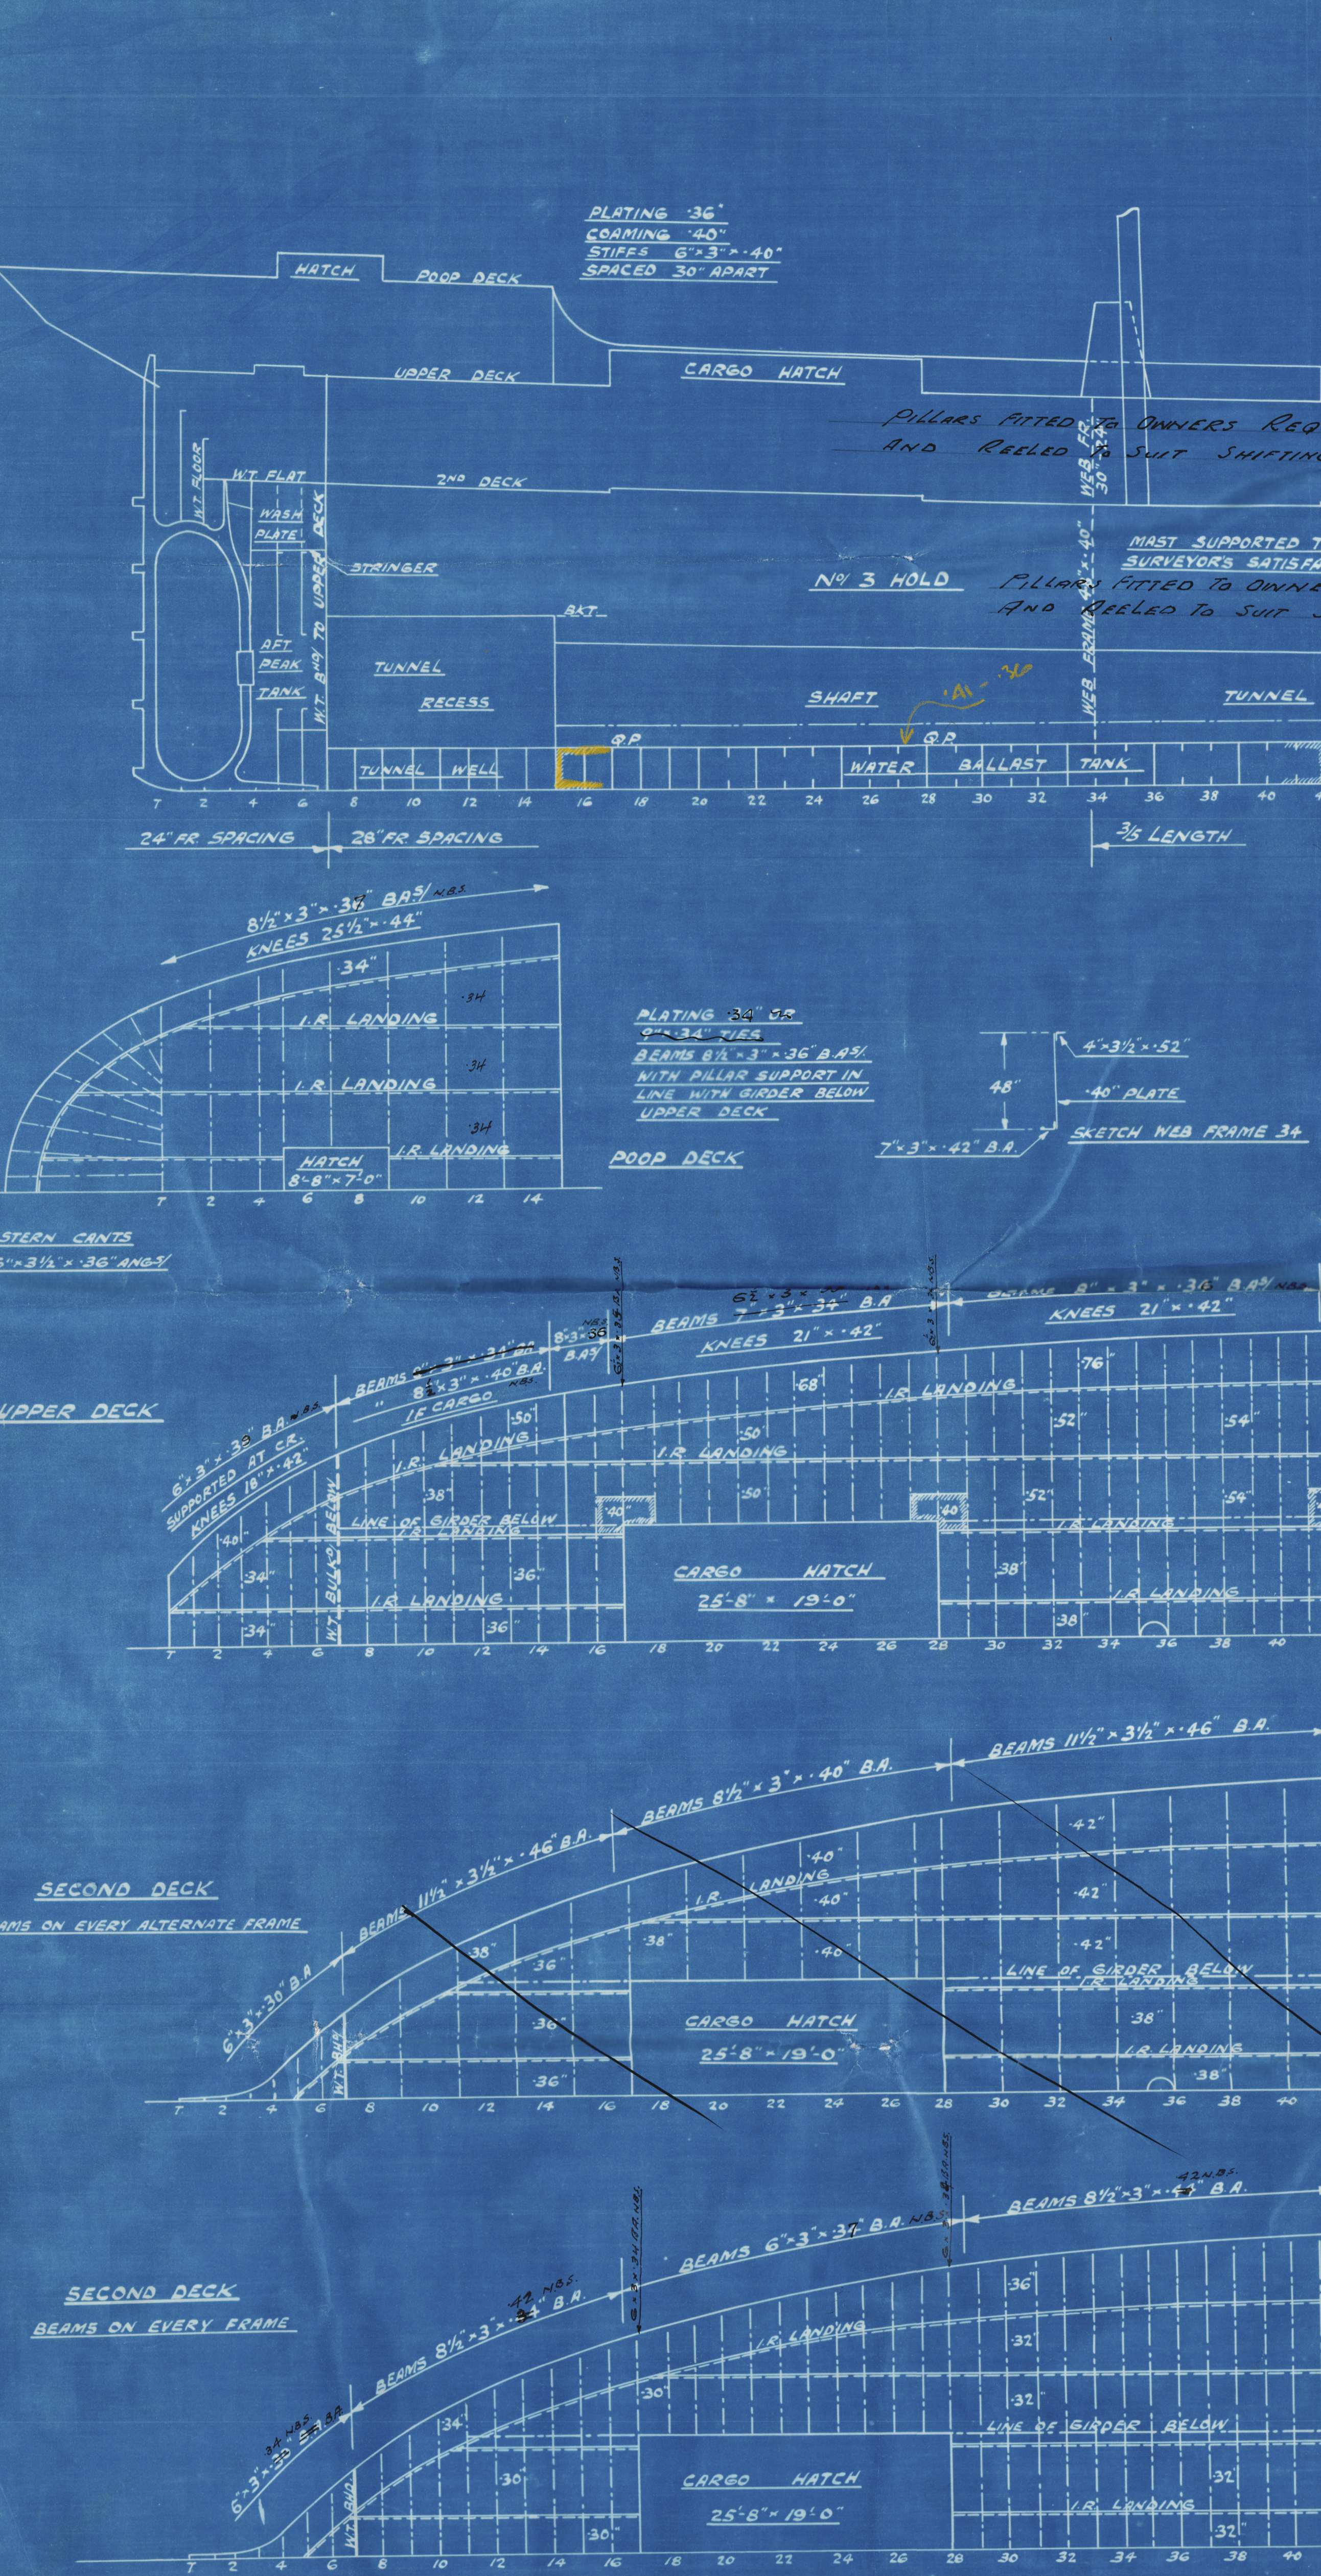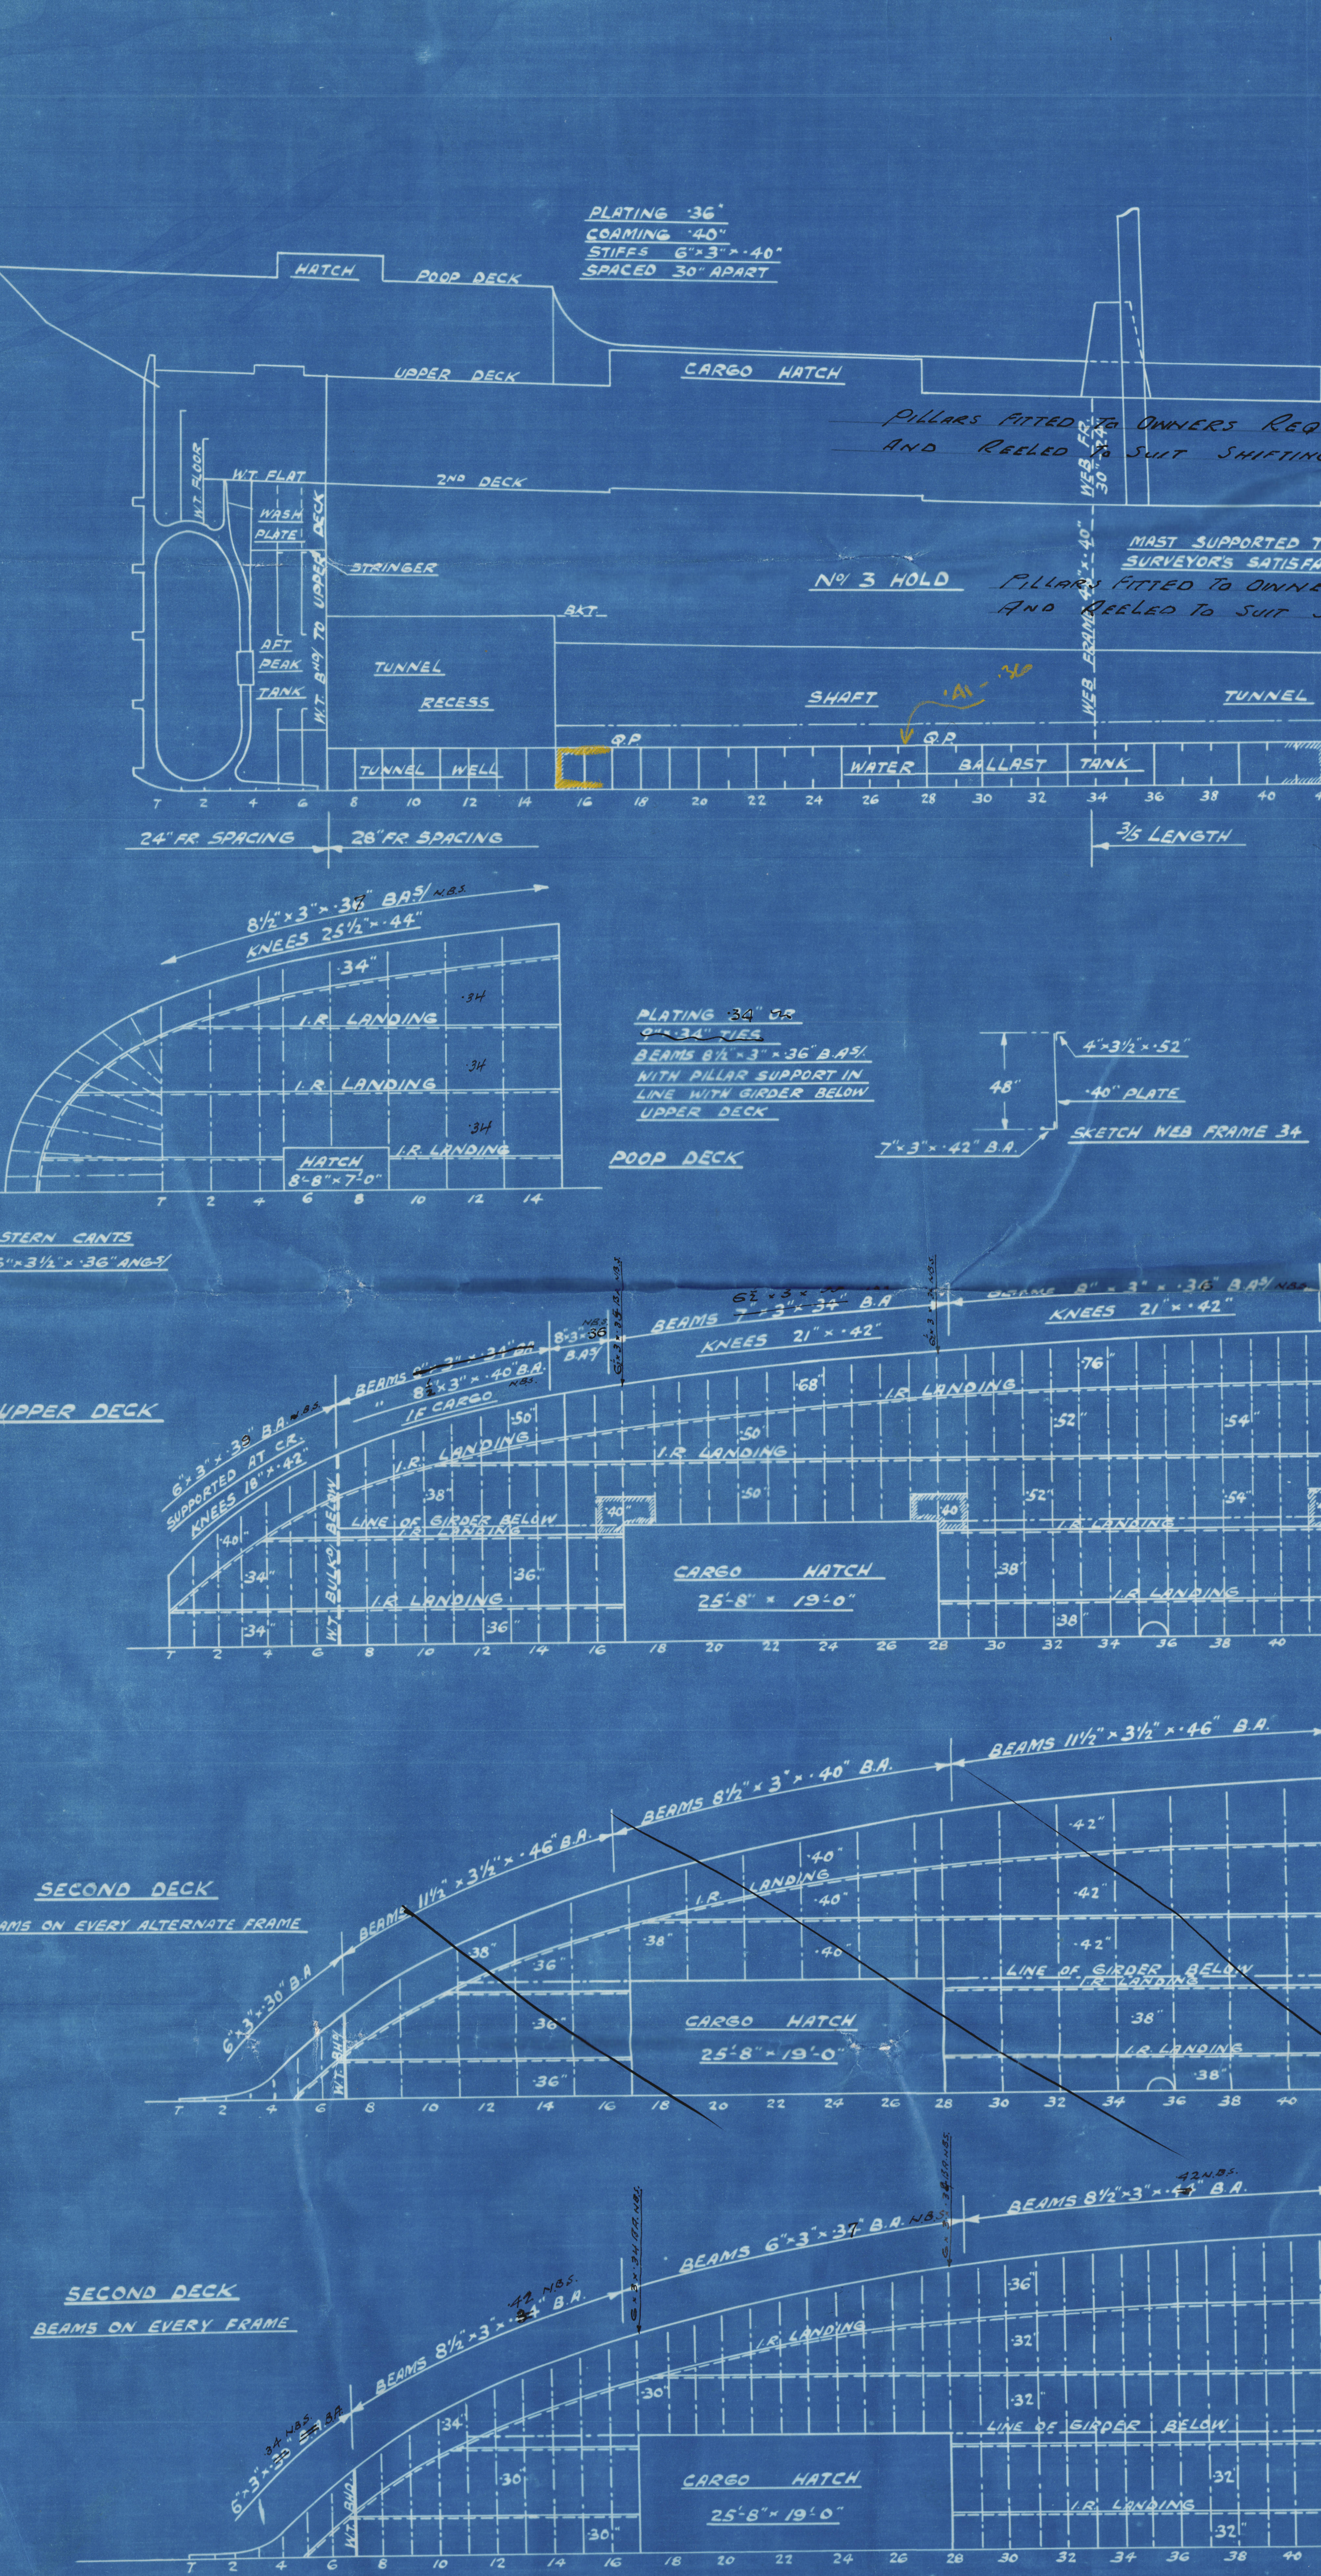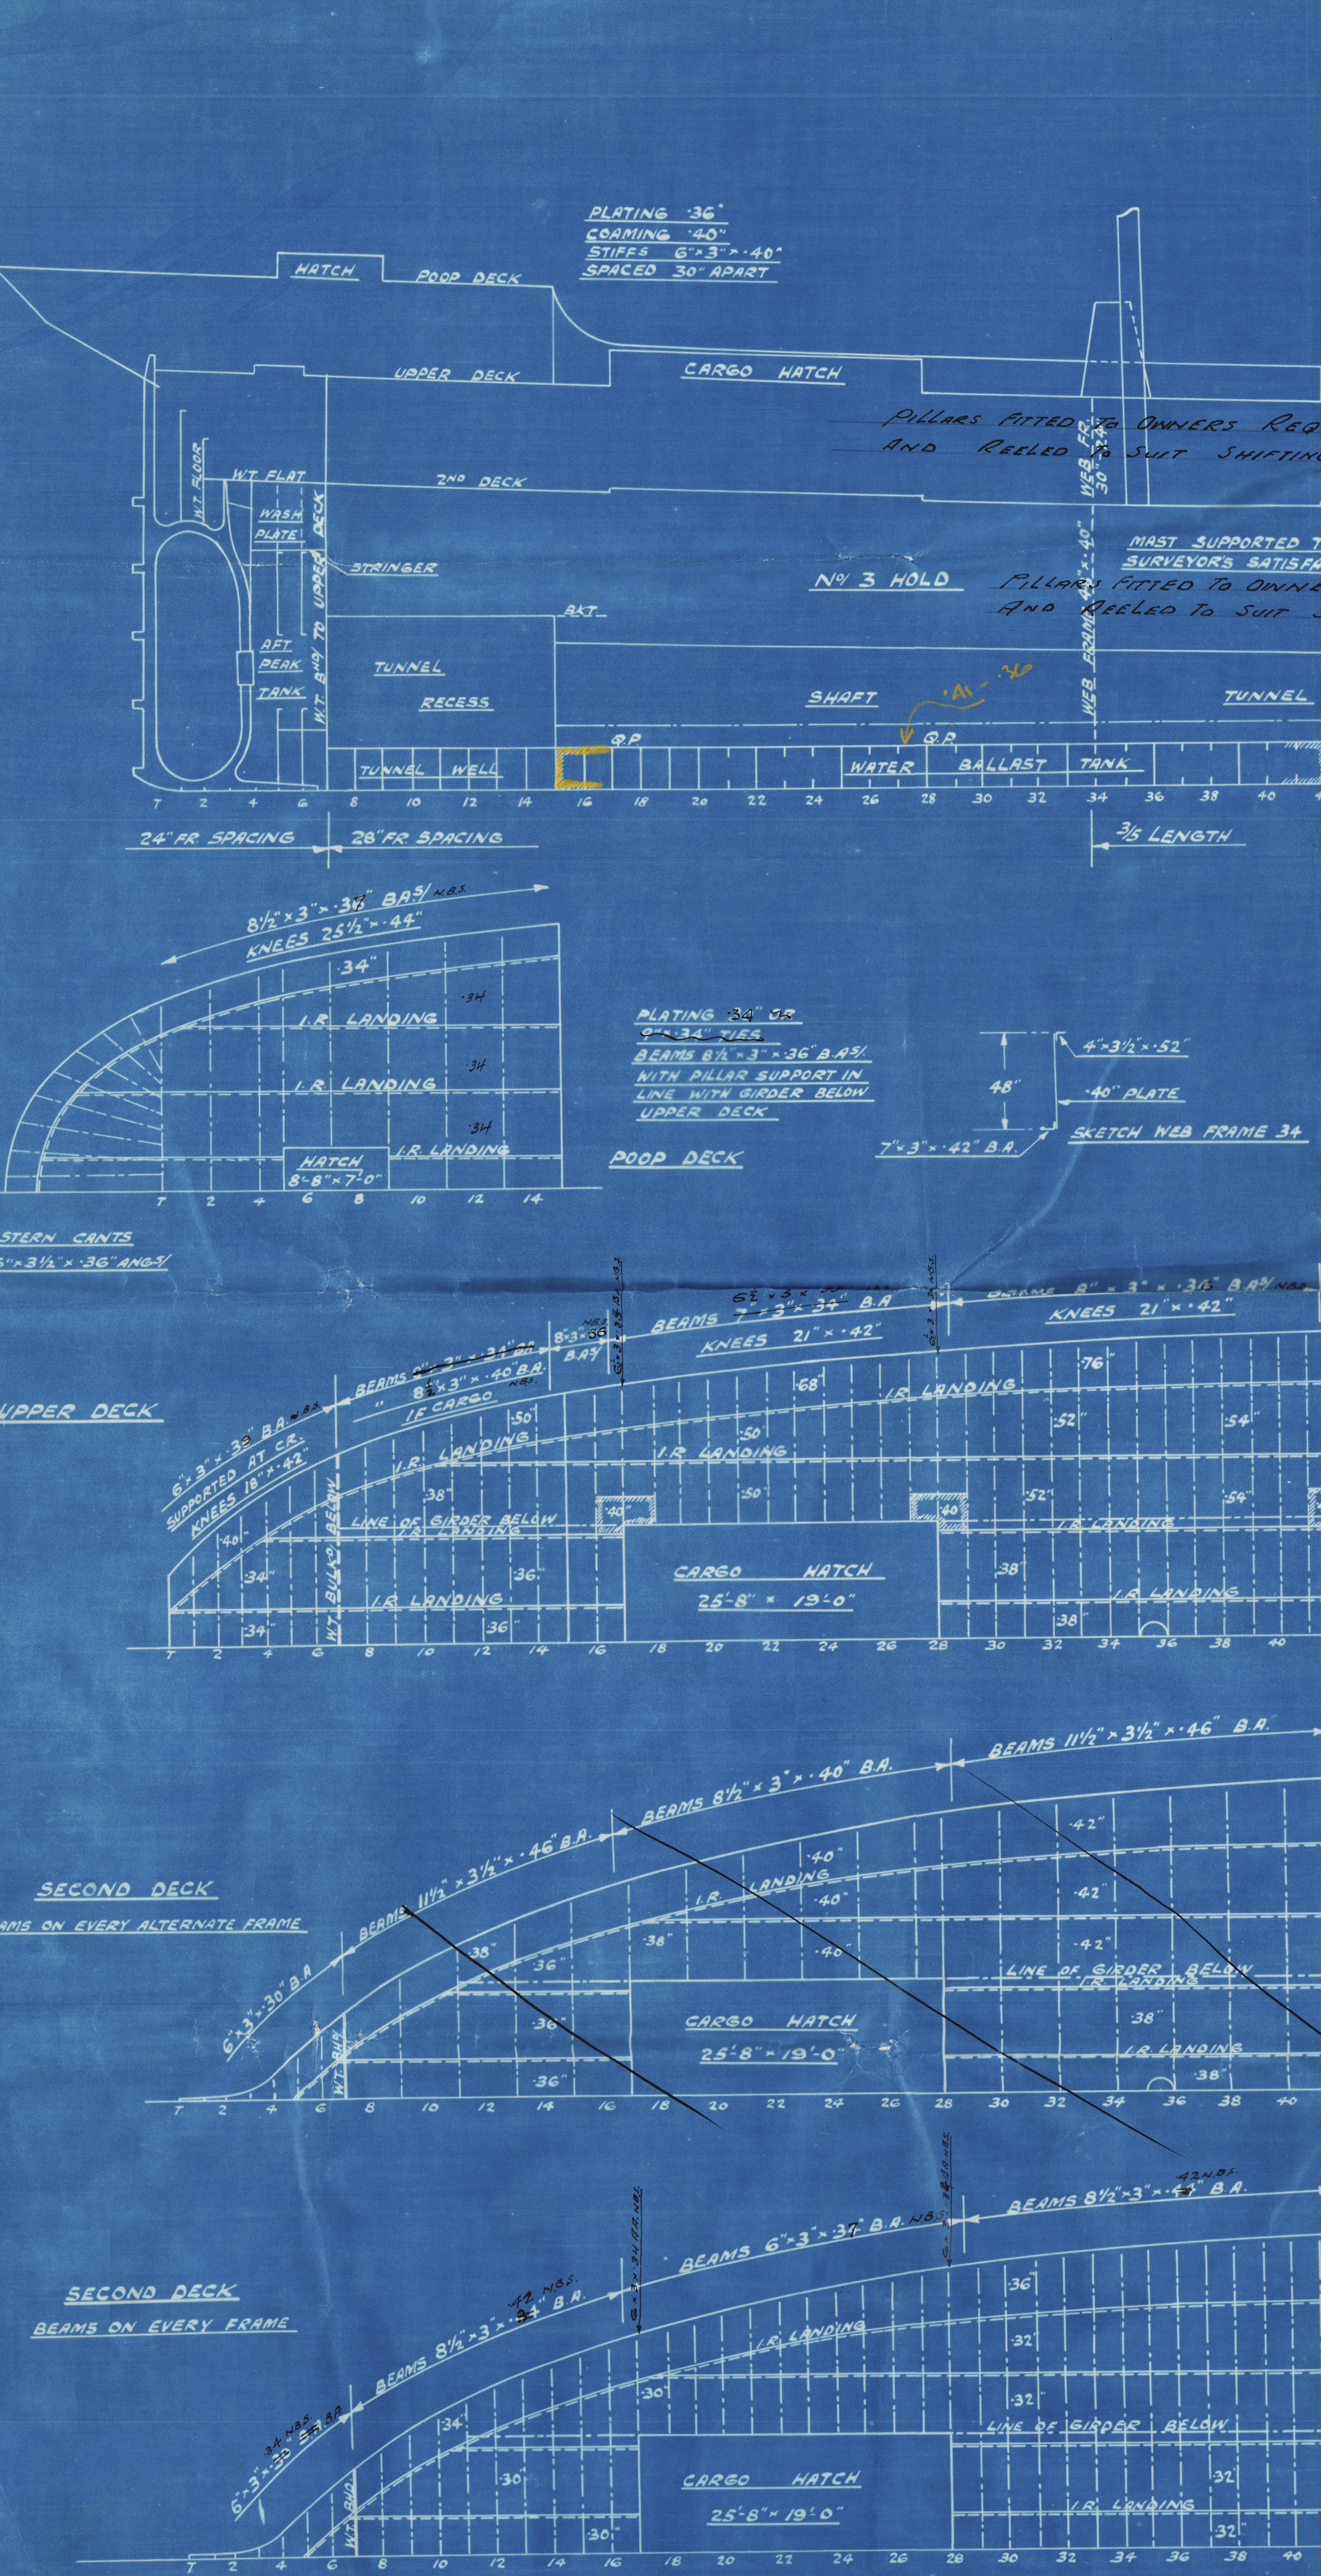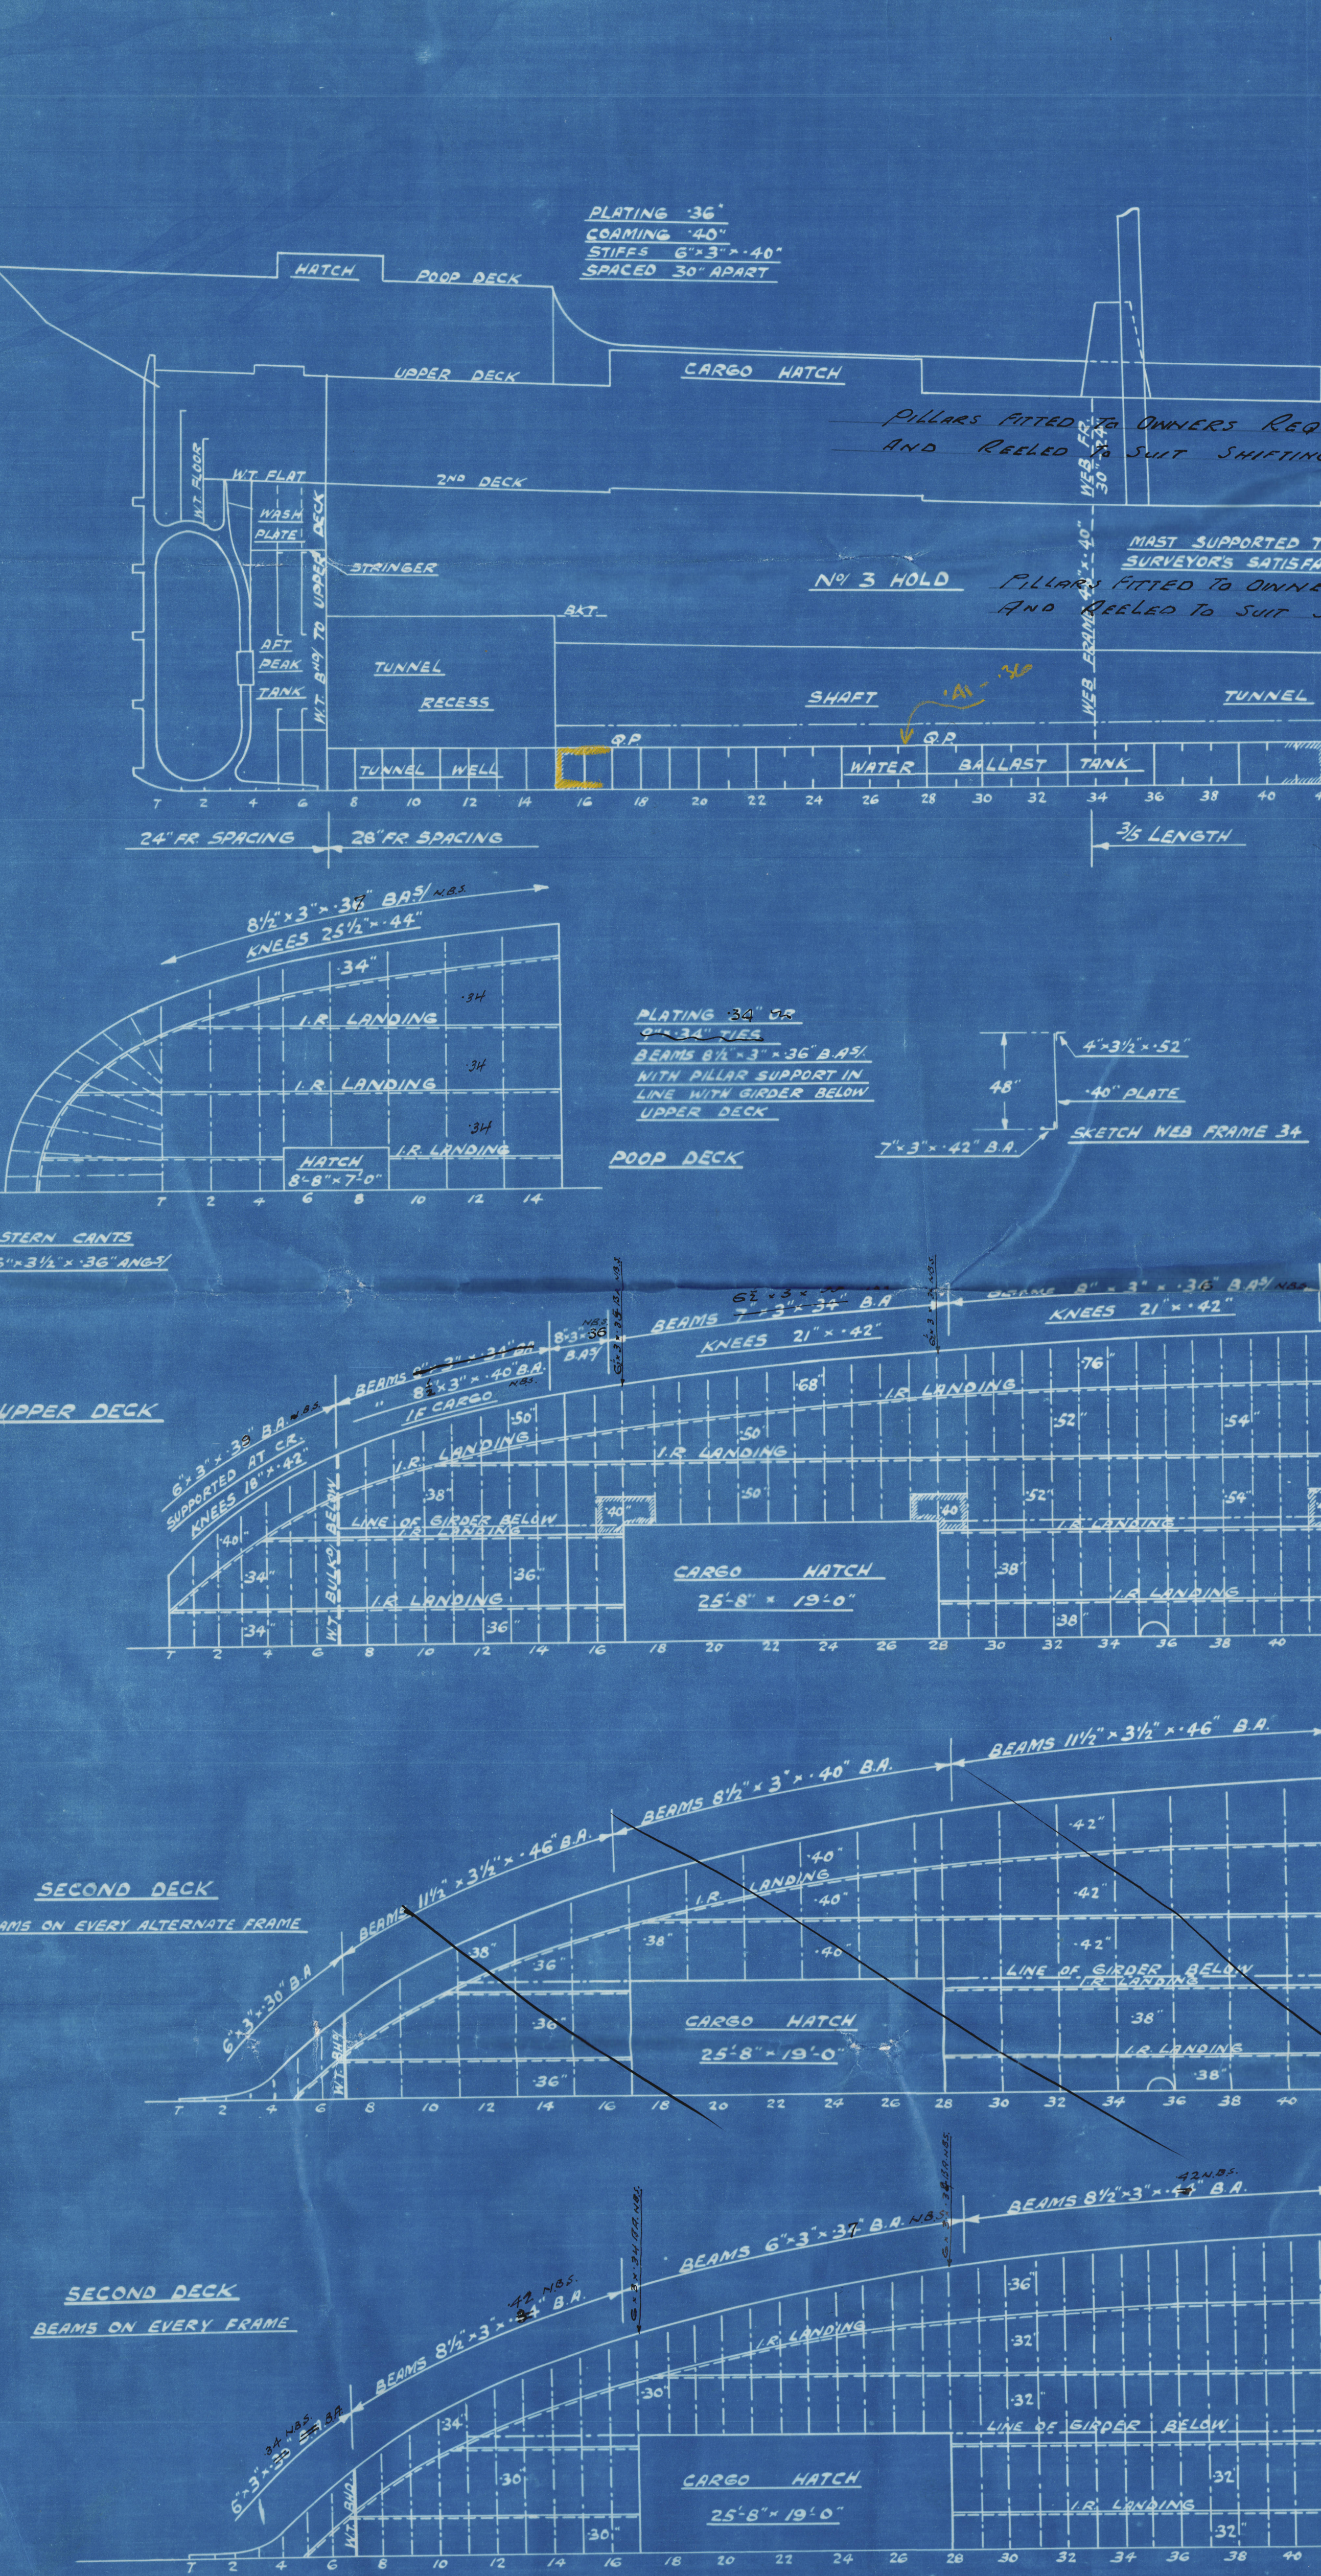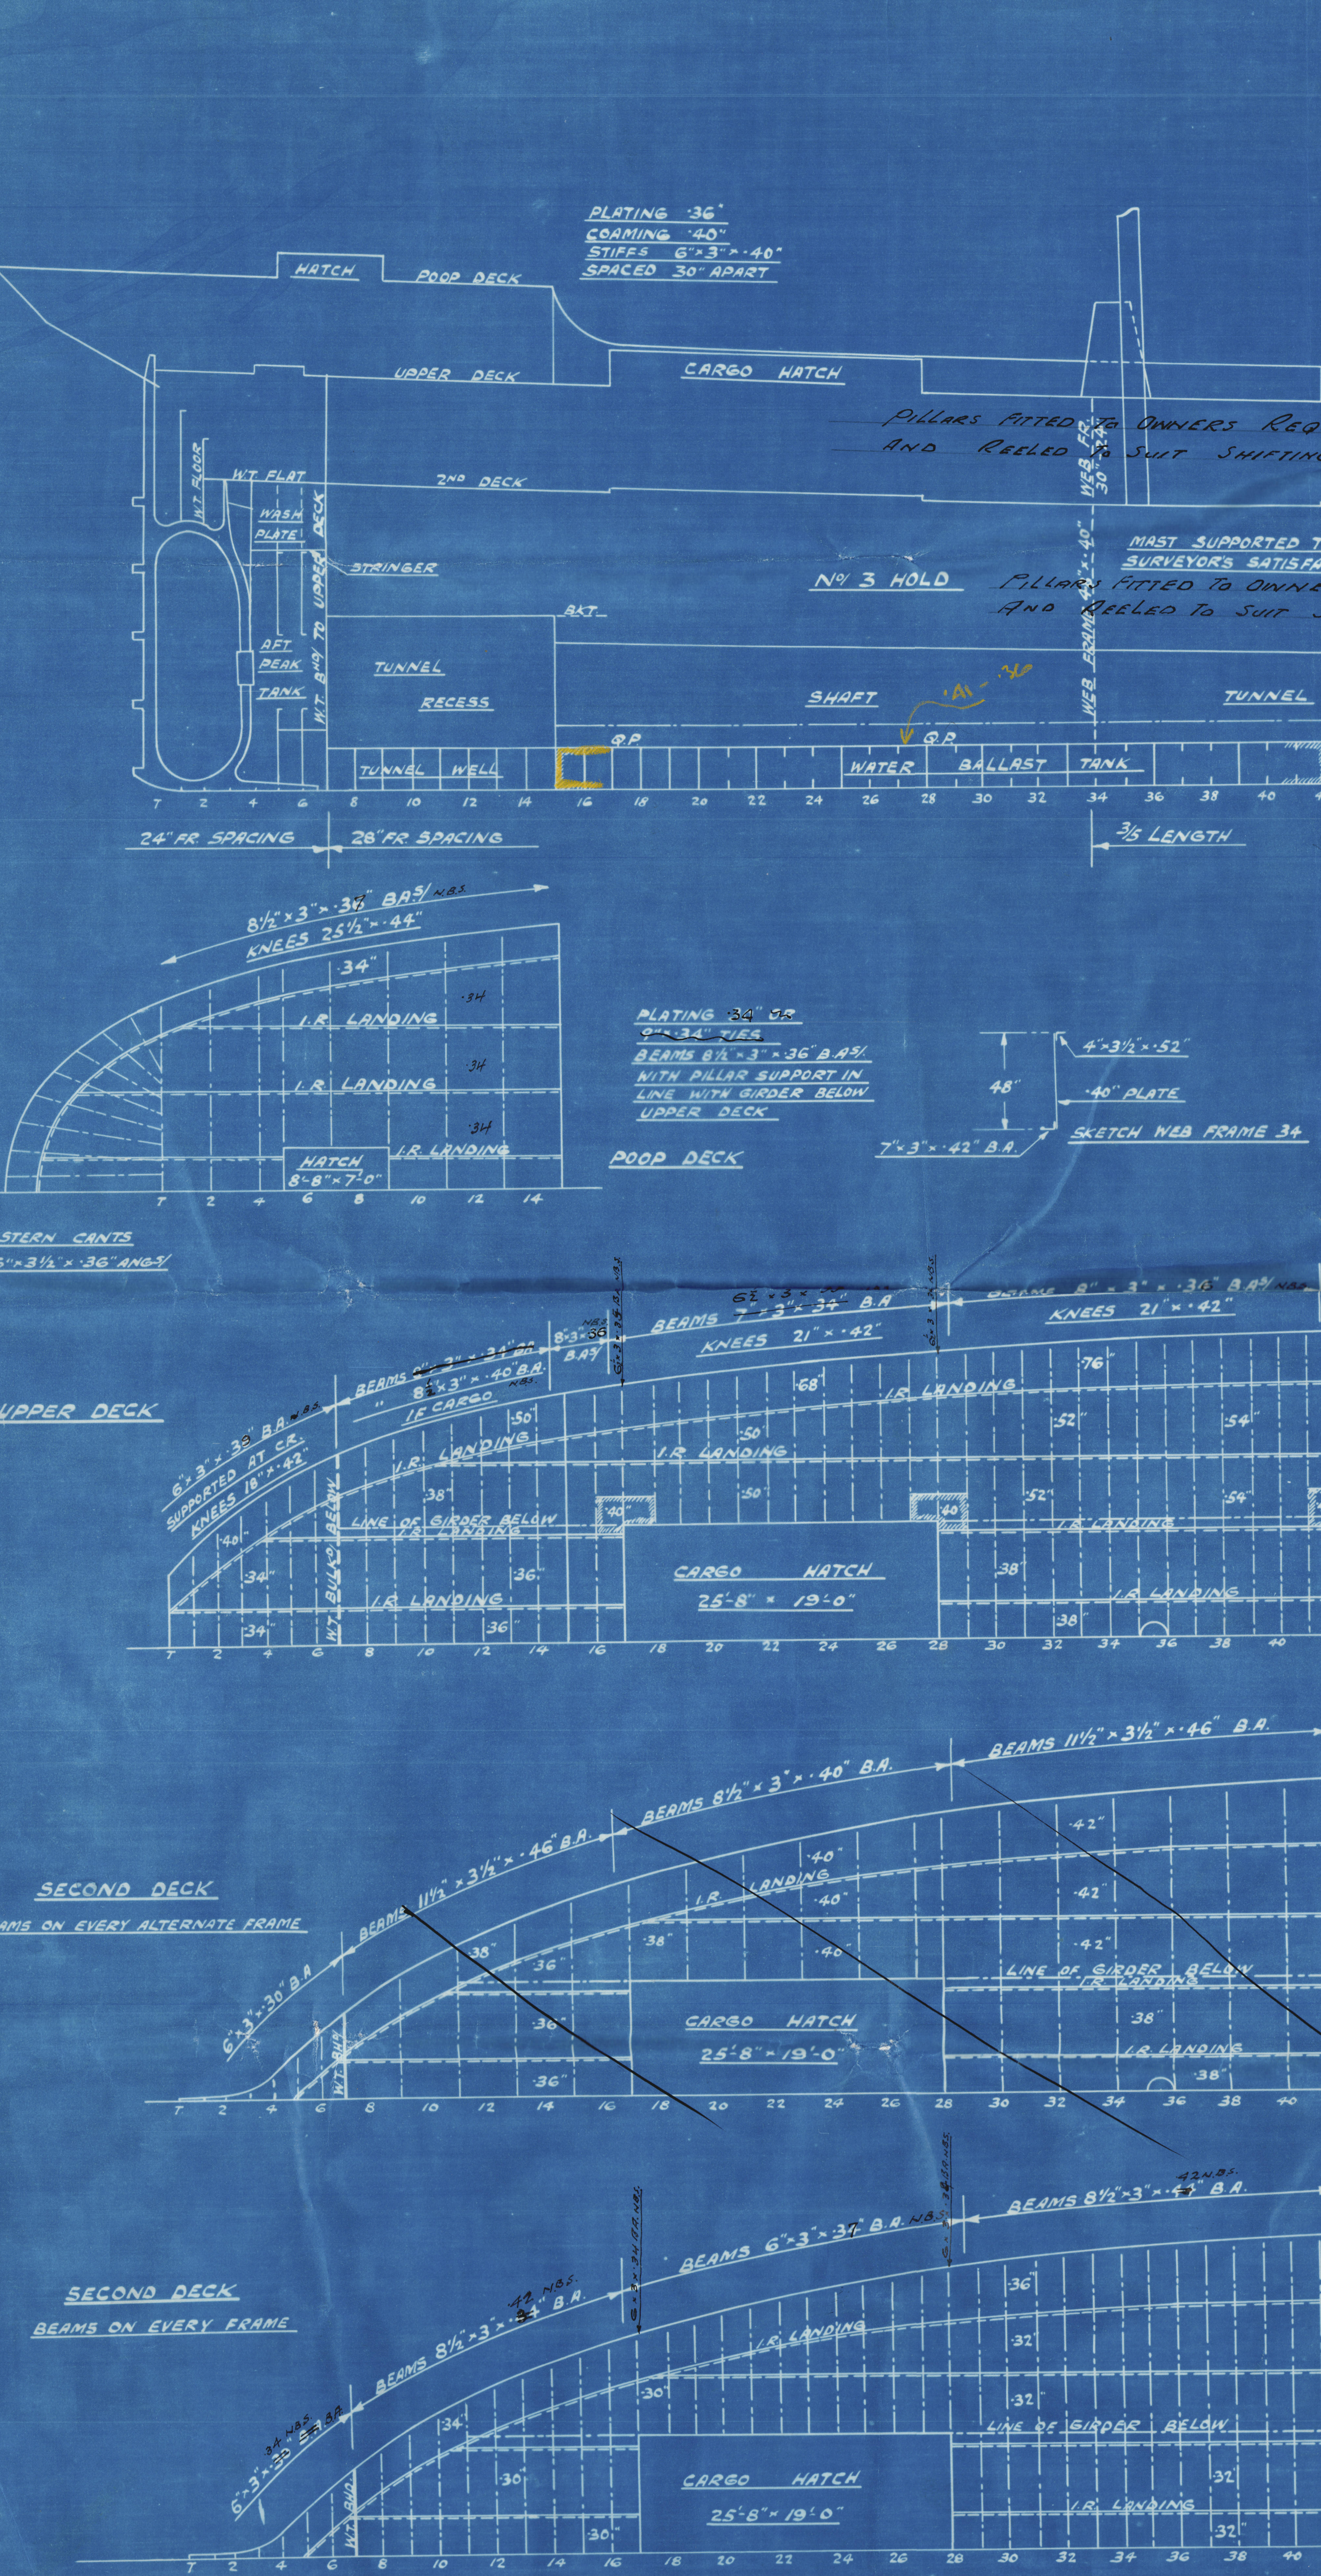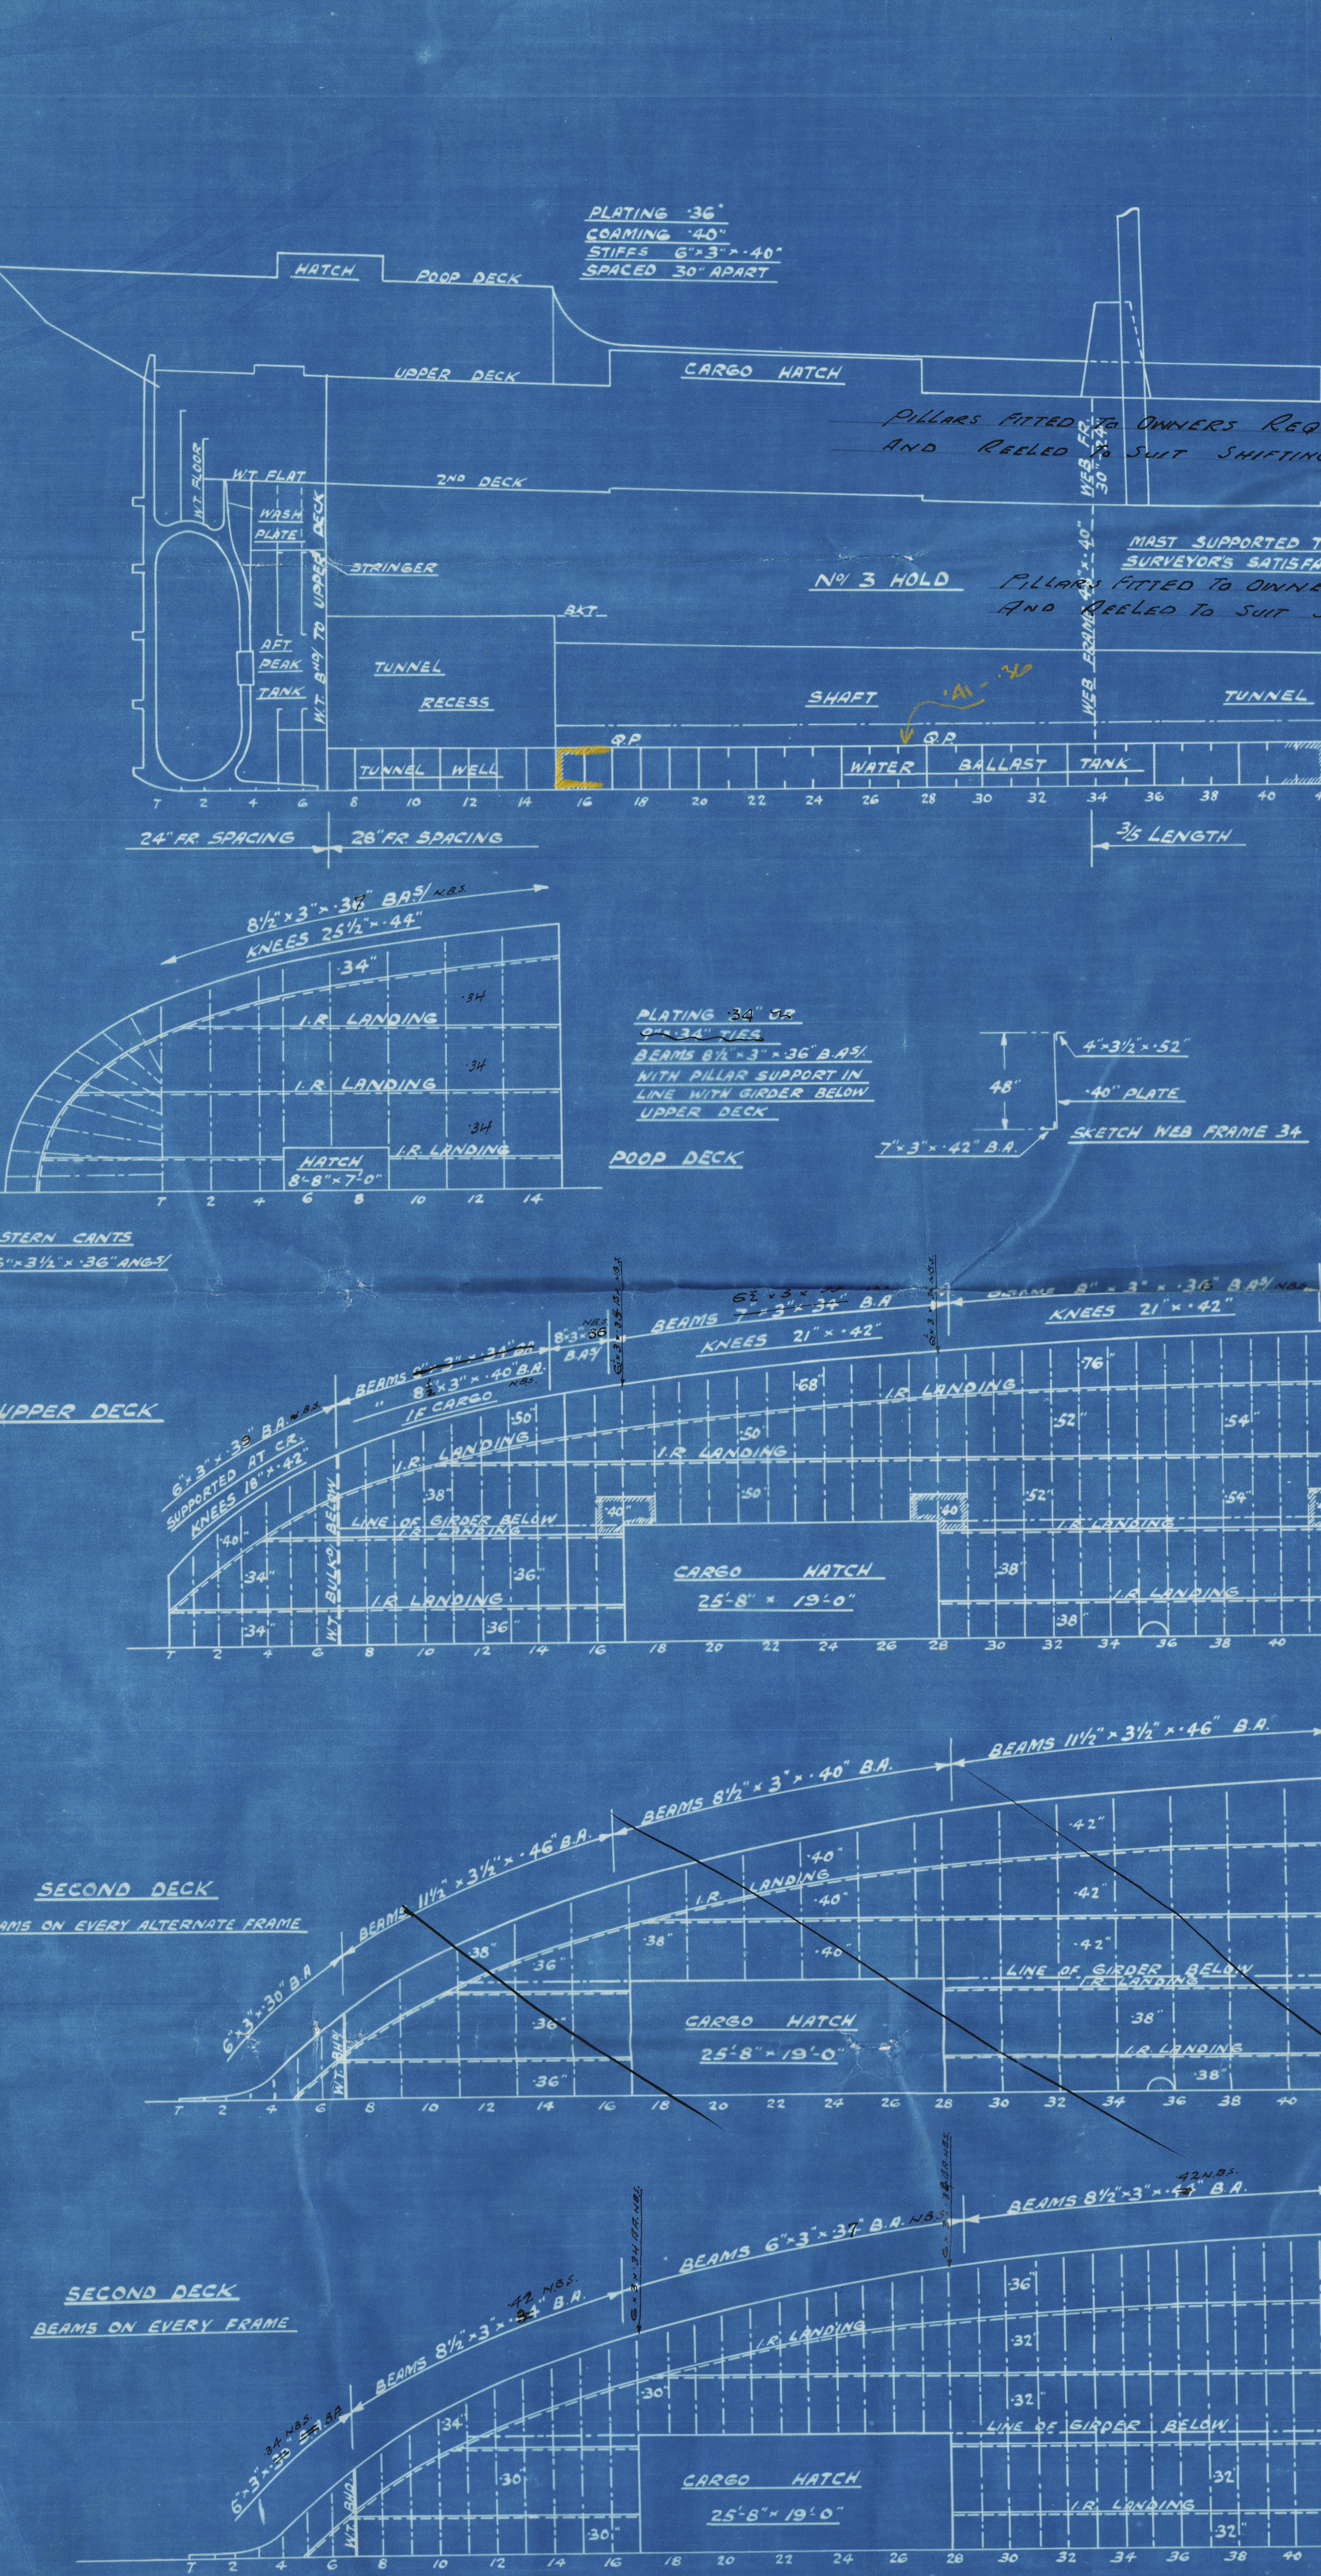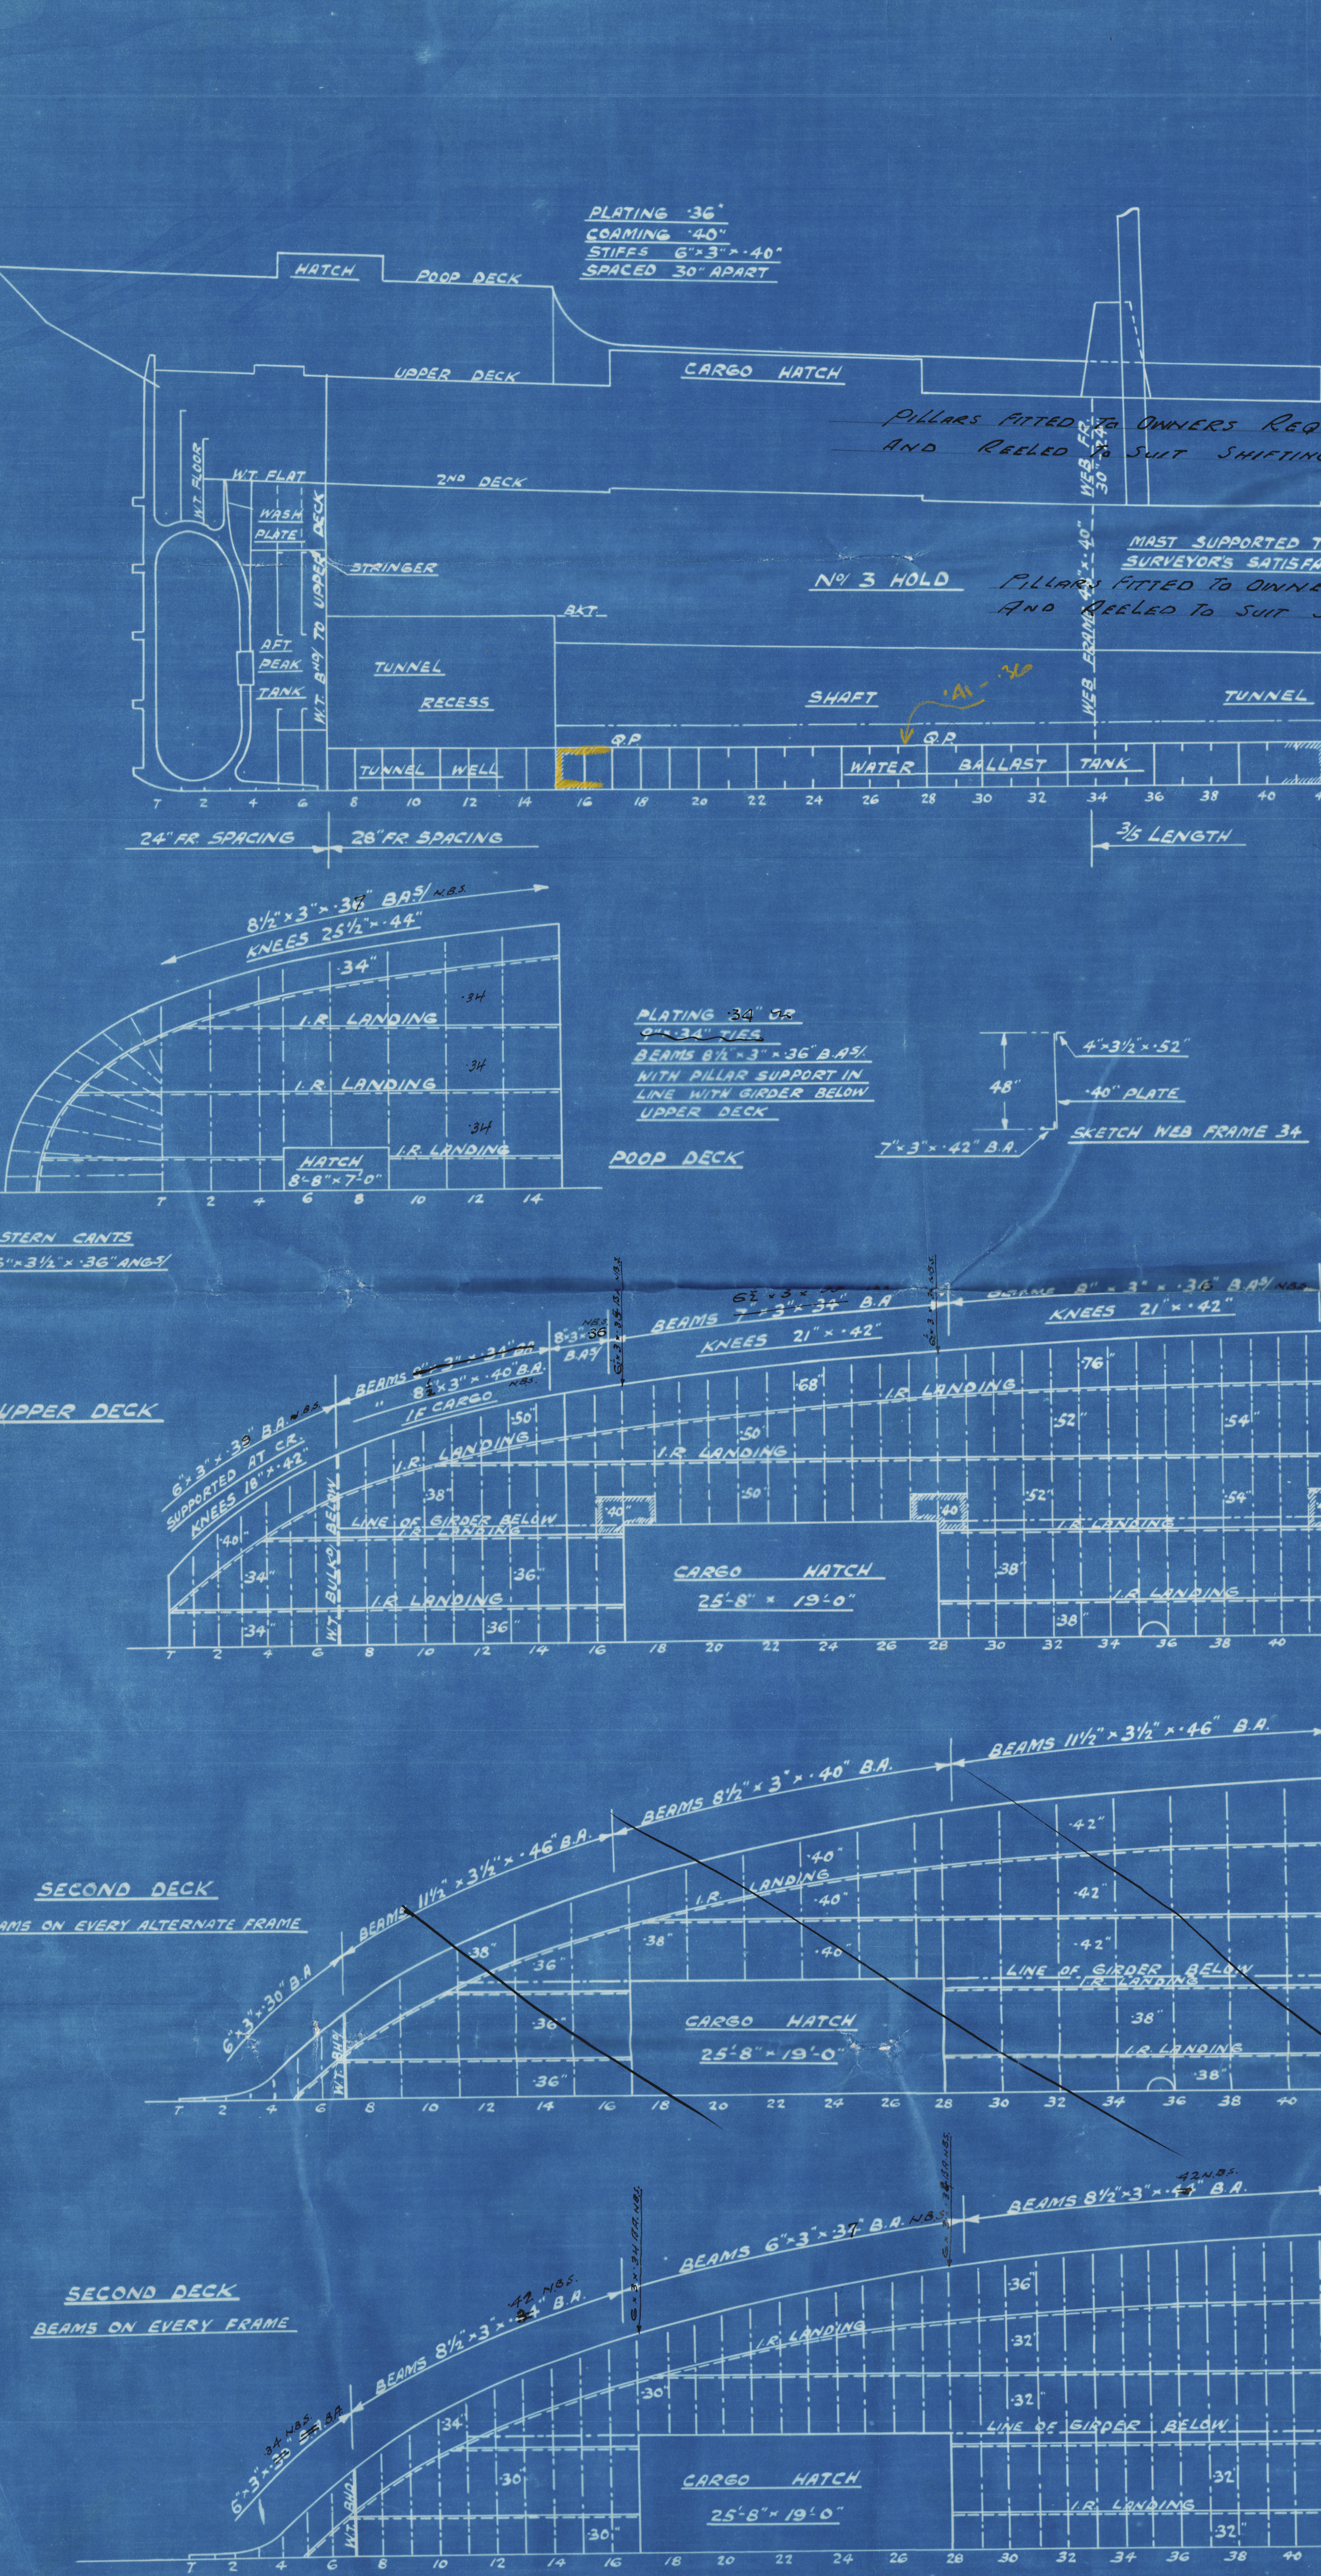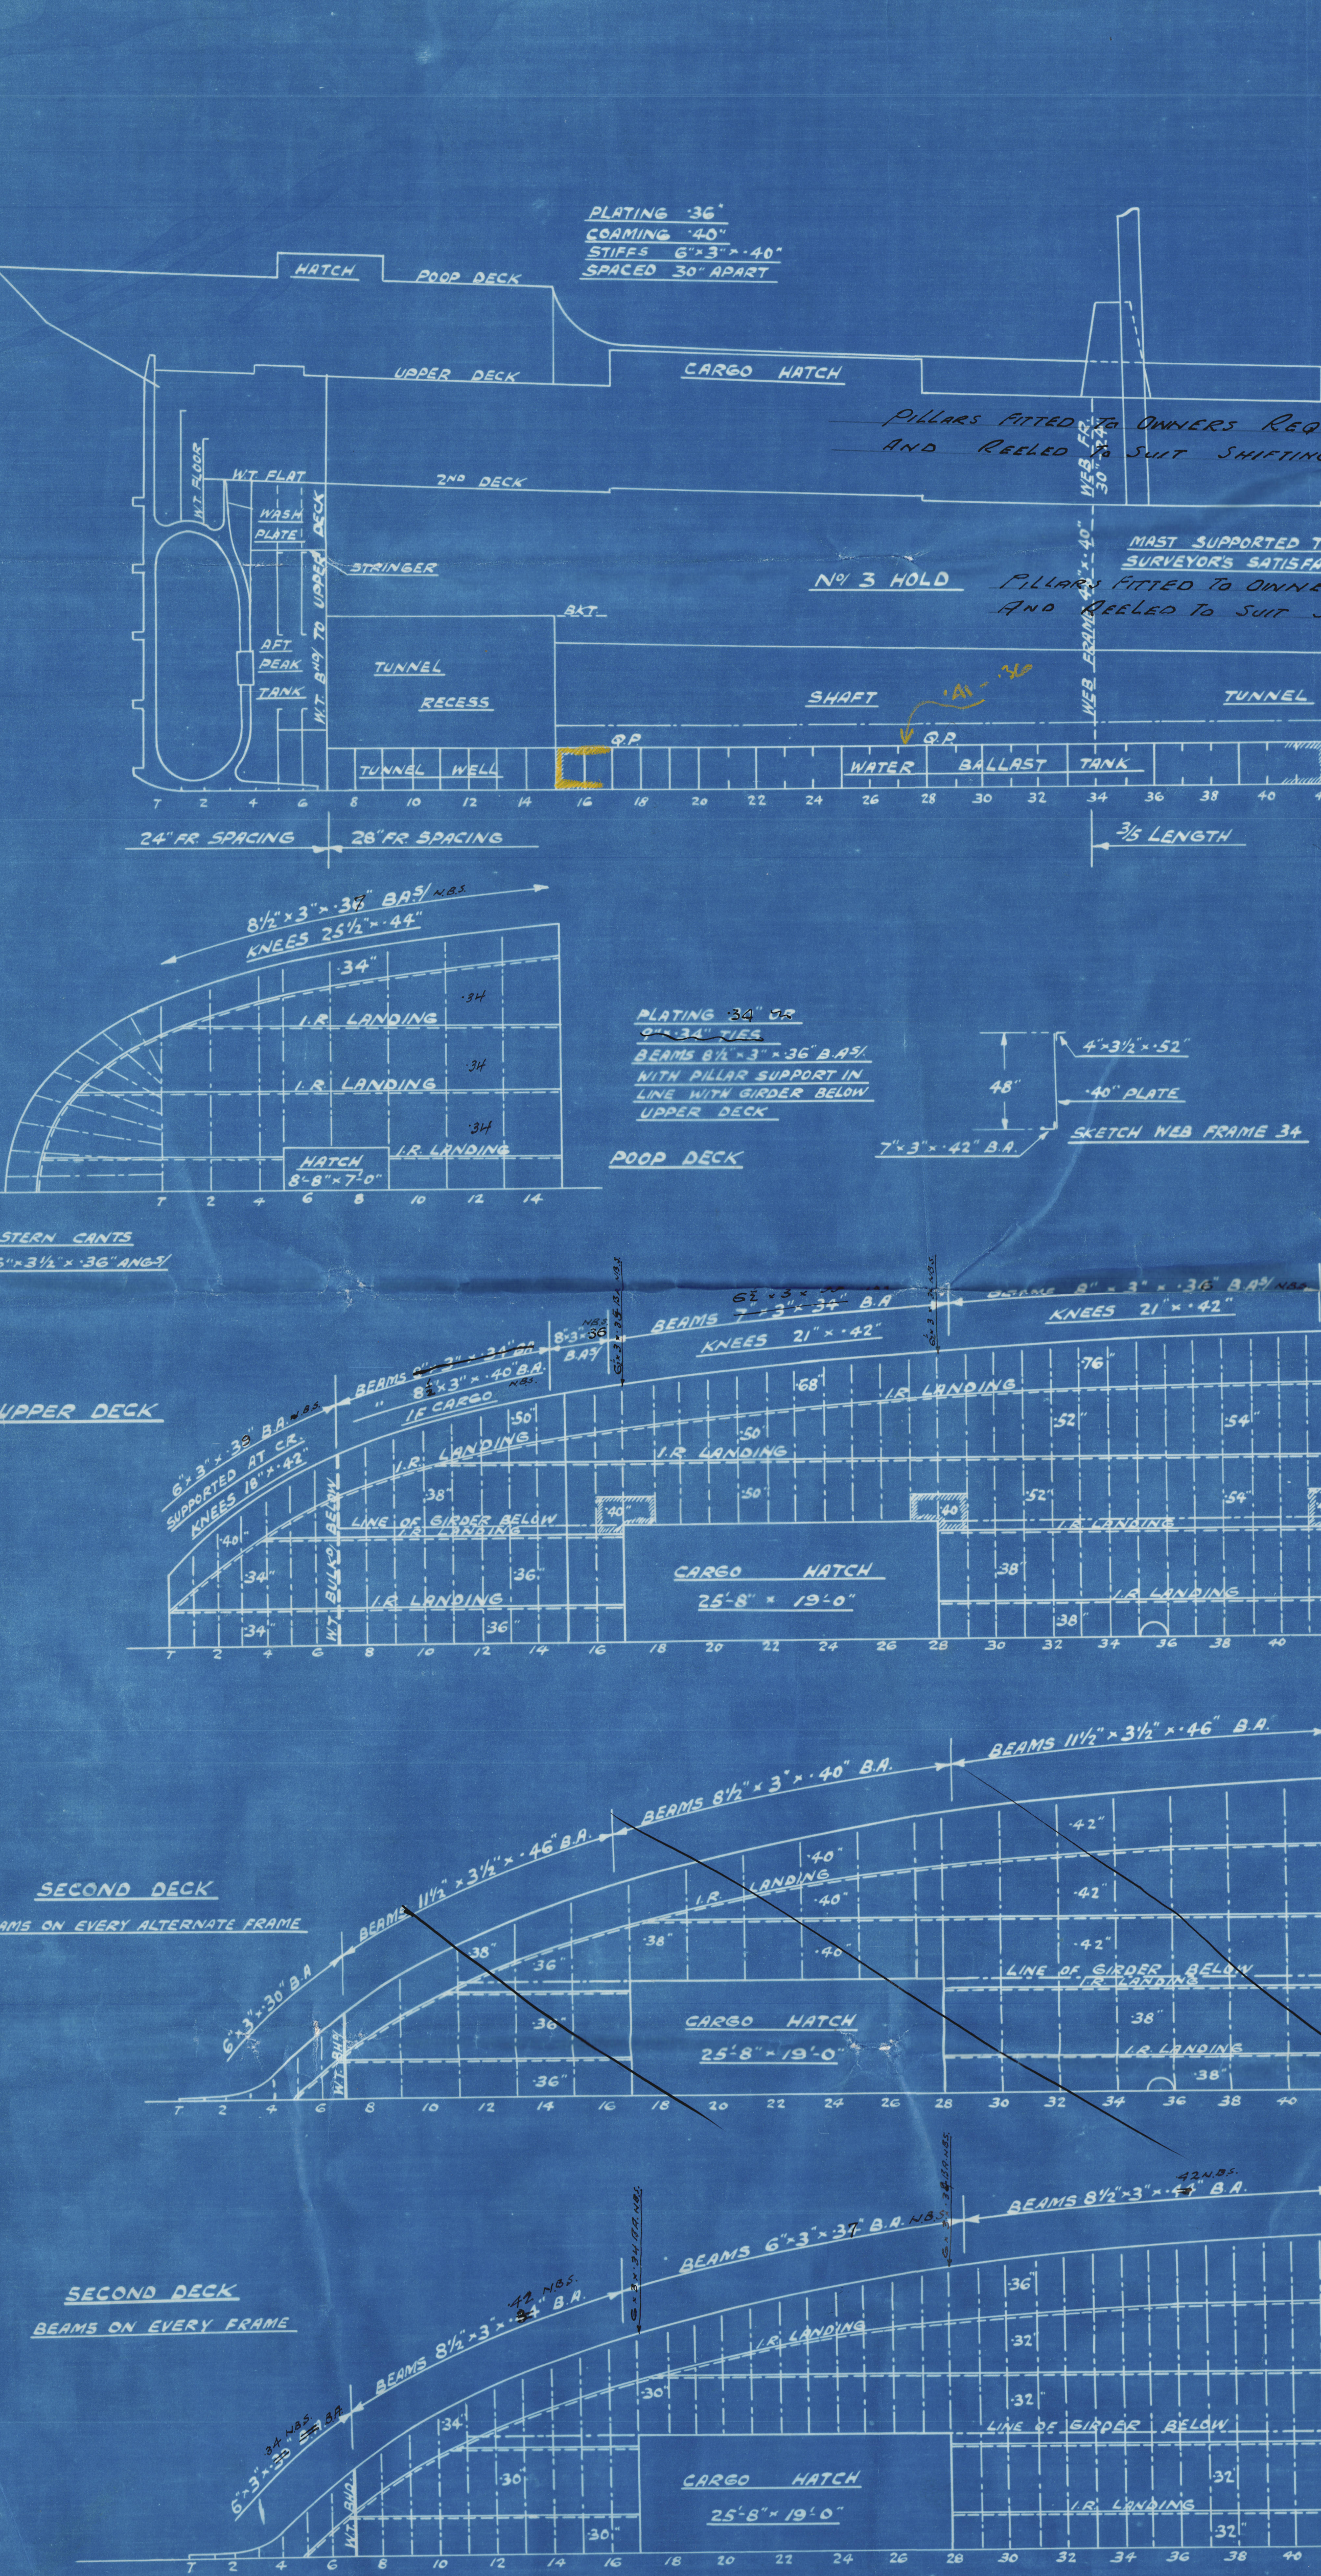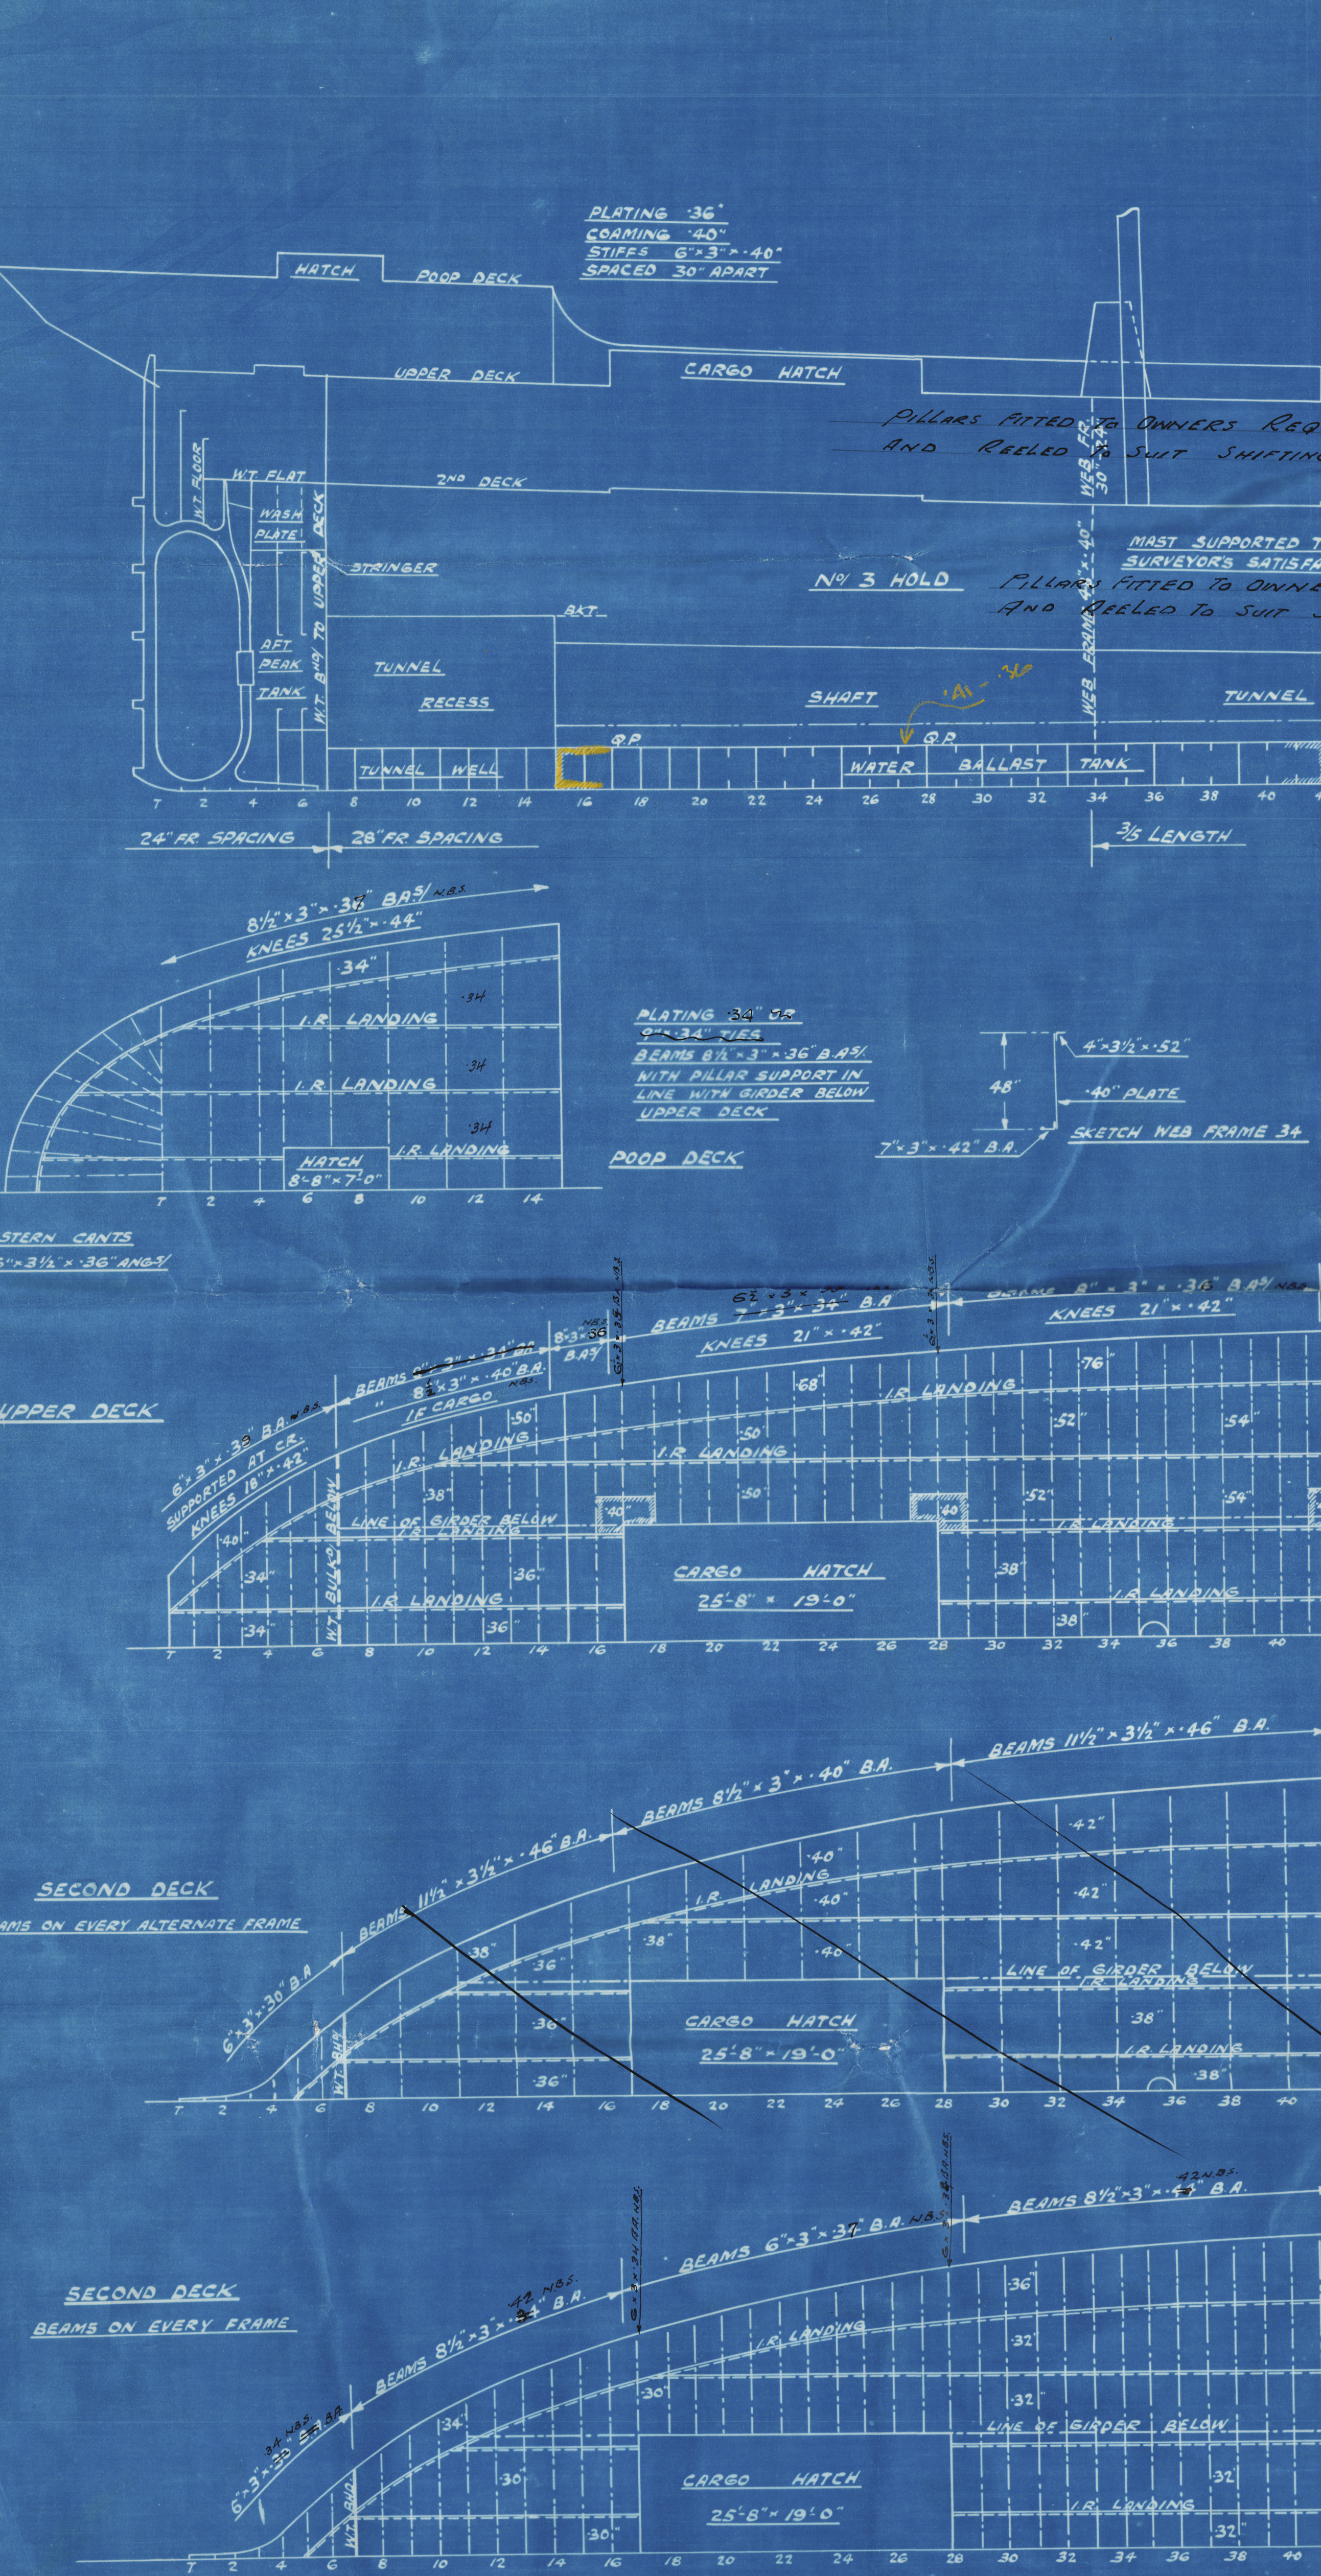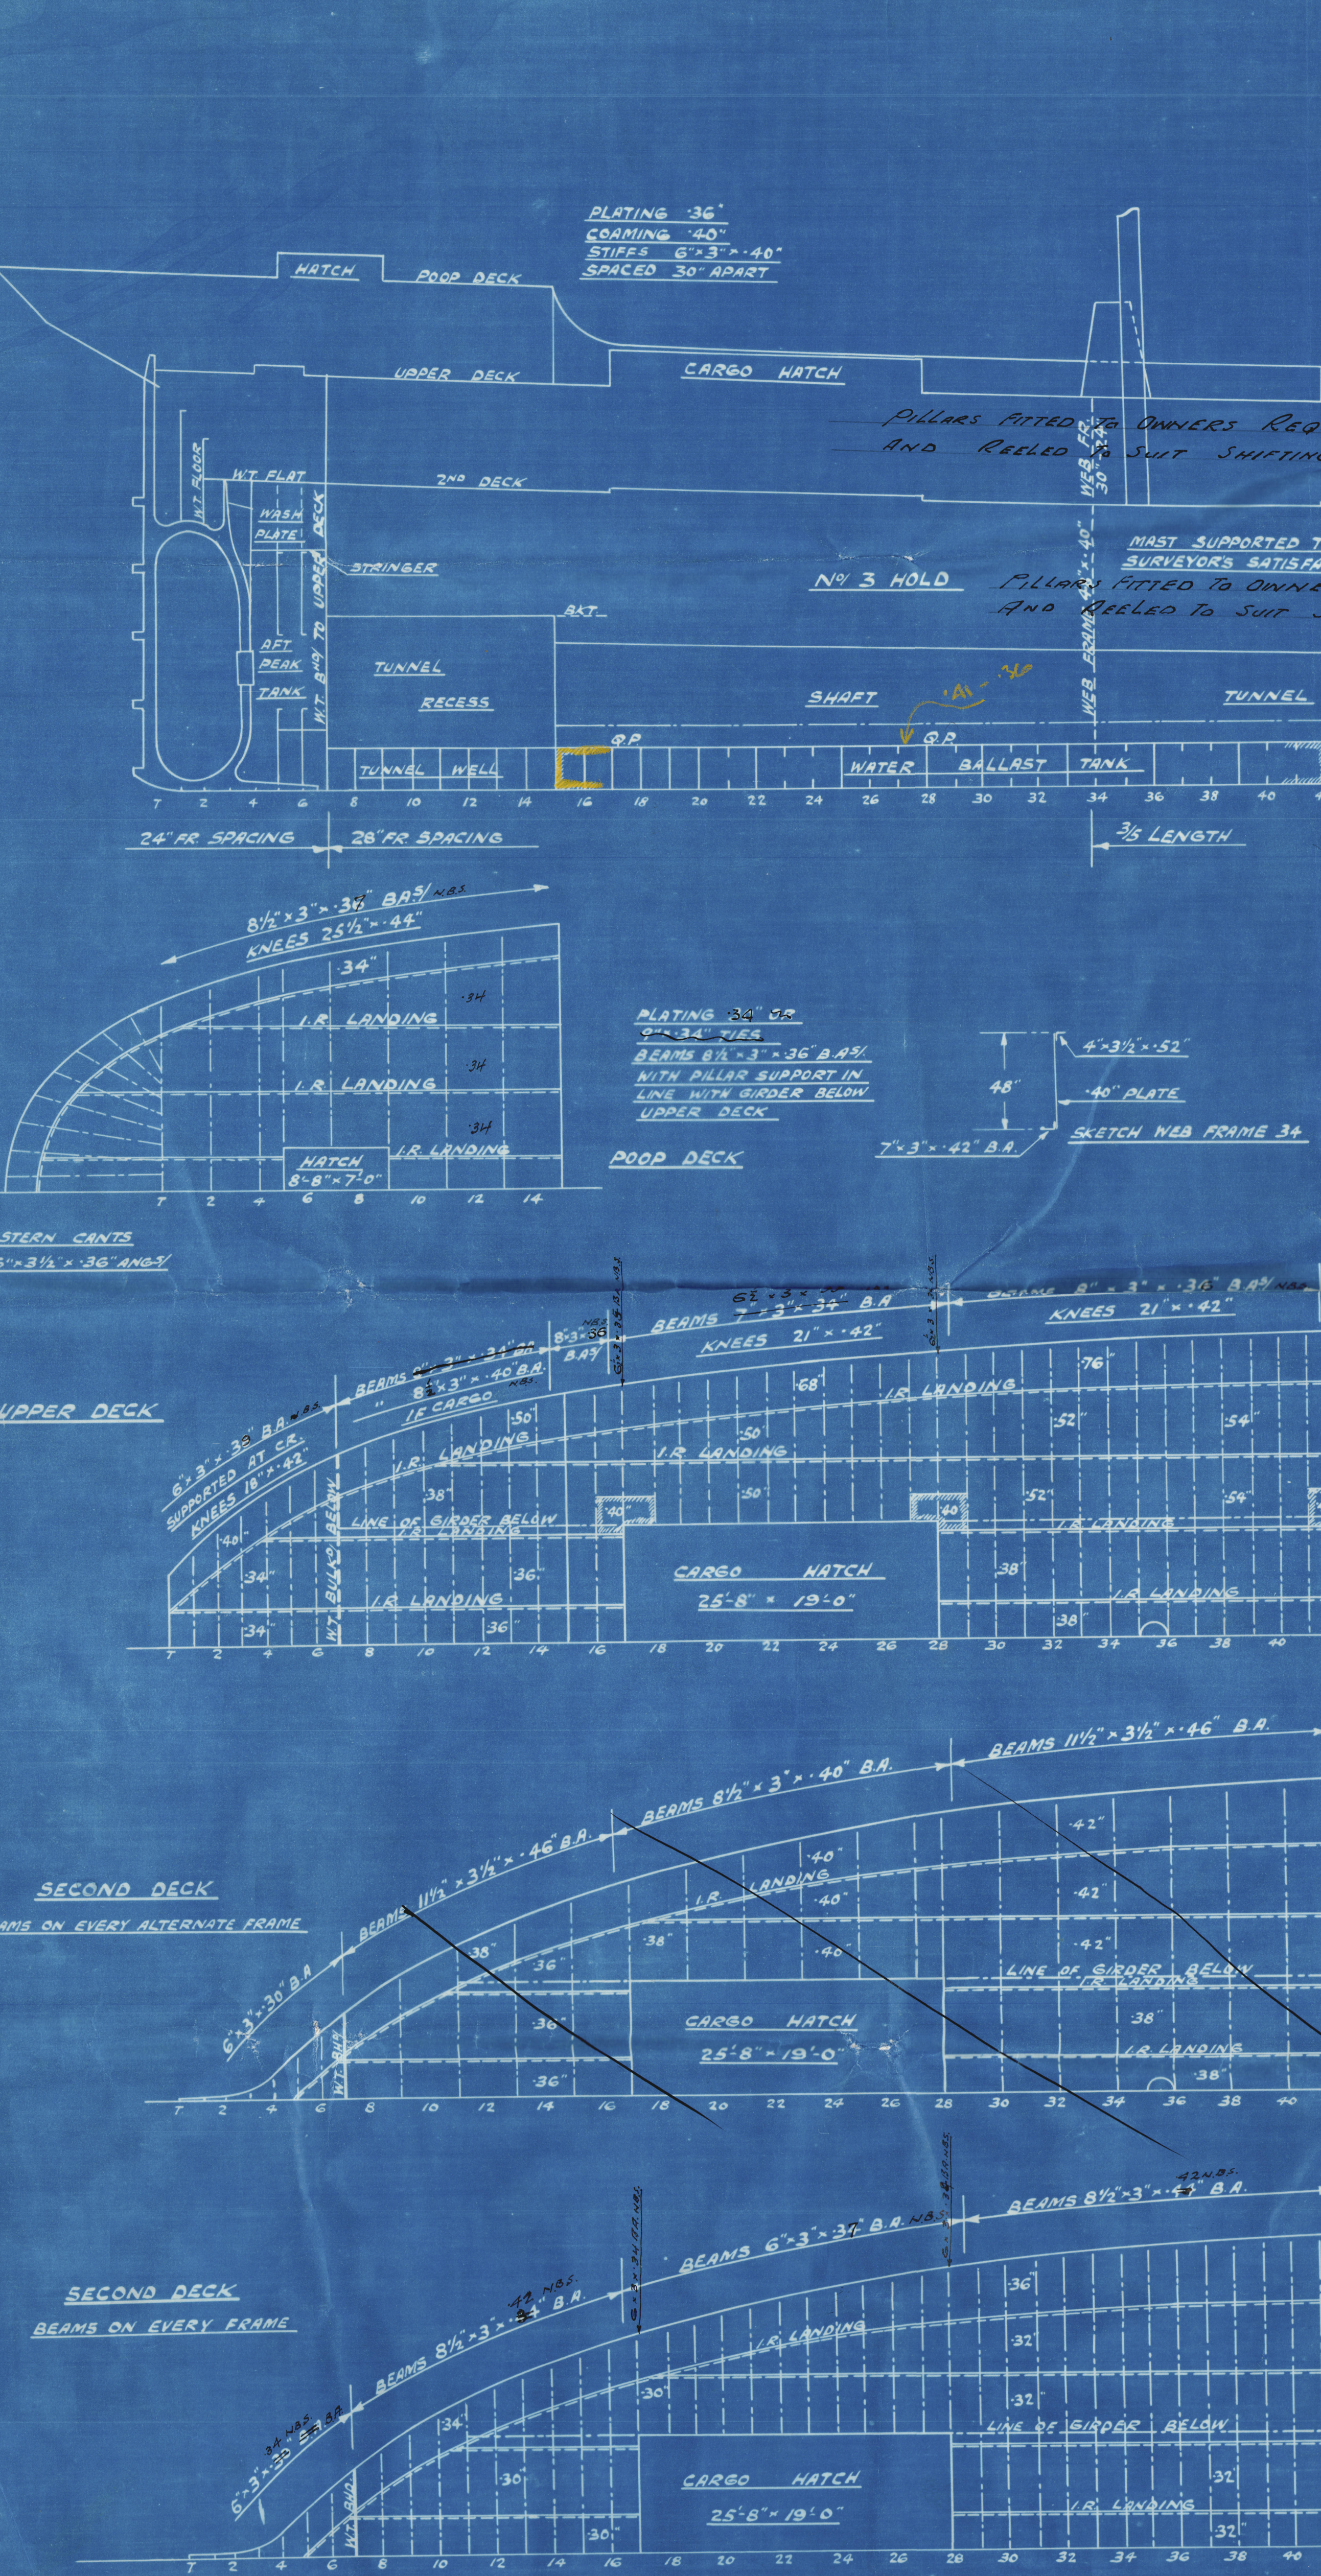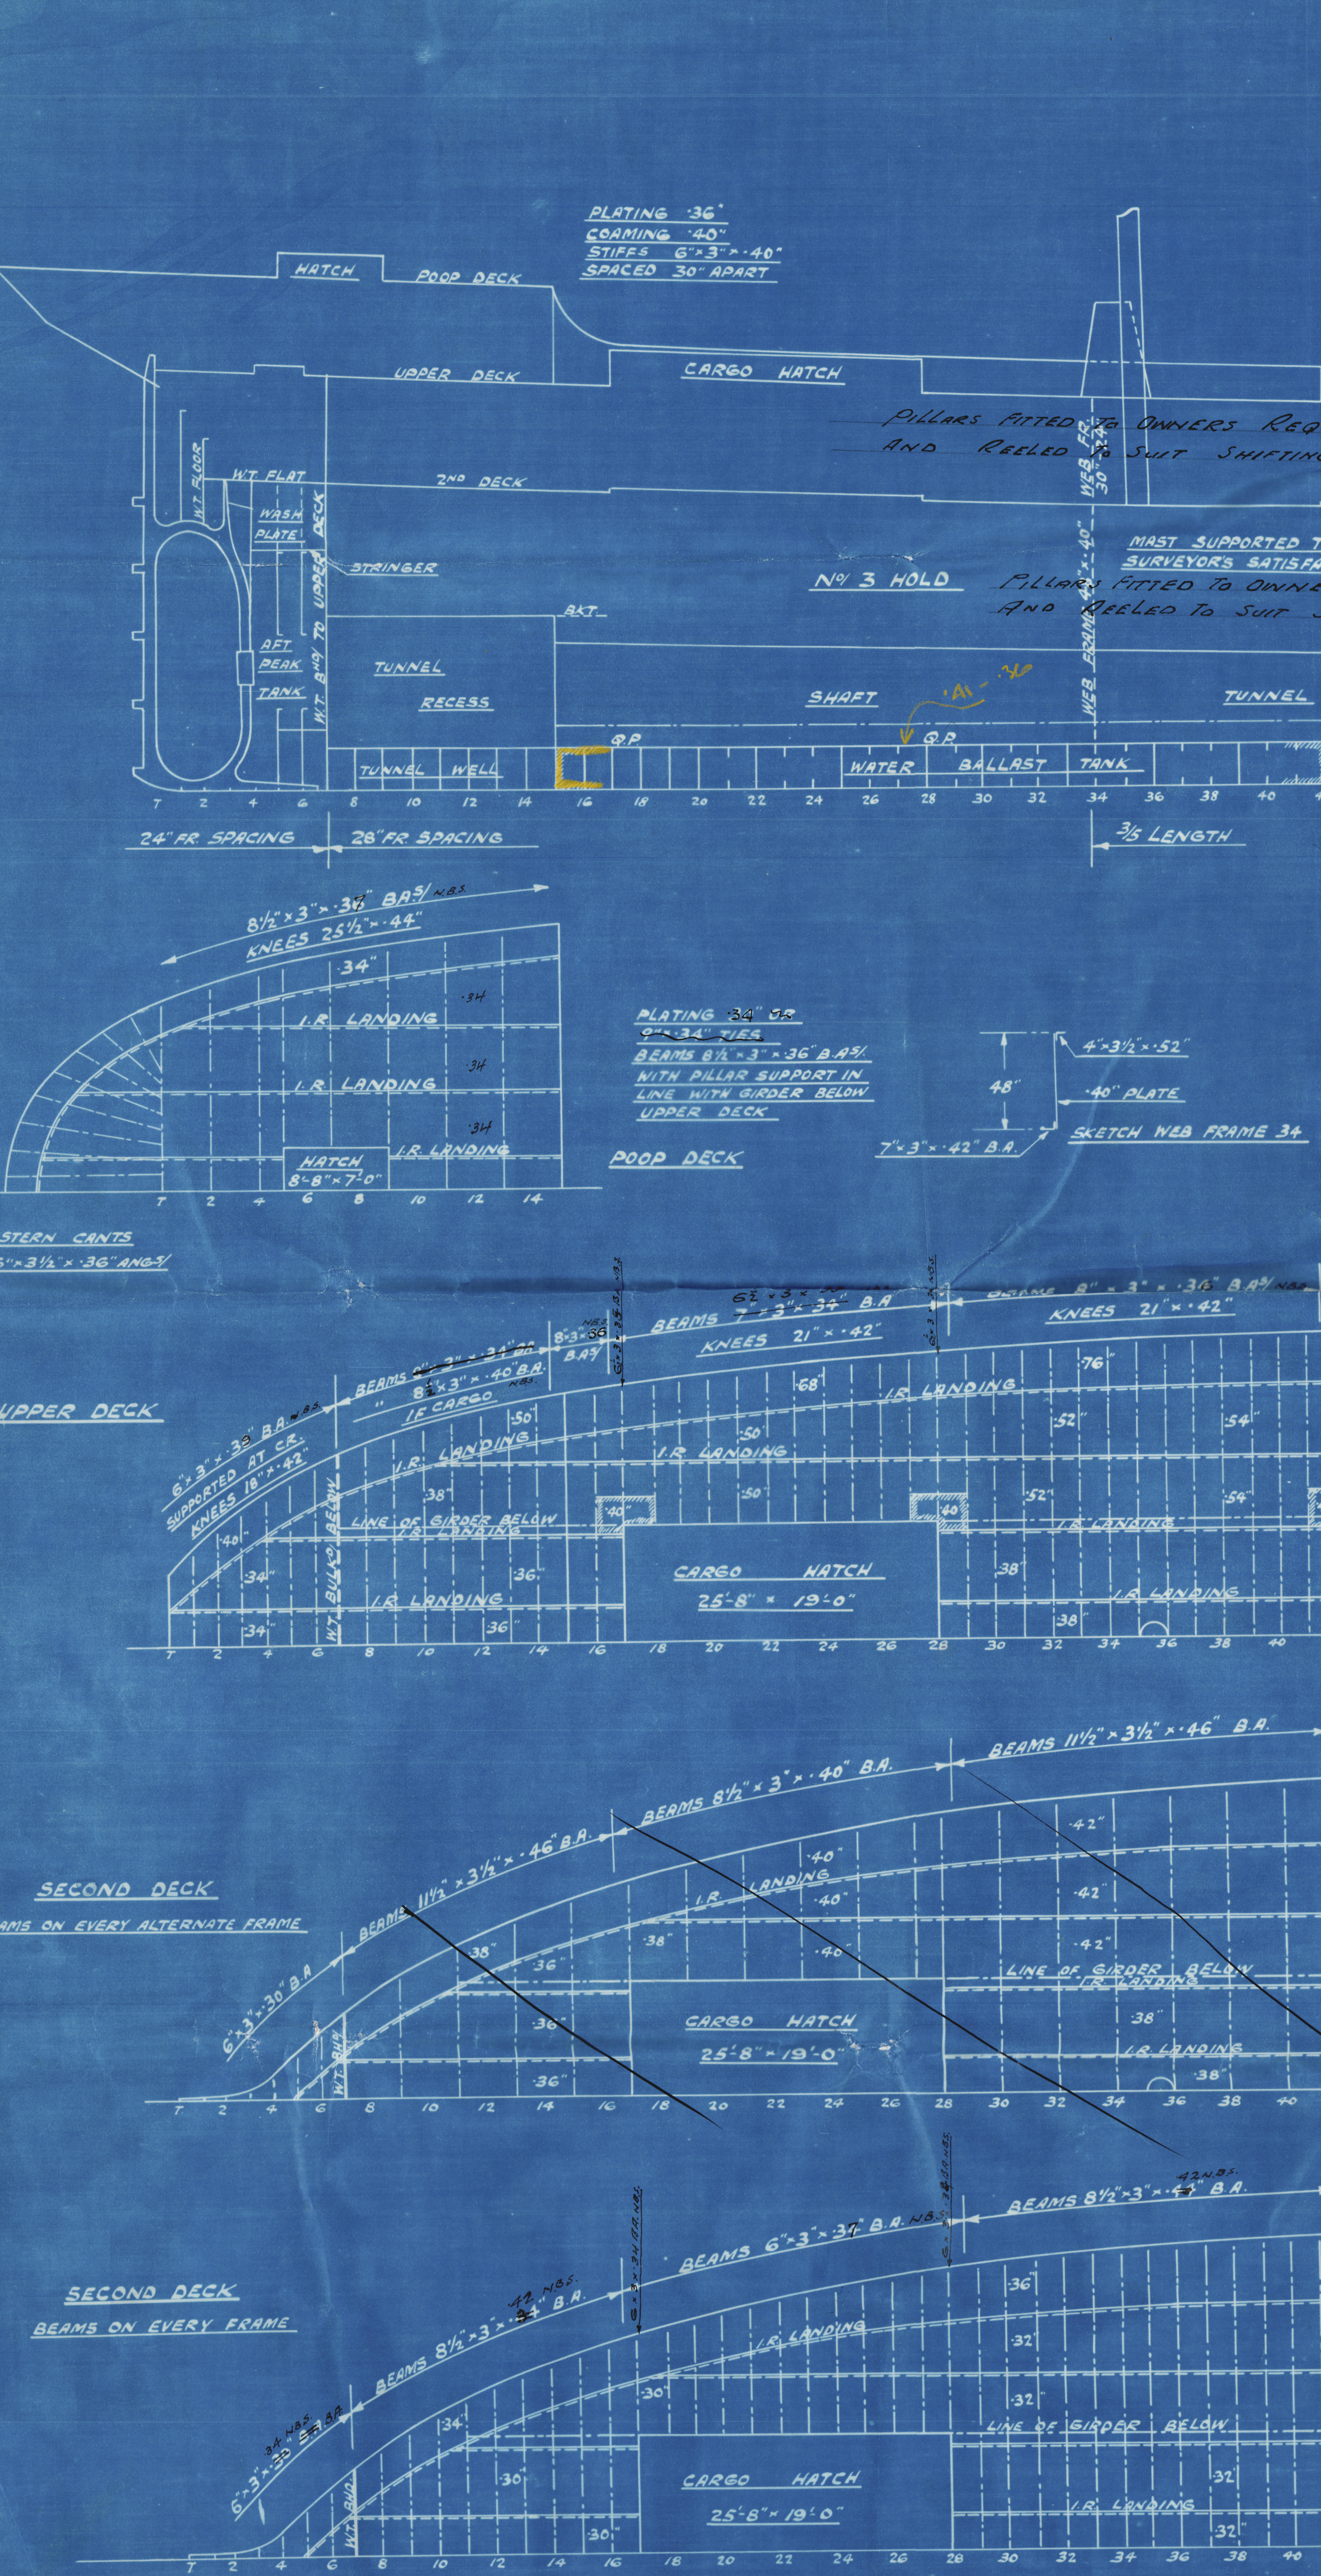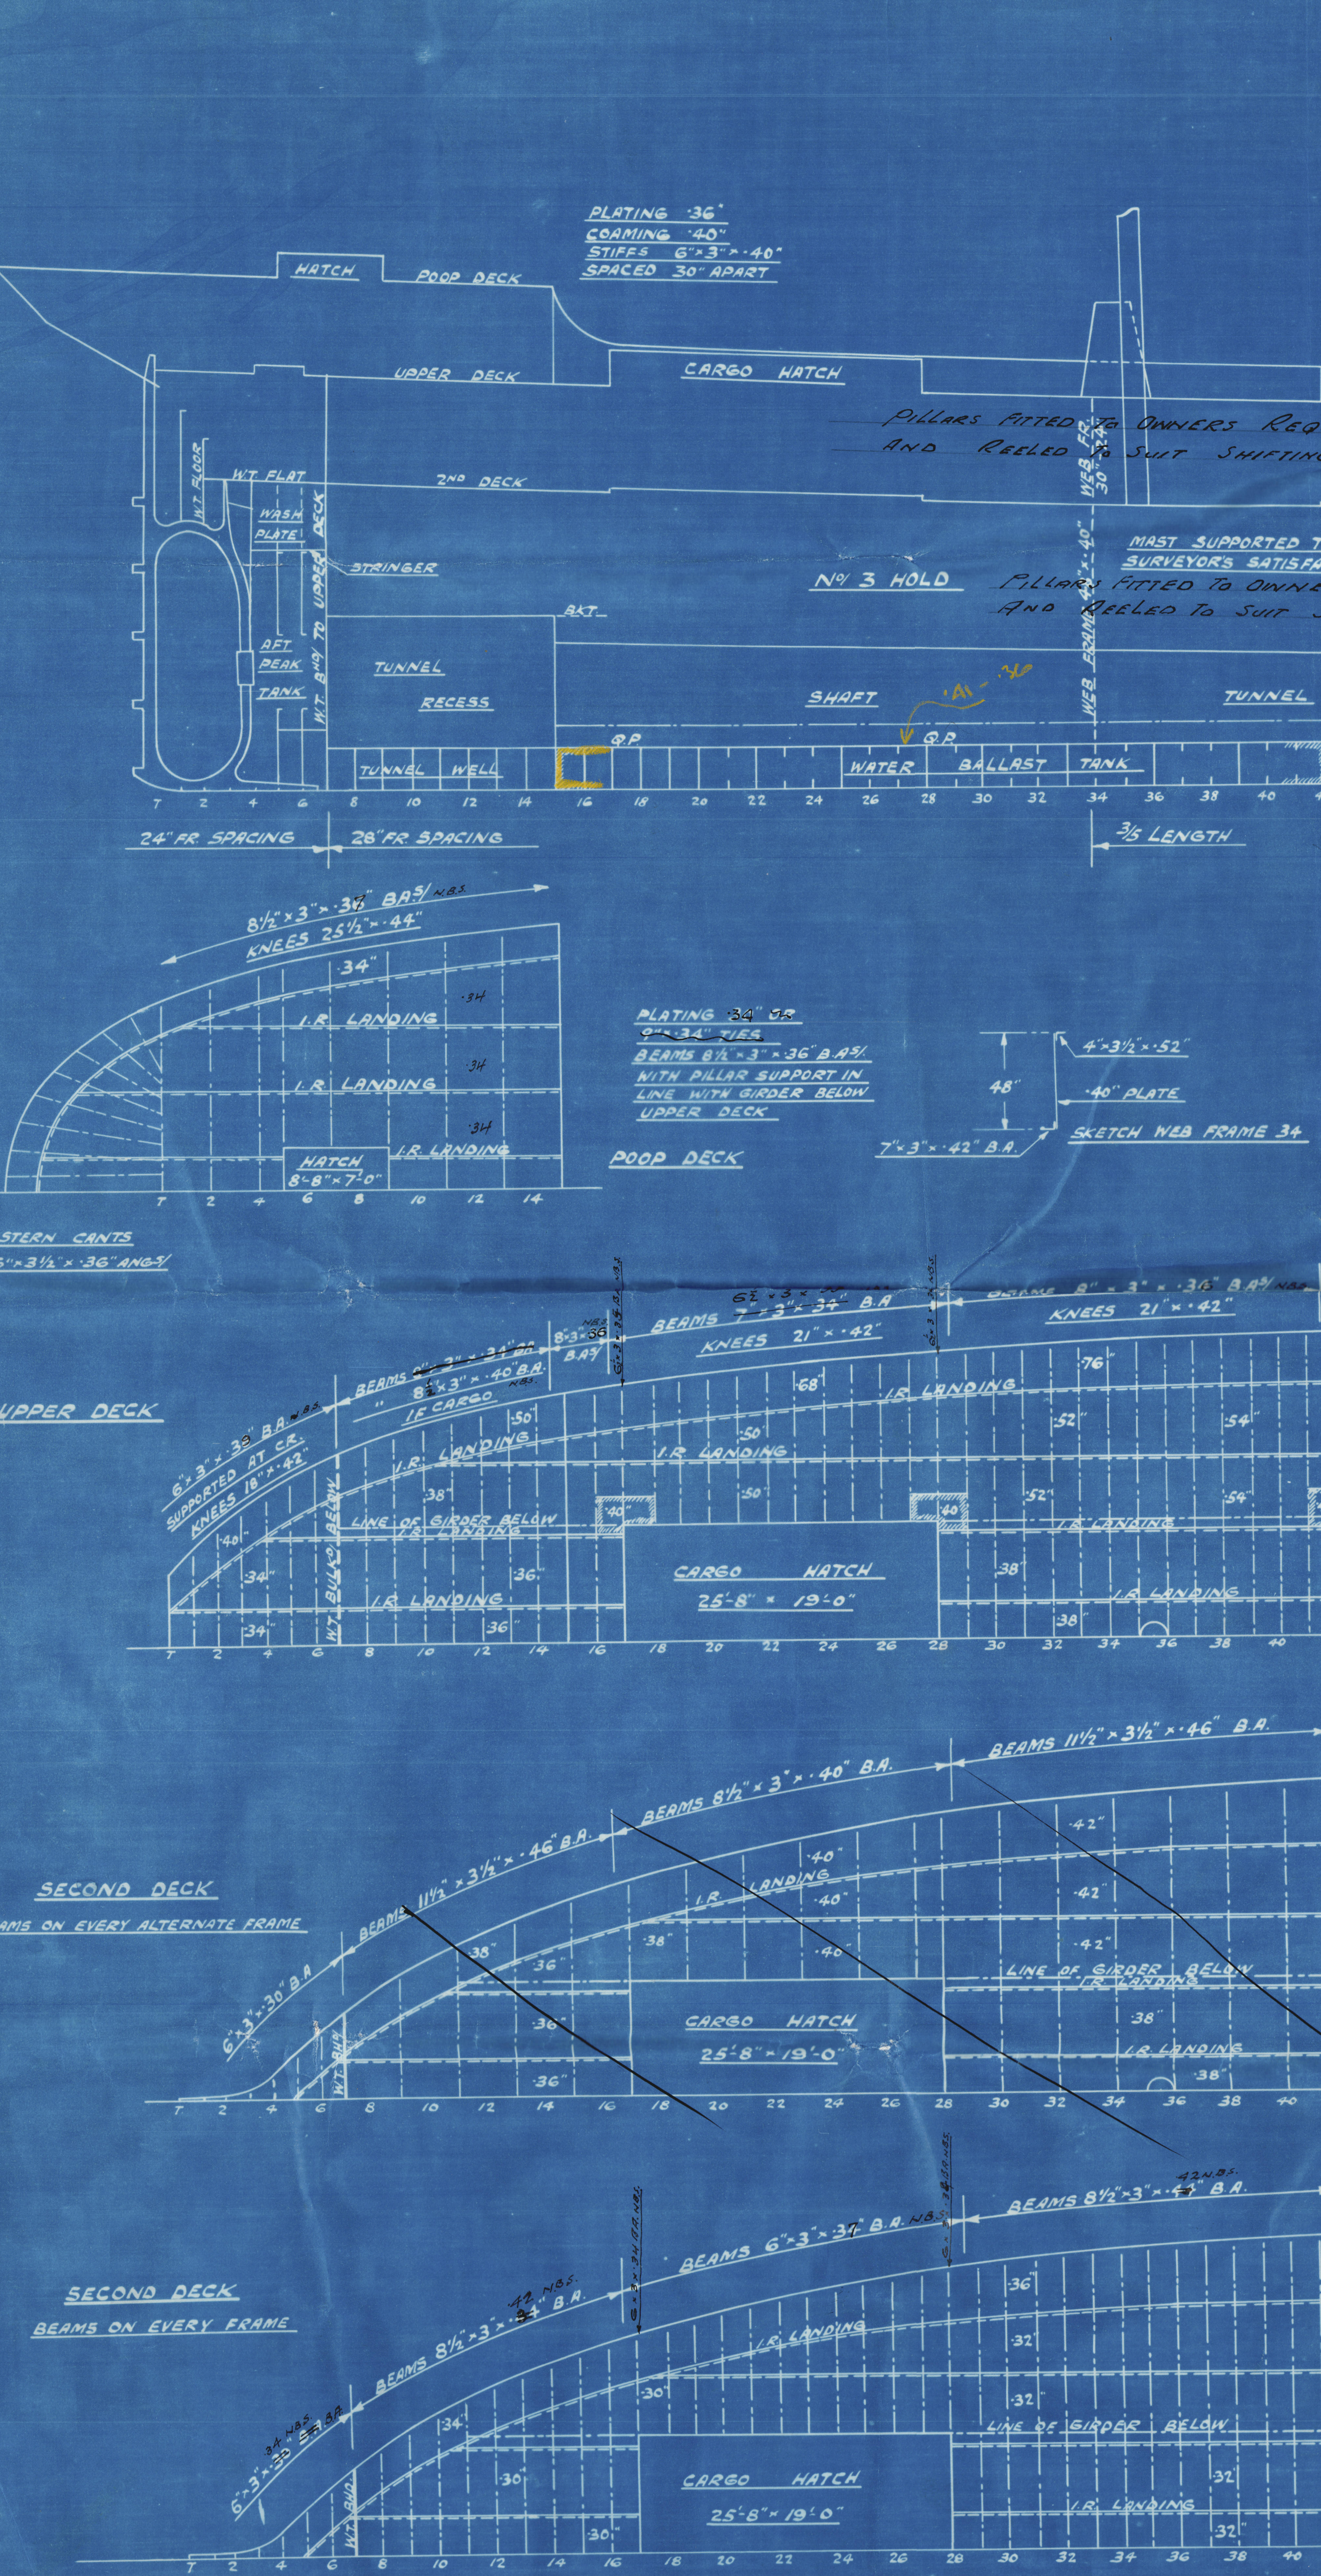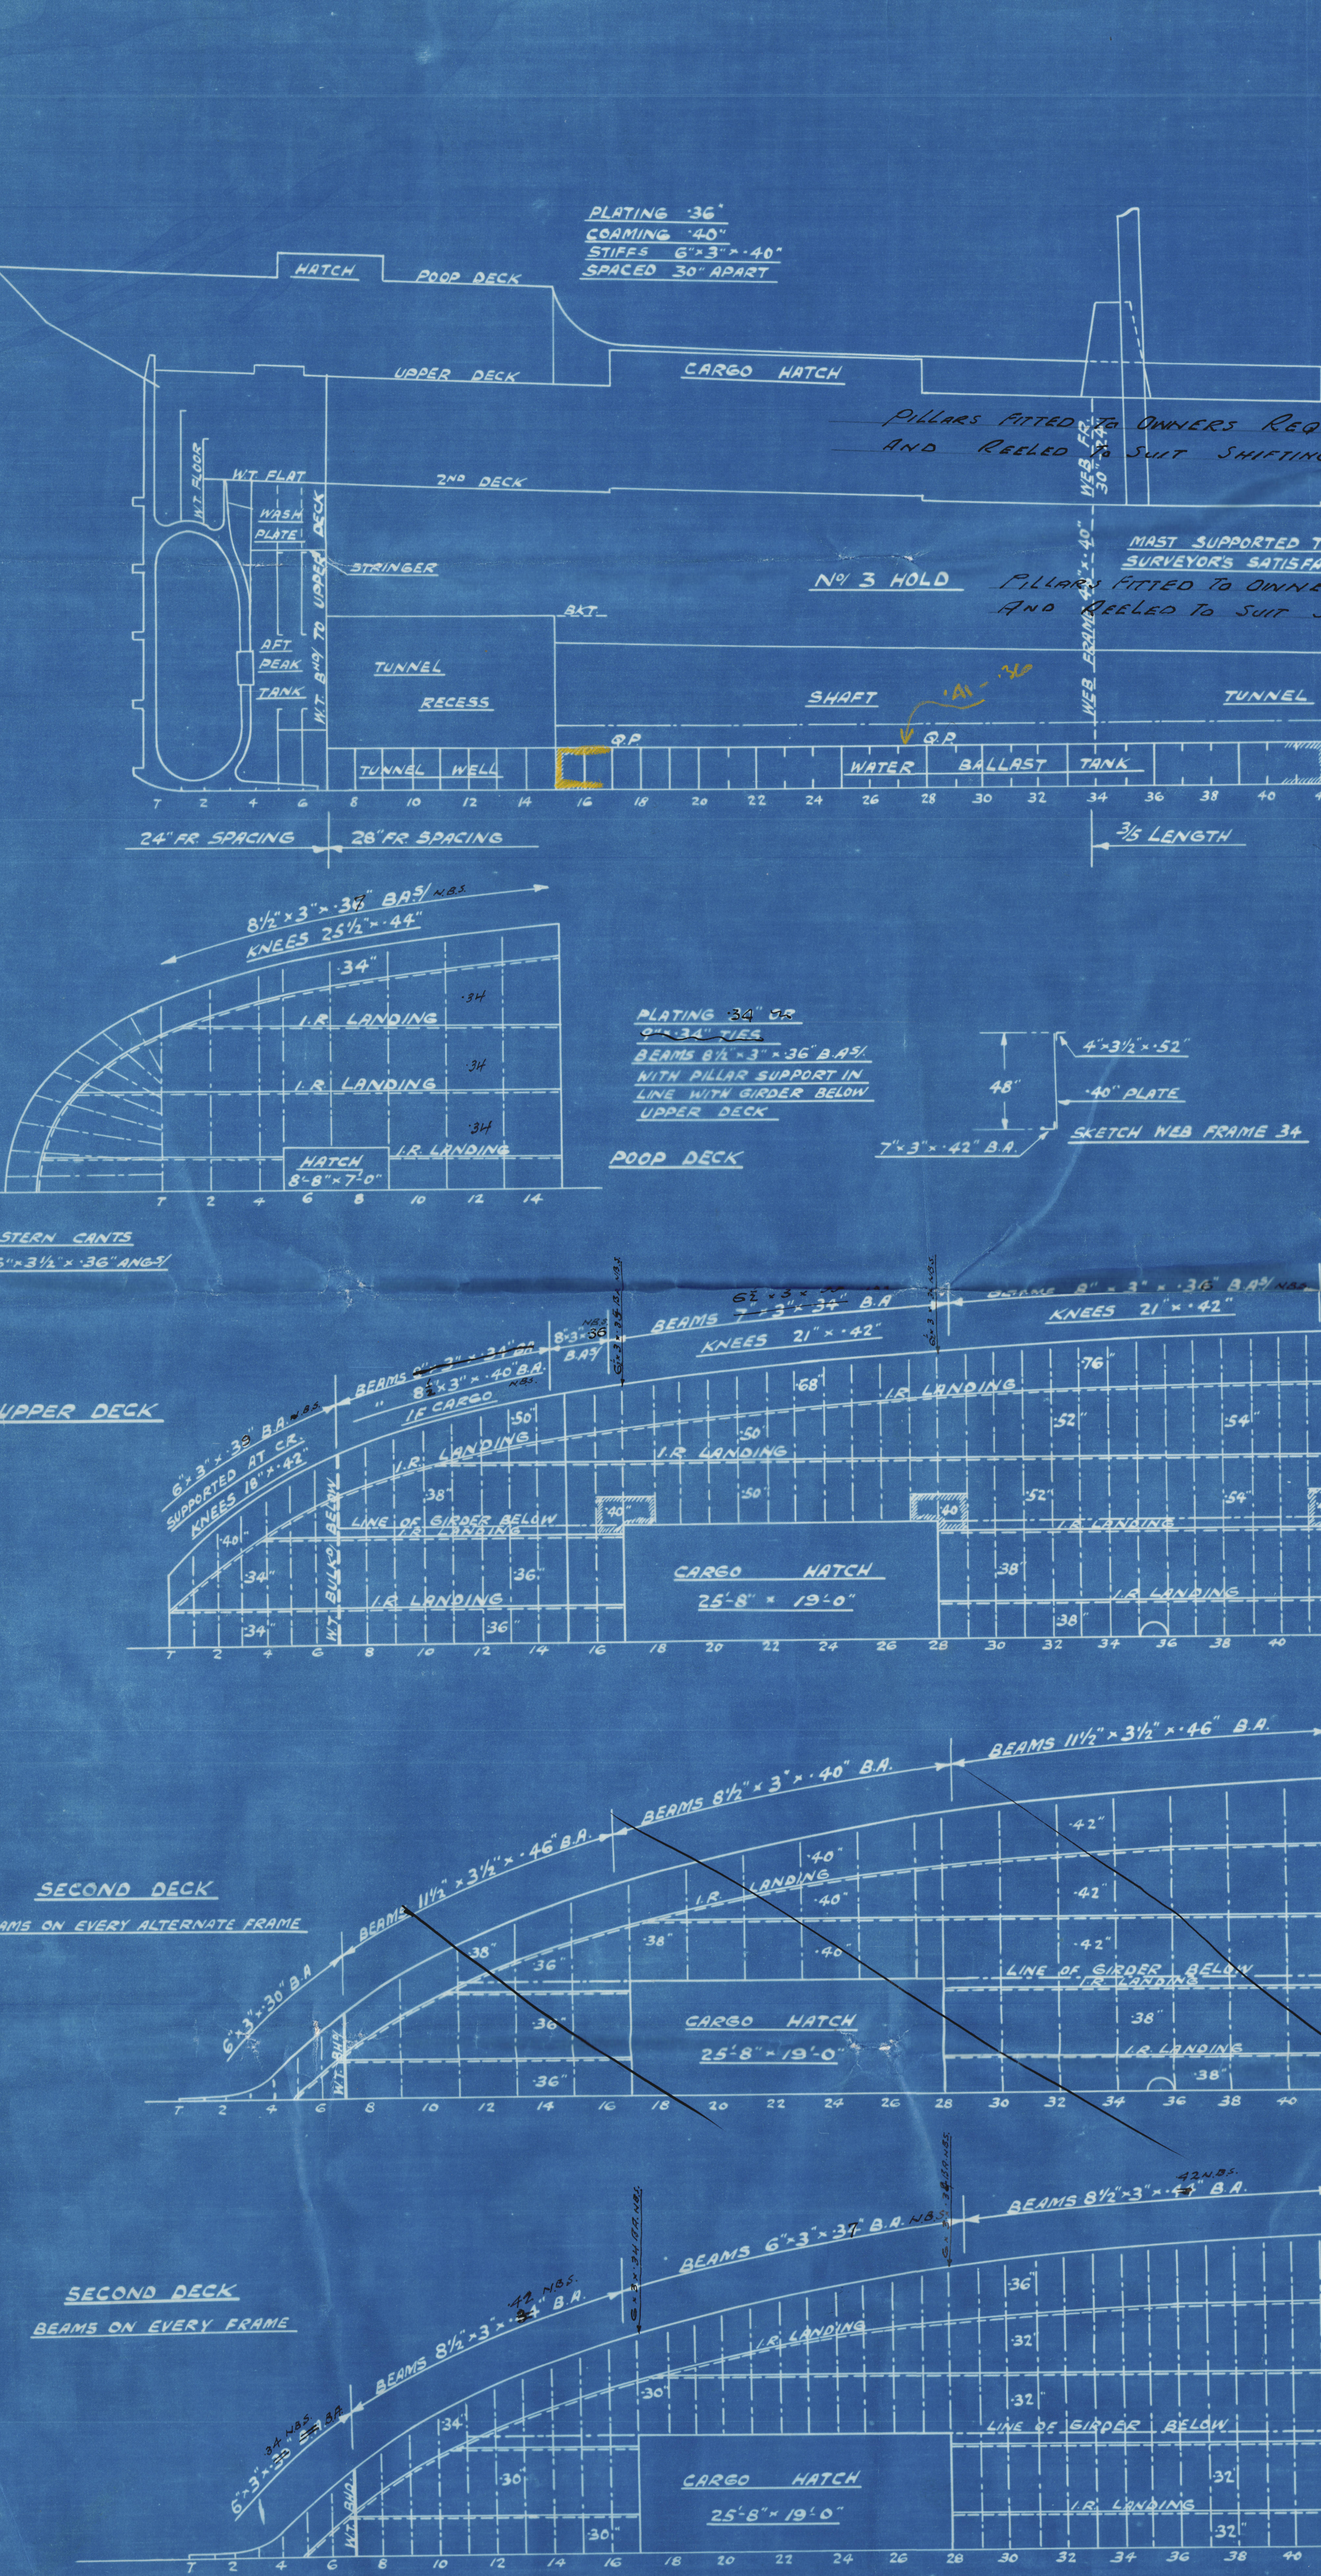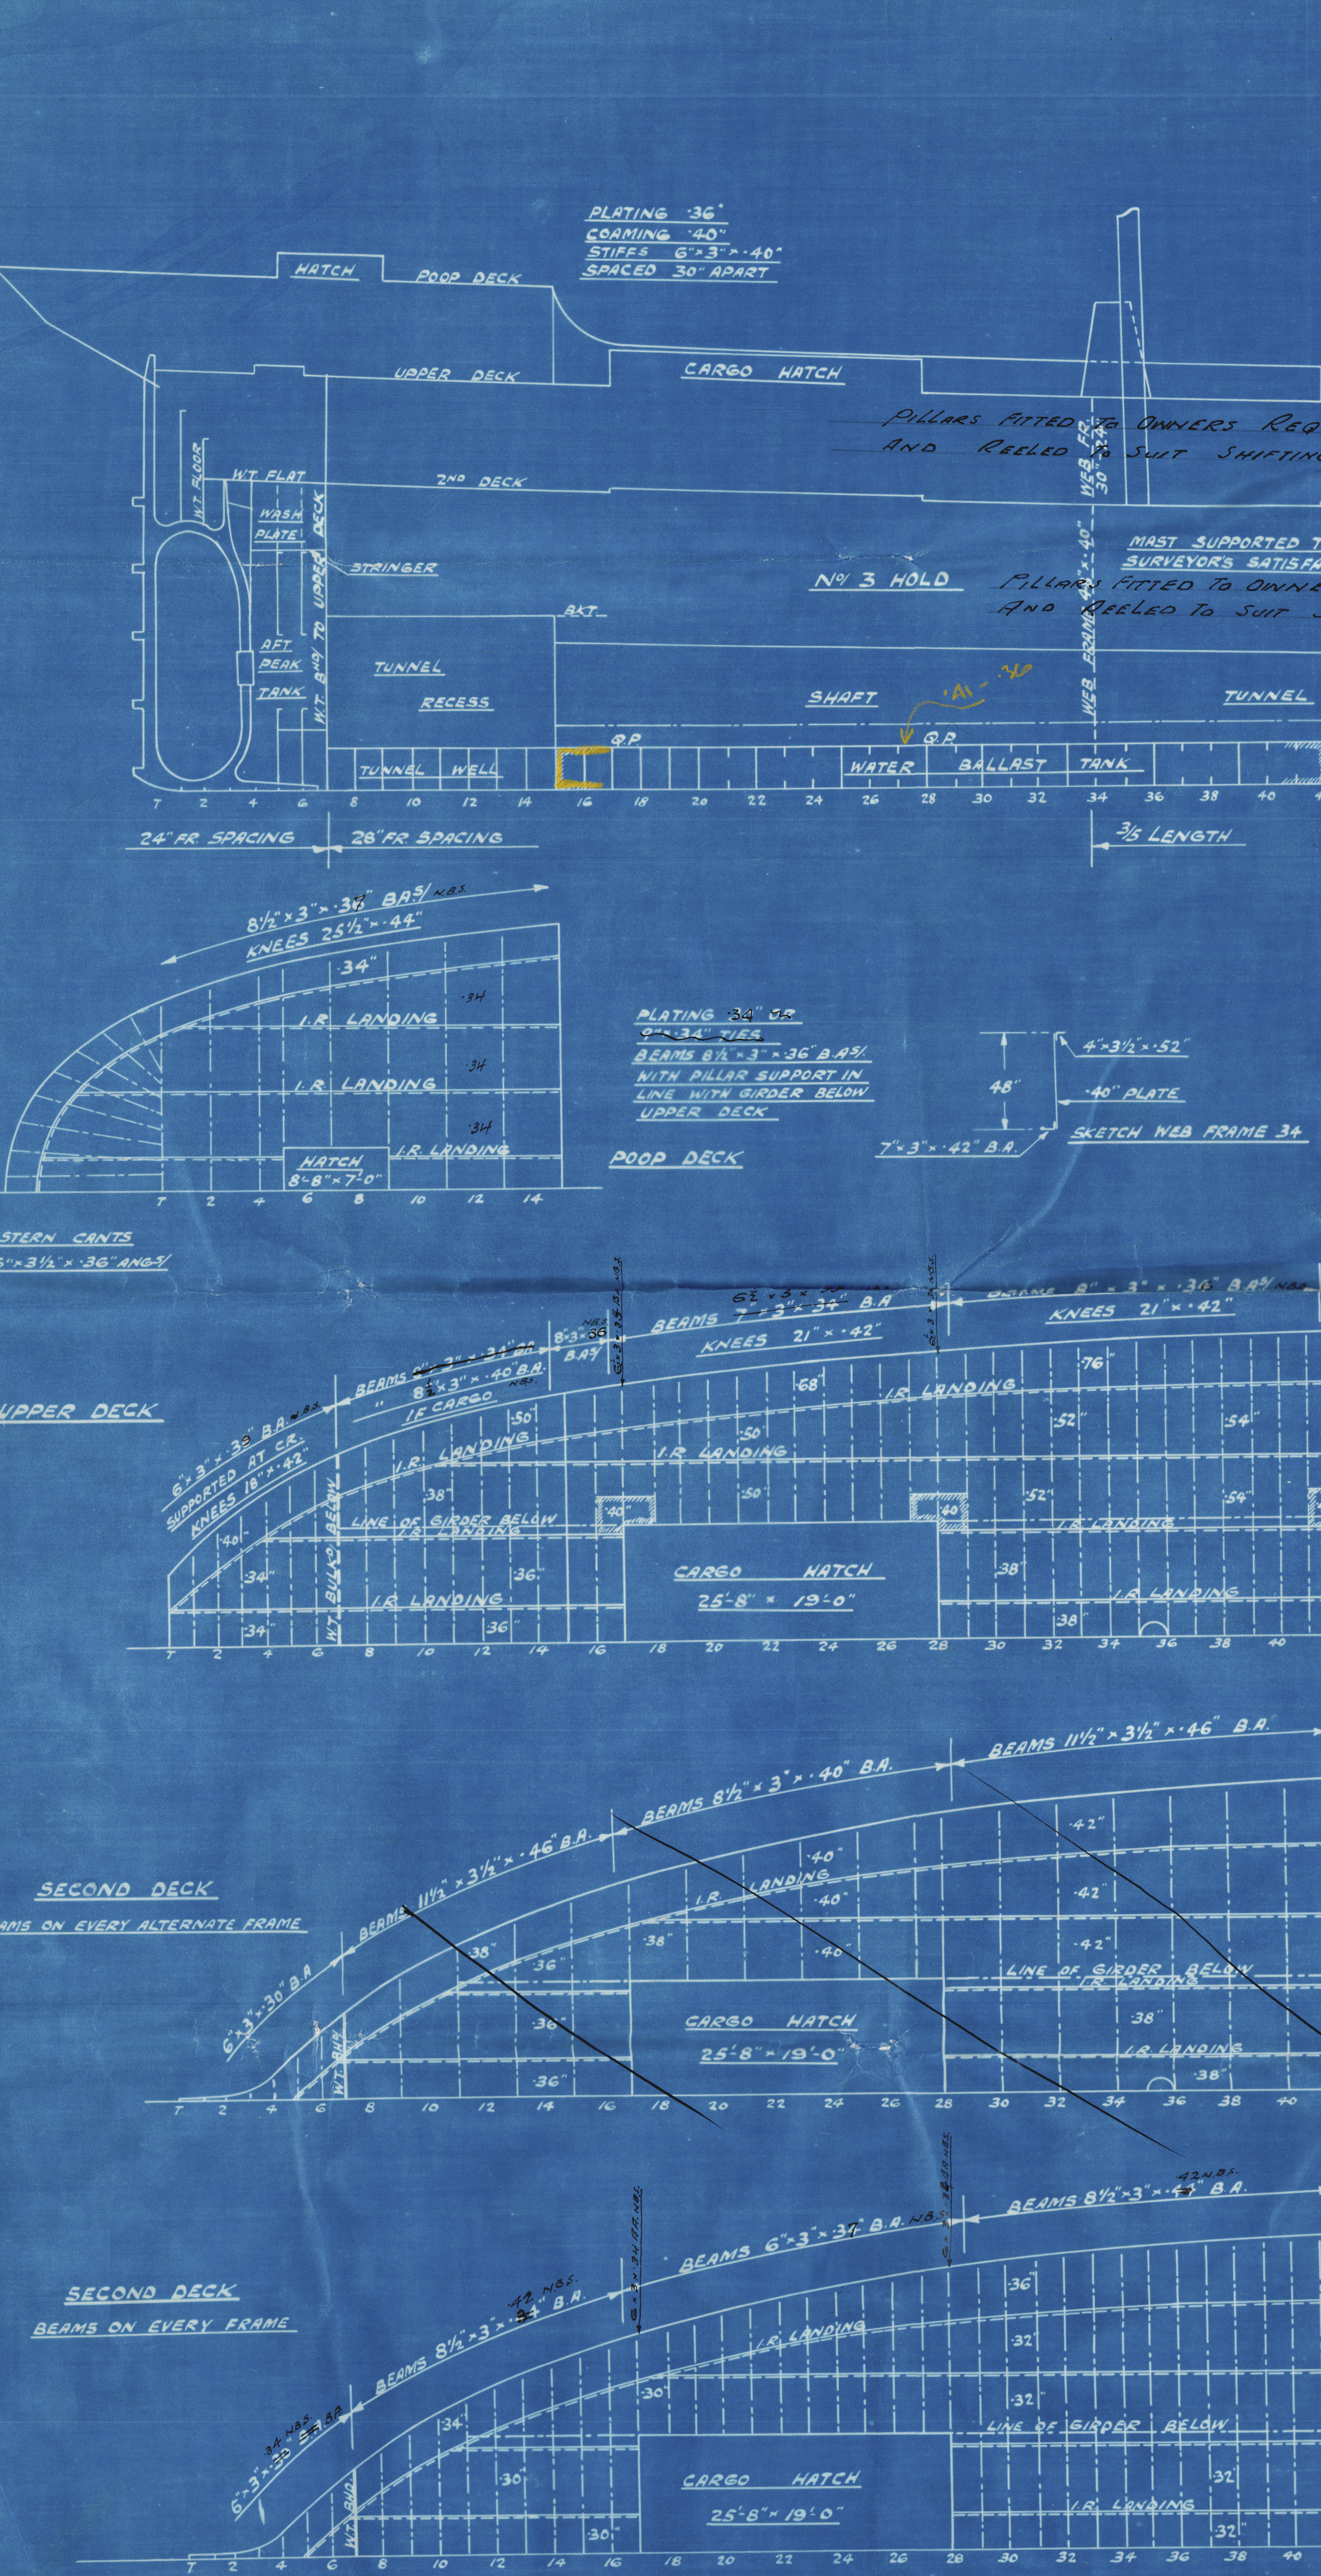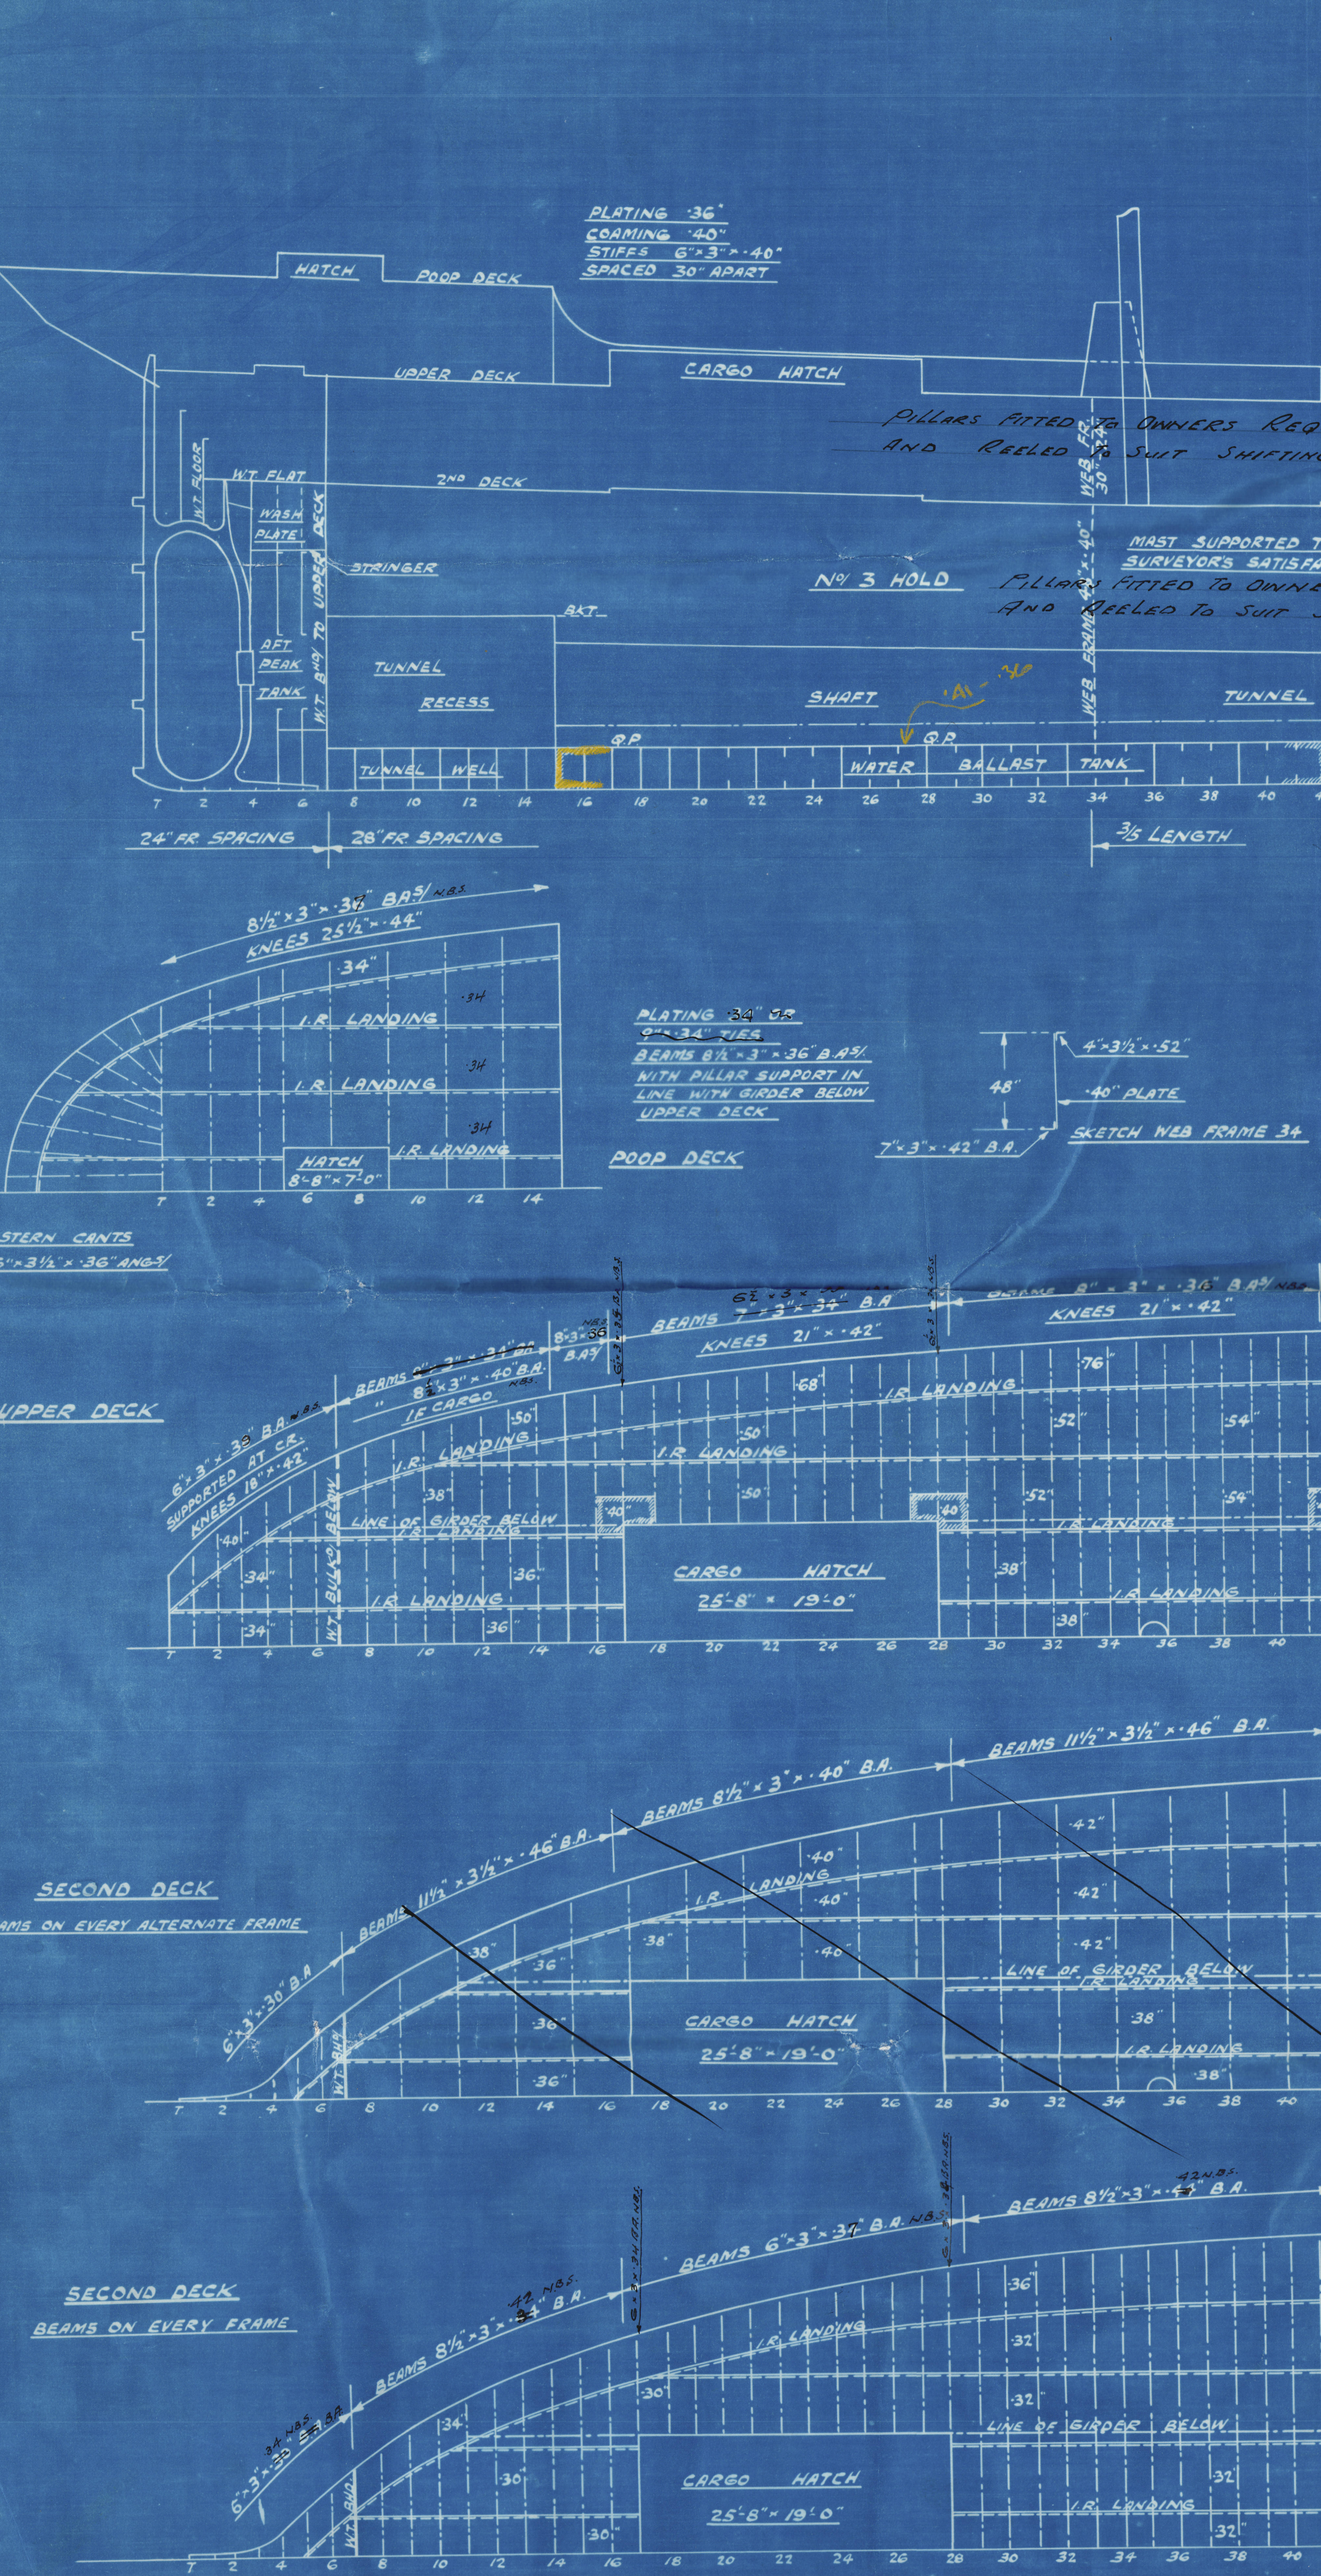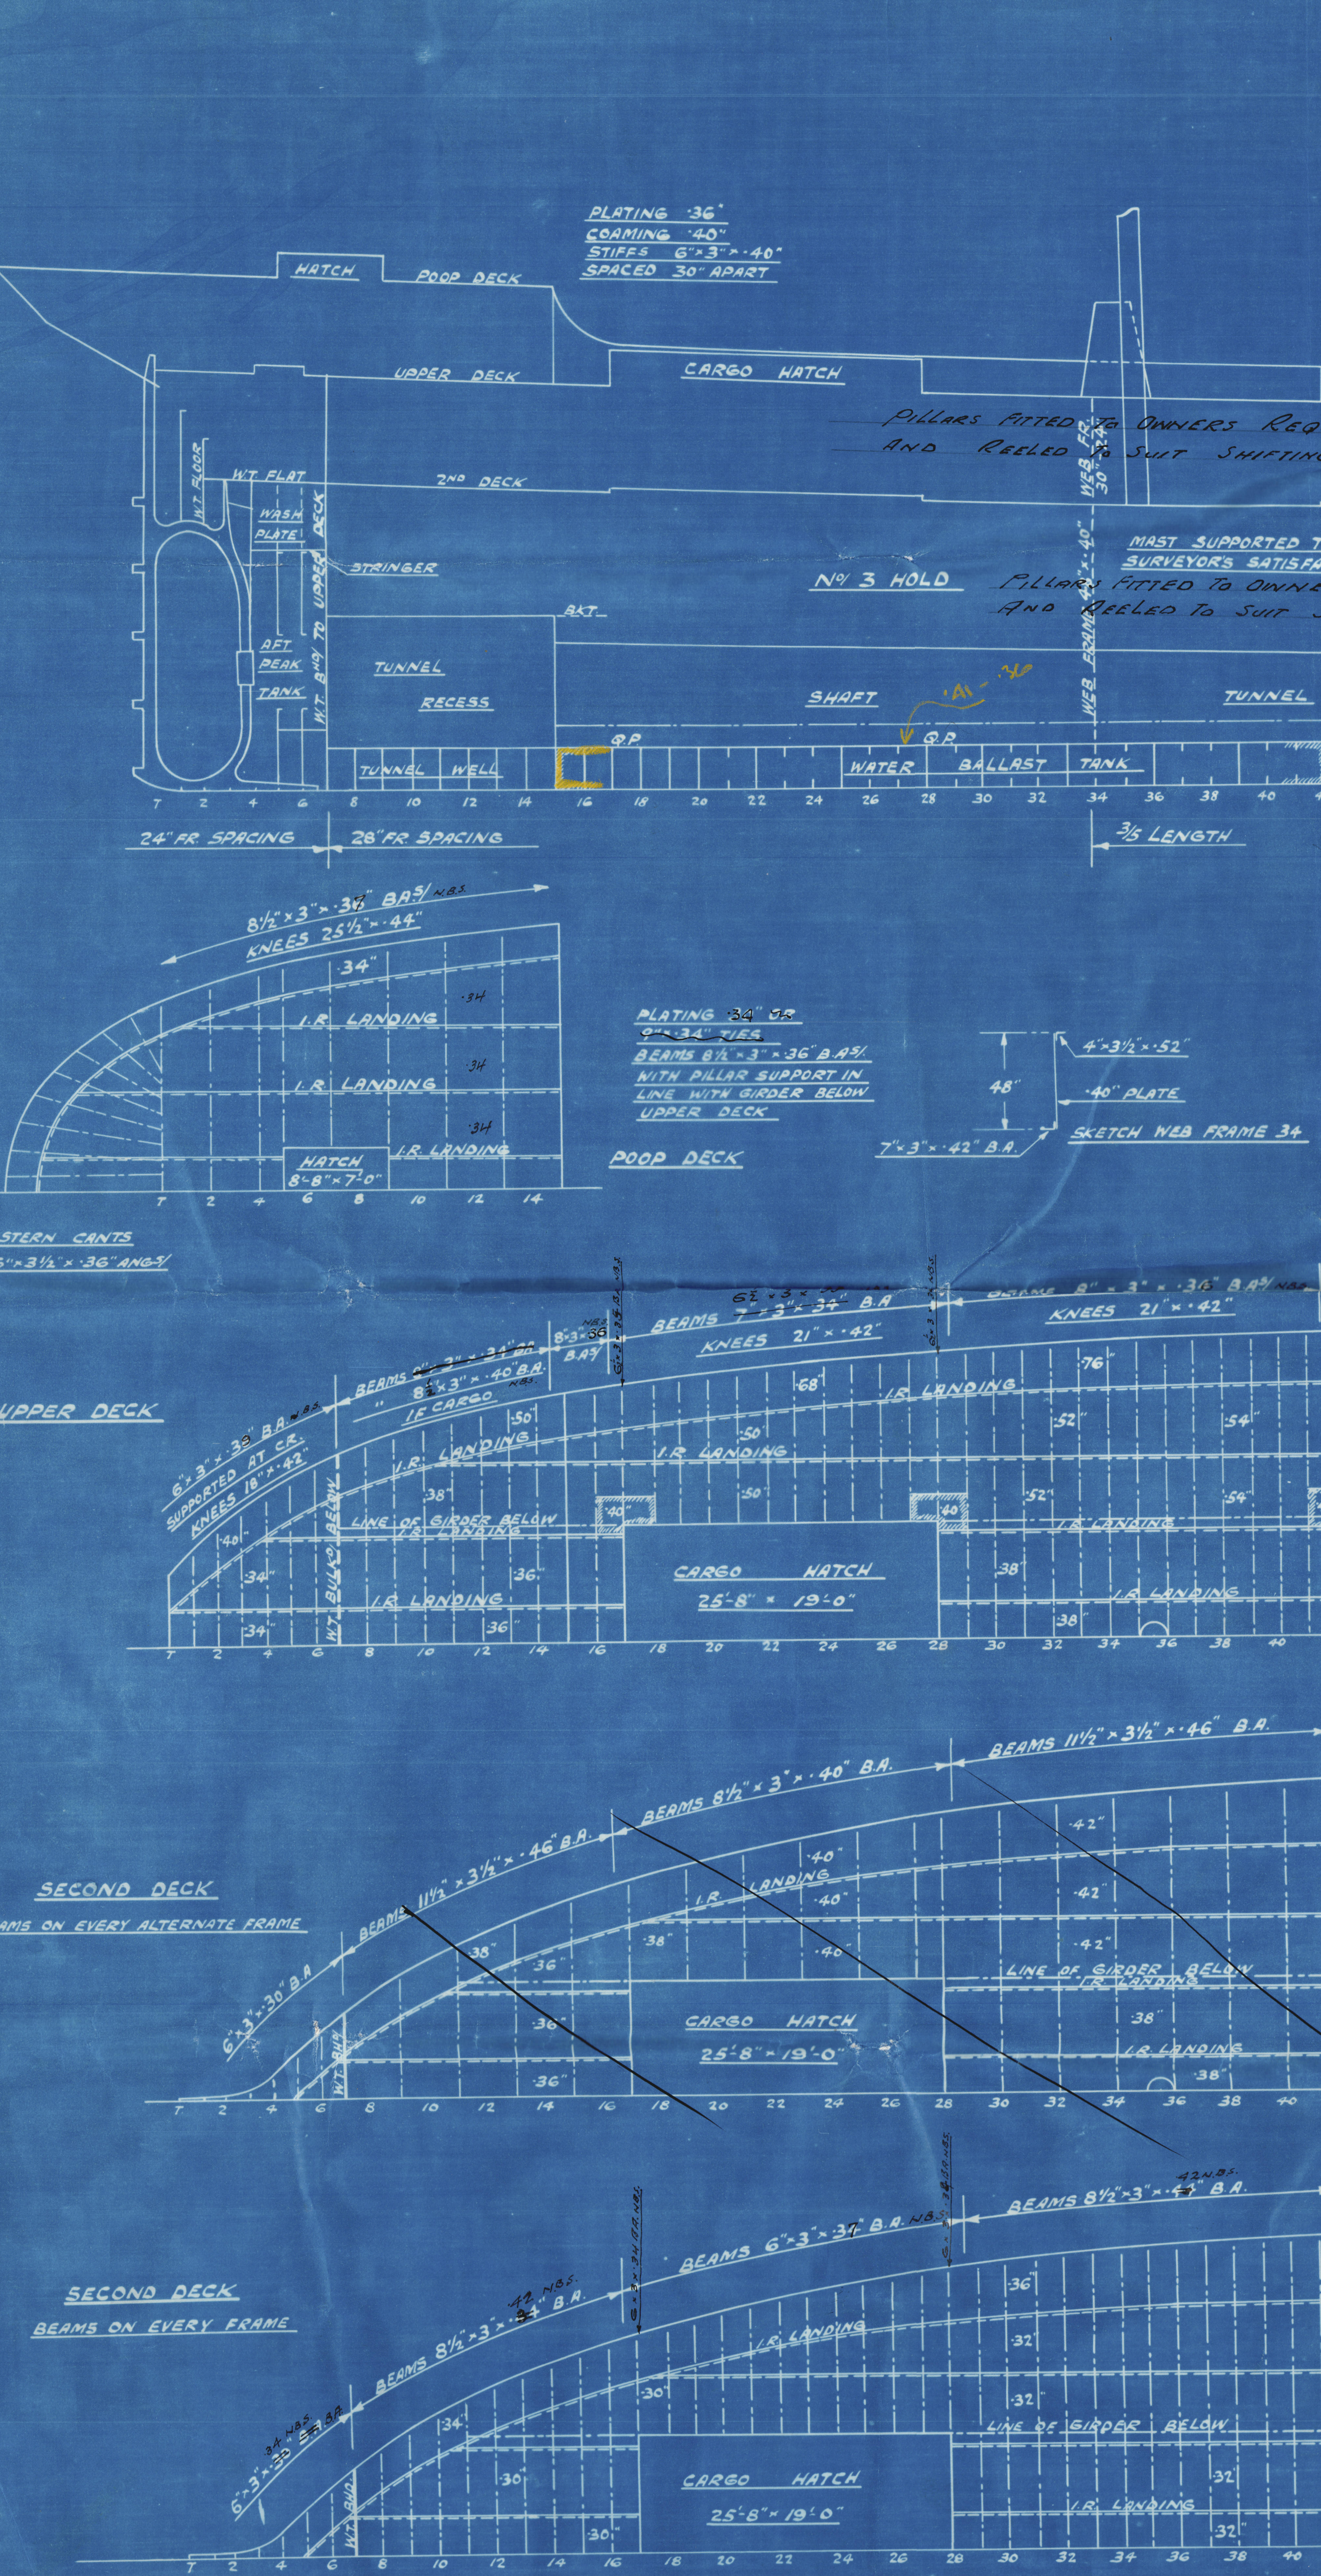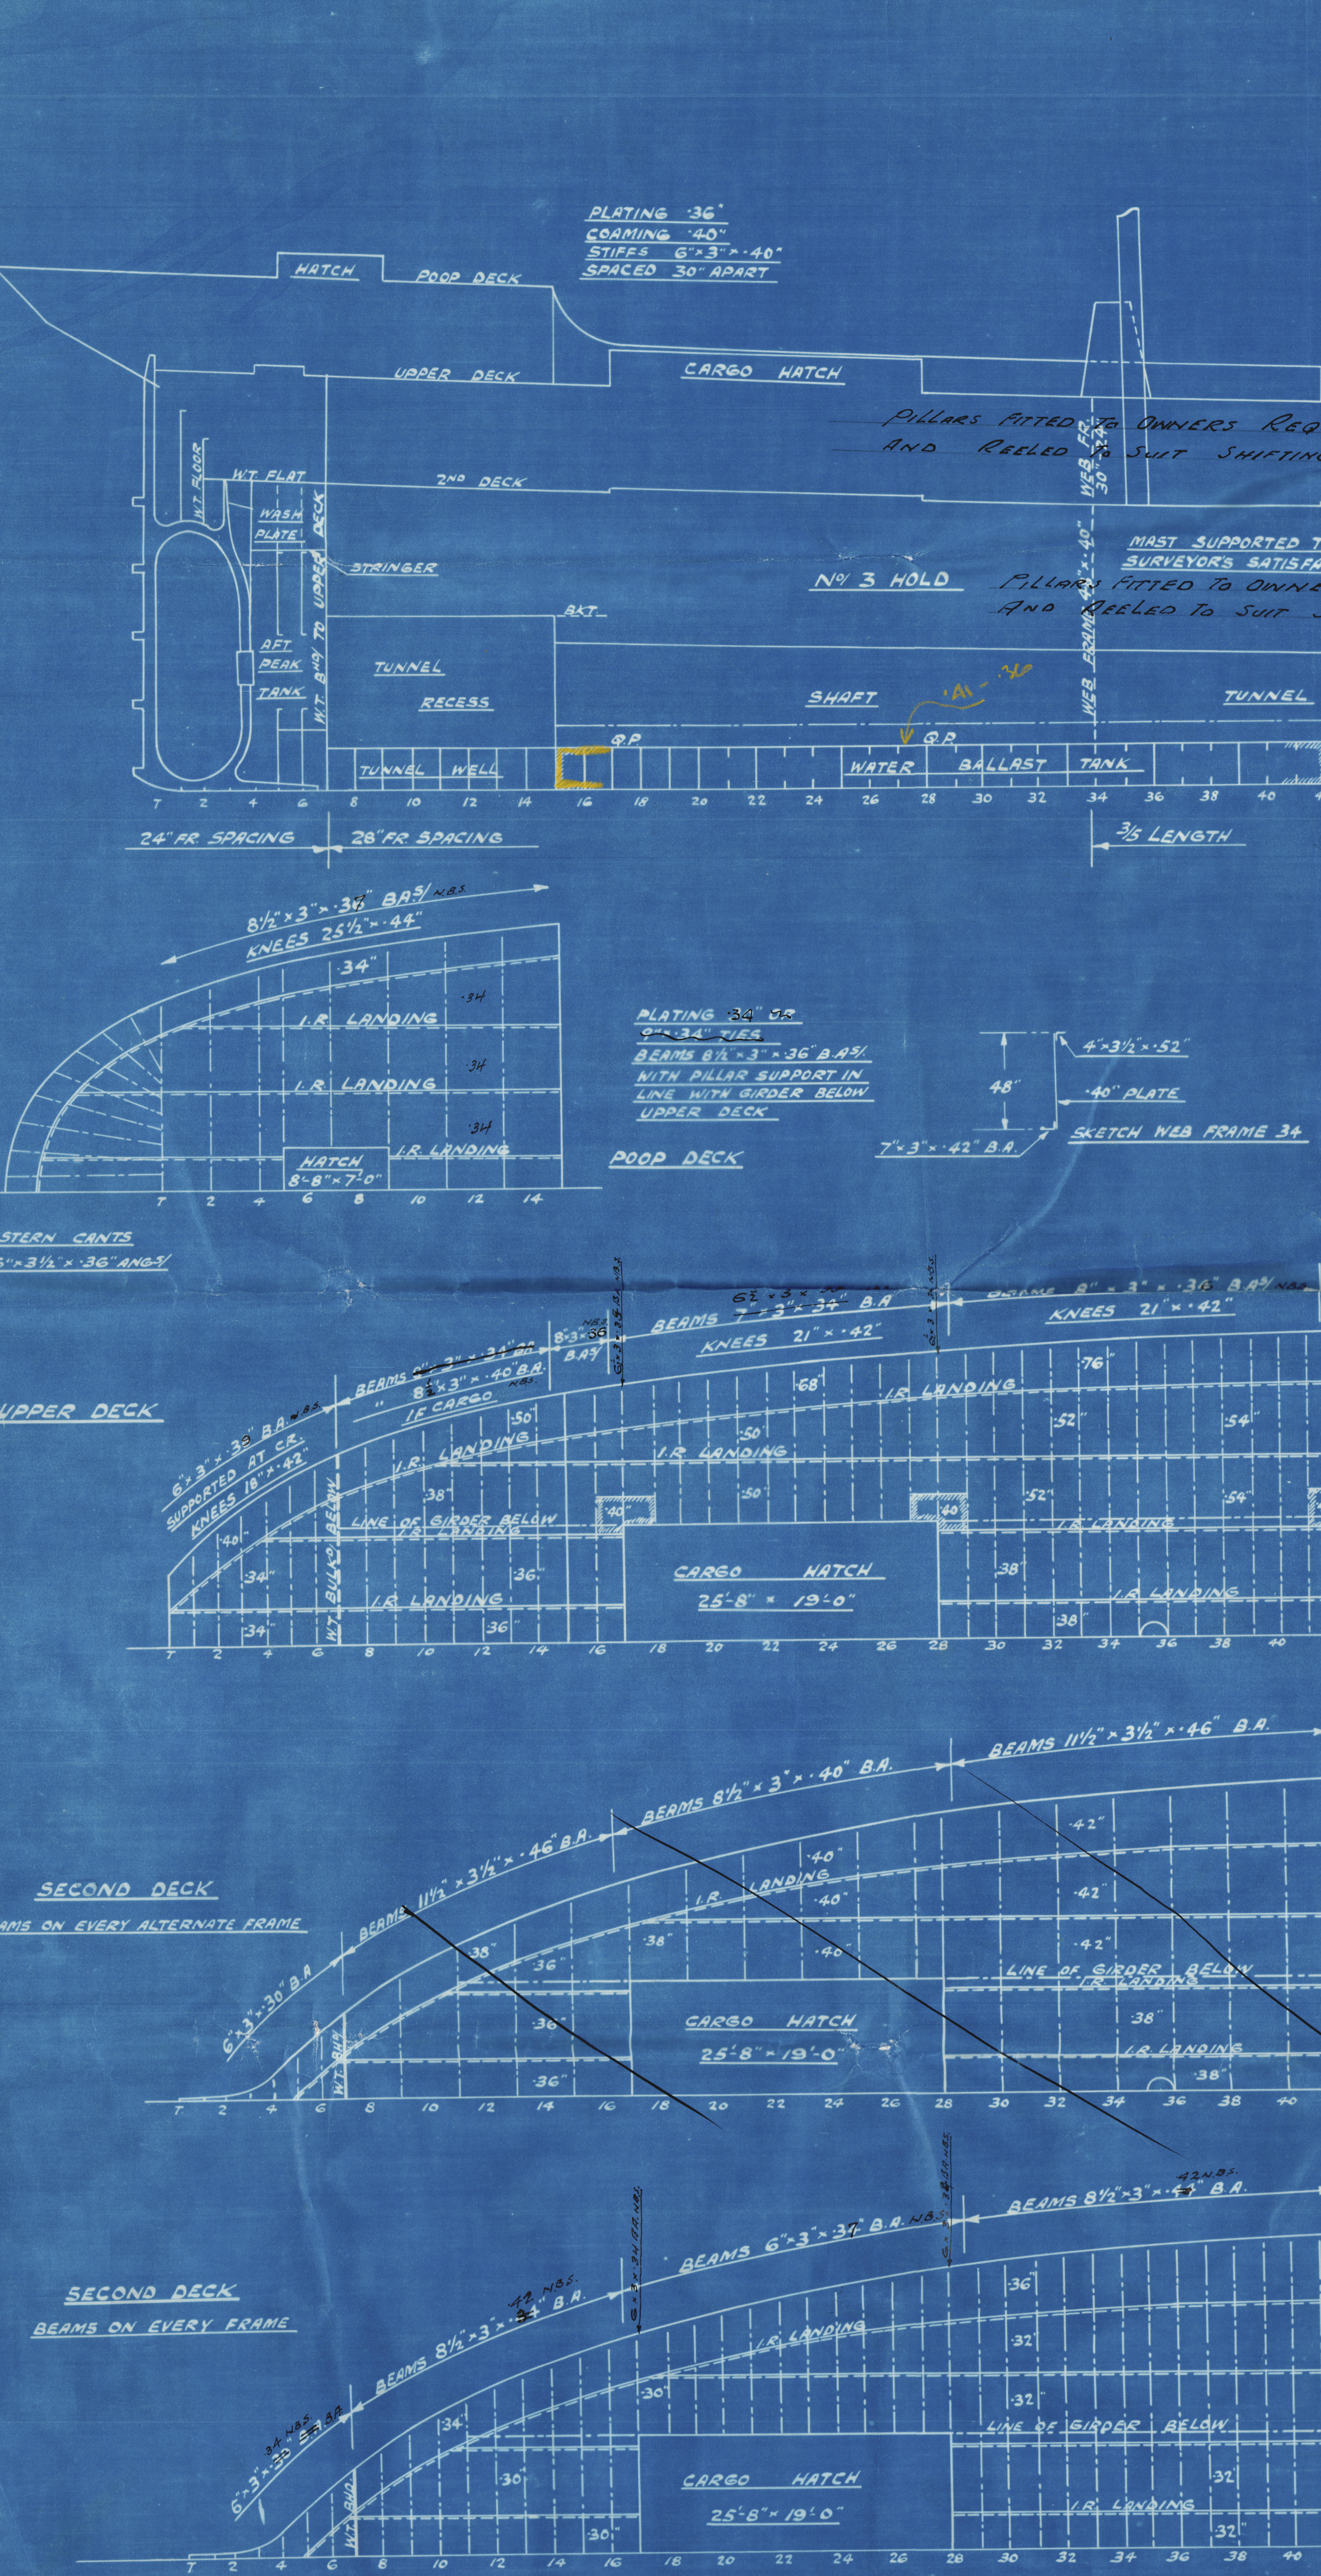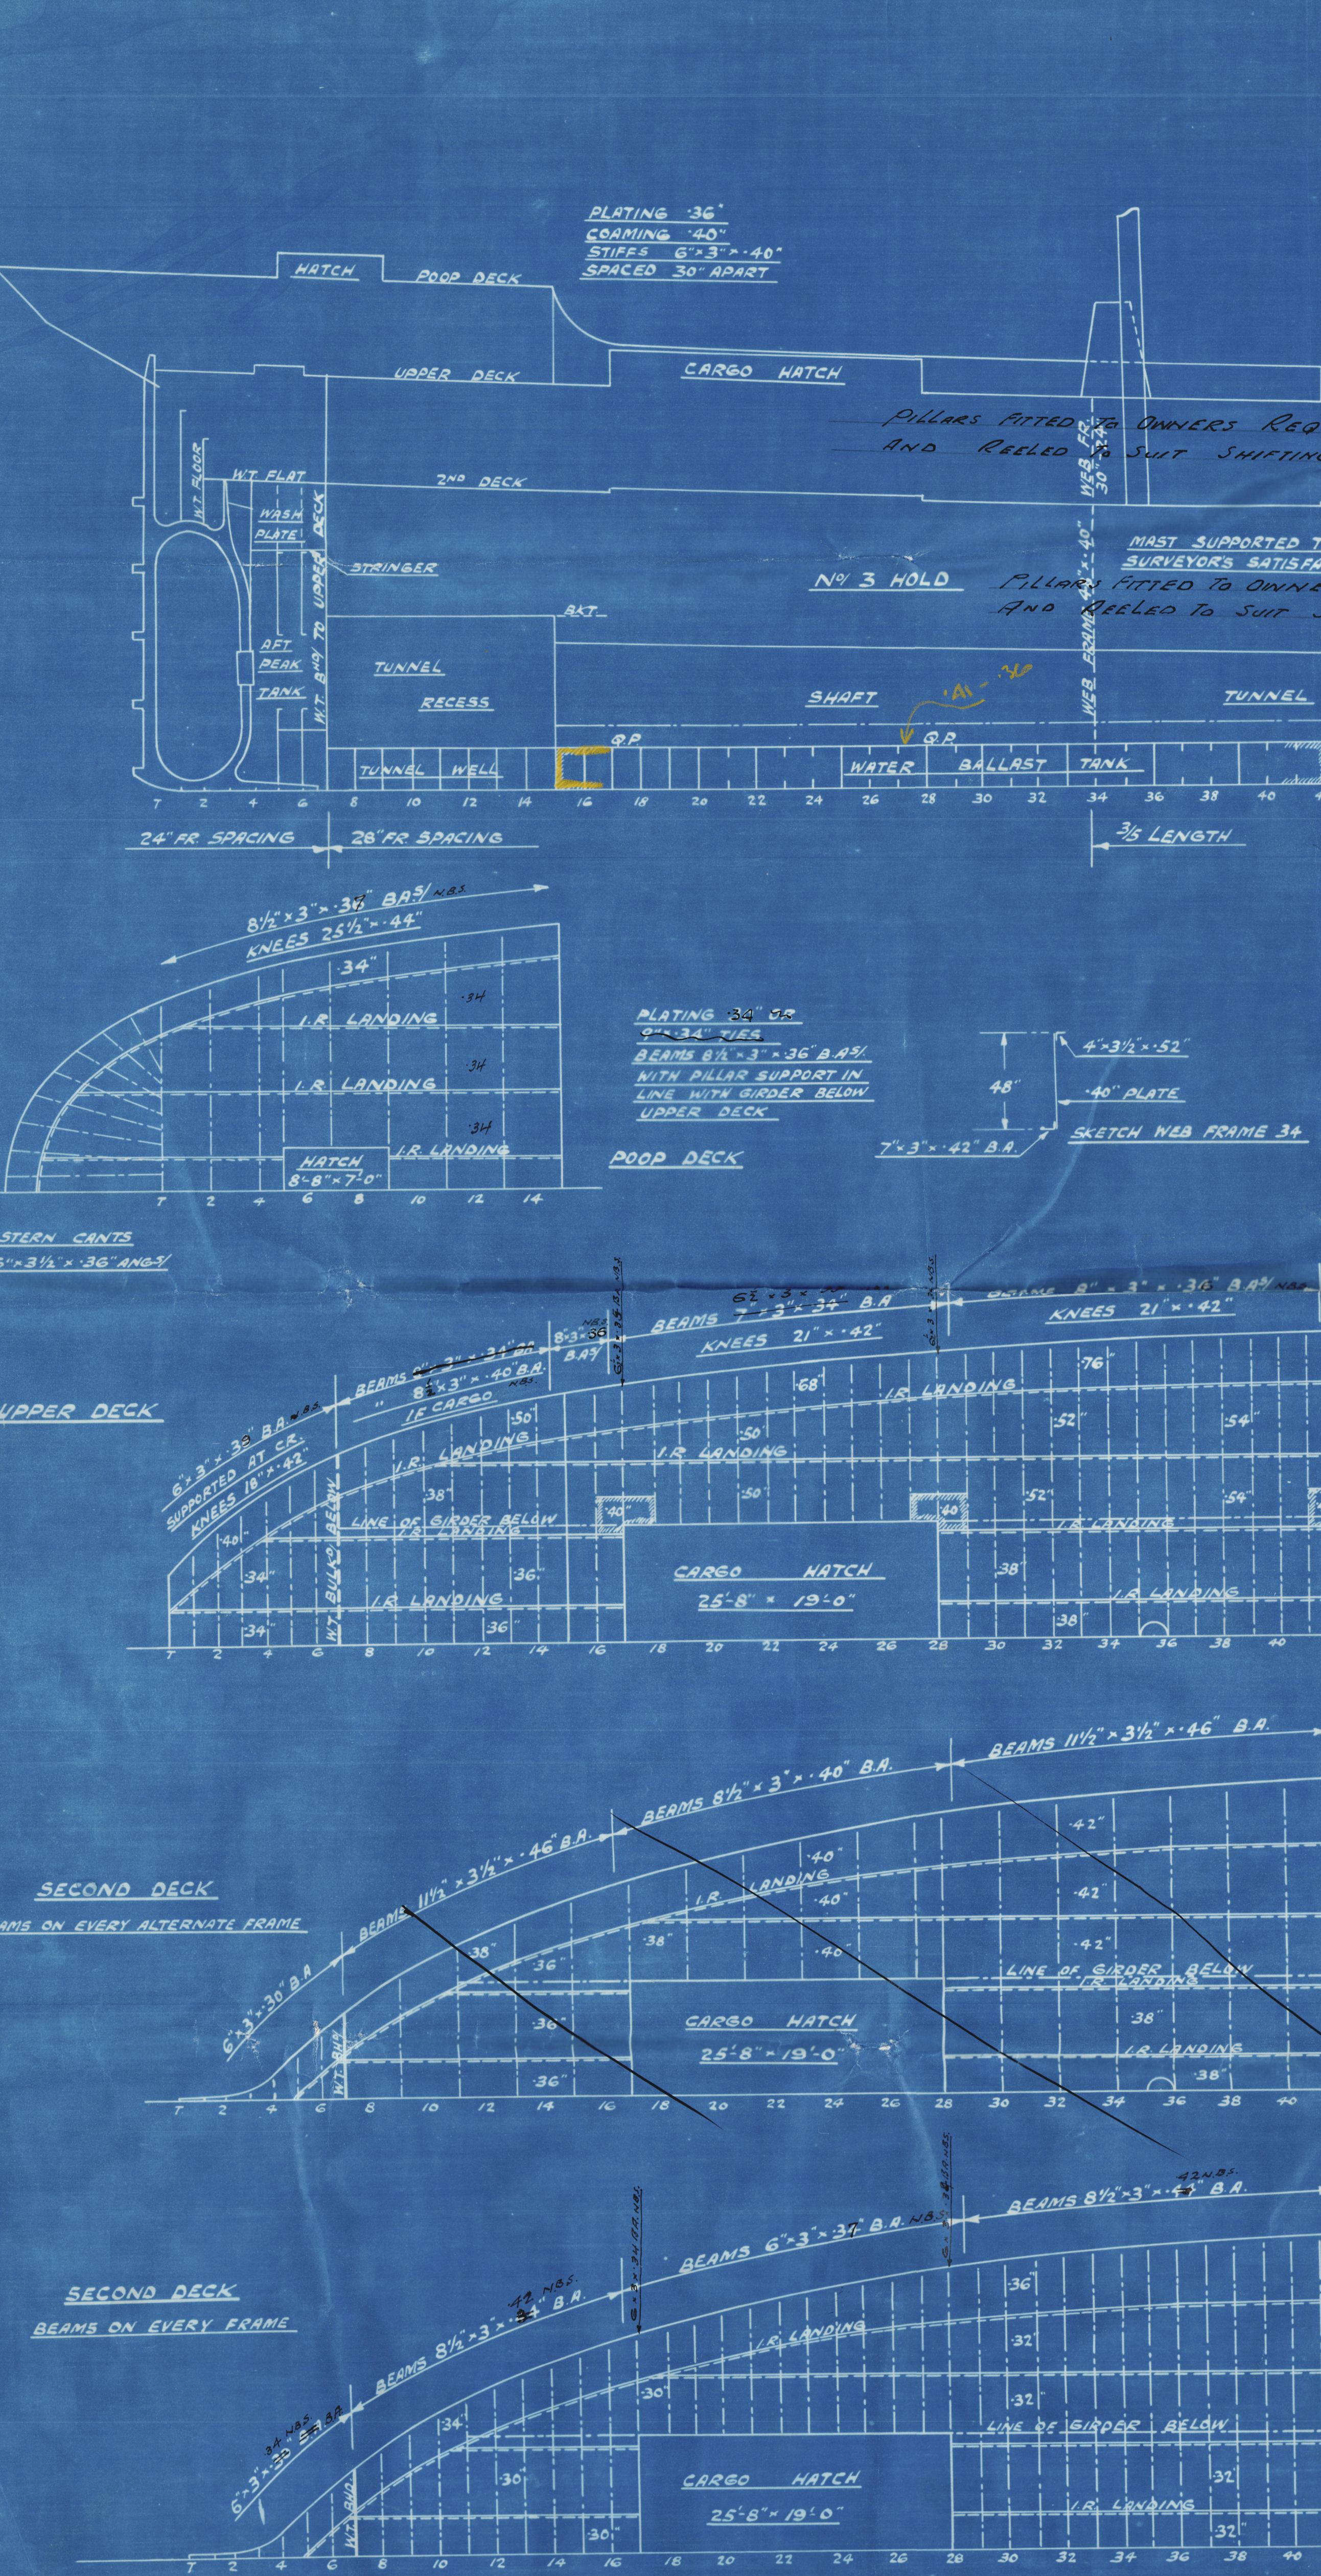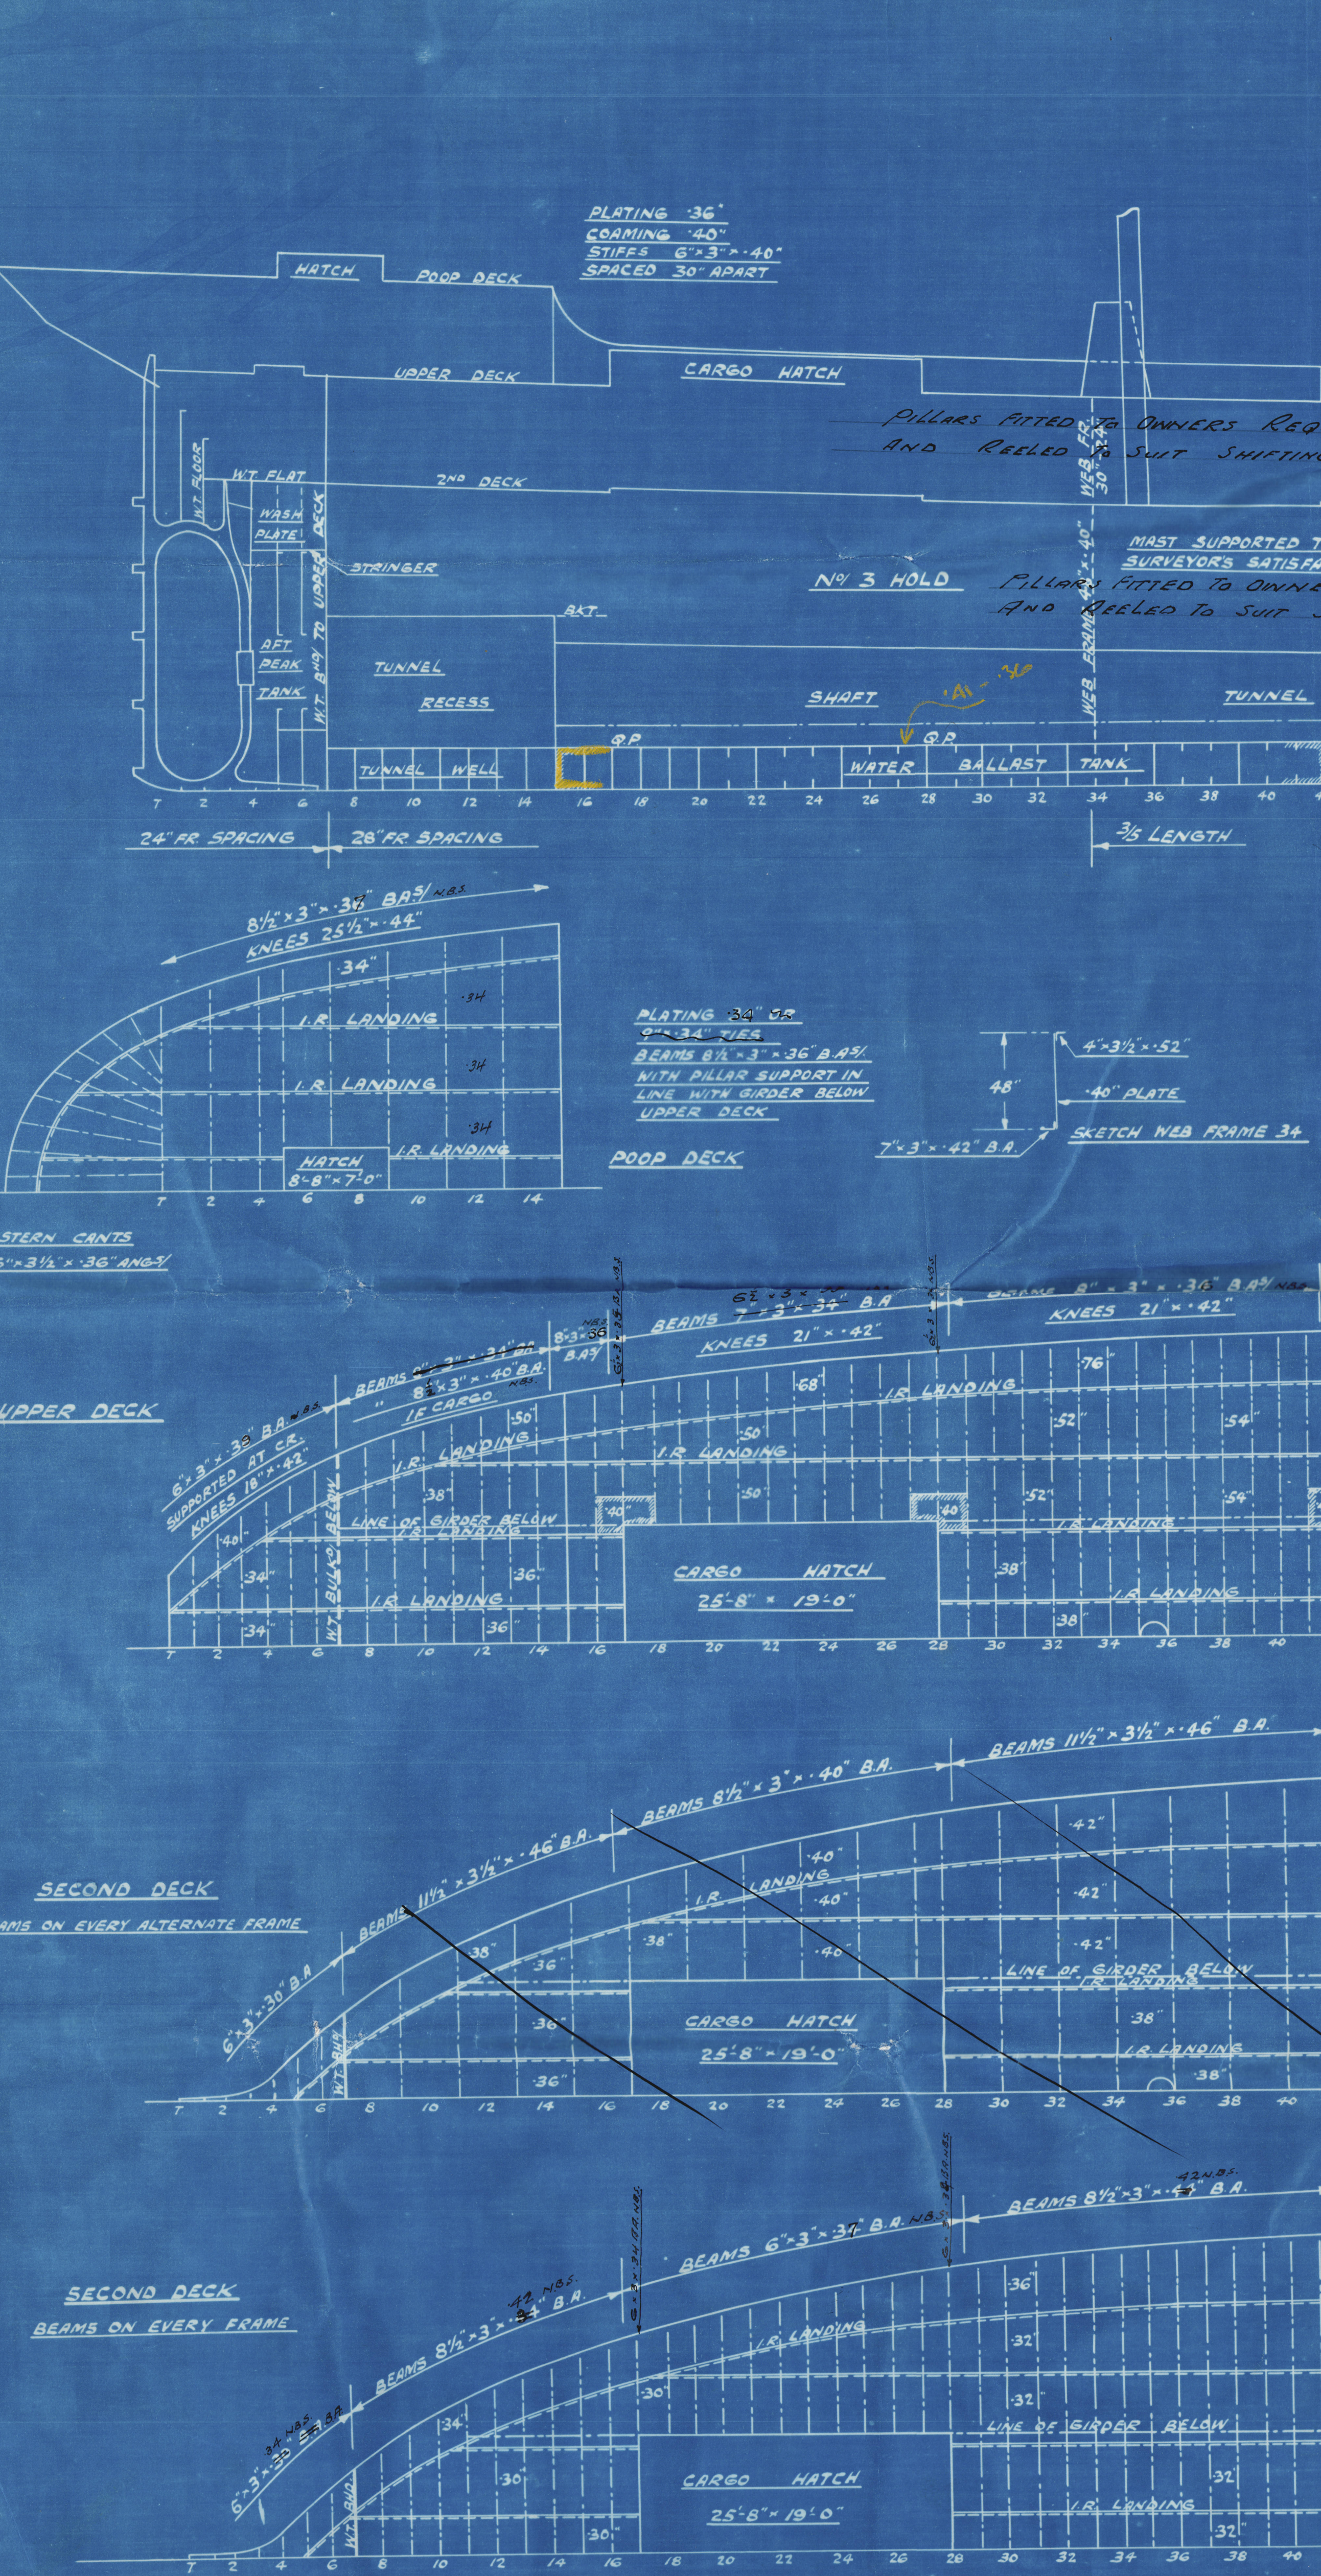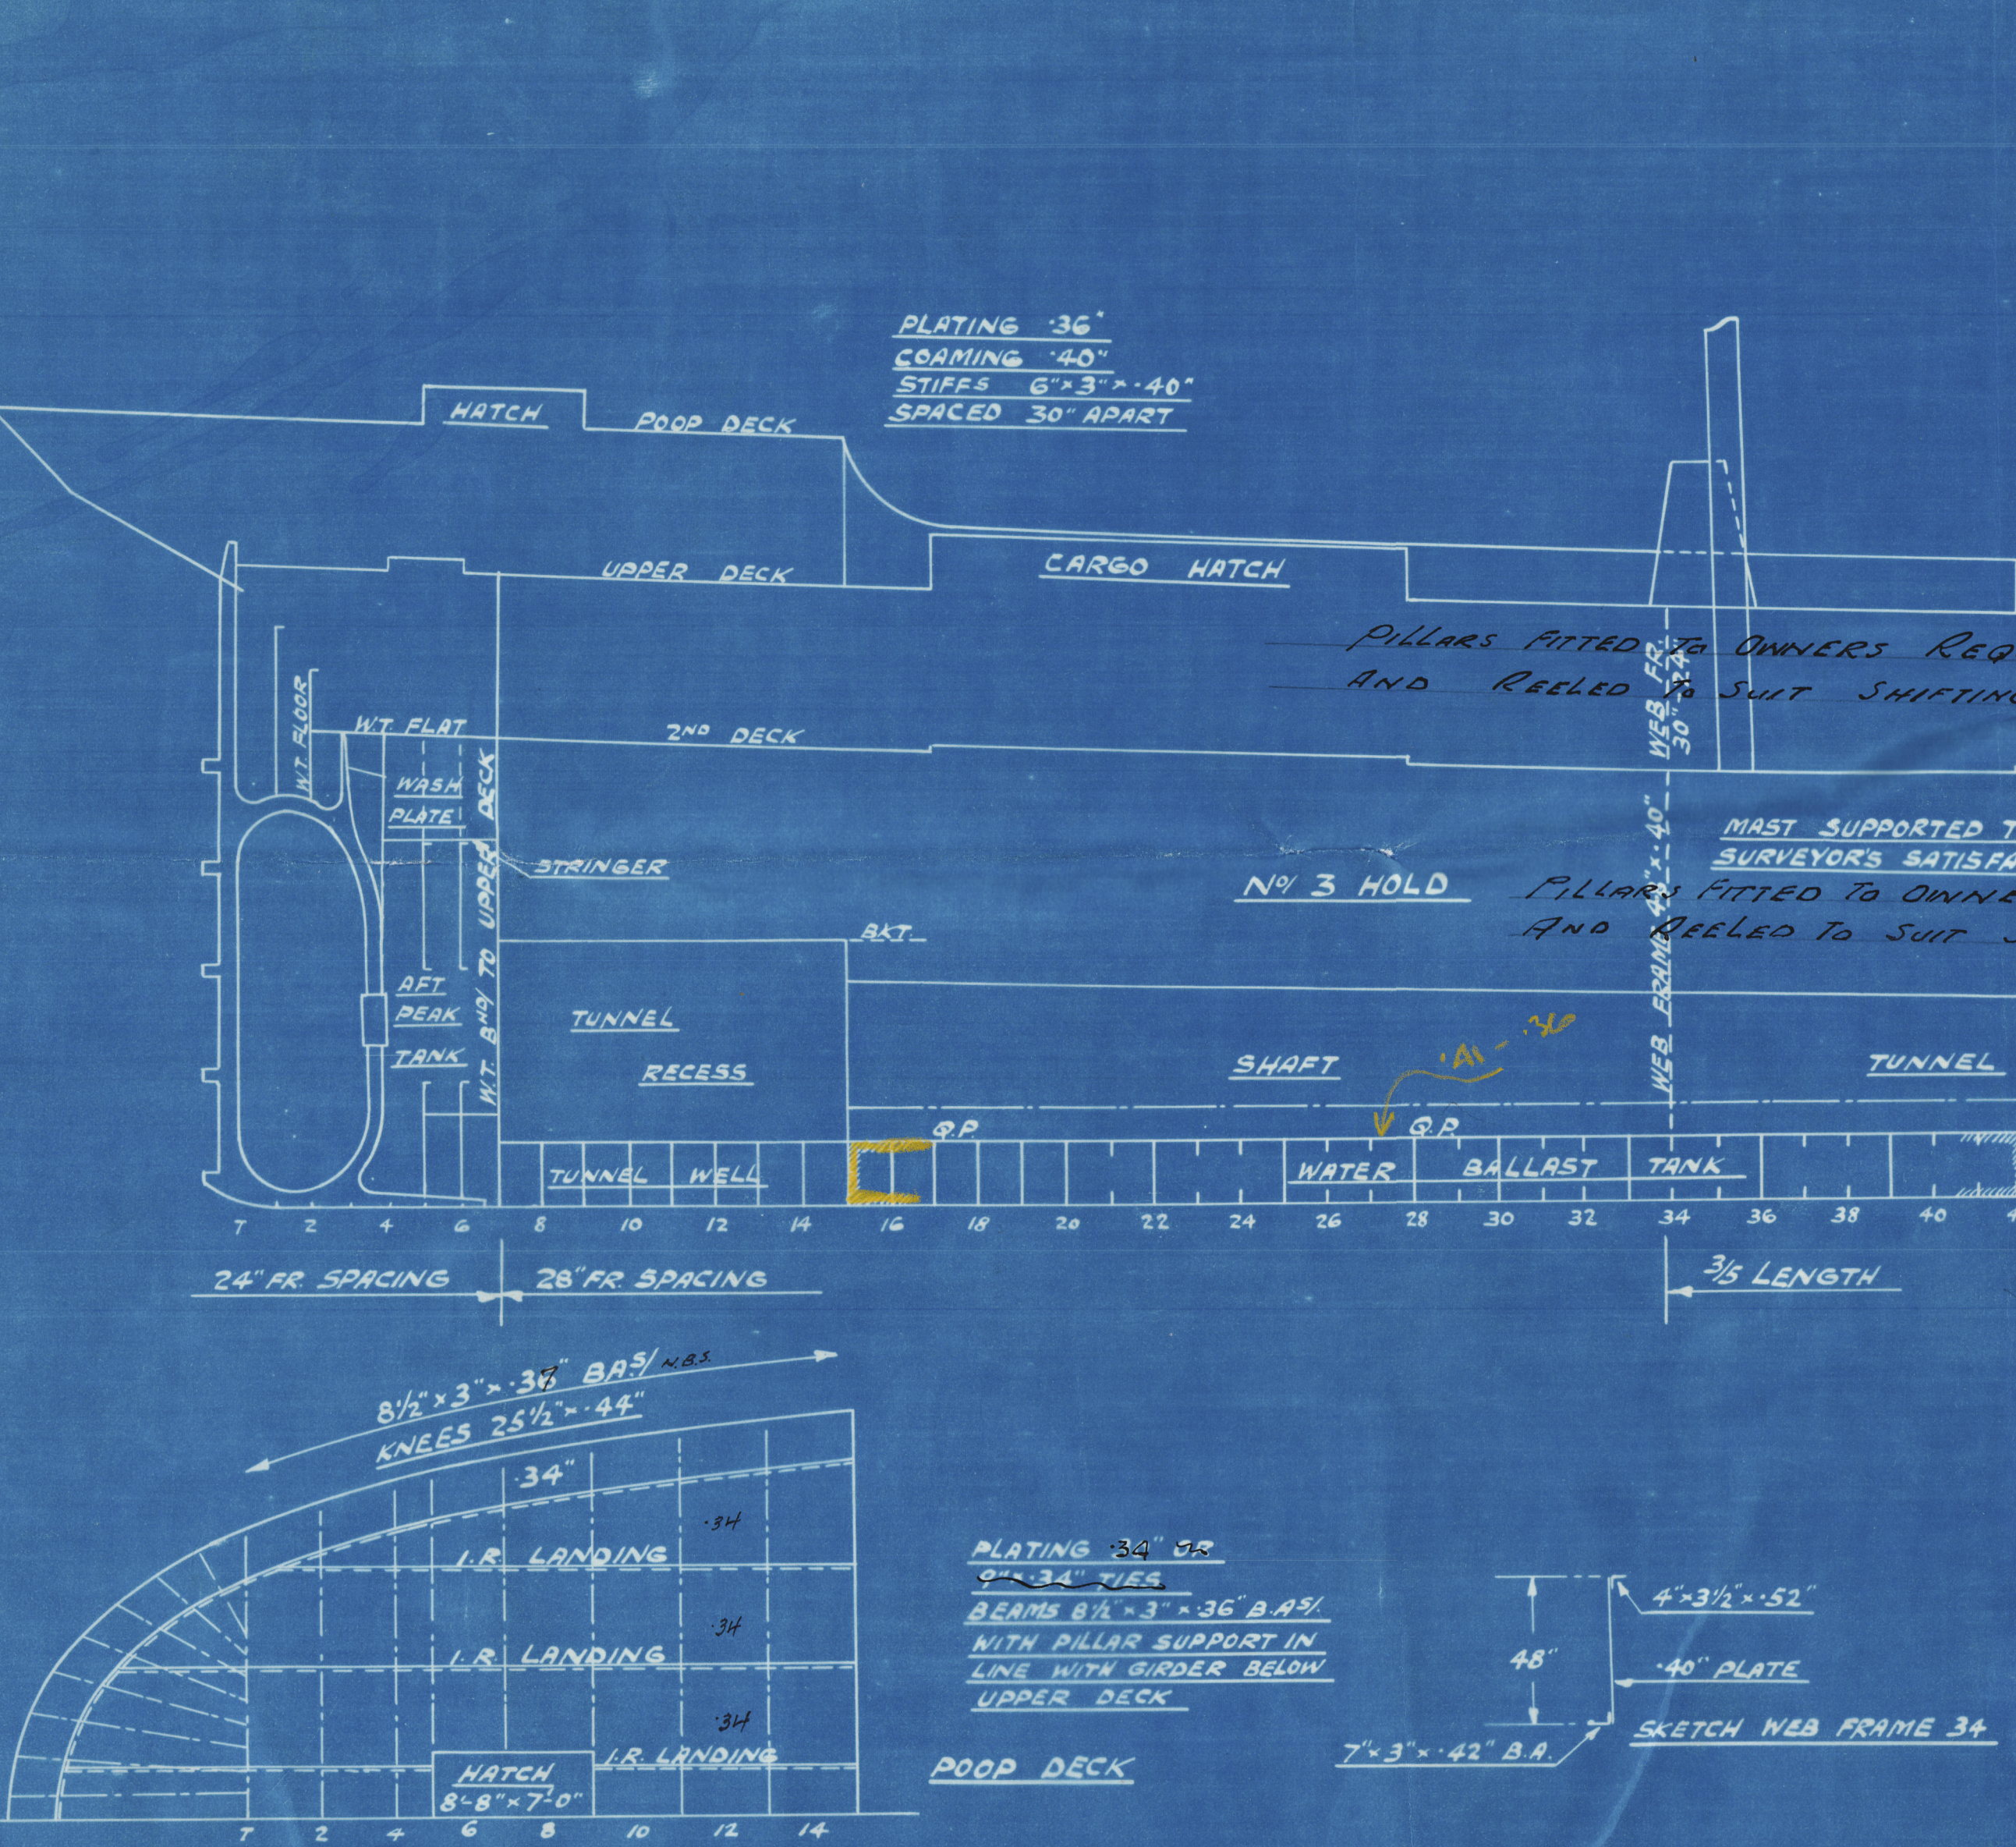

" *

LEONIDAS

LITHGOWS LTD

Nº 805.

PROFILE & DECKS.

(AS BUILT).

S. S. "Bellerado"

Gen. Report N. 18954.

RETAIN

© 2020

003513-003524-0273

Lloyd's Register
Foundation