

S.S. "SENTRY":  
MIDSHIP SECTION.

### Principal Dimensions


Length B.P.	230' - 0"
Breadth Mid.	34' - 10"
Ext.	35' - 0"
Depth Mid.	17' - 0"
Tween Decks.	7' - 0"

Scale:  $\frac{1}{2}$ " = One Foot.

To Class 100. A.I. Lloyd's with Freeboard. 1923-1924 Rules.

### Complete Superstructure Vessel.

The draught not to exceed that for a Complete Superstructure Vessel having a Tonnage Opening.

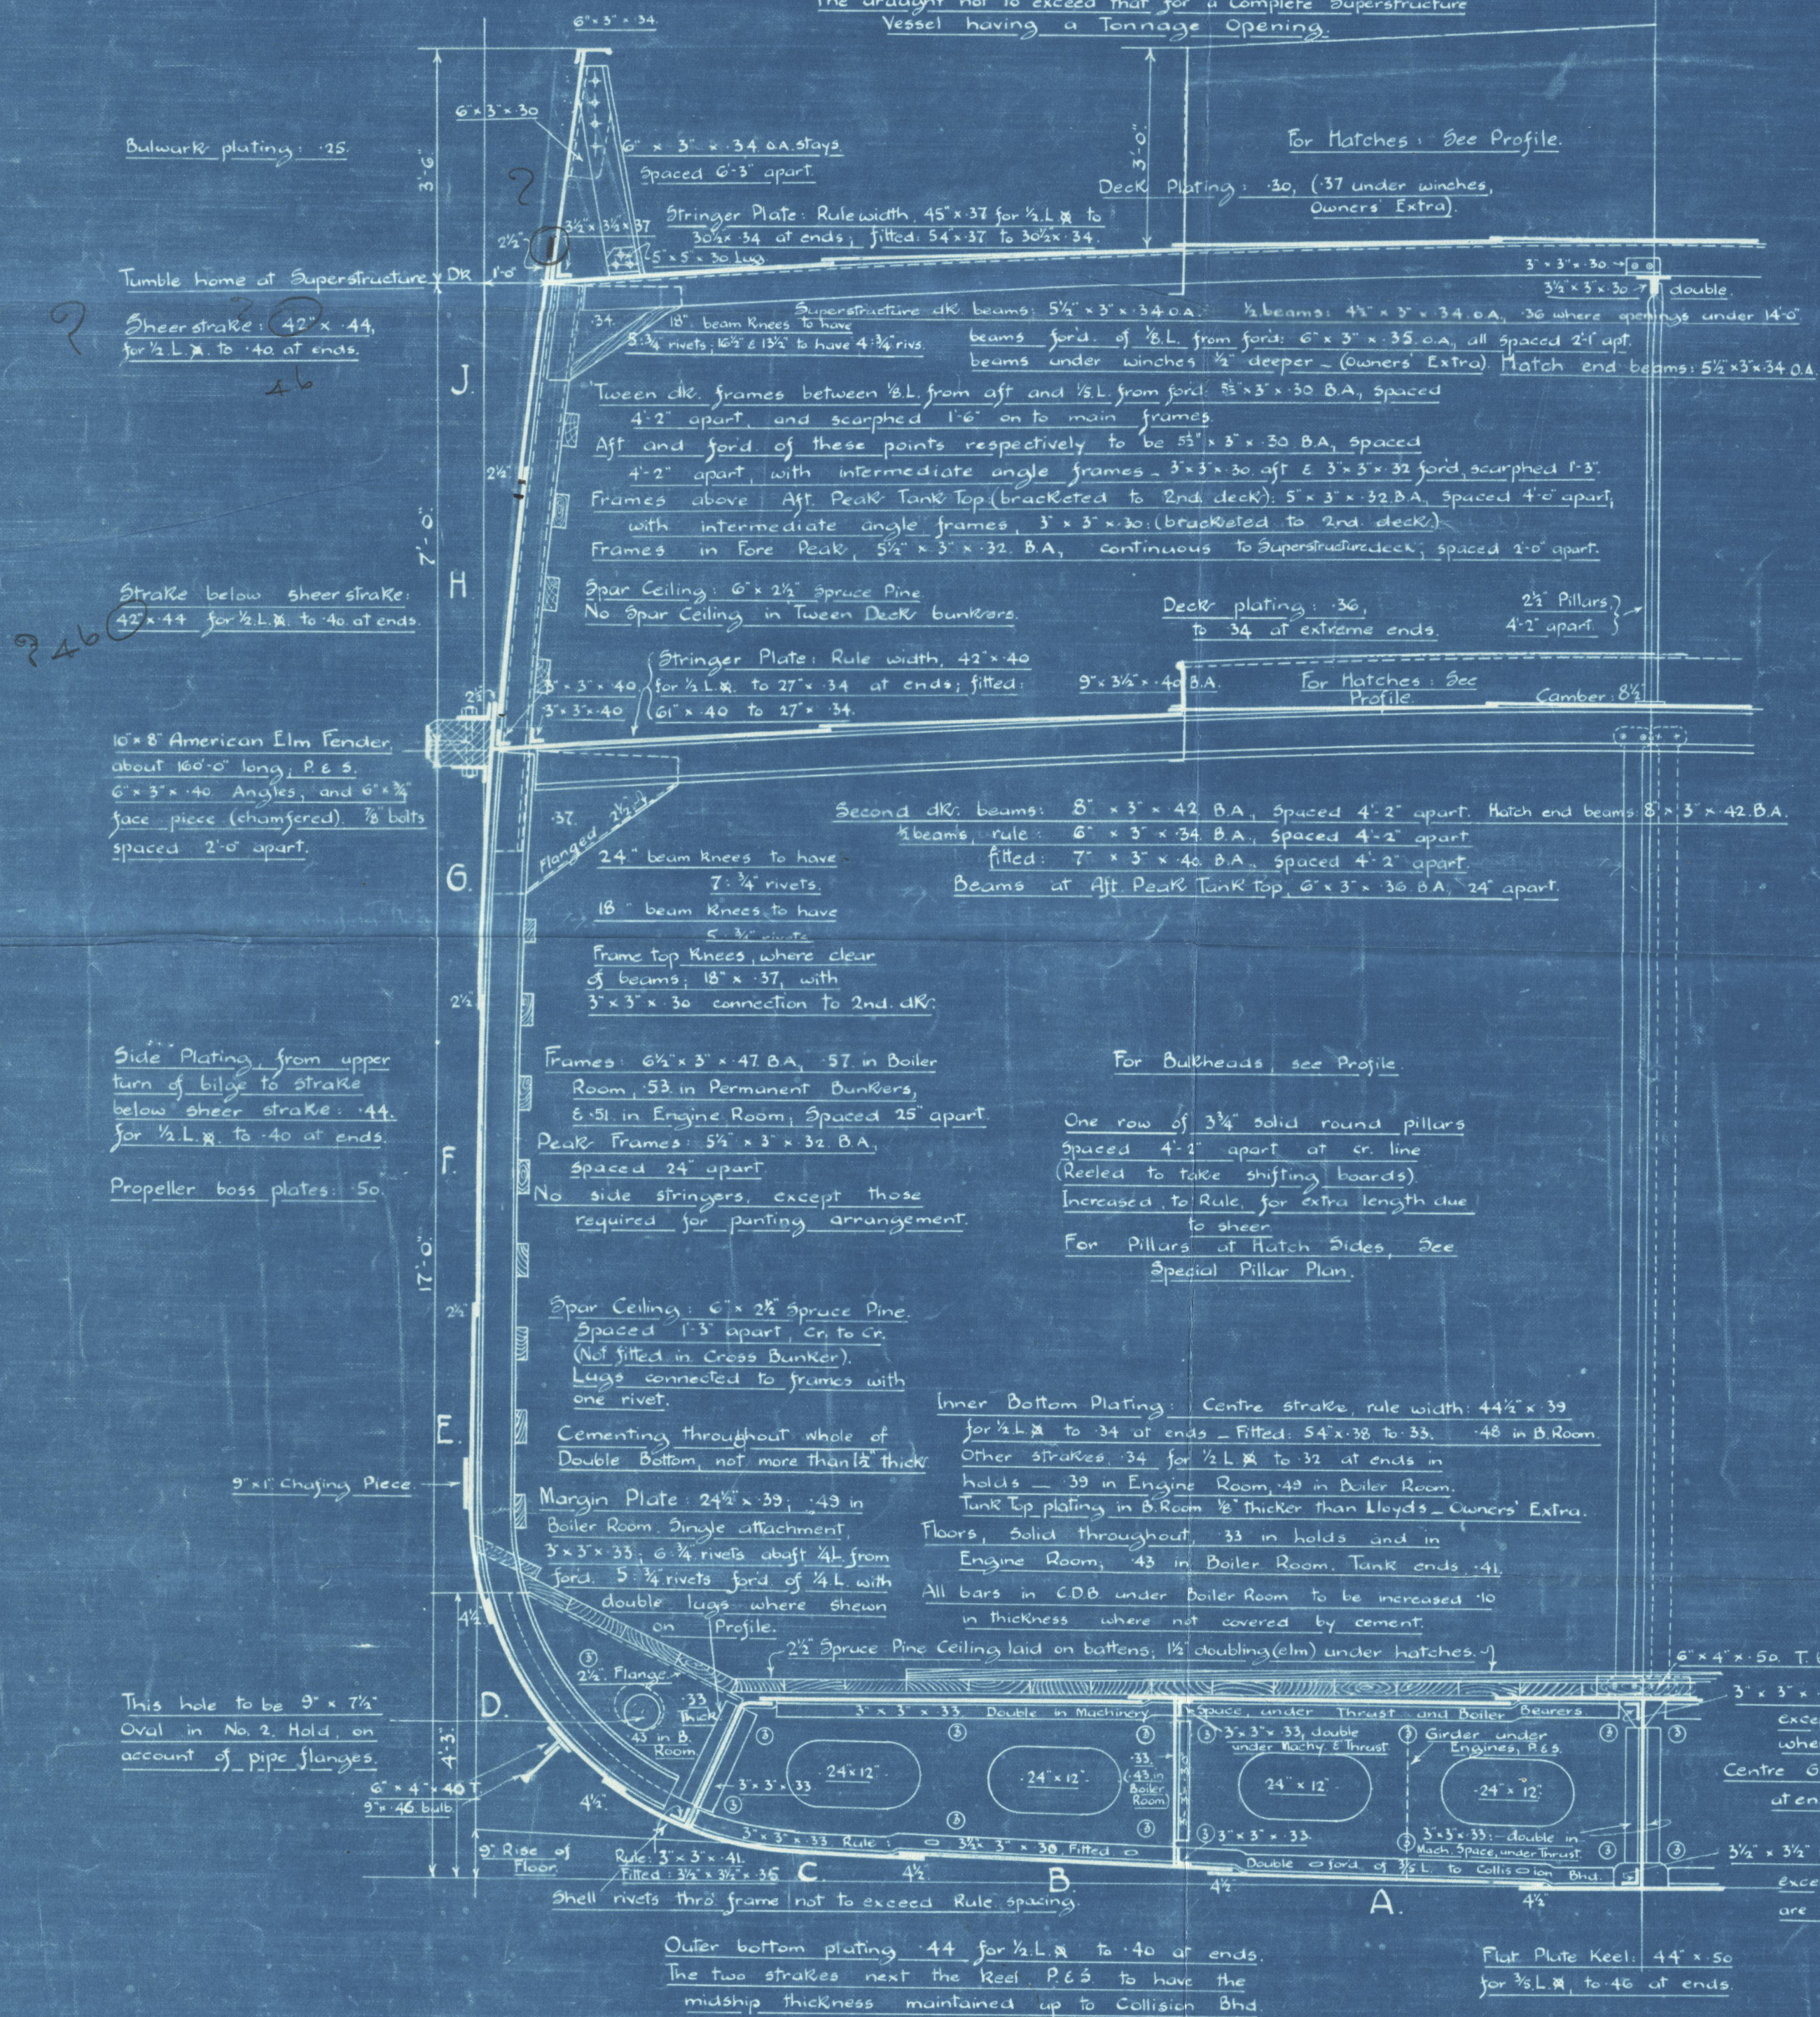

## Lloyd's Numerals

Length.	L.	230.0
Depth.	D.	24.0
First No.	$L \times D.$	5520.0
Breadth.	B.	34.83
Second No.	$L \times (B + D)$	13530.9

Depth to length. (S.D.R.) 9.58.

Depth to 2nd. Deck. 17.00.

Depth of Centre Girder	2.71
------------------------	------

"d" for framing 14.29.

Sheers

Forward:	5.5
$\frac{1}{8}$ L. from fwd	3.025
Aft.	2.5
$\frac{1}{8}$ L. from aft.	1.375

## Erections for Equipment

House aff. 6	$52.33 \times 7 \times \frac{1}{2}$	183.66
Houses 14	$24.5 \times 7 \times \frac{3}{4}$	128.625
<u>Lx(B+D)</u>		13530.9
		13842.585

Equipment: (letter "O").

2	Bowers Anchors (Stockless)	28. each. each.
1	"	24 "
1	Stream Anchor	7 " - ex stock
240	Fathoms 1 3/4" Stud link chain cable.	
75	" 3 3/4" Steel stream wire.	
90	" 3 3/4" Steel wire towline.	
90	" 6" Manilla.	
90	" 5" "	
<u>Owners Extras</u>		
75	Fathoms 3 3/4" Steel wire hawser.	
90	" 5" Manilla.	
90	" 7" "	

## Forgings

Stem:  $7\frac{1}{4}" \times 2"$   
 Stern Post:  $7\frac{1}{4}" \times 5\frac{3}{8}"$   
 Rudder Post:  $6\frac{1}{2}" \times 5\frac{3}{8}"$

List of Riveting:



Sentry - Lyne Iron's 228 -  
Finished Midship Section

---

<sup>S/</sup>"  
<sup>S</sup> Sentry.

*Inv. 78206.*

MIDSHIP SECTION.  
as Built.

---

Medway Boase

---

RETAIN

© 202

003846-003857-0206

Lloyd's Register  
Foundation