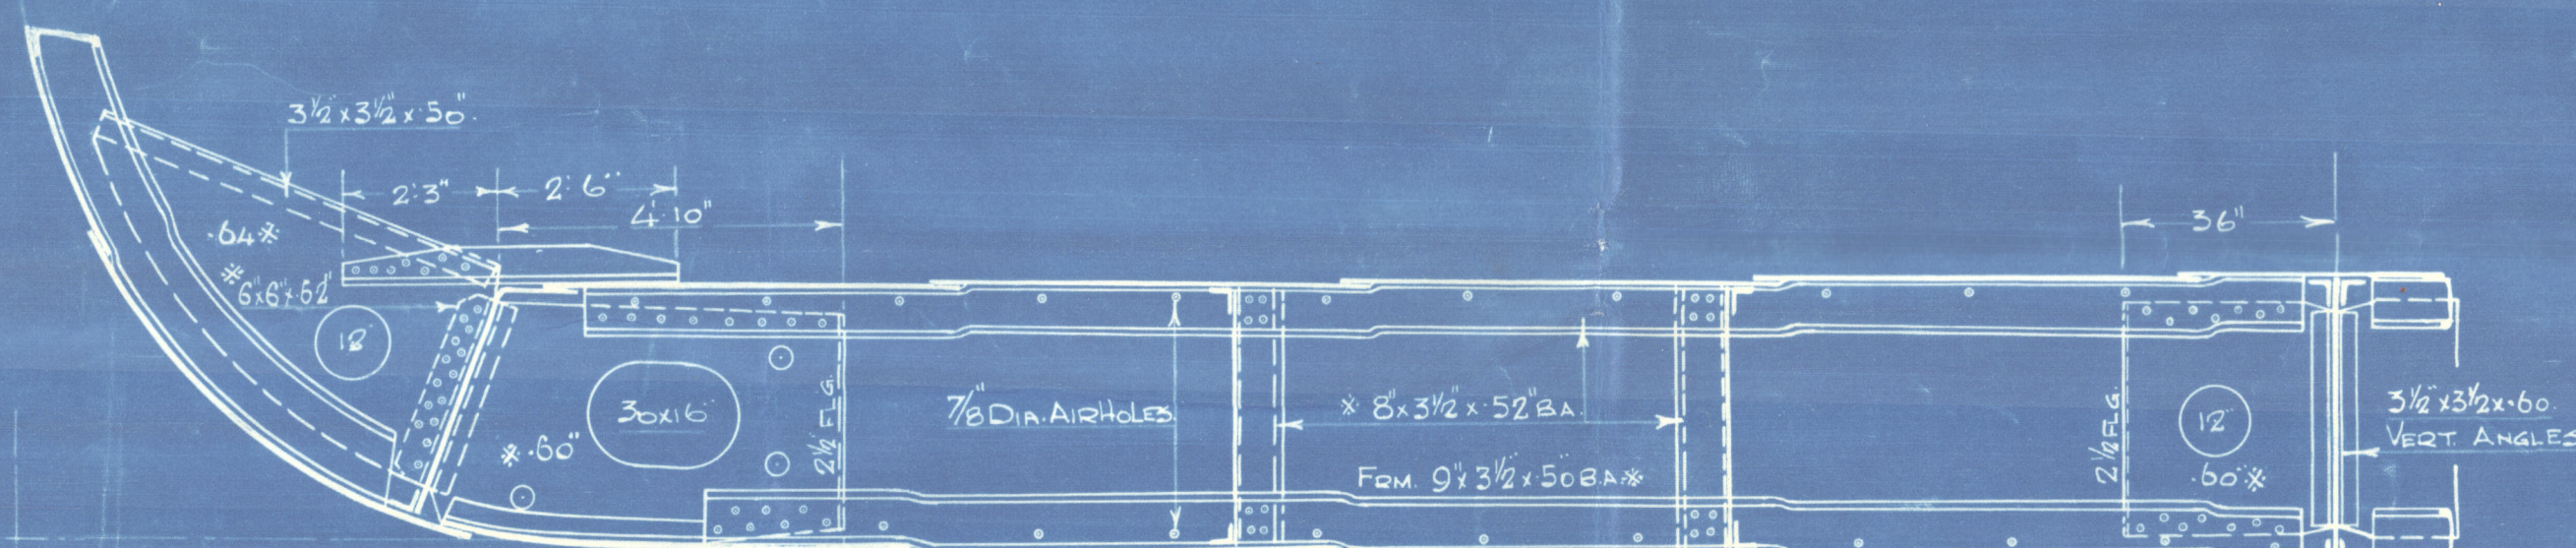
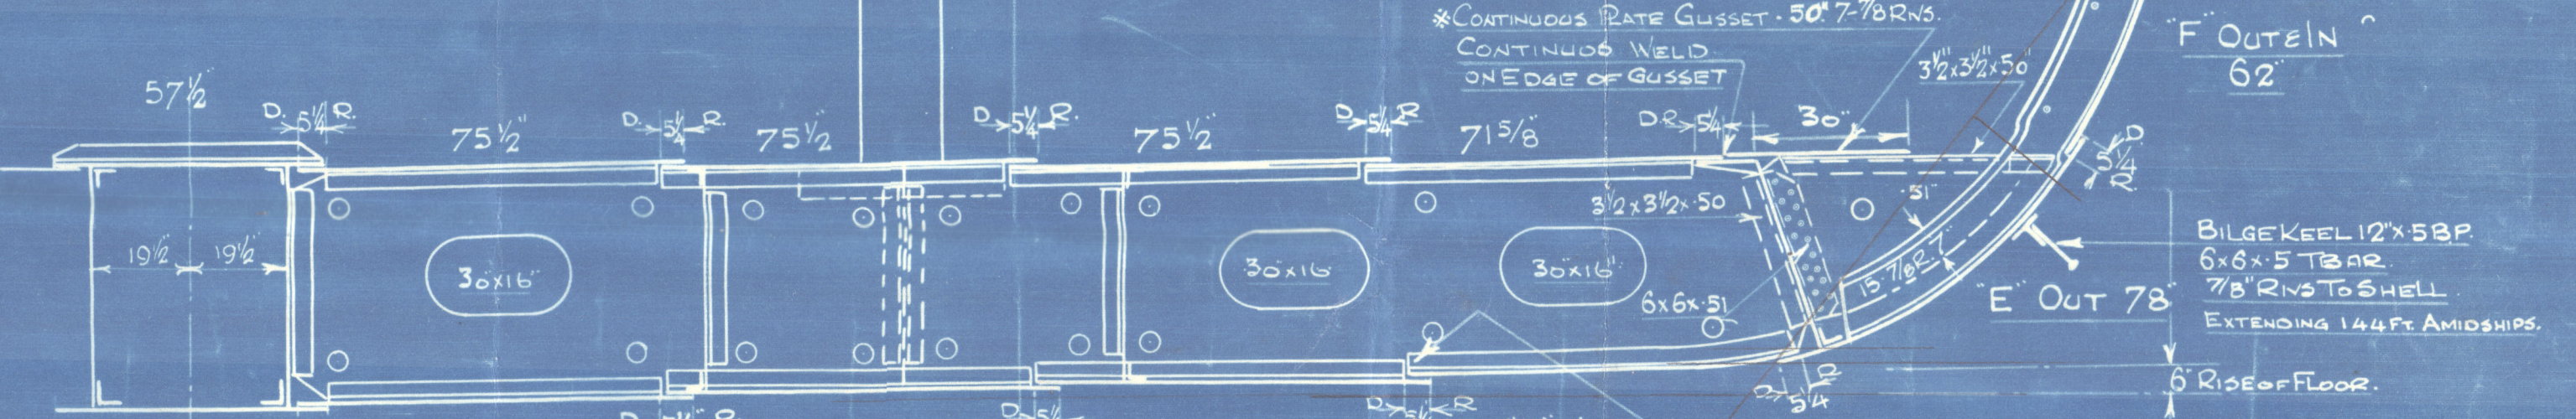


CLAN MACAULAY

1936

[Faint bleed-through from the reverse side of the page]

[illegible]

The Greenk. Dock. Co. L.

T.S.S. No 125

Midship Section
as Built.

T.S.S. CLAN MACAULAY

Gr. 1st E. Ref. No. 20255.

RETAIN



© 2020

Lloyd's Register
Foundation

003958-003963-0118