

S. S. "YEW PARK" № 309

DIMENSIONS:- LENGTH B.P. 195-0

BREATH MLO. 31 - 0"

DEPTH M.L.G. TO UPPER D.K. 14'-0"

RAISED QUARTER DECK 4'-0" ABOVE UPPER DECK

TO CLASS LLOYDS 100 A1.

INNER BOTTOM PLATING INCREASES	.05"
" " WING PLATE "	.02
EXPOSED STEEL DECK PLATES "	.05
BRIDGE & FORECASTLE DECK PLATING OVER SHELL PLATES FORWARD INCREASES	.01'
KEEL PLATE INCREASES .10' & MIDSHIP THICKNESS CARRIED ALL FORM & AFT.	


FORECASTLE DECK.

BEAMS 6" x 8" x 31' B A ON ALTERNATE FRAMES
STRINGER BAR 2" x 2" x 30'
WATERWAY BAR 3" x 3" x 36'
STRINGER PLATE .24
DECK PLATES .24
SIDE PLATING .24"
WOOD DECK 5" x 3" PITCH PINE.

BRIDGE DECK.

BEAMS 6"x3"x21' B.A. ON ALTERNATE FRAMES
STRINGER BAR 3"x3"x30'
WATERWAY BAR 3"x3"x26'
STRINGER PLATE 26"x24'
DECK PLATES 24'
SIDE PLATING 24'
WOOD DECK 4"x2"x2" FITCH PINE

SECTION IN WAY OF BOILER SPACE.

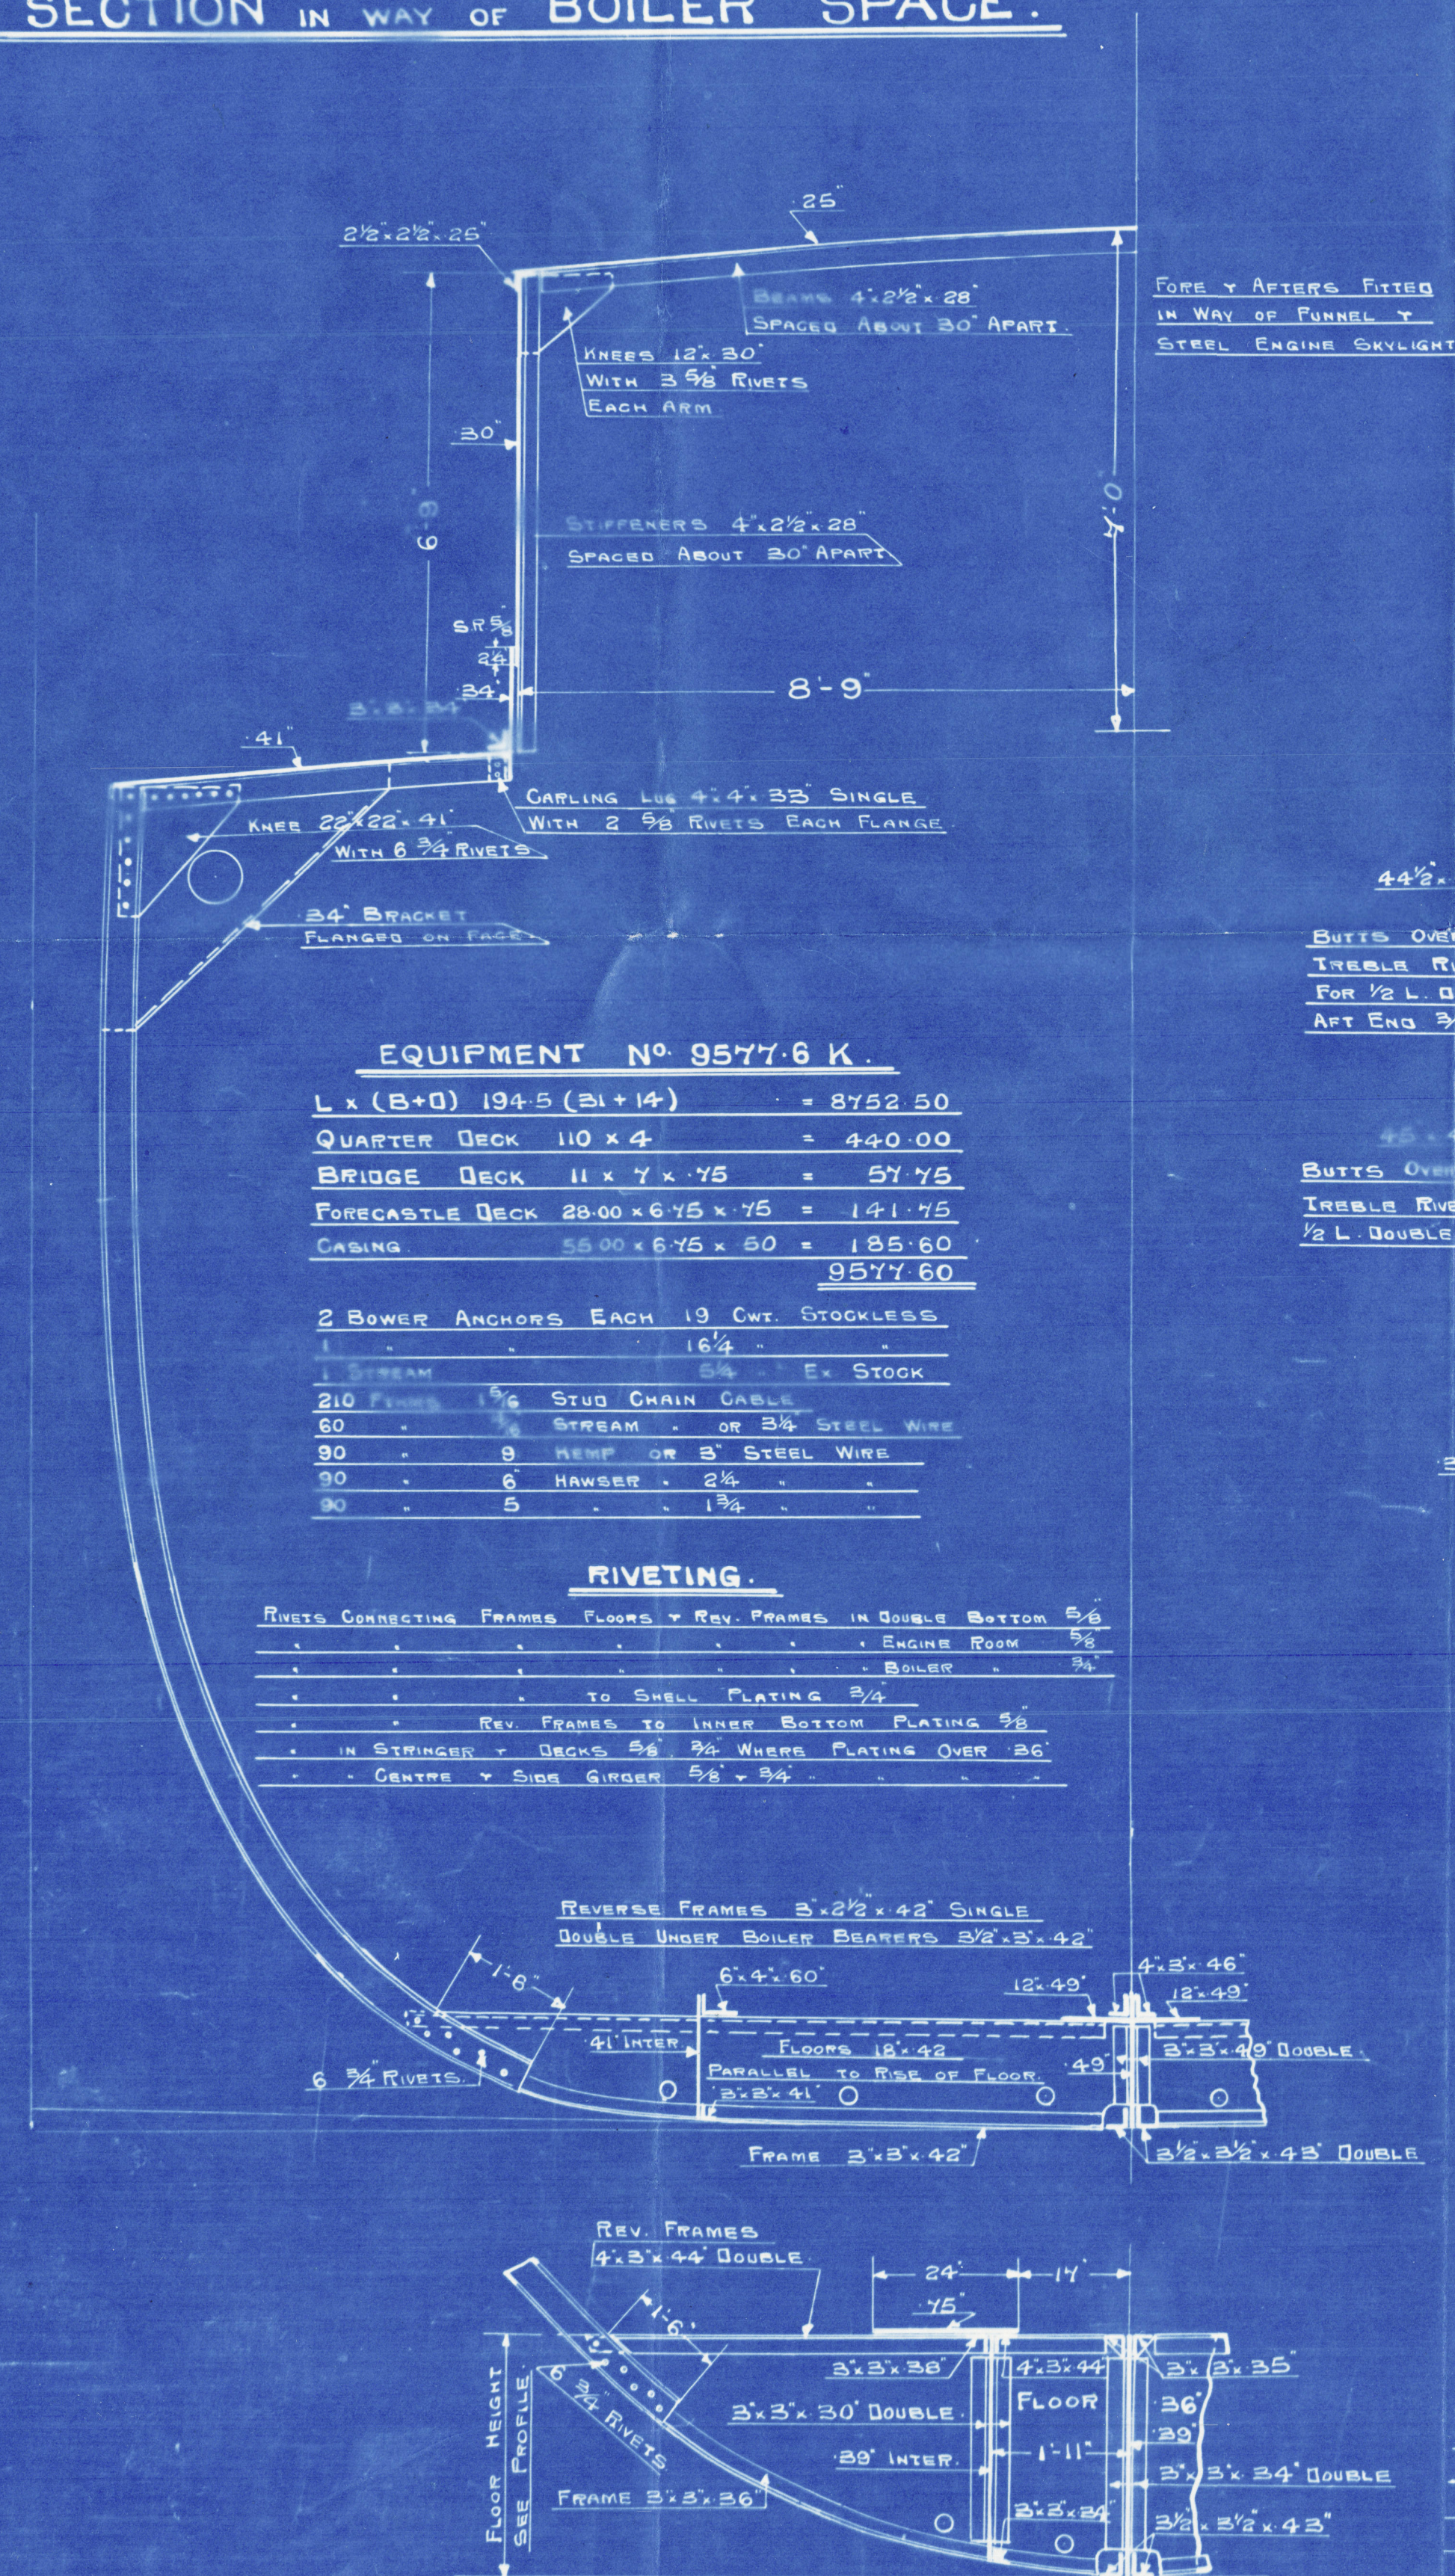

SECTION IN WAY OF QUARTER DECK.

HATCH COAMING	SIDES	44
"	ENDS	44
"	2' 6" PARALLEL ABOVE DECK	

SECTION IN WAY OF UPPER DECK.

HATCH	COAMING	SIDES	44"
"	"	ENDS	44"
"	"	3'6" PARALLEL	ABOVE DECK

HATCH COVERS 11" x 2 3/4" W. PINE.

4" x 3" x 44" DOUBLE.

4" 3" x 4" 11/16"

3" 3" x 5"

CARLING LUGS 4"x4"x42"
SINGLE WITH 2 5/8" RIVET

ES IN WAY OF UPPER DECK 5'2"x33" B.A. SPACE
QUARTER 6'3"x31" B.A.

ON BULKHEADS $3" \times 3"$ AS PER PROFILE
FRAMES IN BOILER ROOM $3" \times 2\frac{1}{2}" \times 42"$ SINGLE D

MEDIANE FRAMES FORWARD 4"x3"x36"
 MS ON EVERY FRAME 6"x3"x31 BA.
 " ALTERNATE FRAMES 6"x3"x34 BA.
 LINGS IN WAY OF HOLDS Y E + B ROOM 4"x3"x

BAR 7 x 1 1/2
DER STOCK 5 1/2" dia
CEMENT

21' x 14'

SINGLE DOUBLE

FORMED OF 1/2 LENGTH

INTER

12' x 6'

3' x 3' x 29'

33. Apt. B
PROPELLER BOSS.

TWO STRAKES OF SHELL
KEEL TO HAVE THE MUD

1990

Crestville
Ex
S/S YEW PARK

—
Messrs Scott & Sons No. 309
—

Midship Section
(as Built).

GLASGOW REPORT No. 50141

RETAIN



© 2020

Lloyd's Register
Foundation

004055-004061-0319