
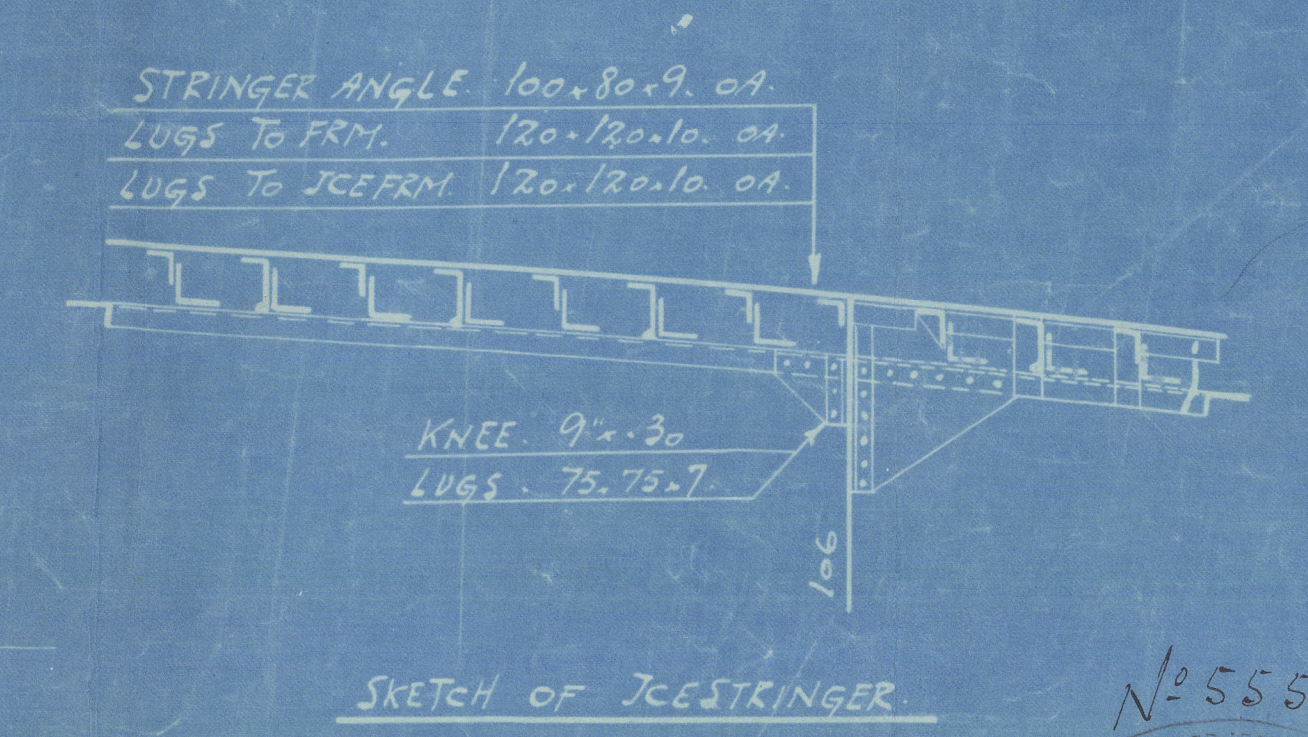


- S/S No. 200 -

DIMENSIONS	
LENGTH BETH. P.P.	265'-0"
BREADTH MOULDED	39'-0"
DEPTH	To UPPERDECK 19'-6"
HEIGHT BETH. UPPER & SECOND DECK	7'-6"
OF POOP & FORECASTLE	7'-6"
DRAFT MOULDED	17'-2 1/2"
SPEED	12 3/4 KNOTS

CLASS: BRITISH LLOYDS 100 A.I. WITH FREEBOARD
 STRENGTHENED FOR NAVIGATION IN ICE
 TYPE: LONG POOP & FORECASTLE
 SHEER FORWARD: 6° 7 1/2"
 AFT: 2° 2"
 MATERIAL: STEEL
 SCALE: 1/4" = 1'-0" OVER
 ALL THICKNESSES IN 100th OF AN INCH

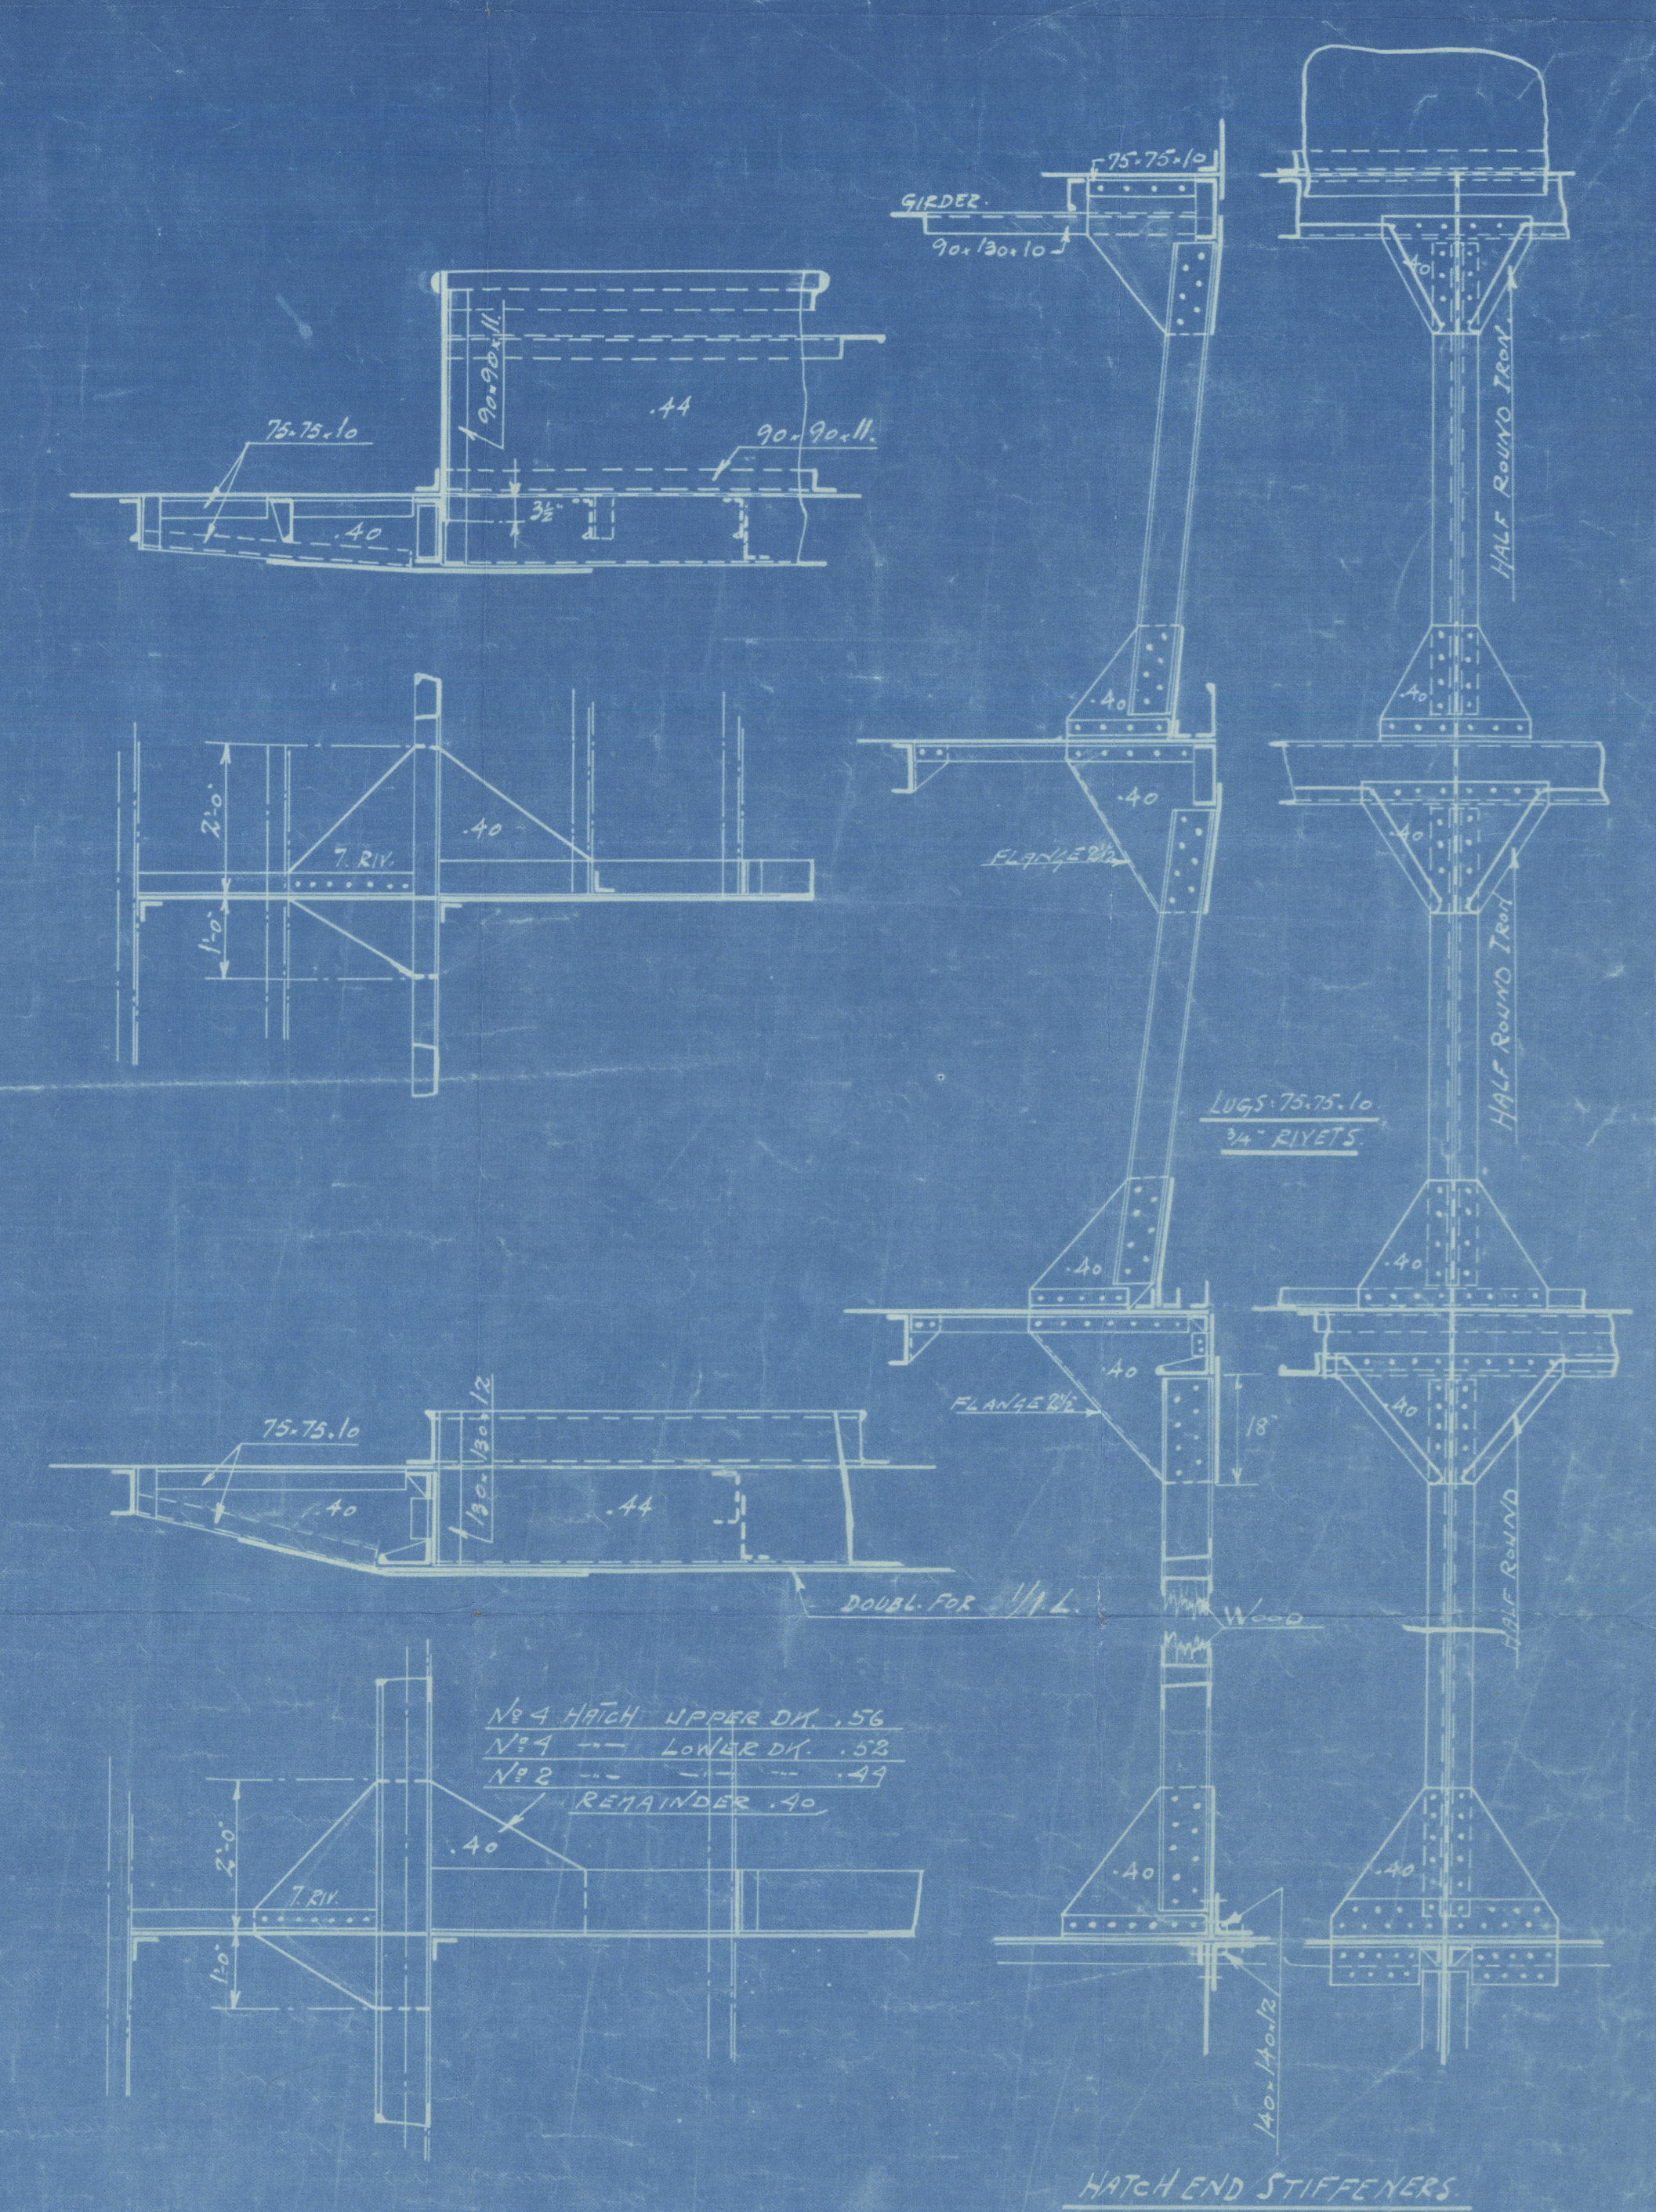


6-3-31
 55558
 LLOYD'S REGISTER FOUNDATION

PROFILE & DECKS (AS BUILT)

S/S ALEXANDRA - YARD N^o 200.

MESSRS A/S HELSINGORS JERN. & MASKE

RETAIN

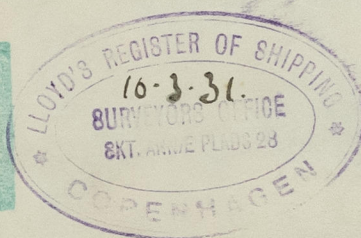

COPENHAGEN REPORT N^o 81574

Alexandra



© 2020

Lloyd's Register
Foundation

004116-004124-0129