

N^o 68-9

MIDSHIP SECTION

SCALE 1/2" = 1 FOOT

DIMENSIONS 460'-0" BP x 59'-0" MLD x 34'-0" MLD TO UPPER DECK

CLASS LLOYDS 100A1* CARRYING PETROLEUM IN BULK

SPECIAL NOTATION LONGITUDINAL FRAMING AT BOTTOM AND AT DECK

SCANTLINGS INCLUDING SHELL CLEAR OF CARGO OIL

COMPARTMENTS TO BE SPECIALLY CONSIDERED

SUITABLE INCREASES TO BE MADE FOR SHEER AT ENDS


STEM 10 1/4" x 2 1/4"

BULB ANGLES ALL N B S.

APPROVED BY LLOYDS 27-12-40

NUMERALS		
1 st LONGITUDINAL	L-10 x 460'-0" x 34'-0"	15043
2 nd	L-10 x 460'-0" x 34'-0"	15043
3 rd	L-10 x 460'-0" x 34'-0"	15043
RULE EQUIPMENT		
2 nd LONGIT.	No.	42780
POOP	34'-42" x 17'-5" x 17'-5"	591
BRIDGE	46'-36" x 17'-5" x 17'-5"	262
FOCLE	48'-28" x 17'-5" x 17'-5"	262
HOUSE ON POOP	8'-10" x 17'-5" x 17'-5"	304
HOUSE ON BRIDGE	42'-3" x 17'-5" x 17'-5"	59
UPPER	40'-3" x 17'-5" x 17'-5"	50
LOWER	42'-0" x 17'-5" x 17'-5"	197
EQUIPMENT NUMERALS		44613

2 BOWER ANCHORS	7 1/2" CENTS EACH STOCKLESS	
1 STREAM	22" EX STOCK	
240 FATHOMS	2 1/2" STUD CHAIN CABLE	
120	1 1/2" STUD CHAIN OR 5 FLEXIBLE STEEL WIRE 6" x 2	
120	5/4 SPECIAL FLEXIBLE STEEL WIRE 6" x 2	
8 HANGERS	100 FATHOMS 2 1/4" FLEXIBLE STEEL WIRE 6" x 2	(3/4" HANGERS SPECIFIED)
2 WARPS	100	2 1/4" 6" x 2 (3/4" WARPS)

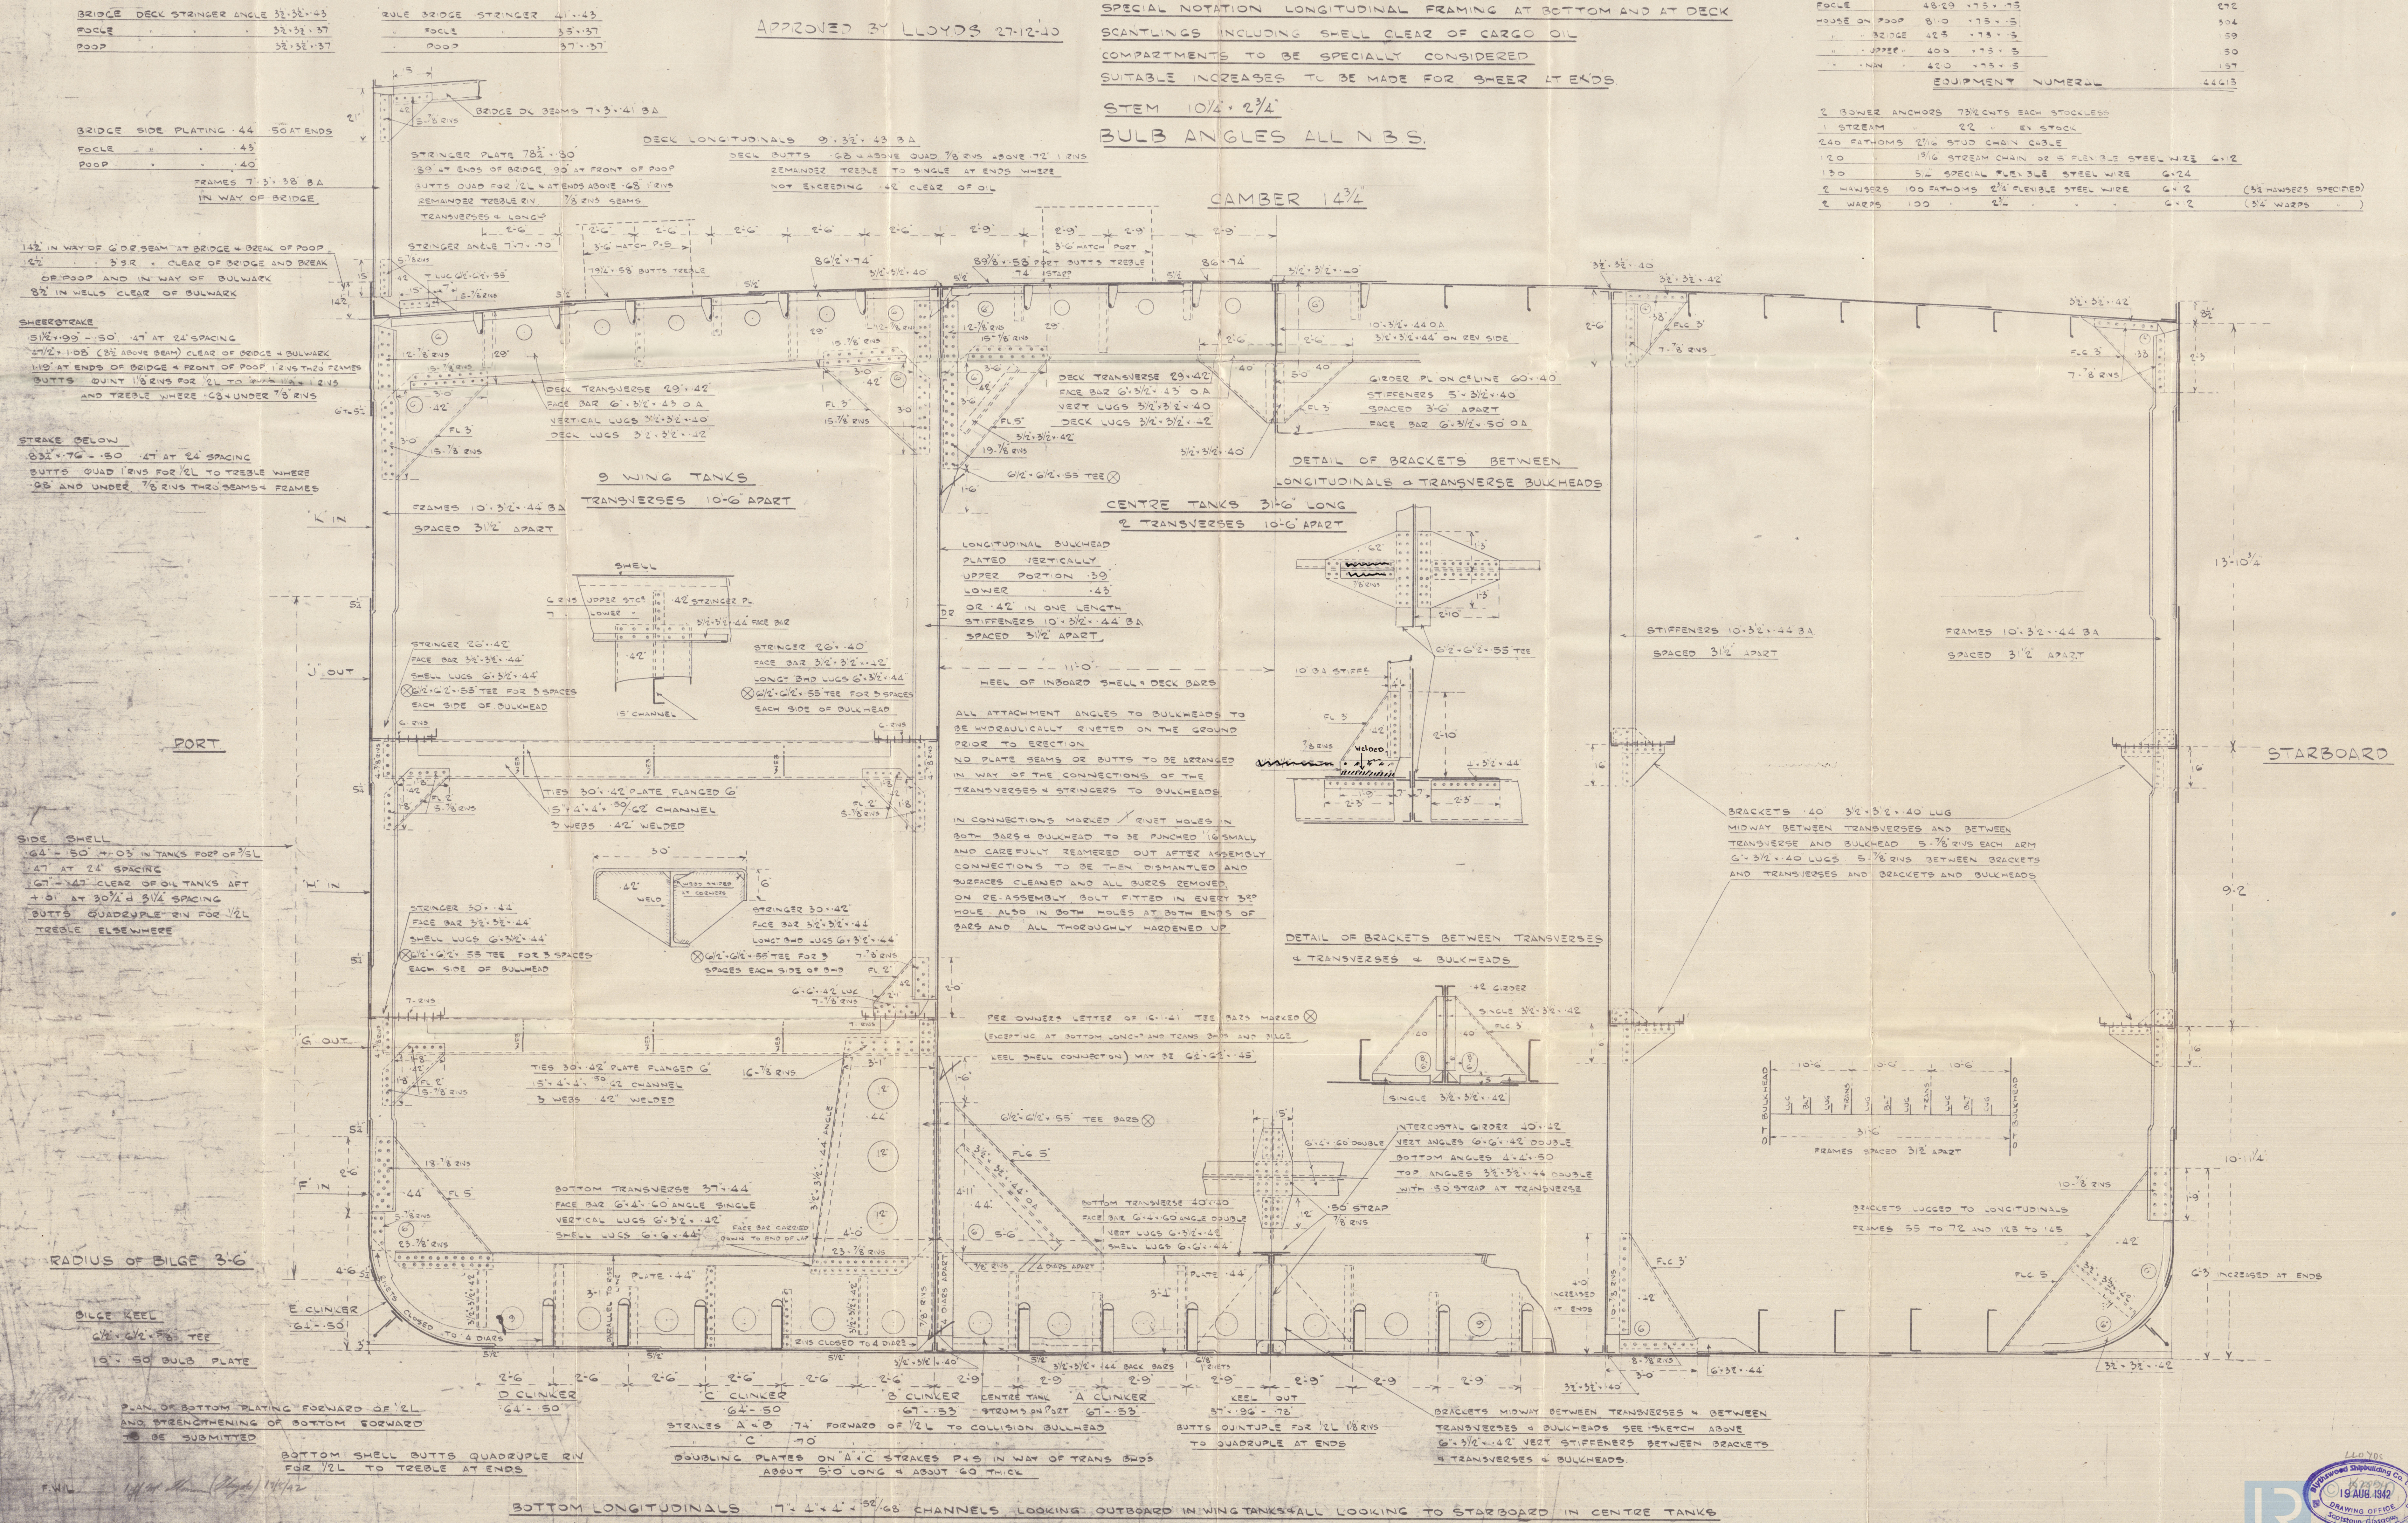

BOTTOM LONGITUDINALS 17'-1'-4" x 58' CHANNELS LOOKING OUTBOARD IN WING TANKS & ALL LOOKING TO STARBOARD IN CENTRE TANKS



M/S. "NASSA." *

(68)

BLYTHSWOOD S. B. CO LTD.

MIDSHIP SECTION.

(AS BUILT.)

GLASGOW REPORT No. 65980

(Sister Vessel "Donacilla"
Yard No 57)

RETAIN

© 2020
Lloyd's Register
Foundation

005082-005088-0147