



S. S. No 559

SCALE 1/8" = 1 FOOT.

T.S.S. "SAN CASTO."

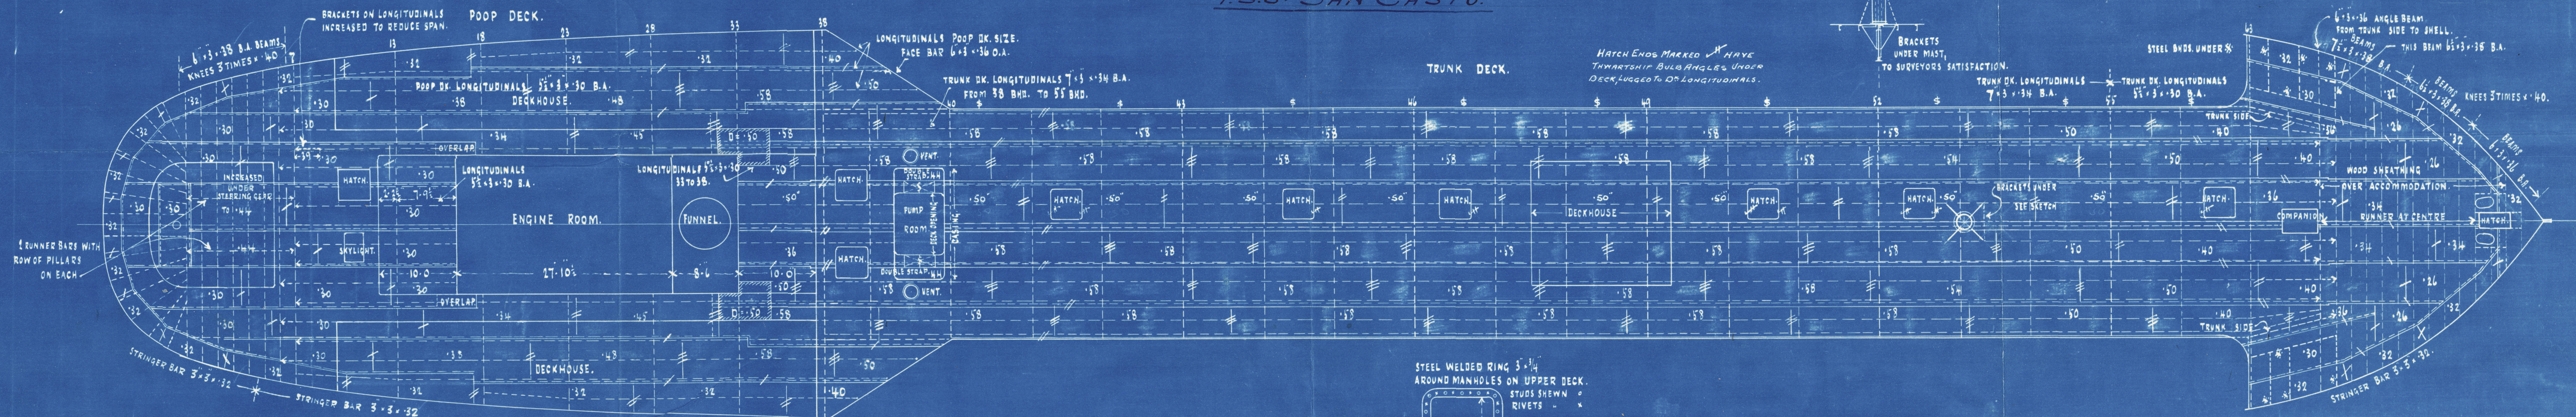


STEEL WELDED RING 3/4" AROUND MANHOLES ON UPPER DECK.

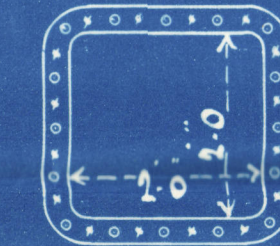

DECK COVER.
3/4" x 5" STEEL RING.
GRUMMET.
7/8" STUDS & NUTS
STUDS SCREWED THROUGH RING.

UPPER DECK.

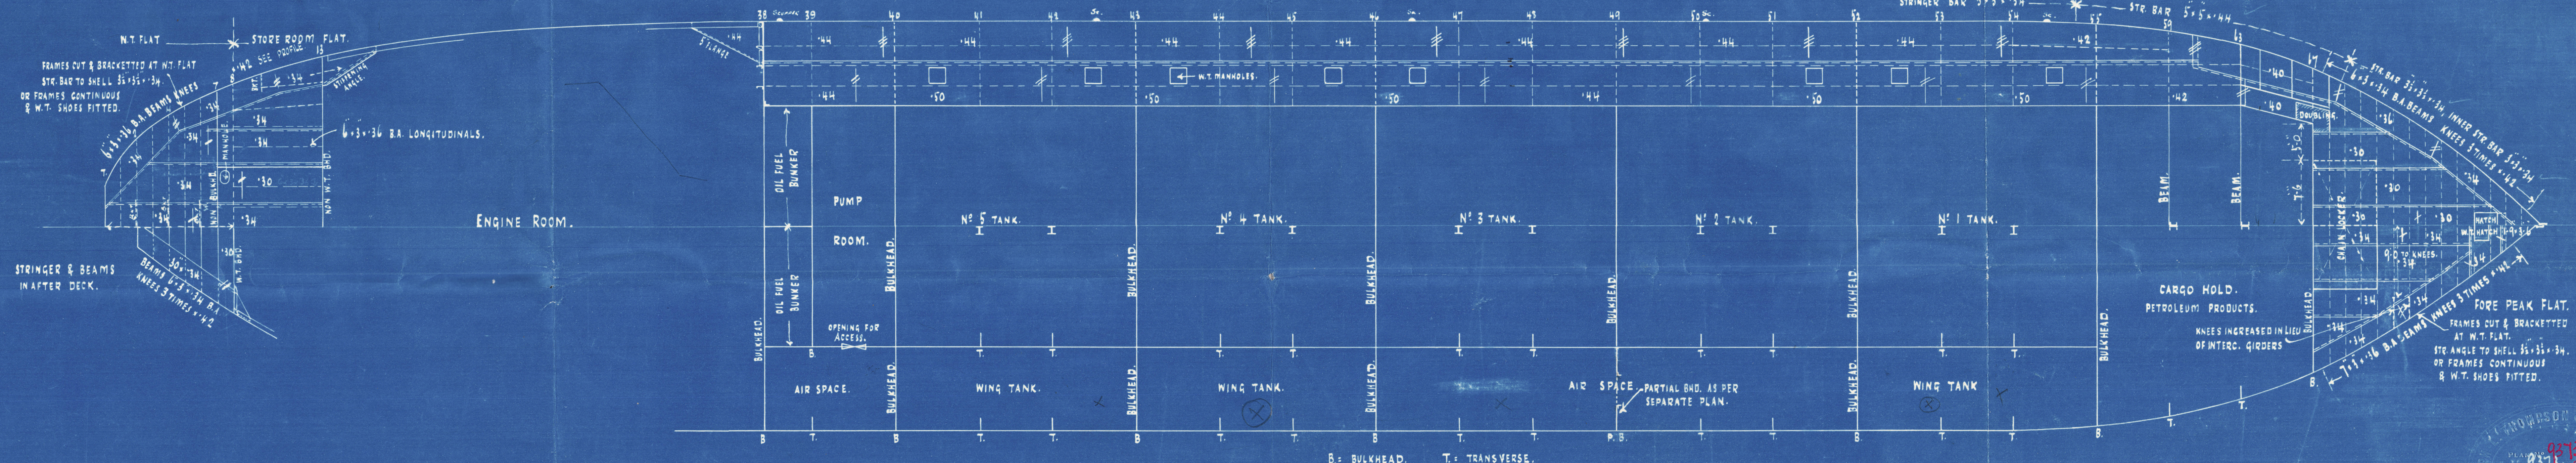

B. = BULKHEAD. T. = TRANSVERSE.



005321-005324-0046

Sunderland
J. L. Thompson & Sons.

- No 559. -

T.S.S. "SAN CASTO."

Deck Plan

(as built).

SUNDERLAND RPT. NO. 29637



© 2020

Lloyd's Register
Foundation

005321-005324-0046