

M.S. Port Chalmers

Swan Hunter No 1483

Midship Section
As Built

S.S. "PORT CHALMERS".
NEWCASTLE ON TYNE.

Report No. 90866



© 2020

Lloyd's Register
Foundation

005363-005357-0003


OF GIRDERS

TTED FOR APPROVAL.

TANKS.)


9" x 3 1/2" x 3/8" x .40 x .54 CHAN.
WITH 3 1/2" x 3" x .40 O.A. REVERSE

SIZE OF BEAMS AND BEAM KNEES AT
SECOND DECK IN NOS 2, 3 & 4 TWEEN
DECKS AND INSULATED STORE ROOMS

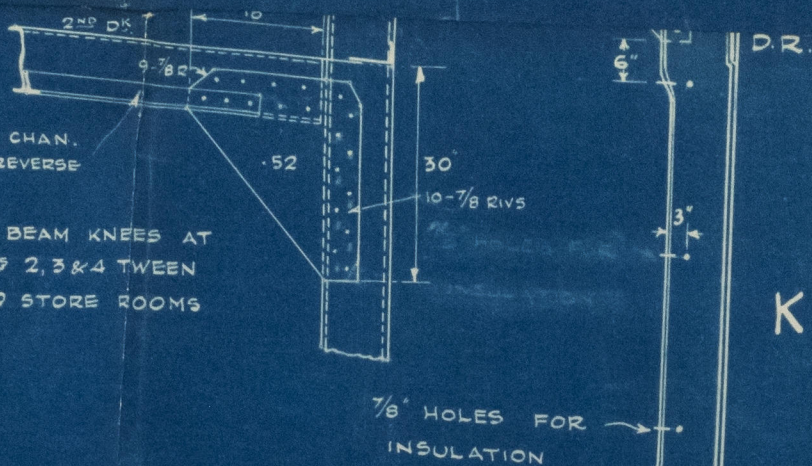

STRINGER 53 1/2" x .40" FOR 1/2 L TO
39 1/2"

SHELL LANDINGS AT BOTTOM OF "M"
& TOP & BOTTOM OF "K" TO BE 3/4" WIDER
ABREAST HATCHES WITH EDGE OF
PLATE CHAMFERED OFF

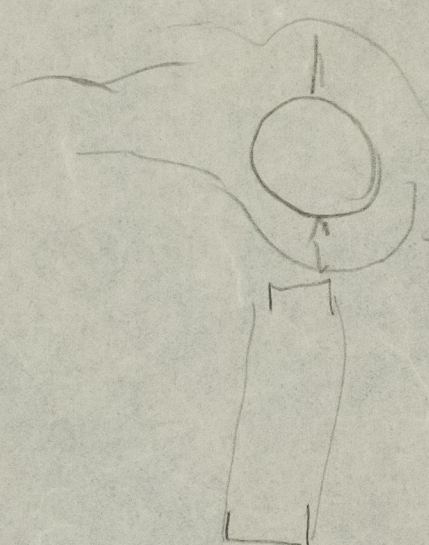

005353-005357-0003