

AFT PEAK W.T. BULKHEAD.
PLATING 26 TO 34 BOTTOM PLATE 40.
STIFFERS 11x3 1/2 x 48 TO 56 B.A.
SPACED 2'-0" APART.
FRAME 5'x5'x48 SINGLE.
BATS 18'x3'-3/4 2 RIVETS.

W.T. BULKHEAD ON 74 FR.
PLATING 26 TO 34 BOTTOM PLATE 40.
STIFFERS 11x3 1/2 x 48 TO 56 B.A.
SPACED 2'-0" APART.
FRAME 5'x5'x48 SINGLE.
BATS 33x44 PLANGED 8'-1/2 RIVETS.

W.T. BULKHEAD ON 72 FR.
PLATING 26 TO 34 BOTTOM PLATE 40.
STIFFERS 10x3 1/2 x 52 TO 62 B.A.
SPACED 2'-0" APART.
FRAME 5'x5'x44 SINGLE.
BATS 31x44 PL. 7'-8 RIVETS.

PROFILE & DECK PLANS. S.S.240.


LENGTH 356'3" B.P. BREADTH EXT 48'9". DEPTH MLD 25'11".

SCALE 1/8" = 1 FOOT


W.T. BULKHEAD ON 94 FR.
PLATING 26 TO 34 BOTTOM PLATE 44.
STIFFERS 10x3 1/2 x 52 TO 62 B.A.
SPACED 2'-0" APART.
FRAME 5'x5'x44 SINGLE.
BATS 31x44 PLANGED 7'-8 RIVETS.

W.T. BULKHEAD ON 137 FR.
PLATING 26 TO 34 BOTTOM PLATE 48.
STIFFERS 11x3 1/2 x 66 TO 72 B.A.
SPACED 2'-0" APART.
FRAME 5'x5'x48 SINGLE.
BATS 34x44 PLANGED 8'-1/2 RIVETS.

FORE PEAK W.T. BULKHEAD.
PLATING 26 TO 34 BOTTOM PLATE 48.
STIFFERS 11x3 1/2 x 66 TO 72 B.A.
SPACED 2'-0" APART.
FRAME 5'x5'x48 SINGLE.
BATS 34x44 PLANGED 8'-1/2 RIVETS.

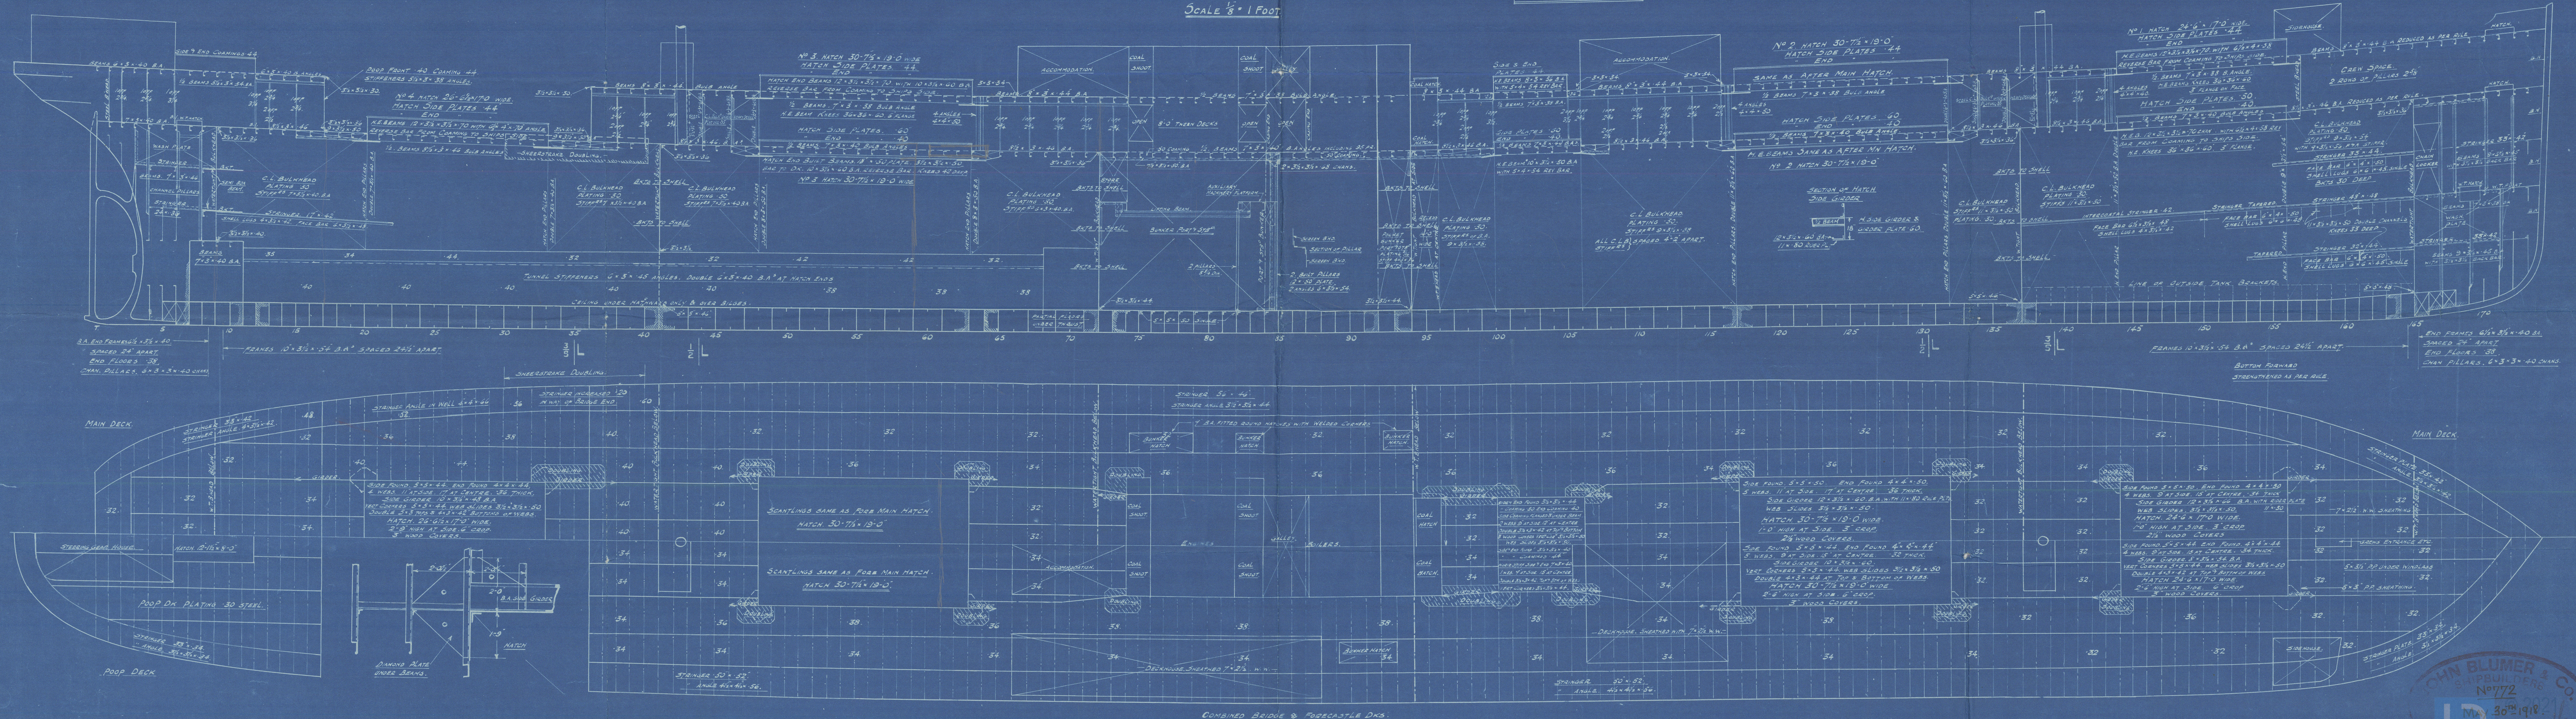

COMBINED BRIDGE & FORECASTLE DECKS.

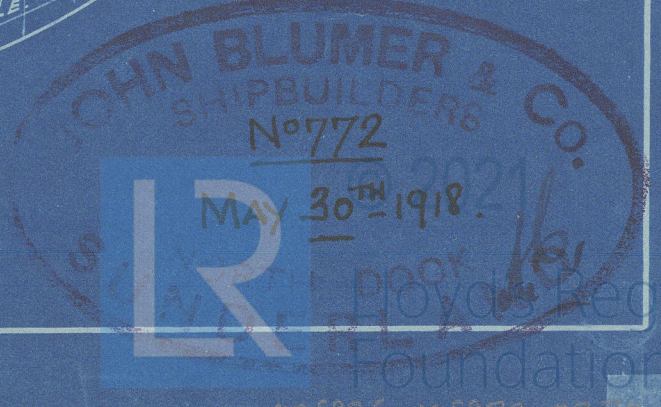

n/nc "Bonifacio"

WULSTY CASTLE


J BLUMER & CO

No 240

PROFILE

AS BUILT

SUNDERLAND RPT. No. 27274

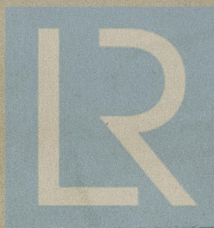

© 2021

Lloyd's Register

Foundation

005826-005839-0270