

SHADE DECK RIVETING

ITEM	DIAM.	SPACING
S.R. 2 1/2" SEAMS	5/8"	2 1/2" C#
BEAMS TO DECK	5/8"	4 1/2"
STRINGER ANGLE TO DECK AND CURTAIN	5/8"	2 1/2"
WATERWAY ANGLE TO DECK	5/8"	4 1/2"
HOUSE FOUNDATIONS TO DECK	5/8"	3 1/2"

UPPER DECK RIVETING


ITEM	DIAM.	SPACING
T.R. 7 1/2" AND D.R. 5" BUTTS OF STRINGER	5/8"	2 1/2" C#
D.R. 4 1/2" BUTTS OF STRINGER PLATE	5/8"	4 1/2"
S.R. 2 1/2" SEAMS	5/8"	3 1/2"
S.R. 2 1/2" SEAMS	5/8"	2 1/2"
BEAMS TO DECK AT EVERY FRAME	5/8"	4 1/2"
BEAMS TO DECK AT ALT. FRAME	5/8"	3 1/2"
STRINGER ANGLE TO DECK & SHELL	5/8"	3 1/2"
WATERWAY ANGLE TO DECK	5/8"	4 1/2"
BULKHEAD BOUNDARY TO DECK & SHELL	5/8"	3 1/2"
HATCH, CASING & HOUSE FOUNDATIONS	5/8"	3 1/2"

NO 292 SHIP PROFILE & DECK PLAN

SCALE 1/8" = 1 FOOT
AS BUILT



DESIGNED BY
DATE: 28-6-37

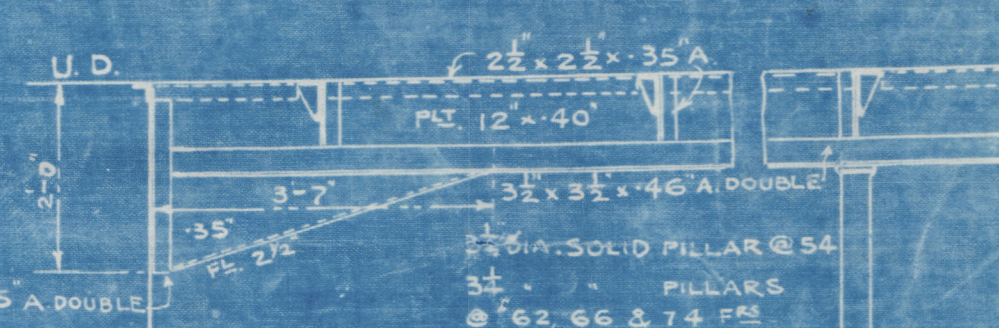

TO BE MADE FROM PILLAR & GIRDER PLAN



"Antonia"
(Sister to "Governor Wright")

Profile and Decks

006749-006759-0002



© 2021.

Lloyd's Register
Foundation