




# PROFILE & DECK PLANS

Scale 1/8" = 1 Foot

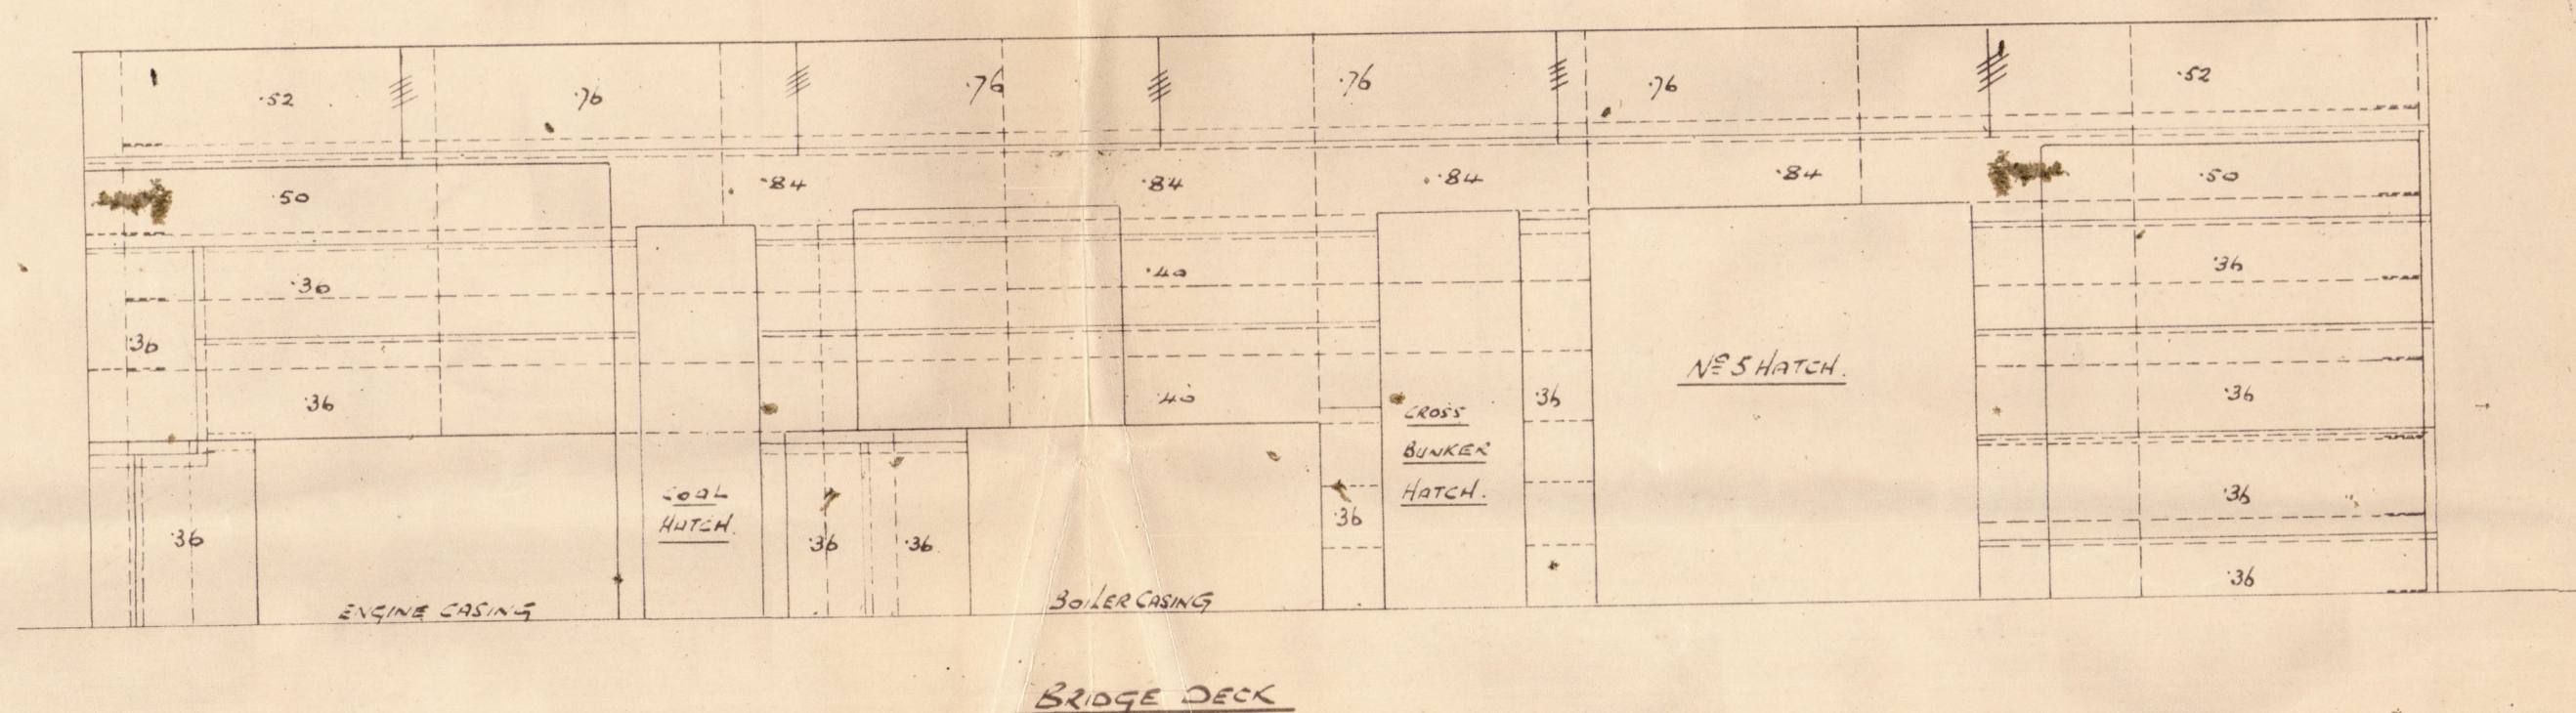

S.S. MASKINONGE

No 365

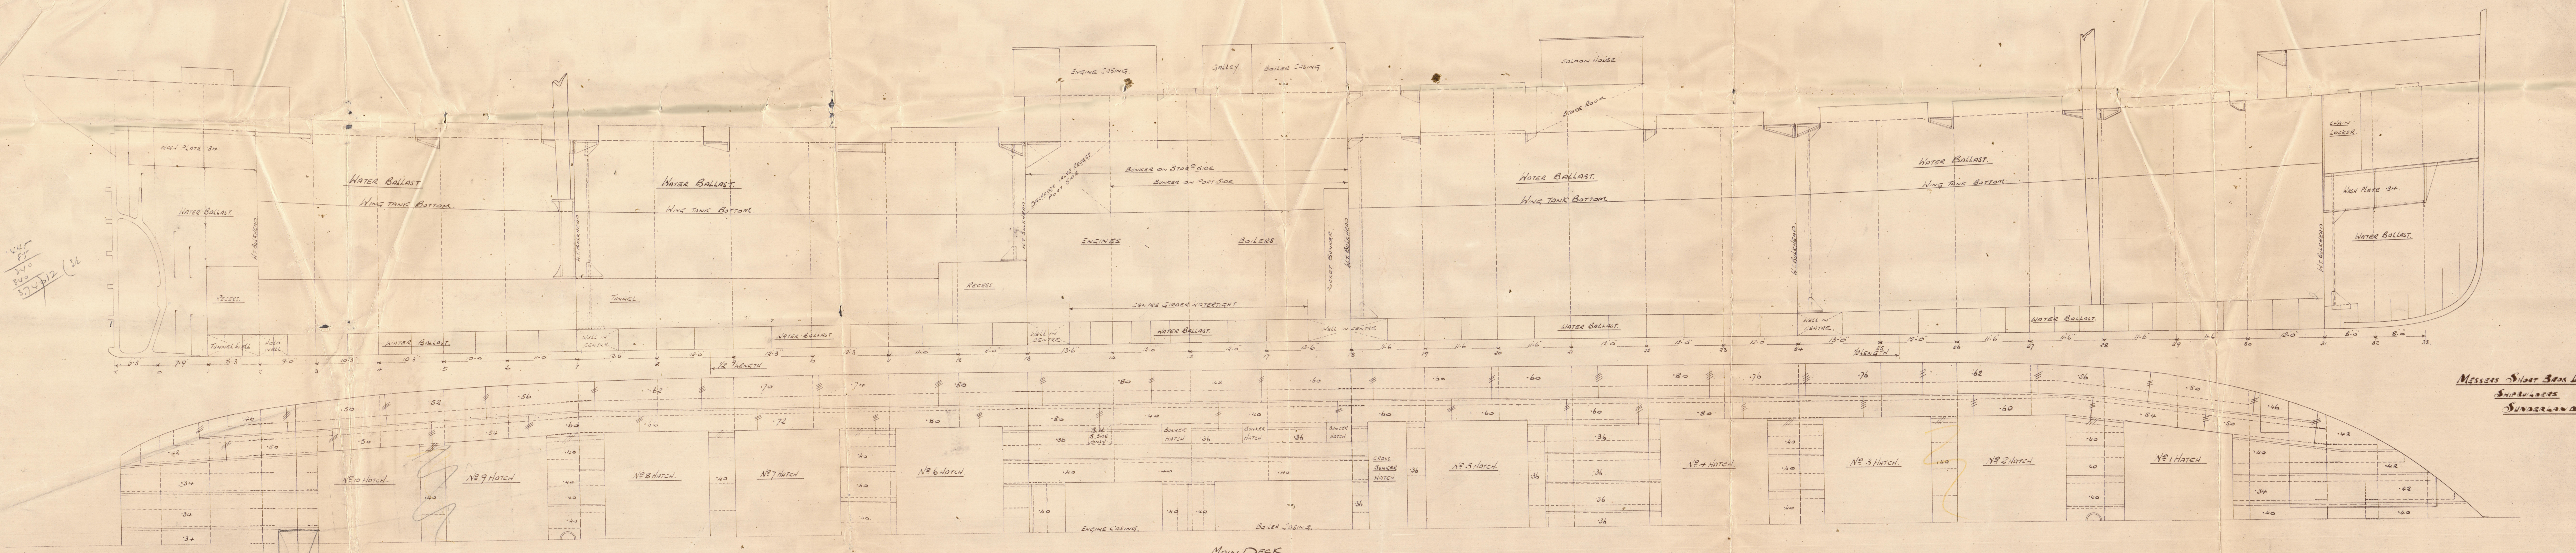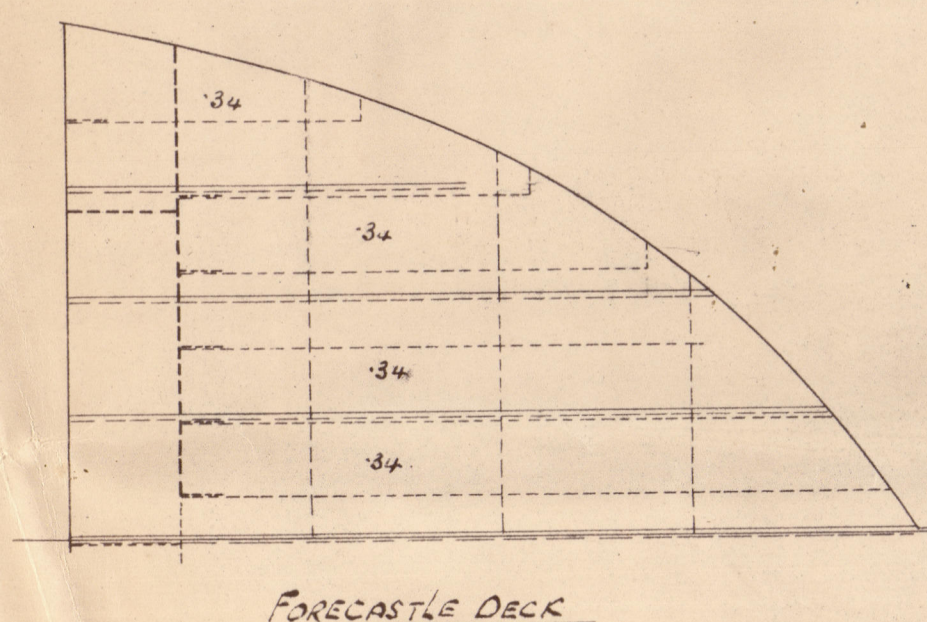

Messrs. Silver Star Line  
Supercargo







Messrs Short Bros

PROFILE & DECK PLANS.  
*as built*

S.S. "MASKINONGE"

No. 365.

Lo. Report No. 25183

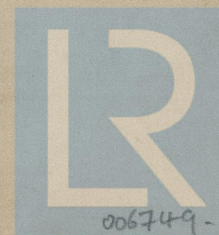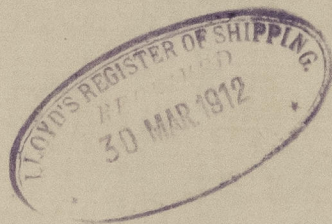

© 2021

Lloyd's Register  
Foundation

006749-006759-0216