
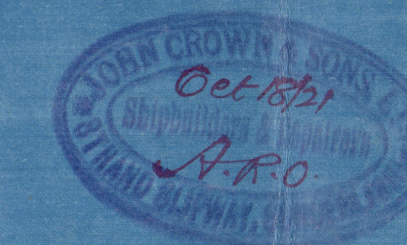


PROFILE TO CLASS 100 A.I. AT LLOYDS Length B.P. = 270'-0", Breadth Mid. 38'-0", Depth Mid. 20'-6"

Scale 1/8" = 1 Foot

CORRECTED AS FITTED IN SHIP
 18/10/21
 A.R.O.

Nos 166-7

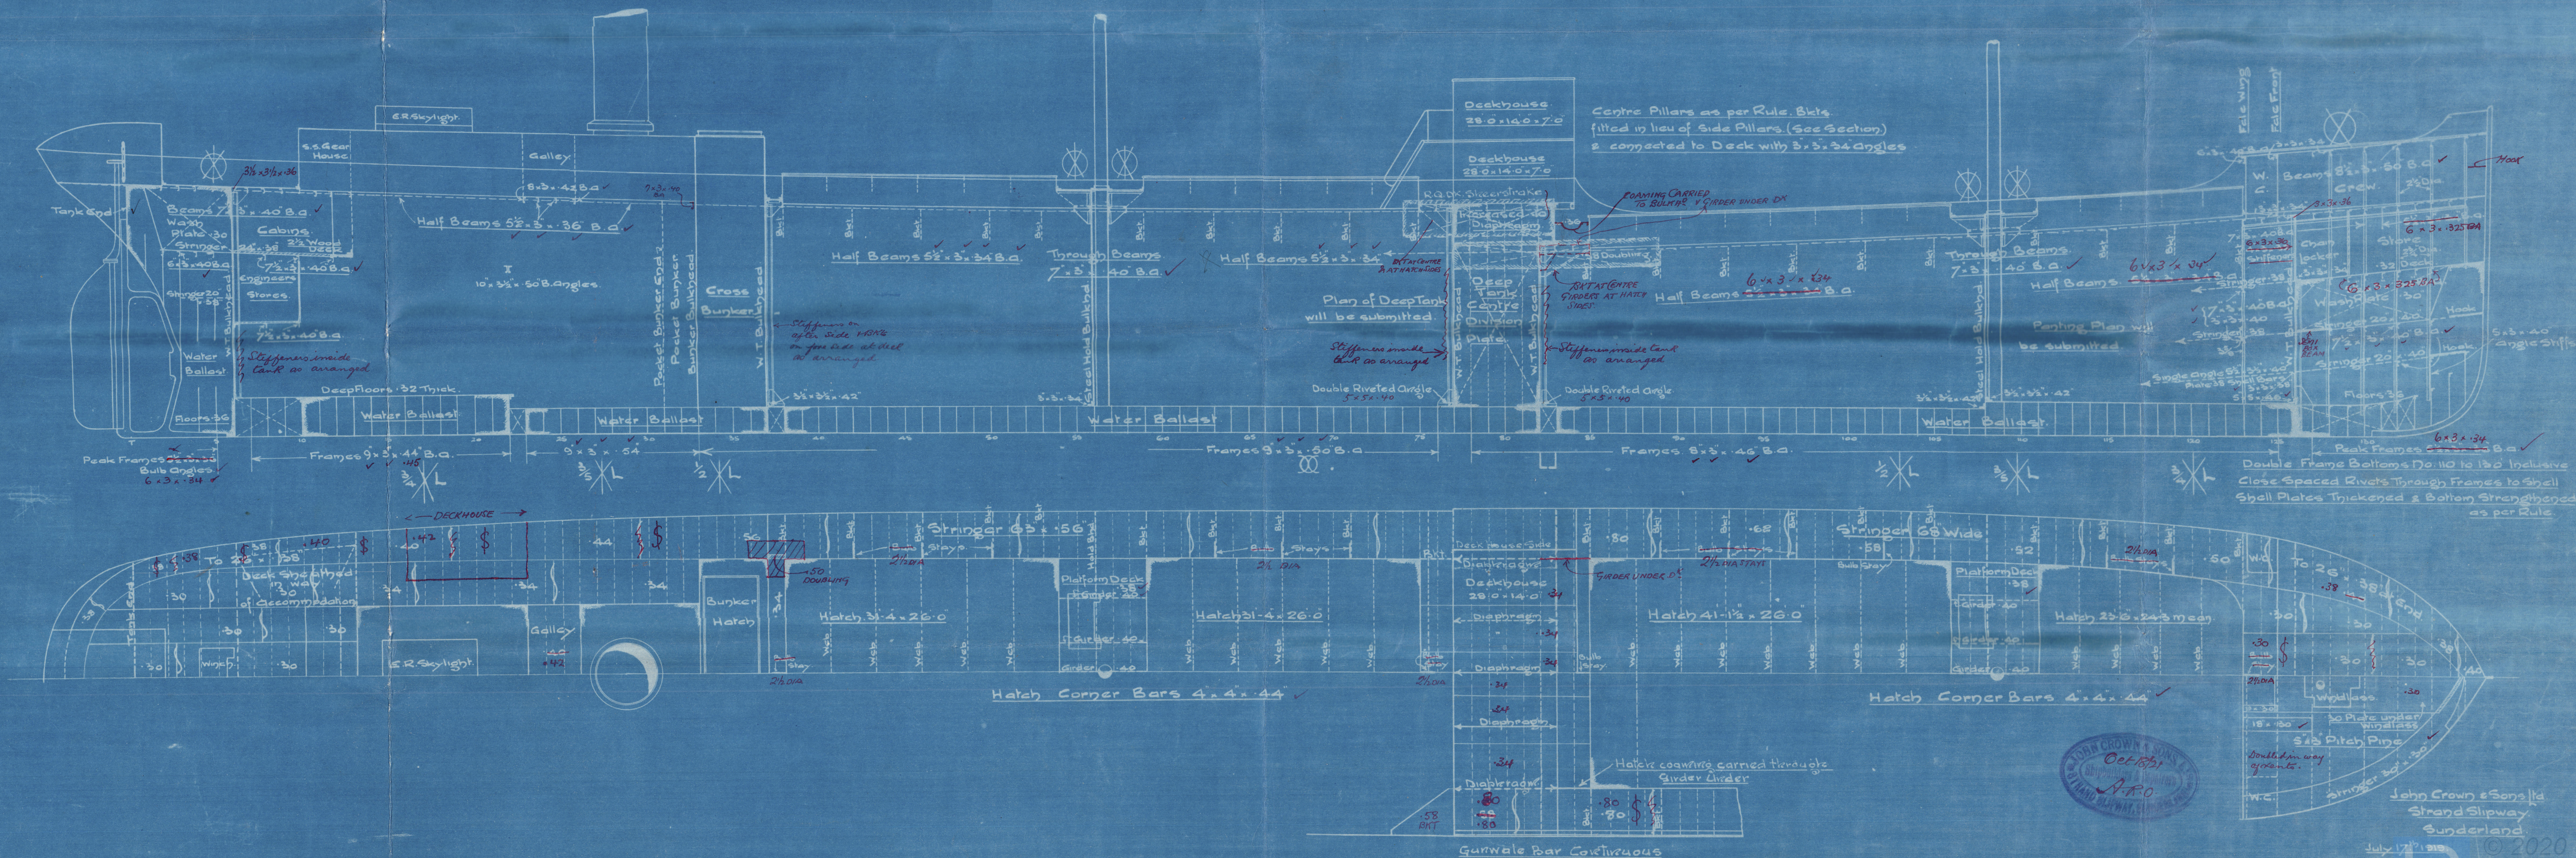

John Crown & Sons Ltd
 Strand Slipway
 Sunderland

July 17/1919

J. CROWN & SONS, LIMITED, SUNDERLAND.

ENCLOSURE
FOR

Messrs Lloyd's Surveyors.

007930-007937-0197

J. CROWN & SONS

Nº 167

PROFILE

AS BUILT

S/S CHARTERED

Sld Rpt Nº 28178



© 2020

Lloyd's Register

007930-007937-0147