


SCALE $\frac{1}{8}'' = 1 \text{ FOOT}$.

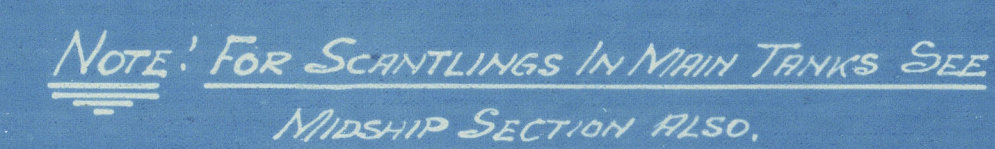

SUNDERLAND

SIR JAMES LAING & SONS LTD

Nº 704

PROFILE & DECKS

TWIN SCREW "PAQUITA"

(AS BUILT)

SUNDERLAND RPT. NO. 29899



© 2020

Lloyd's Register
Foundation

008177-008185-0025