


MIDSHIP SECTION.

SCALE $\frac{1}{2}$ " = 1 FOOT

LENGTH BP-----285'-0"

BREADTH MD-----41'-9"

DEPTH MD-----21'-2 $\frac{1}{2}$ "

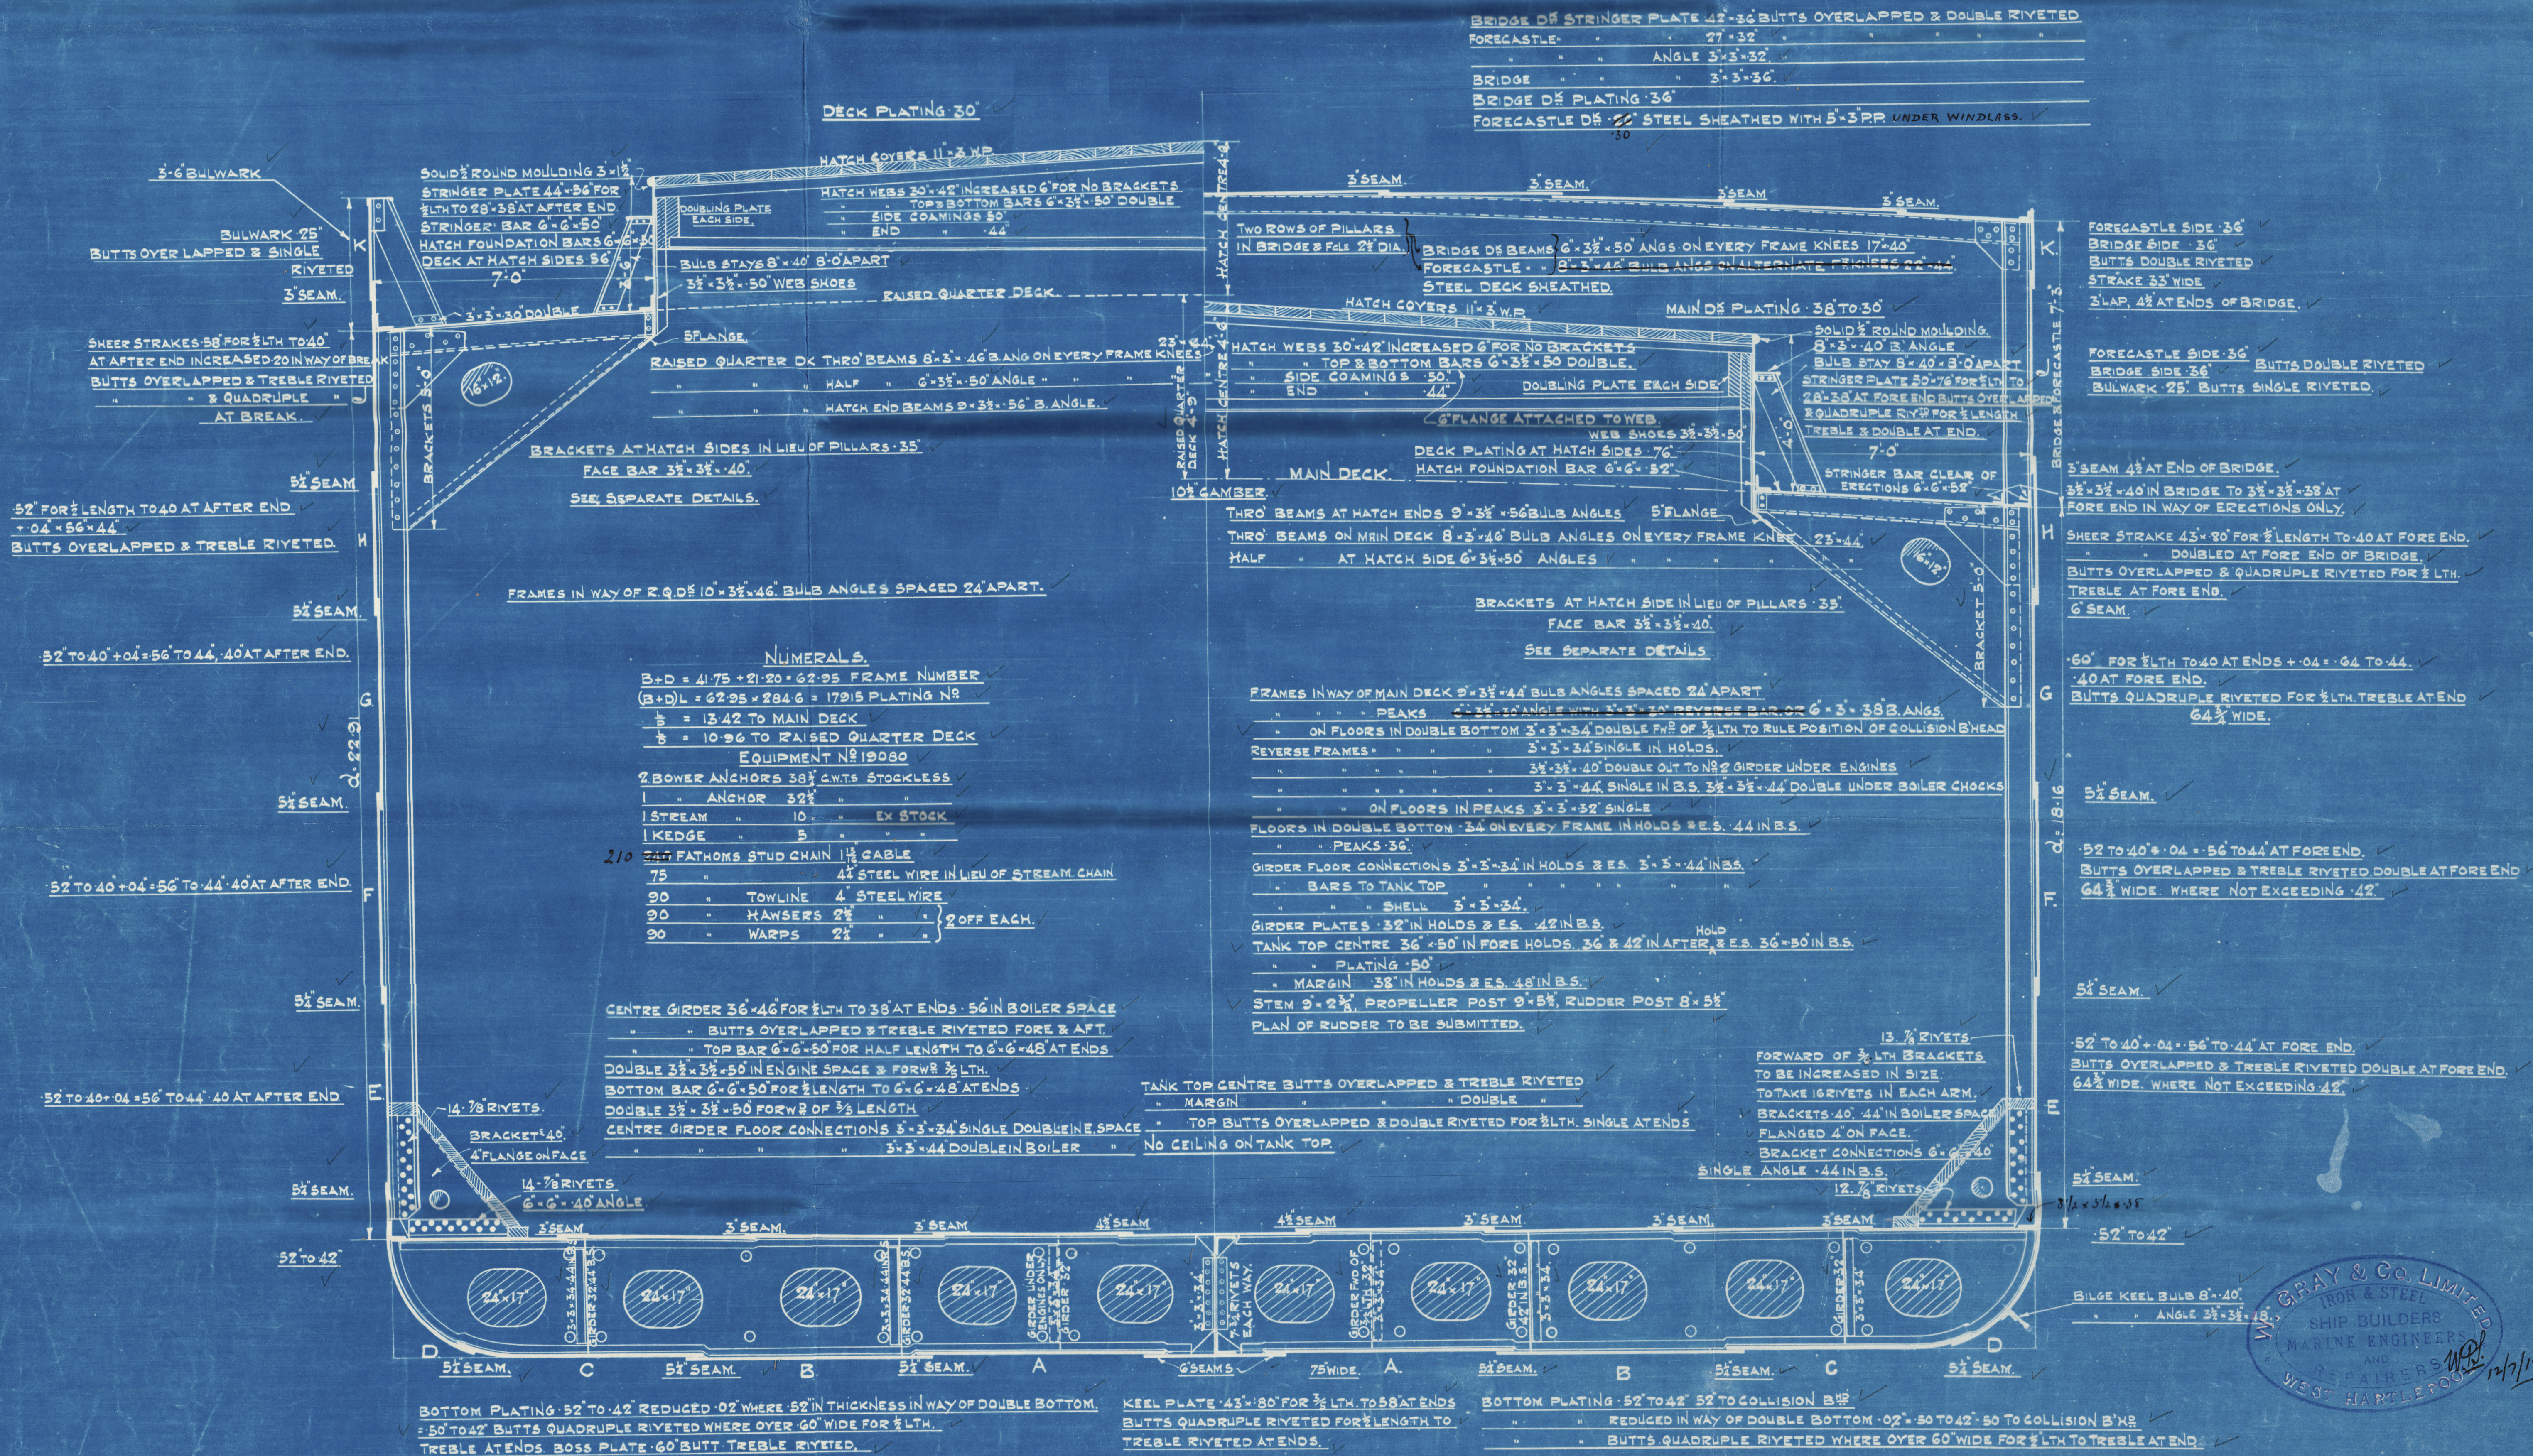

900-1.
901.

900-1-900-1


008524-008532-0161

W. GRAY & CO.

S.S. N° 901.

Midship Section of vessel
as built.

S.S. "WAR SHELL"

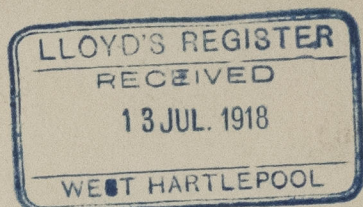

Refut. N° 15529.

STANDARD-D TYPE.

List to vessel to the

S.S. "WAR TORPEDO" N° 900.