
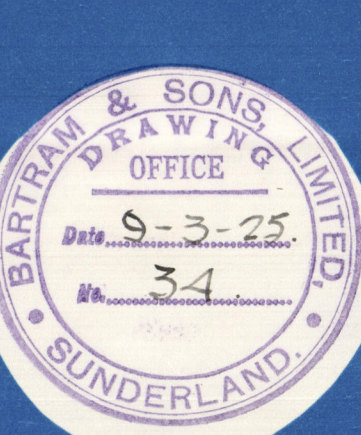
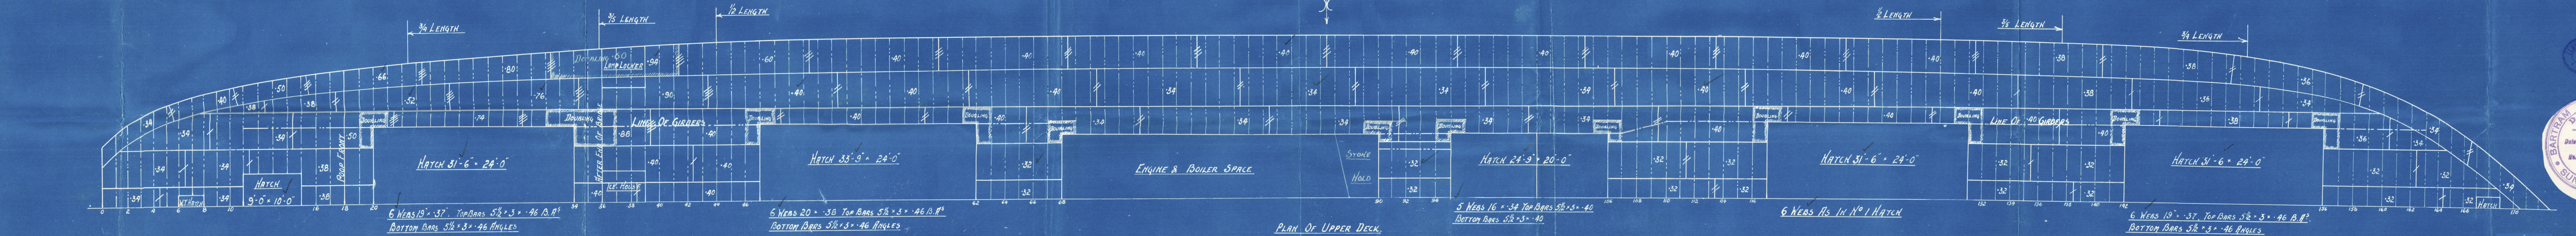
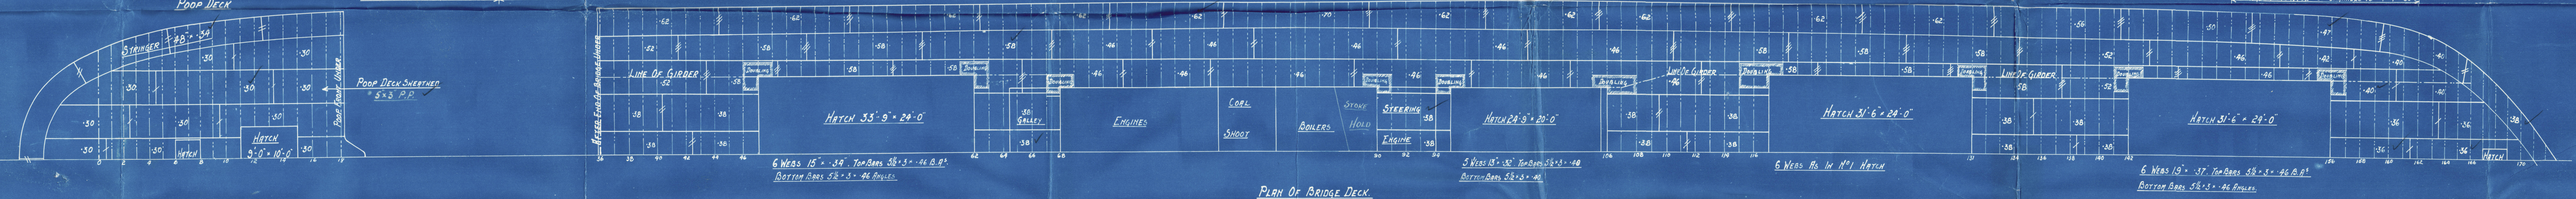


# PROFILE & DECK PLAN

As Fitted

S.S. N° 258

Scale 1/8" = 1 Foot

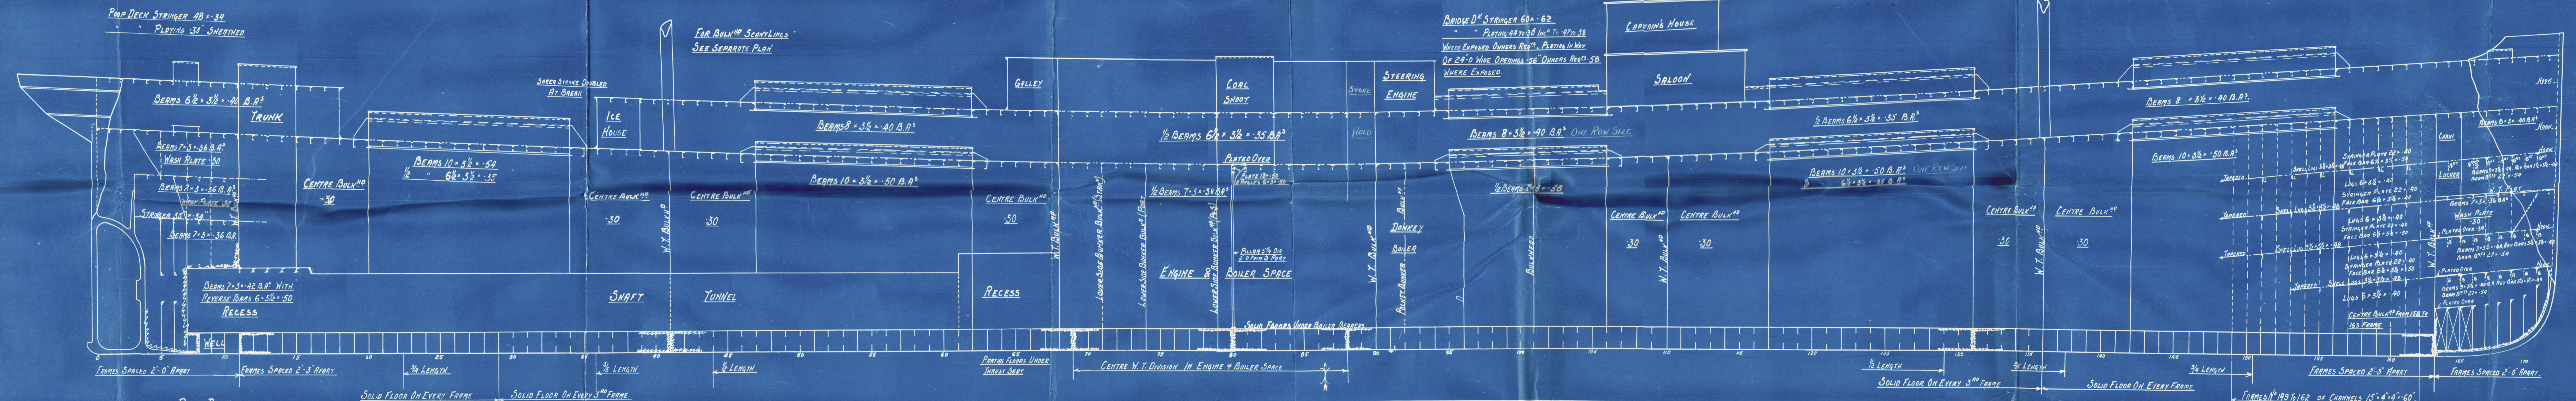



Sunderland

Barham & Sons.


- N<sup>o</sup> 258 -

"PETERSTON"

Std Rpt No. 29027.

PROFILE & DECKS.

(-as built).

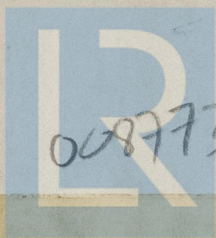

© 2021

008773-008777-0152

Lloyd's Register  
Foundation