


MIDSHIP SECTION S.S. N^o 258.

AS FITTED

SCALE $\frac{1}{2}$ = 1 FOOT.

POOP 38'-9" BRIDGE 305'-11"

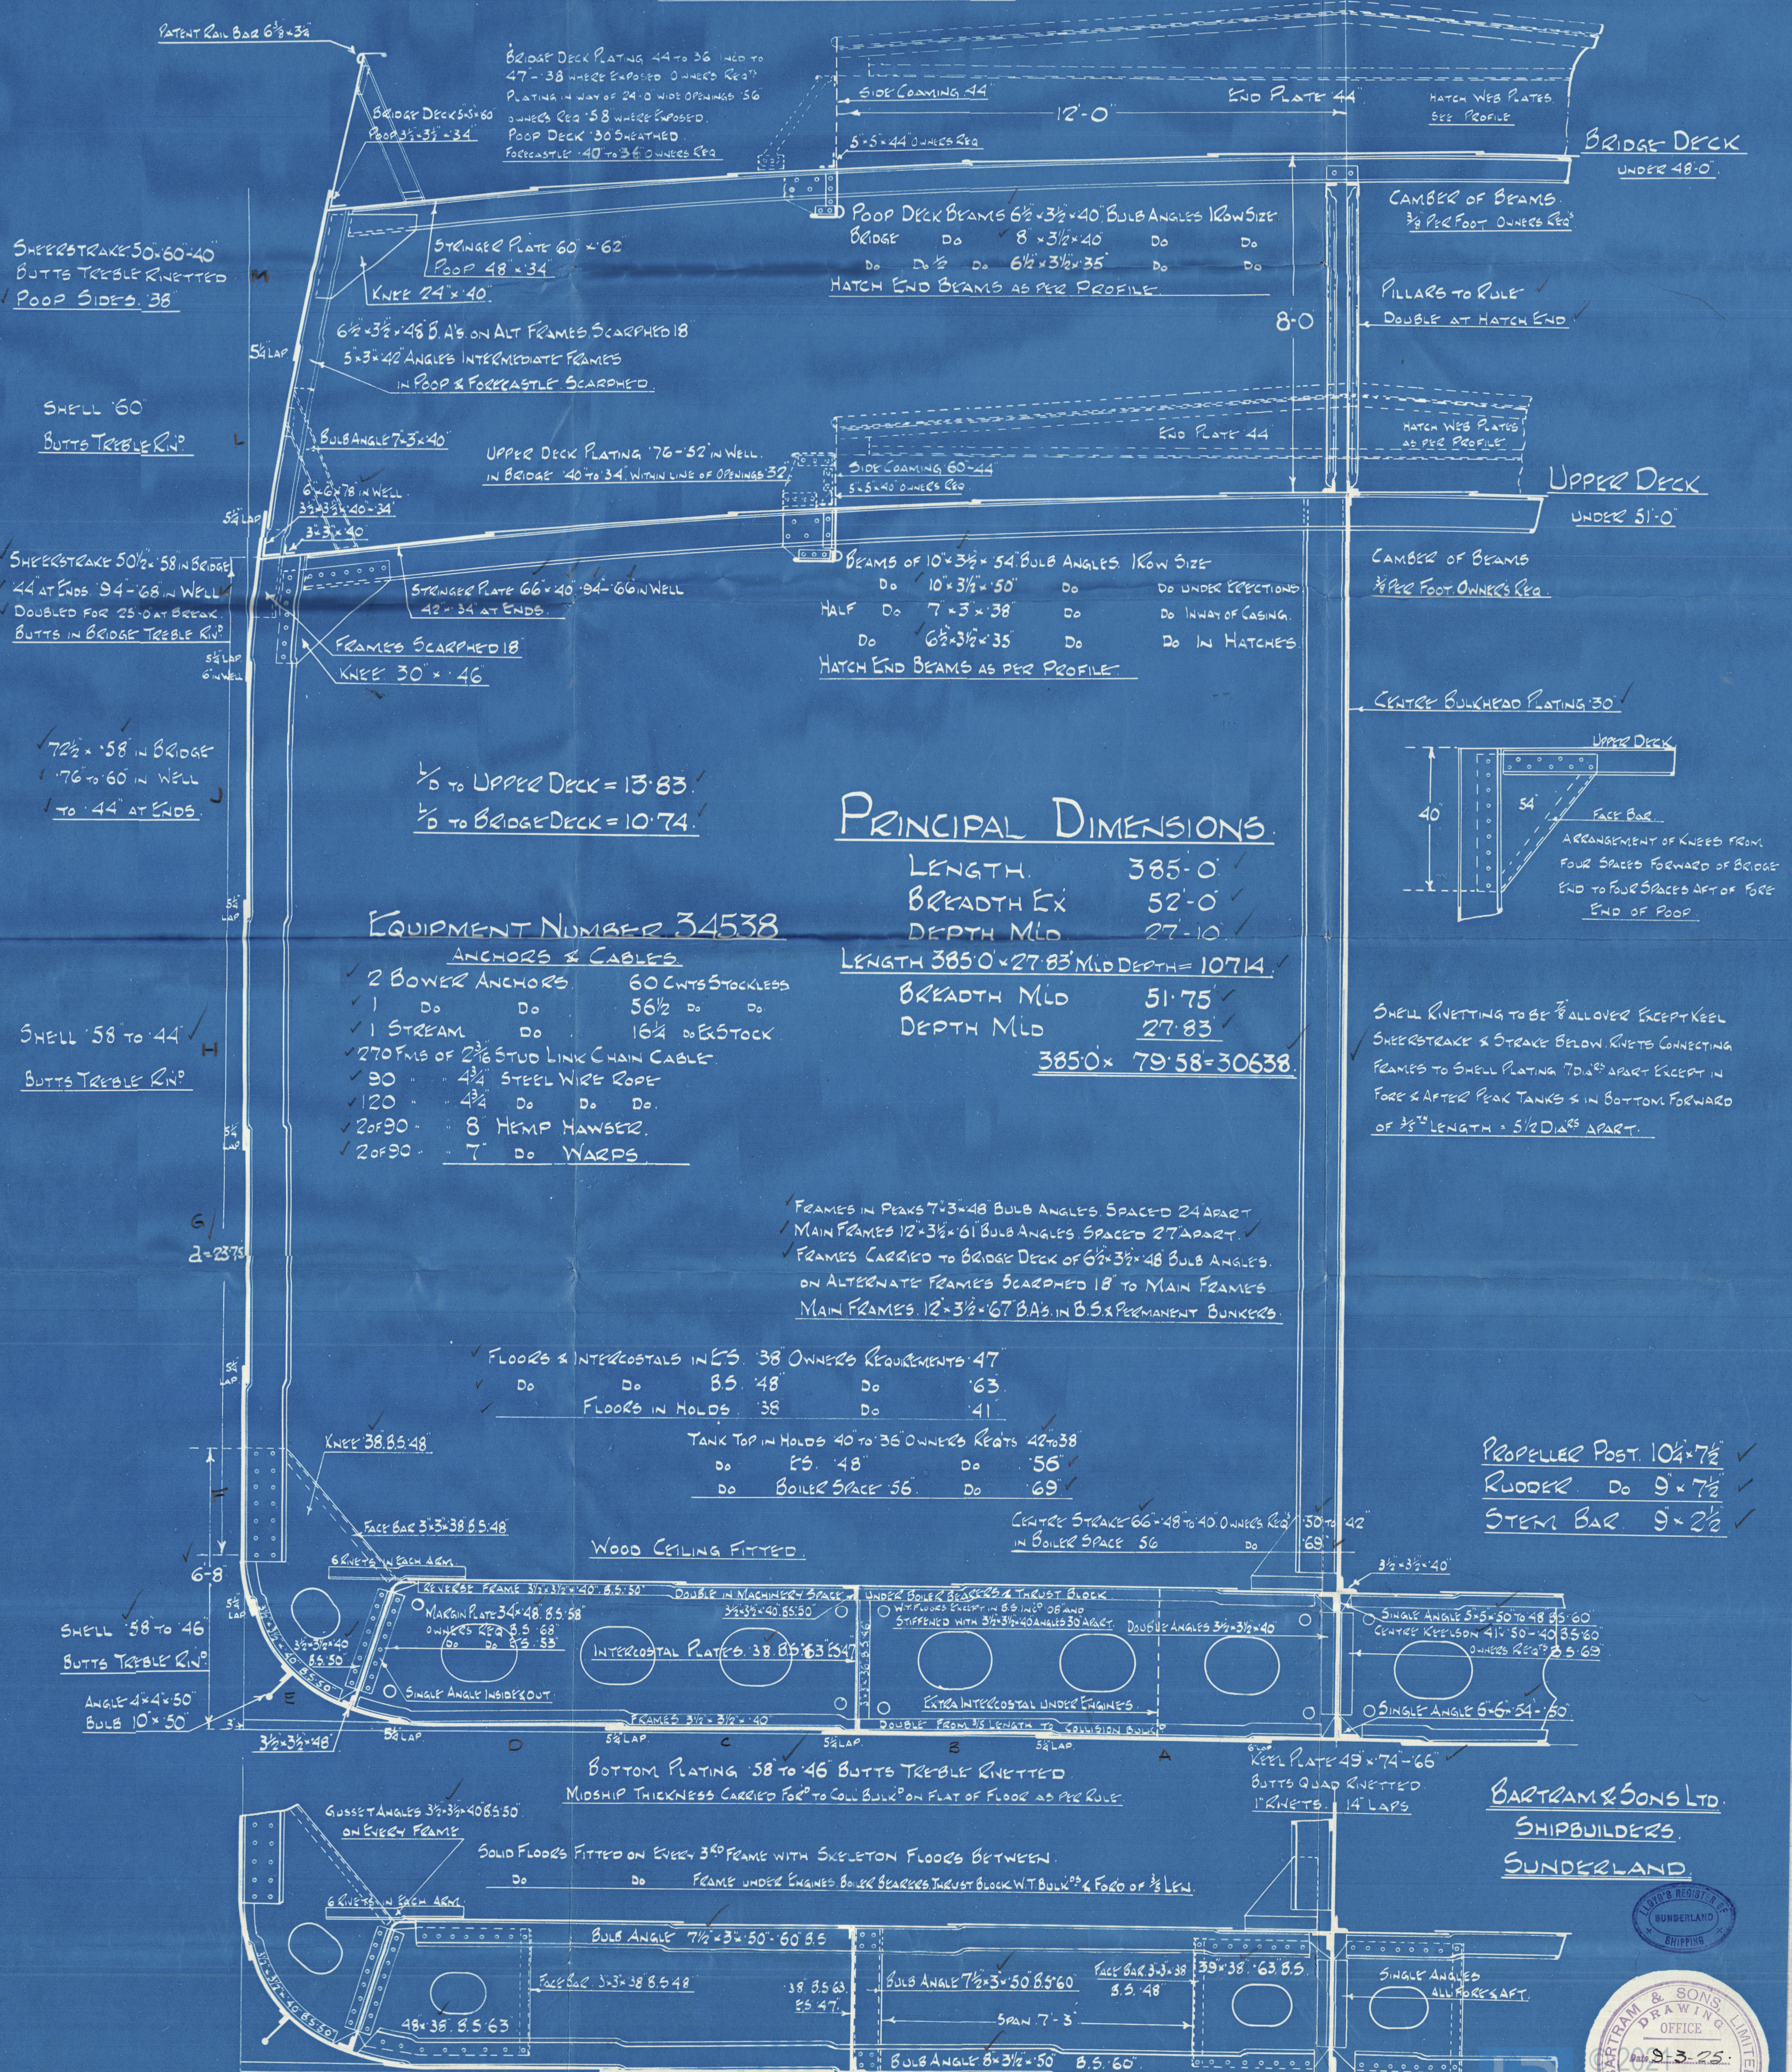

BARTRAM & SONS LTD.
SHIPBUILDERS
SUNDERLAND



008773-008777-0153

Sundland.

Barham & Sons.

- N^o 258. -

"S.S. PETERSTON."

Std Rpt No. 29027.

MIDSHIP SECTION.

(as built).

Raloo



© 2021

Lloyd's Register
Foundation

008775-08777-0153