

MIDSHIP SECTION
105' WOODEN MINESWEEPERS

— S.N. NOS. 481 — 488 —

DRAWING NO. P.C.W.M.S. 4


AS BUILT BY:—

— R.A. BENSON SHIPYARDS LTD. —
— NEWCASTLE SHIPYARDS LTD. —
— STAR SHIPYARDS (MERCERS) LTD. —
— VANCOUVER SHIPYARDS LTD. —

Hull No 948

SCALE $\frac{3}{4}" = 1'-0"$

*To accompany Vancouver A6
 1st Entry Hull Report JP.6262
 J.M.C.S. Lavallee*

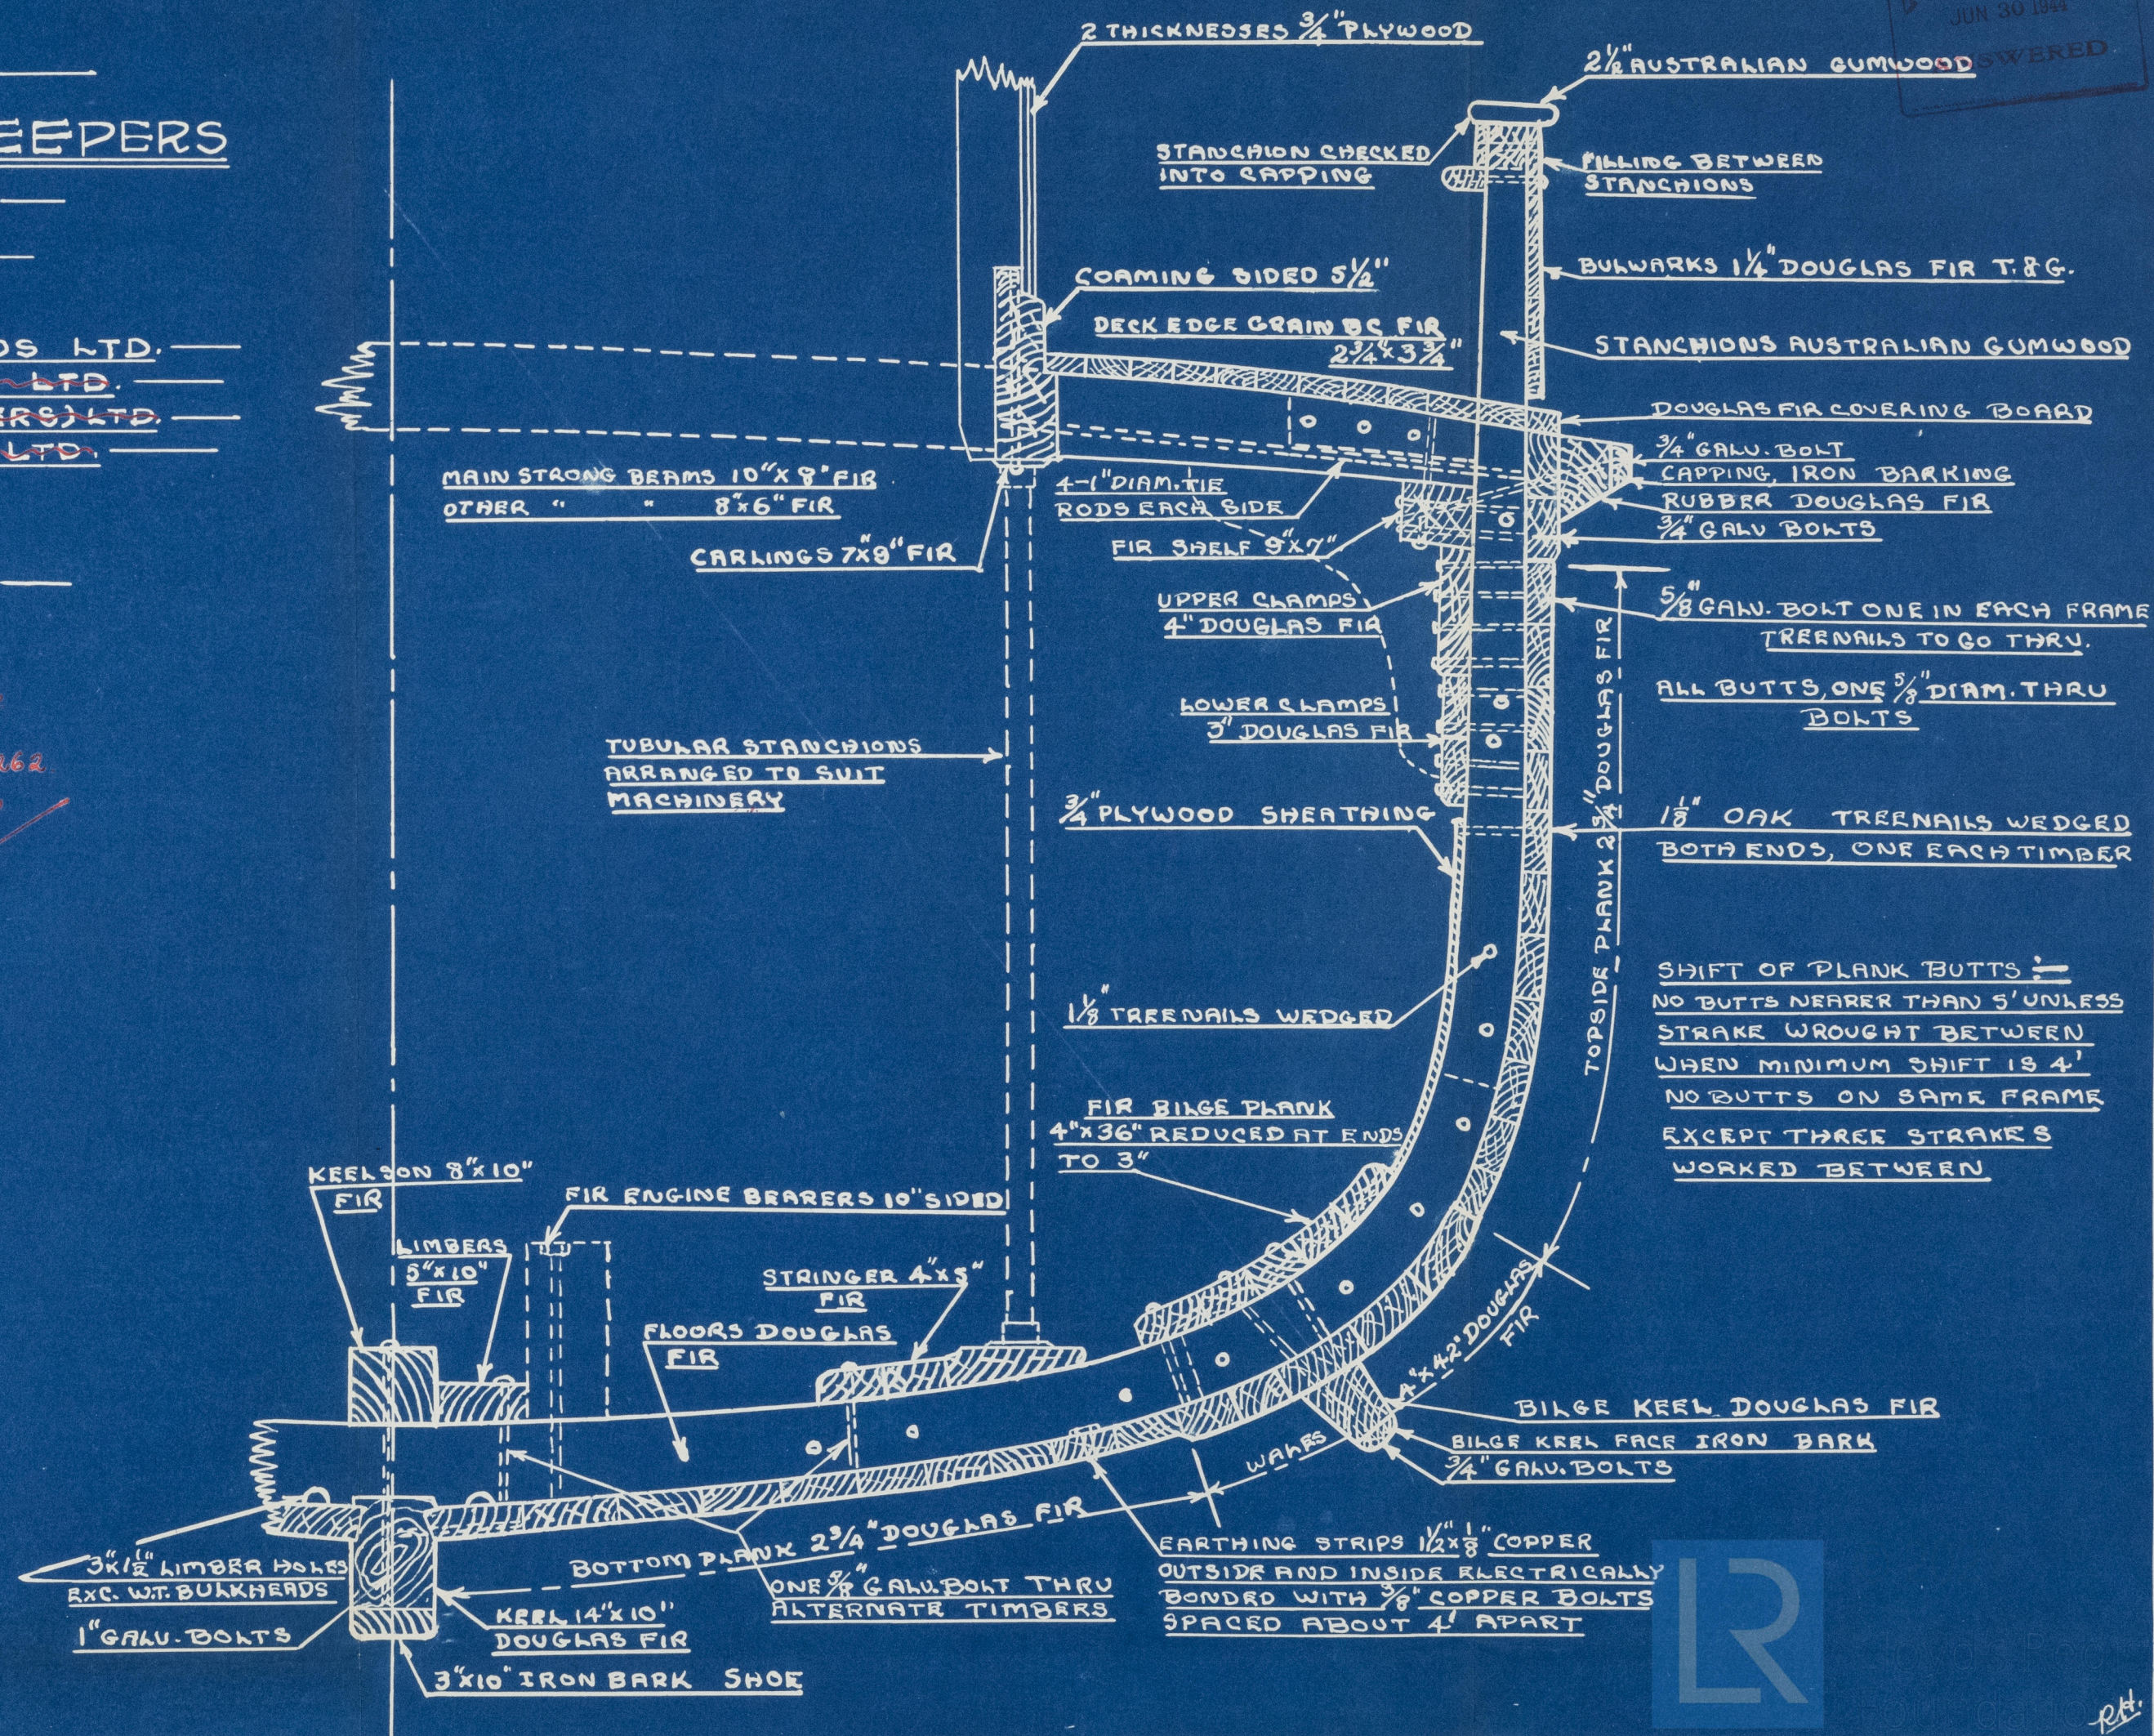

RECEIVED
 JUN 30 1944
 ANSWERED

R
 Lloyd's Register
 Foundation
 R.H.