

NUMERALS

L + D = 1771 L(B + D) = 6083
 1/2 D = 13.39 D = 1115
 d = 10.33

EQUIPMENT NO 6594 (WITH CLOSED FORWARD T. BAY)

- 2 STOCKLESS BOWER ANCHORS 10 1/2 CWT'S EACH
- 1 STOCKLESS BOWER ANCHOR 8 1/2 CWT'S
- 1 STREAM ANCHOR 3 1/2 CWT'S EX STOCK
- 165 FATHOMS 1/4" STUD CHAIN CABLE 954 CWT'S
- 60 (STREAM)
- 75 2 1/2" STEEL WIRE TOWLINE
- 80 5 1/2" HEMP HAWSER

TEAK HOUSE

NAV. BR DS

SHADE DS

SHADE DS

UPPER DS

UPPER DS

STARBOARD SIDE

SHIP NO 291. S. O. NO 6130.

MIDSHIP SECTION.

DIMENSIONS - 163' 0" O.A. 154' 0" P. 28' 0" H. 6' 0" M.

SCALE 1" = ONE FOOT.


A.K. Rpt. No 8242

009116-009121-0061

Governor Wright
 Midship Section
 as built

SECTION THRO TUNNEL

LOOKING AFT.

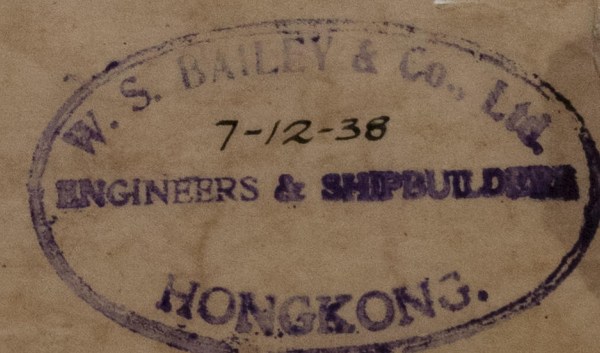

DRAWN BY
 TRACED BY
 CHECKED BY
 DATE



© 2021
 Lloyd's Register
 Foundation

009116-009121-0061

40" DOUBLE
18" x 40"
5" AT ENDS

0" FOR 2L TO 35"
CEILING

1" TO FR

A STRAKE

31" x 40" A DOUBLE

S. K. INT. 30"

TOPS 4" x 3" x 35" TO 30" ANG DOUBLE.
BOTTOM 2 1/2" x 2 1/2" x 30" A. SINGLE
VERT. 2 1/2" x 2 1/2" x 30" ANG. SINGLE.

REVERSE FRAME 22" x 22" x 30" A

2 1/2" S.R.

B STRAKE


2 1/2" S.R.

C STRAKE 35" FOR 2L
TO 30" AT ENDS.

6" x 4" x 30" TEE BAR

9" x .45" BULB PLATE

A & B STRAKES 35" AMIDSHIPS, TO 30" FROM 2L AFT TO A.P.
AND 30" FROM 2L FWD TO RULE POSITION OF F.P. BULKHEAD.

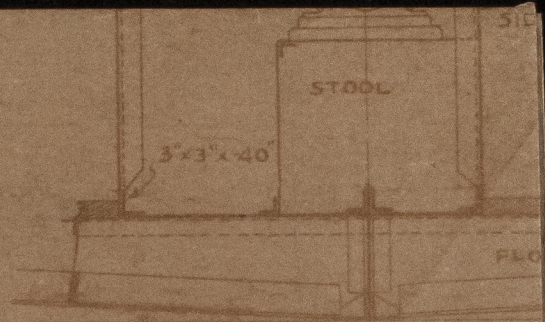

No 6130.

TION.

S. P. 28-0-11-6" M.L.P.

OOT

Governor Wrigill
Midship Section
as built

SECTION THE

LOOKING

A. K. Rpt. No. 8242

009116-009121-0061

