
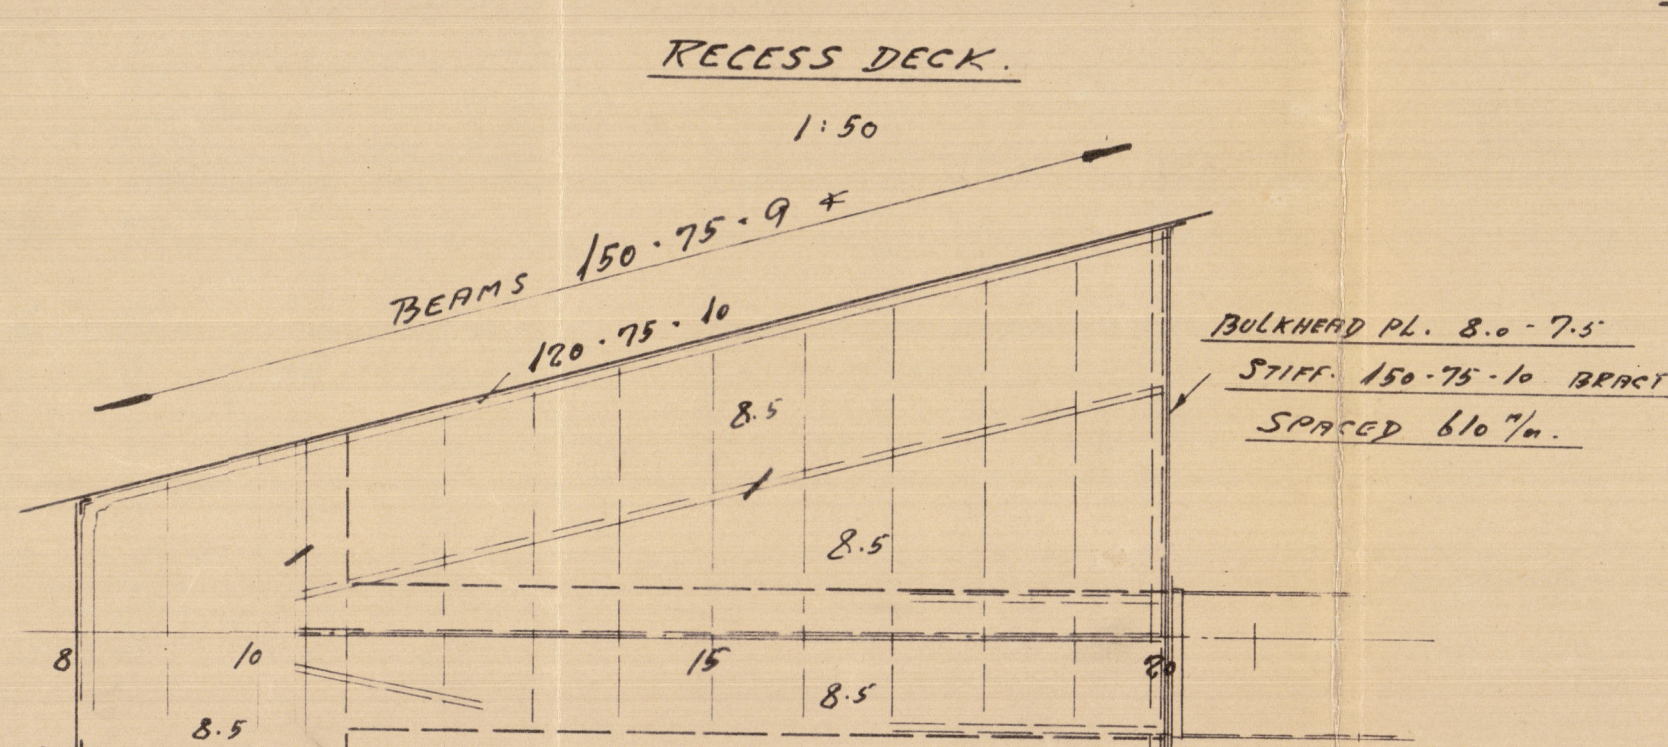
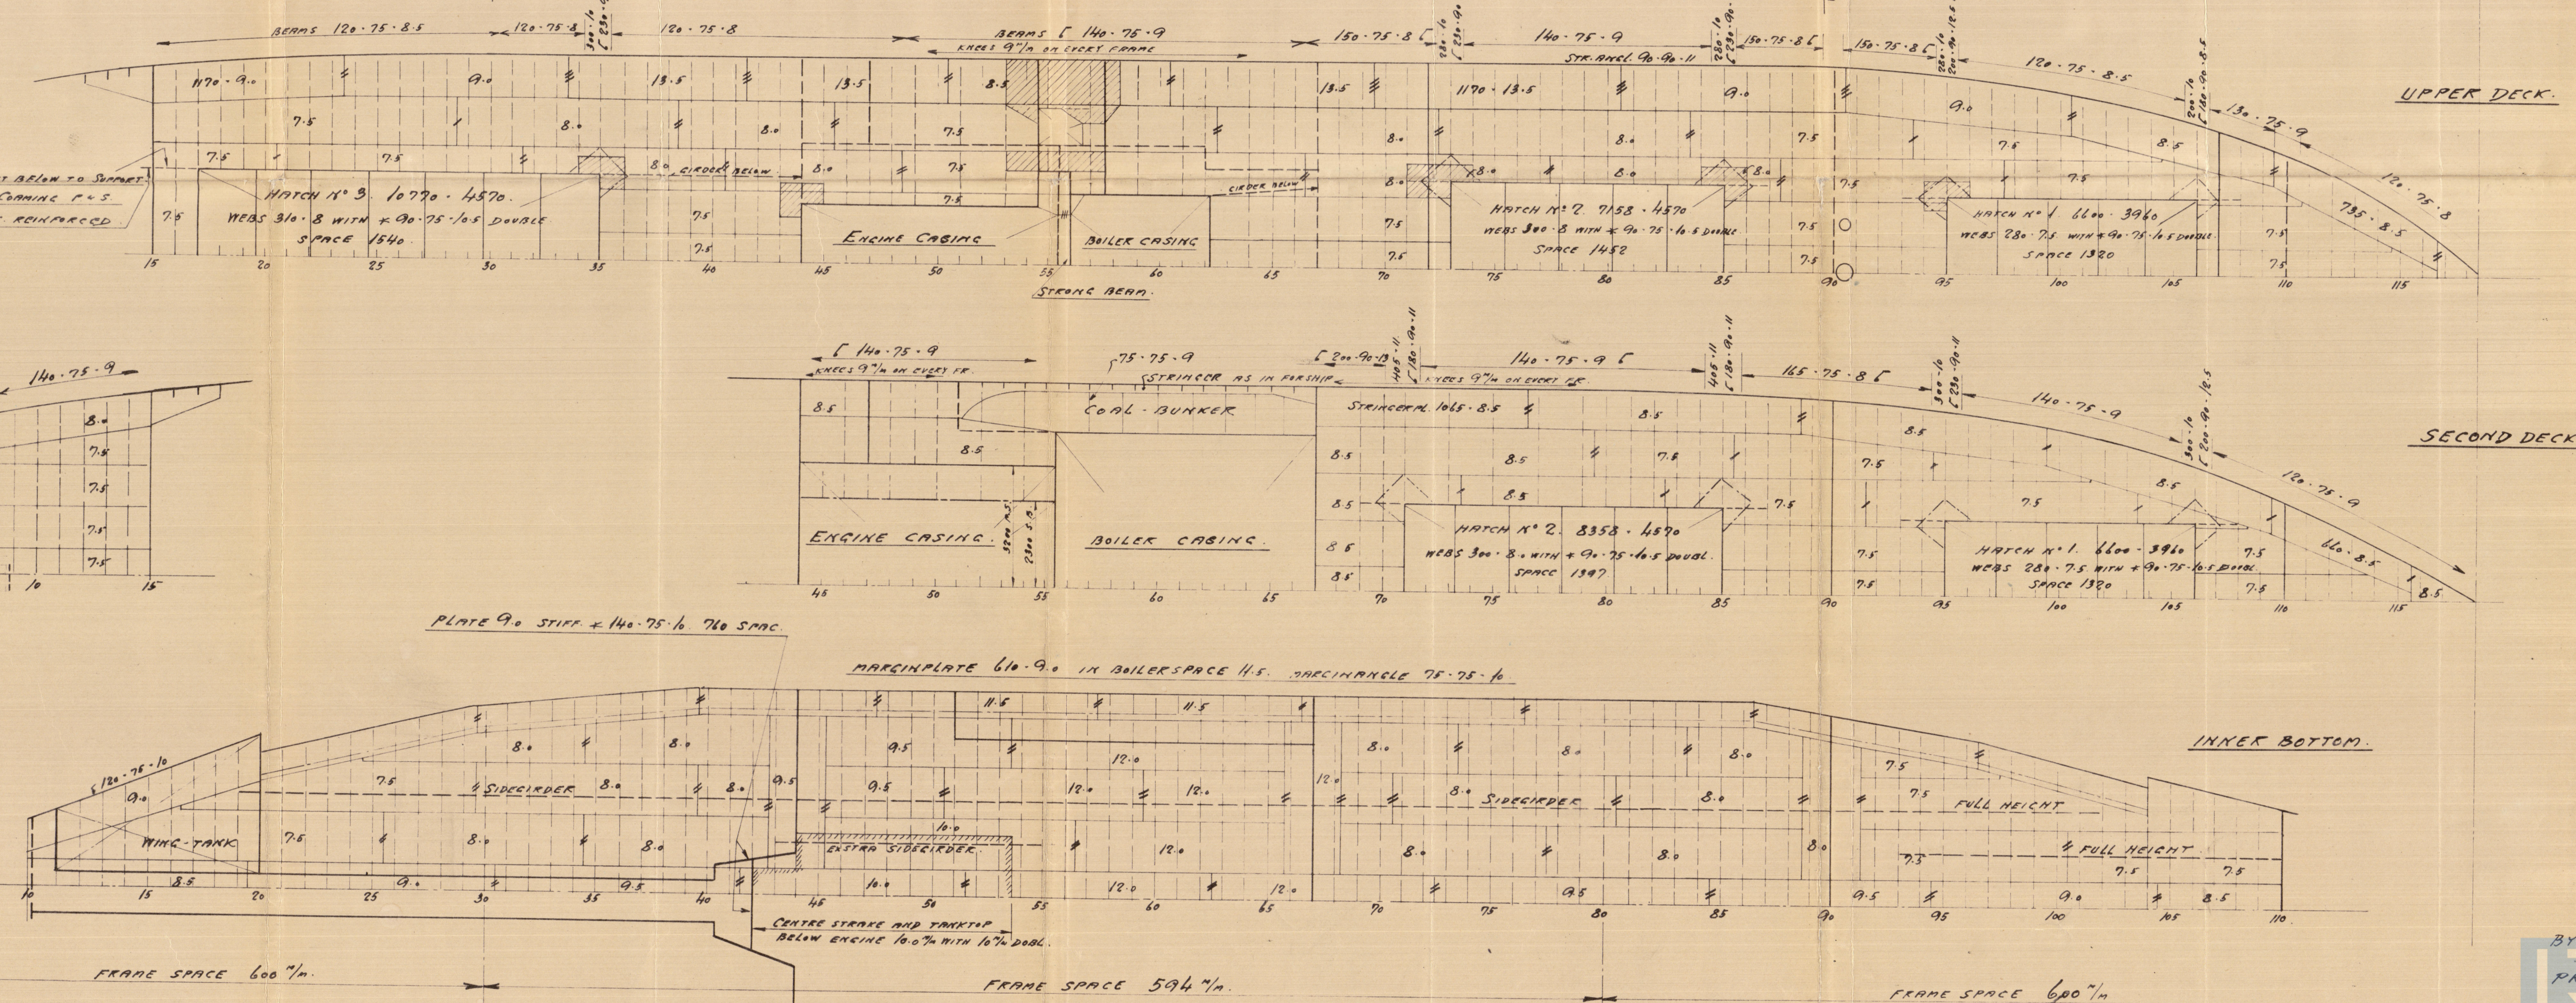
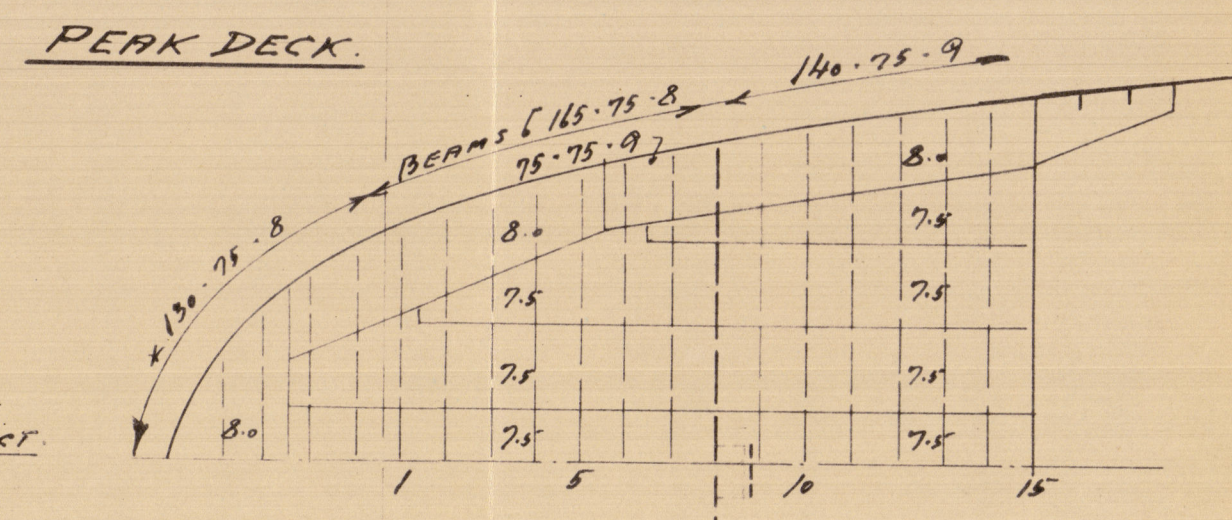
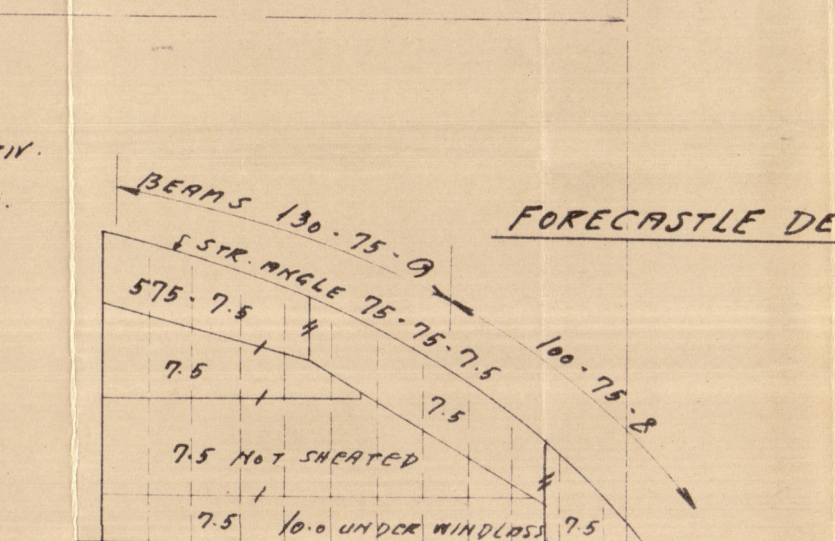
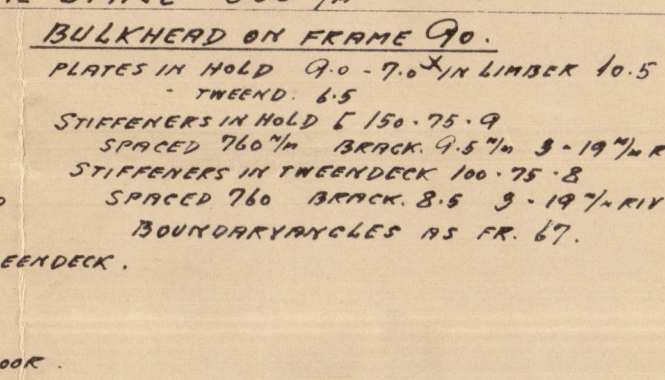
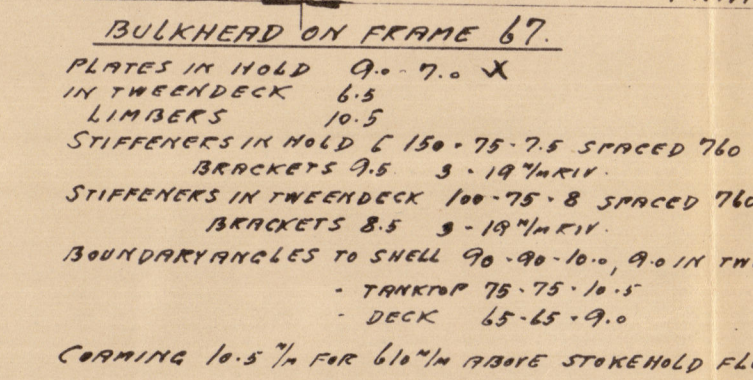
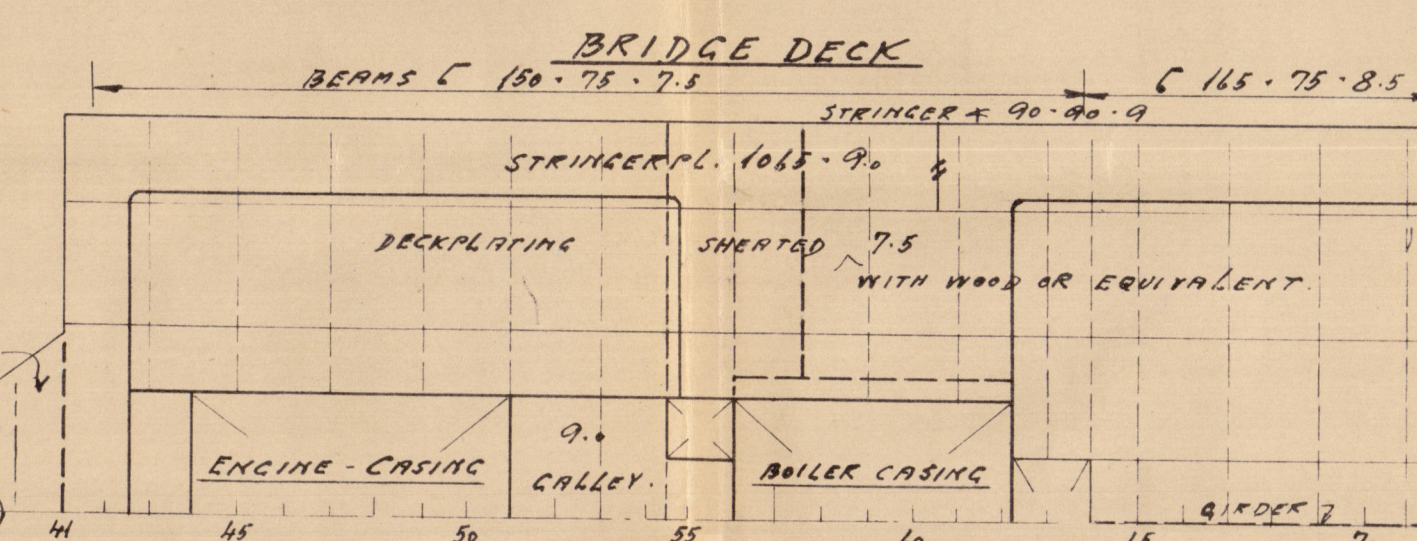
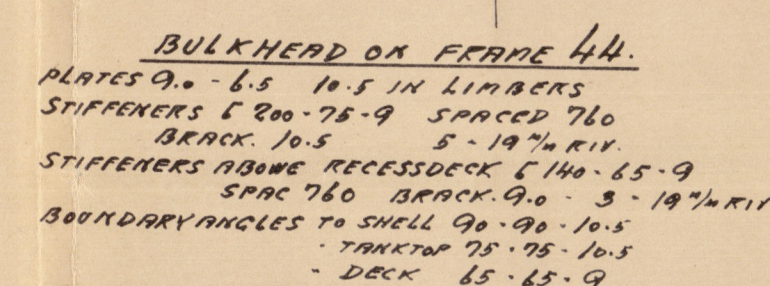
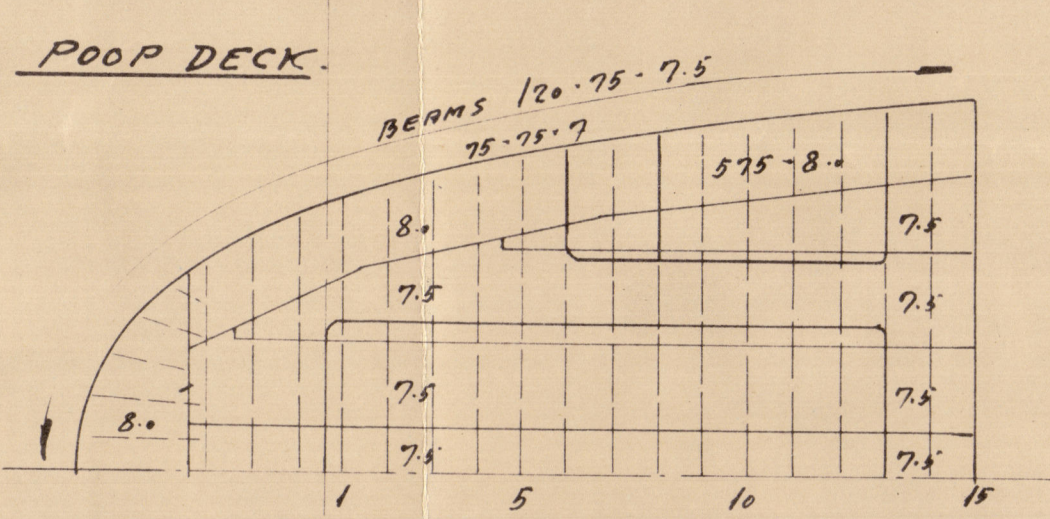


SCALE 1:100.


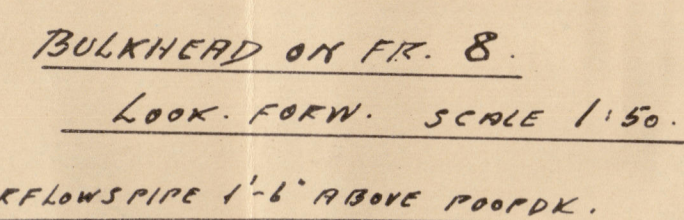


S/s. "SLASK"

A/s. Nakskov Skibsvarft.

Yard No 51.

PROFILE & DECKS (as built)

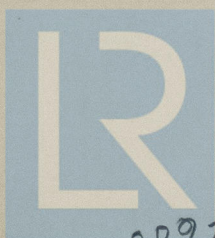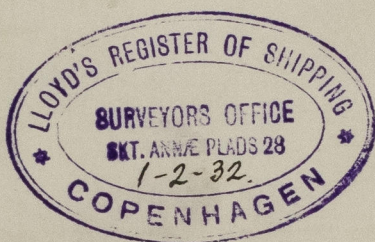

© 2020

Lloyd's Register
Foundation

009232 009234.0050