

<u>Equipment Numerals</u>	
Longitudinal Number	3501
Poop and Forecastle Deck	59
Deck Houses	170
	3730


— SHIP N° 82-83-84. —
— MIDSHIP - SECTION. —

- Scale 1:25. -

Cargo and Passenger Motorship to Class Lloyds Reg. 100 F.I.†
Compl. Superstructure Vessel Draught: 22'11" moulded

—Equipments.—

2 off stockless bowler anchors each 3455 kg
 1 - Stream anchor 965 kg + 25% for stock
 445 H. stud chain cable 58.5 mm Diam. min Weight 36400 kg
 165 H. Steelwire 127 mm for Stream anchor 6-12 spec Flexible
 220 H. " 121 " 6-24 spec. Flexible
 2 off. 165 H. 203 mm Manila or 70 mm Steel wire 6-12 Flexible
 2 - 165 - 178 - 64 - 6-12 -

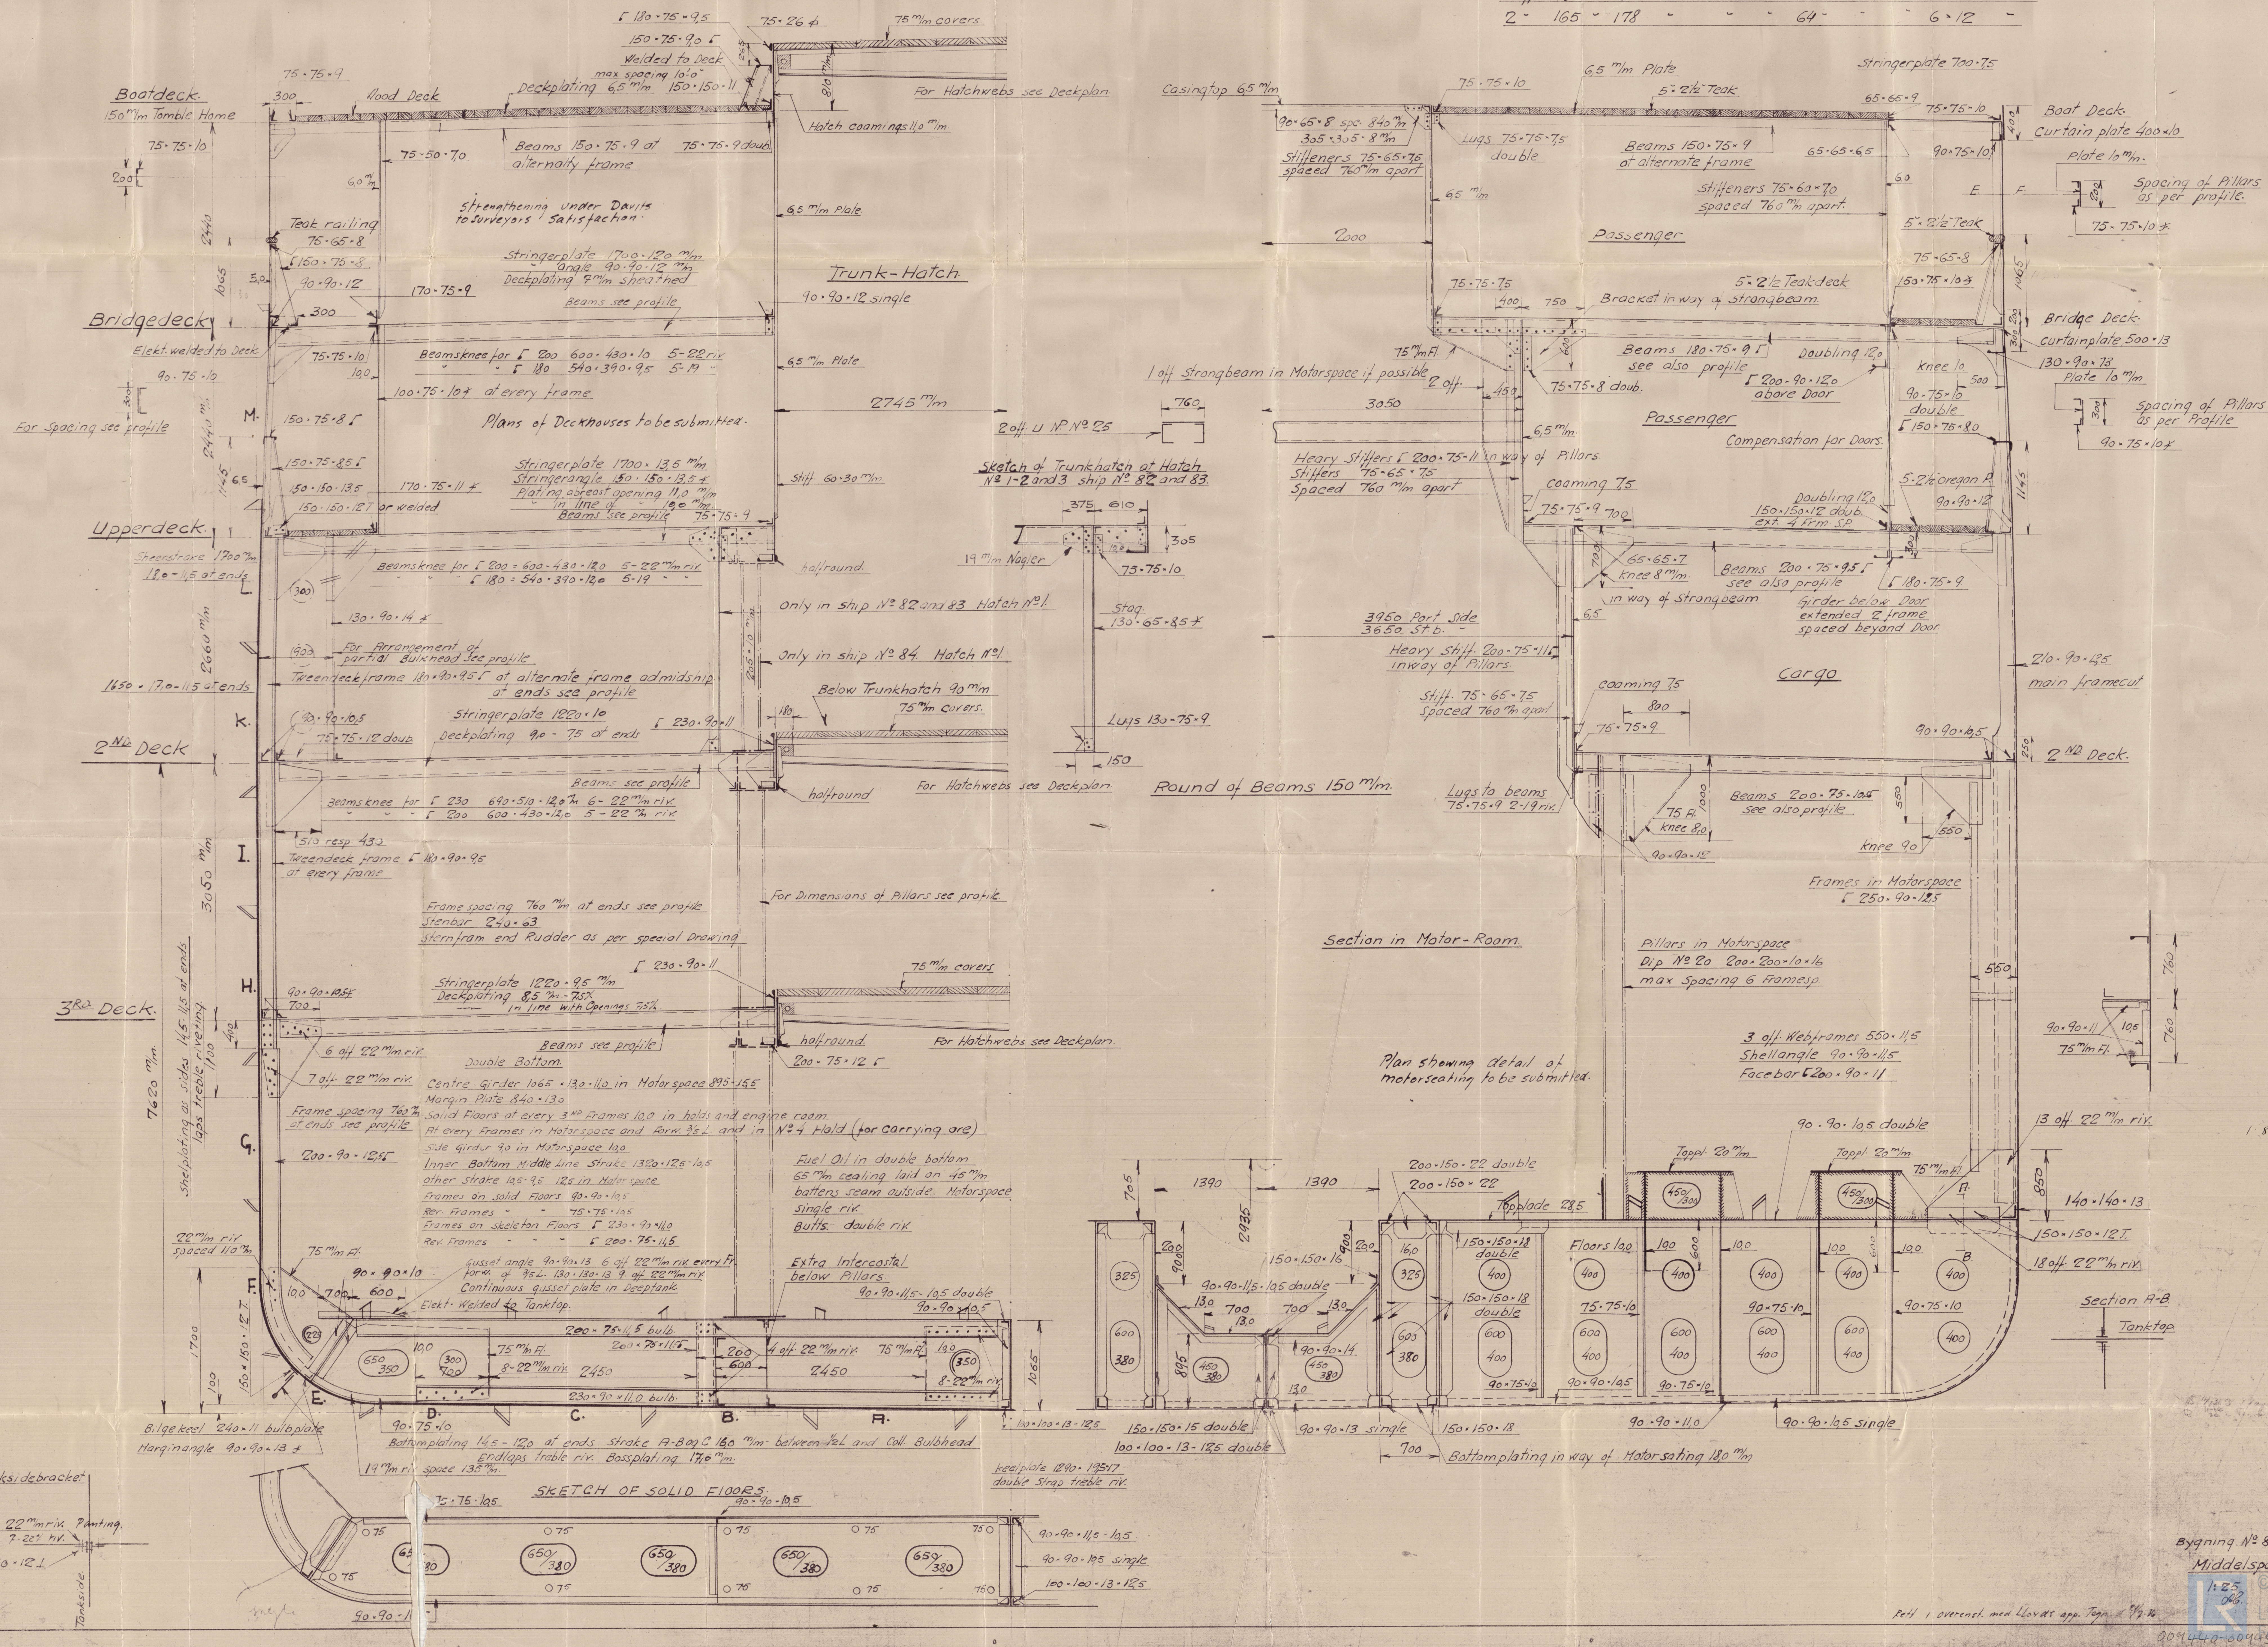Bygning N^o 82-830984

Middelspant.

1:25 © 2021 9-7-30



Lloyd's Register

009440-009450-0134



Mens. ²⁵/₁₀ Nakker Skibsvæft.

Yard No. 82.

M/T. "Capiapo." of Valparaiso.

Midship Section
"as built."

Cpn. Repat No. 10433.

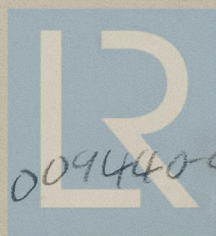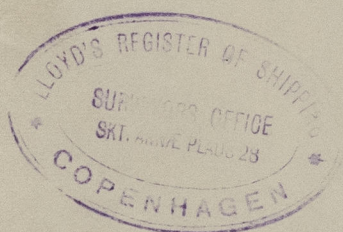

© 2021

Lloyd's Register
Foundation

009440-00 715000139