



MIDSHIP SECTION.

S.S. "PYROPE."


YARD No 338.

SCALE $\frac{1}{2}$ " = 1'-0"

N.B.: LENGTH ON SUMMER

LOAD LINE 162'-6"

DIMENSIONS: LENGTH 163'-0" B.P. BREADTH 25'-0" MLD. DEPTH 11'-9 $\frac{1}{2}$ " MLD.

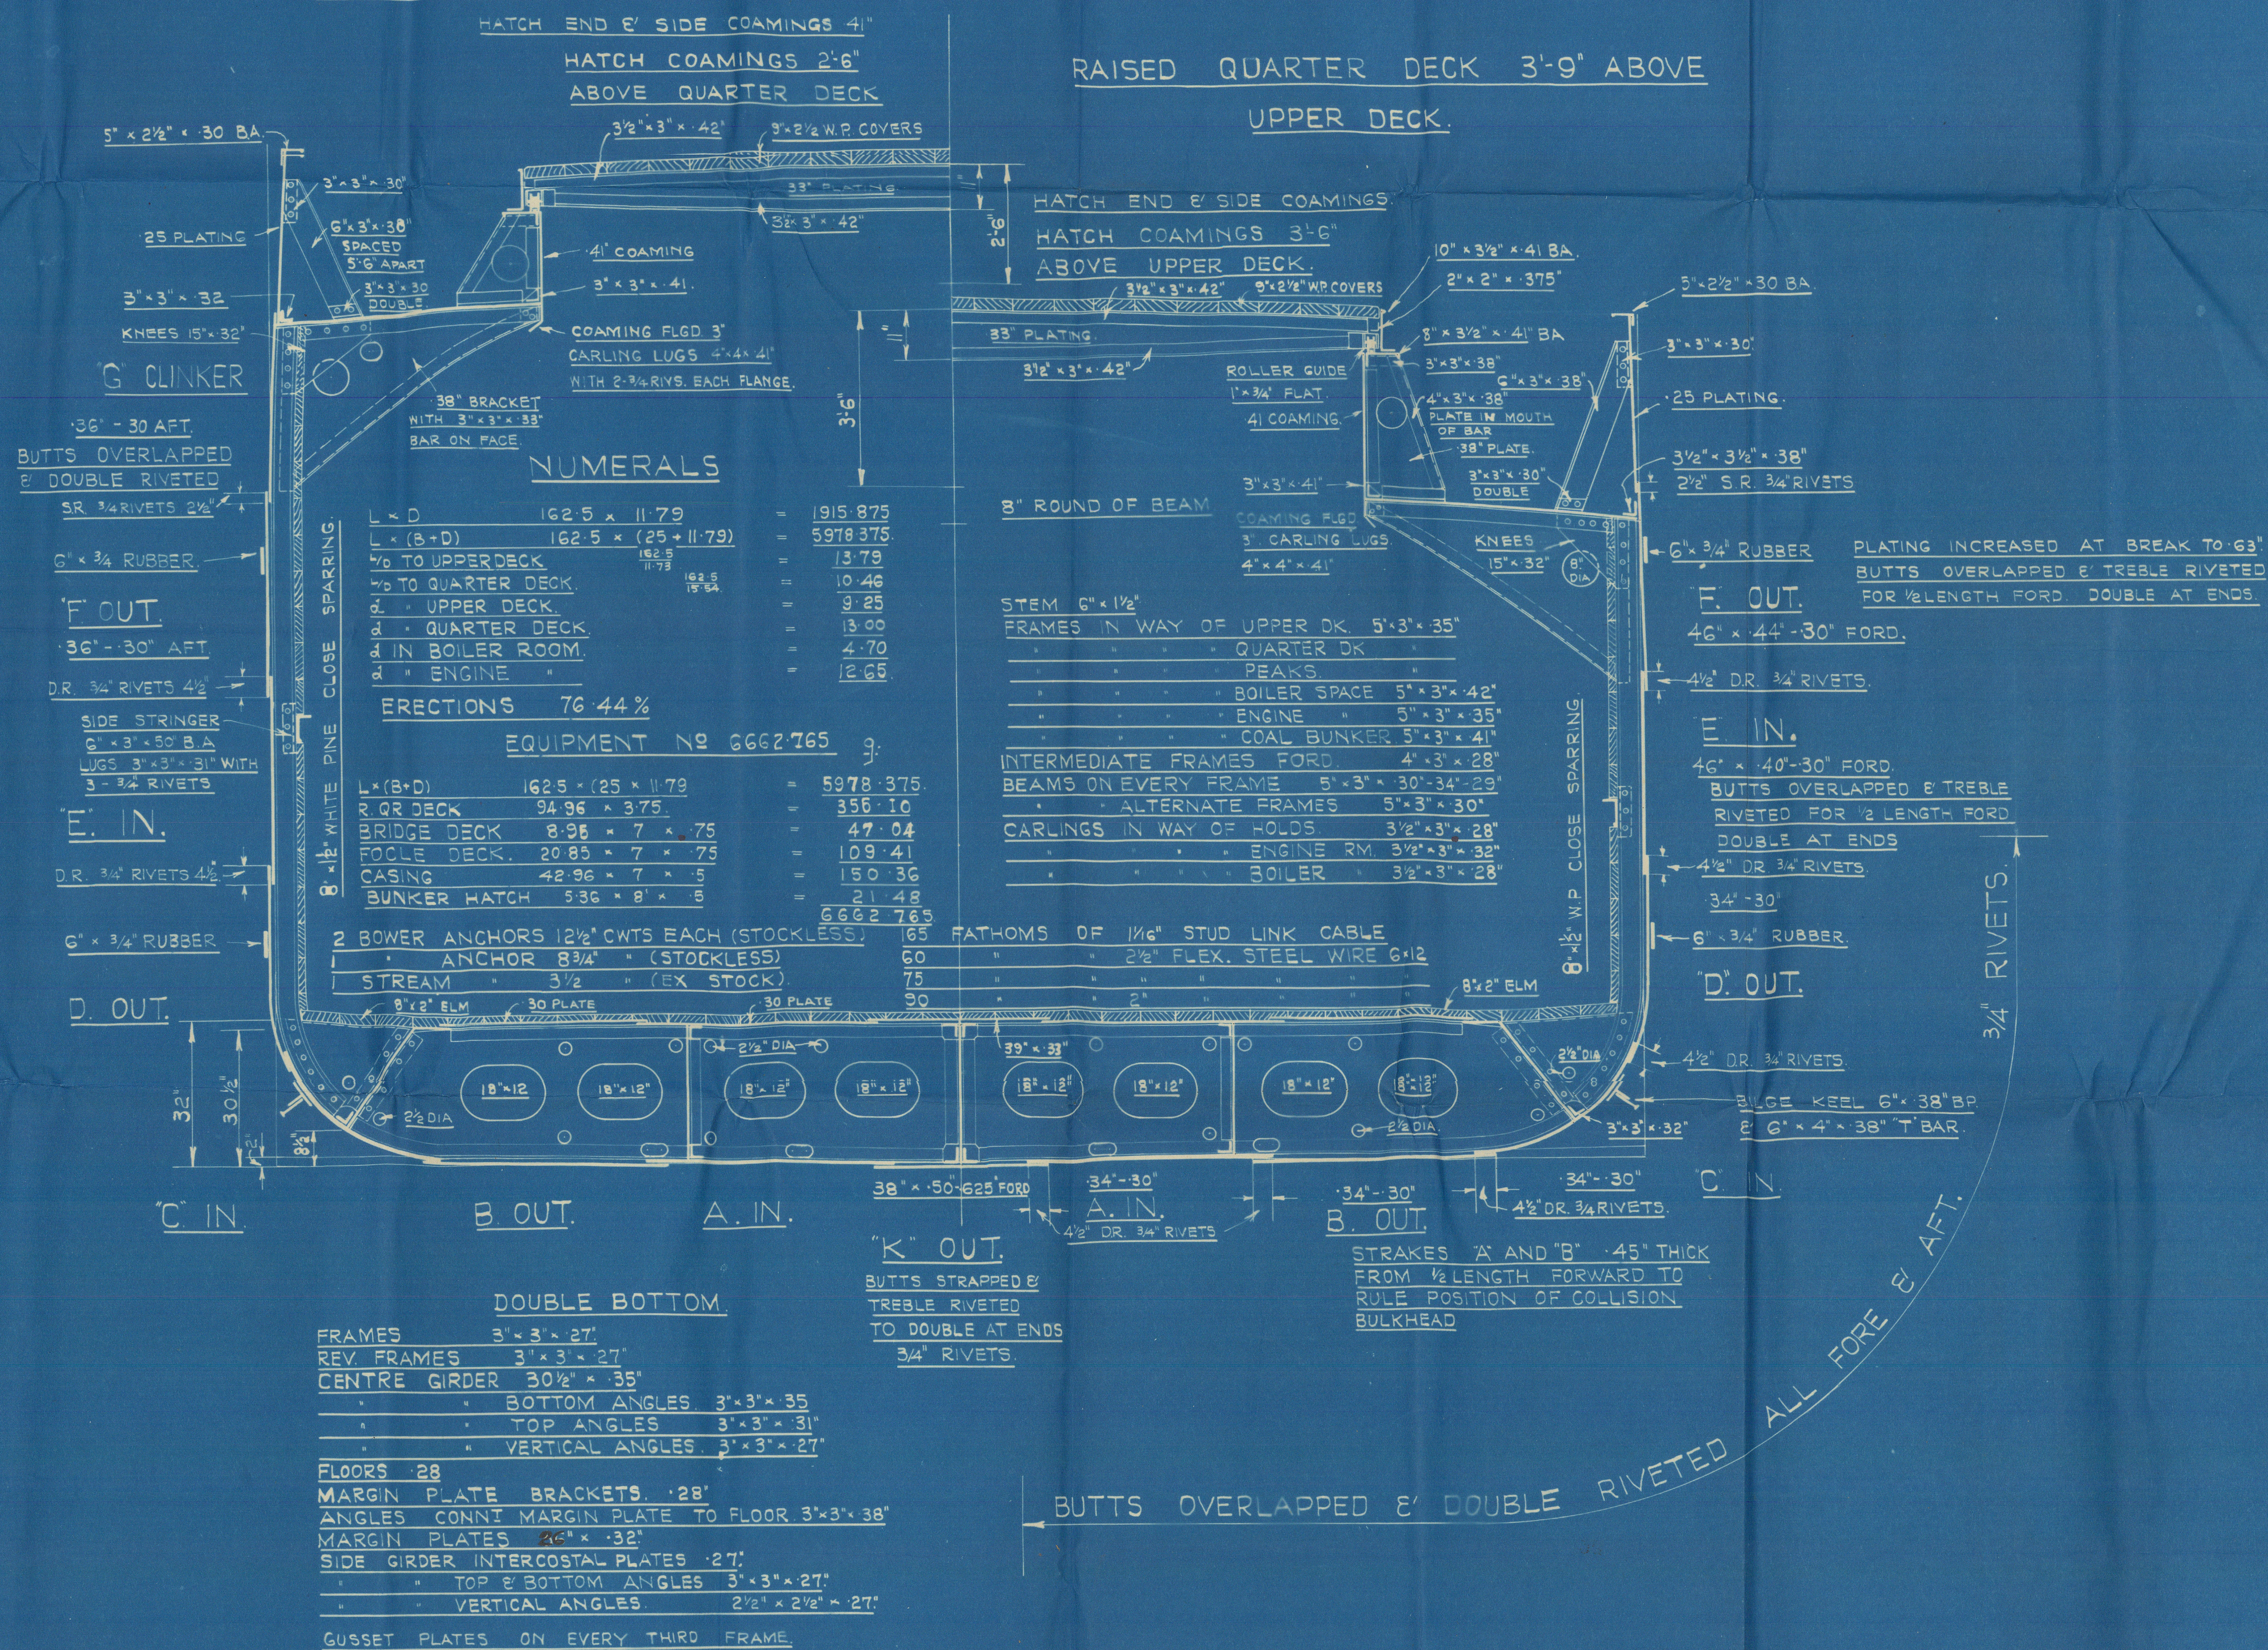


M/M 10424
Scott & Sons.

N^o 338;
CUMA
s/s. "PYROPE"
x

Leadship Section
(as built).

GLASGOW REPORT No. 57275

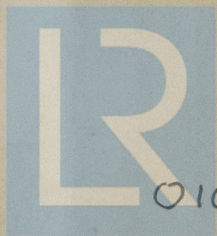

© 2021

Lloyd's Register
Foundation

010416-010427-0223