
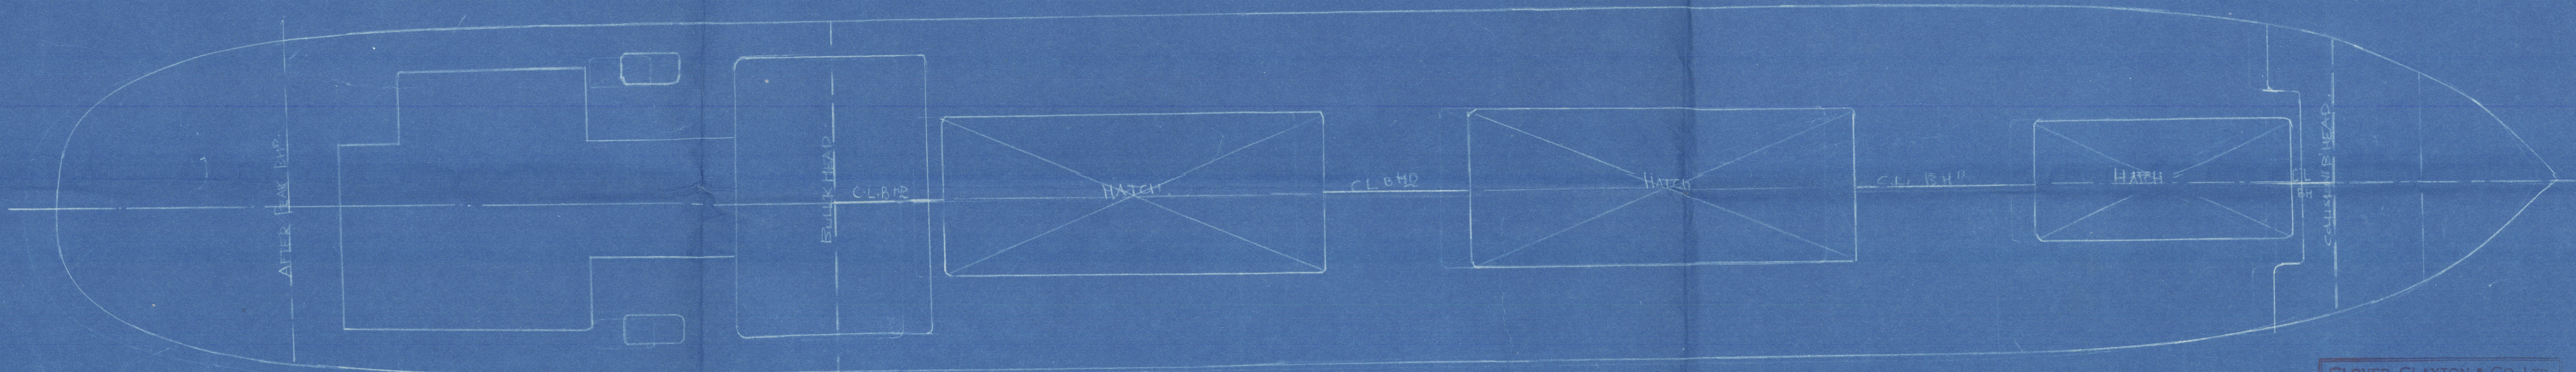


SS. "CHLORIS" ex "EIDER"

SCALE 1:100.

For C.L. Bulkheads see separate details

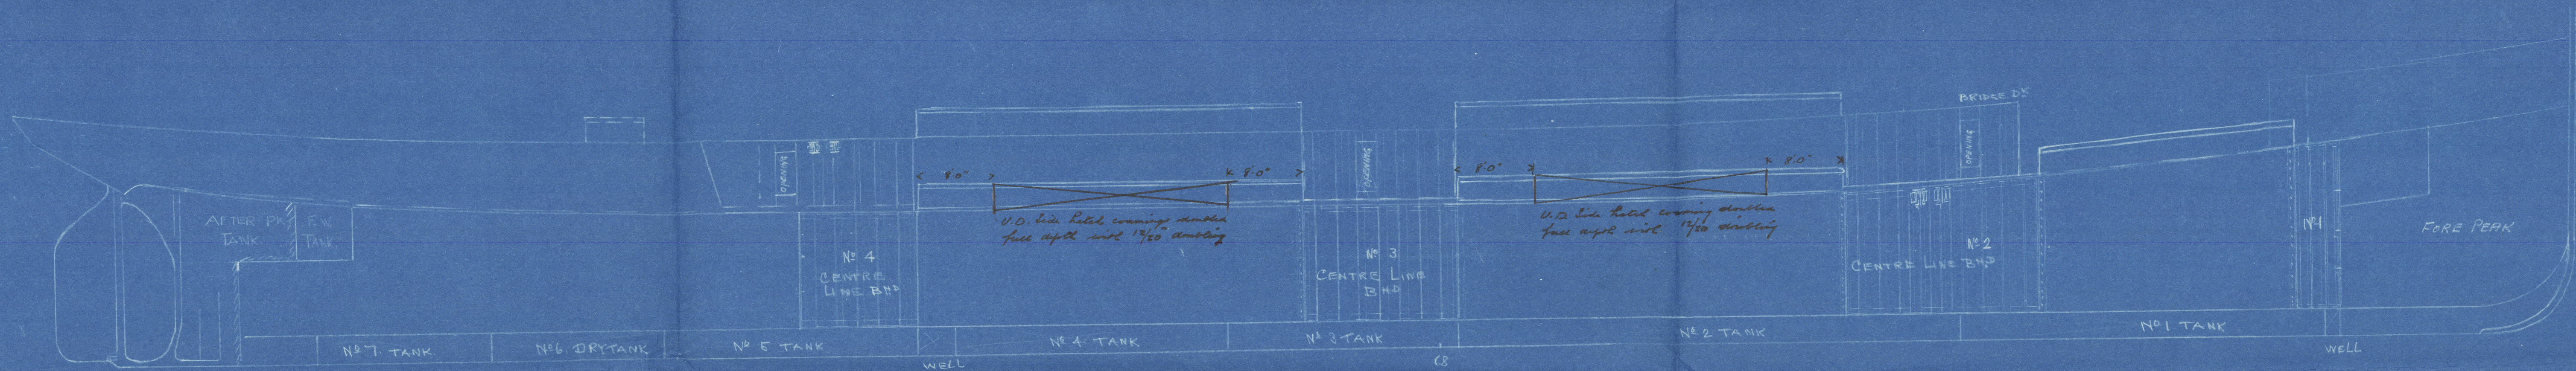

W. G. L.
19/7/23.

CLOVER, CLAYTON & CO. LTD.
BIRKENHEAD
DRAWING NUMBER
DATE 17/7/23

S. S. 'Chloris.'

ex German Steamer 'Edda'

Longitudinal & Deck plan
showing extent of Centre Line
Bulkheads as built

Liv. 85543.



© 2021

Lloyd's Register
Foundation

010509-010518-0003