

T.S.S. "PRINCESS JOAN" BETH

MIDSHIP SECTION

SCALE $\frac{1}{2}$ " = 1 FOOT.

AS FITTED.

DIMENSIONS 351'0" B.P. x 52'0" MLD. x 19'0" MLD. TO MAIN DECK
LENGTH OVERALL = 366'0".

TO CLASS 100 A.I. WITH FREEBOARD CORRESPONDING TO A MEAN DRAFT OF 16'0" MOULDED
FOR CHANNEL AND SOUND SERVICE - SEATTLE AND SKAGWAY. FOR ALL SEASONS.



ALL SECTIONS ARE NEW BRITISH STANDARD.

EQUIPMENT :-

SECOND LONGITUDINAL NUMERAL	Lx(B+D) = 351 x (52+27.75) =	27992
UPPER TO PROMENADE TWEEN DECK (FRS. 20-21) 307'25" x 7'75" x 1'75"		= 1785.9
HOUSE ON UPPER DECK (FRS. 22-23) 24'75" x 7'75" x 1'5"		= 95.9
PROMENADE TO BOAT TWEEN DECK (FRS. 32-33) 135' x 7'5" x 1'75"		= 789.4
HOUSES ON PROMENADE DECK (FRS. 10-32 AND 32-133) 155'25" x 7'5" x 1'5"		= 562.2
HOUSE ON BOAT DECK (FRS. 22-23) 13'25"		
" " " " (FRS. 23-24) 13'25"		
" " " " (FRS. 36-37) 126'		
" " " " (FRS. 33-34) 13'25"		
" " " " (FRS. 101-132) 70'75"		
TOTAL =	286'5" x 7'25" x 1'5"	= 857.3
CASING TOP (FRS. 47-89) 34'5" x 1'5" x 1'5"		= 70.8
EQUIPMENT NUMERAL		= 32143.5


EQUIPMENT -

	(1 GRADE ABOVE LLOYDS)
3 BOWER ANCHORS EACH	57 CWTs. STOCKLESS
1 STREAM ANCHOR	16 1/2 CWTs. EX. STOCK
270 FATHOMS	2 3/4" STUD CHAIN CABLE
30 FATHOMS	4 3/4" STEEL WIRE
120 FATHOMS	4 3/4" STEEL WIRE TOWLINE
2 @ 30 FATHOMS	6" HEMP
2 @ 90 FATHOMS	7" HEMP

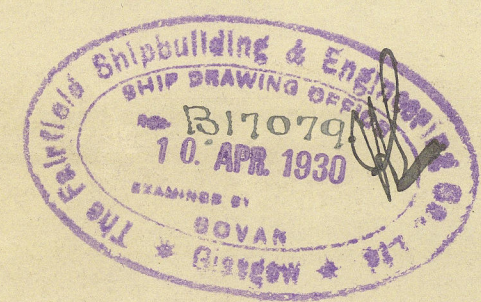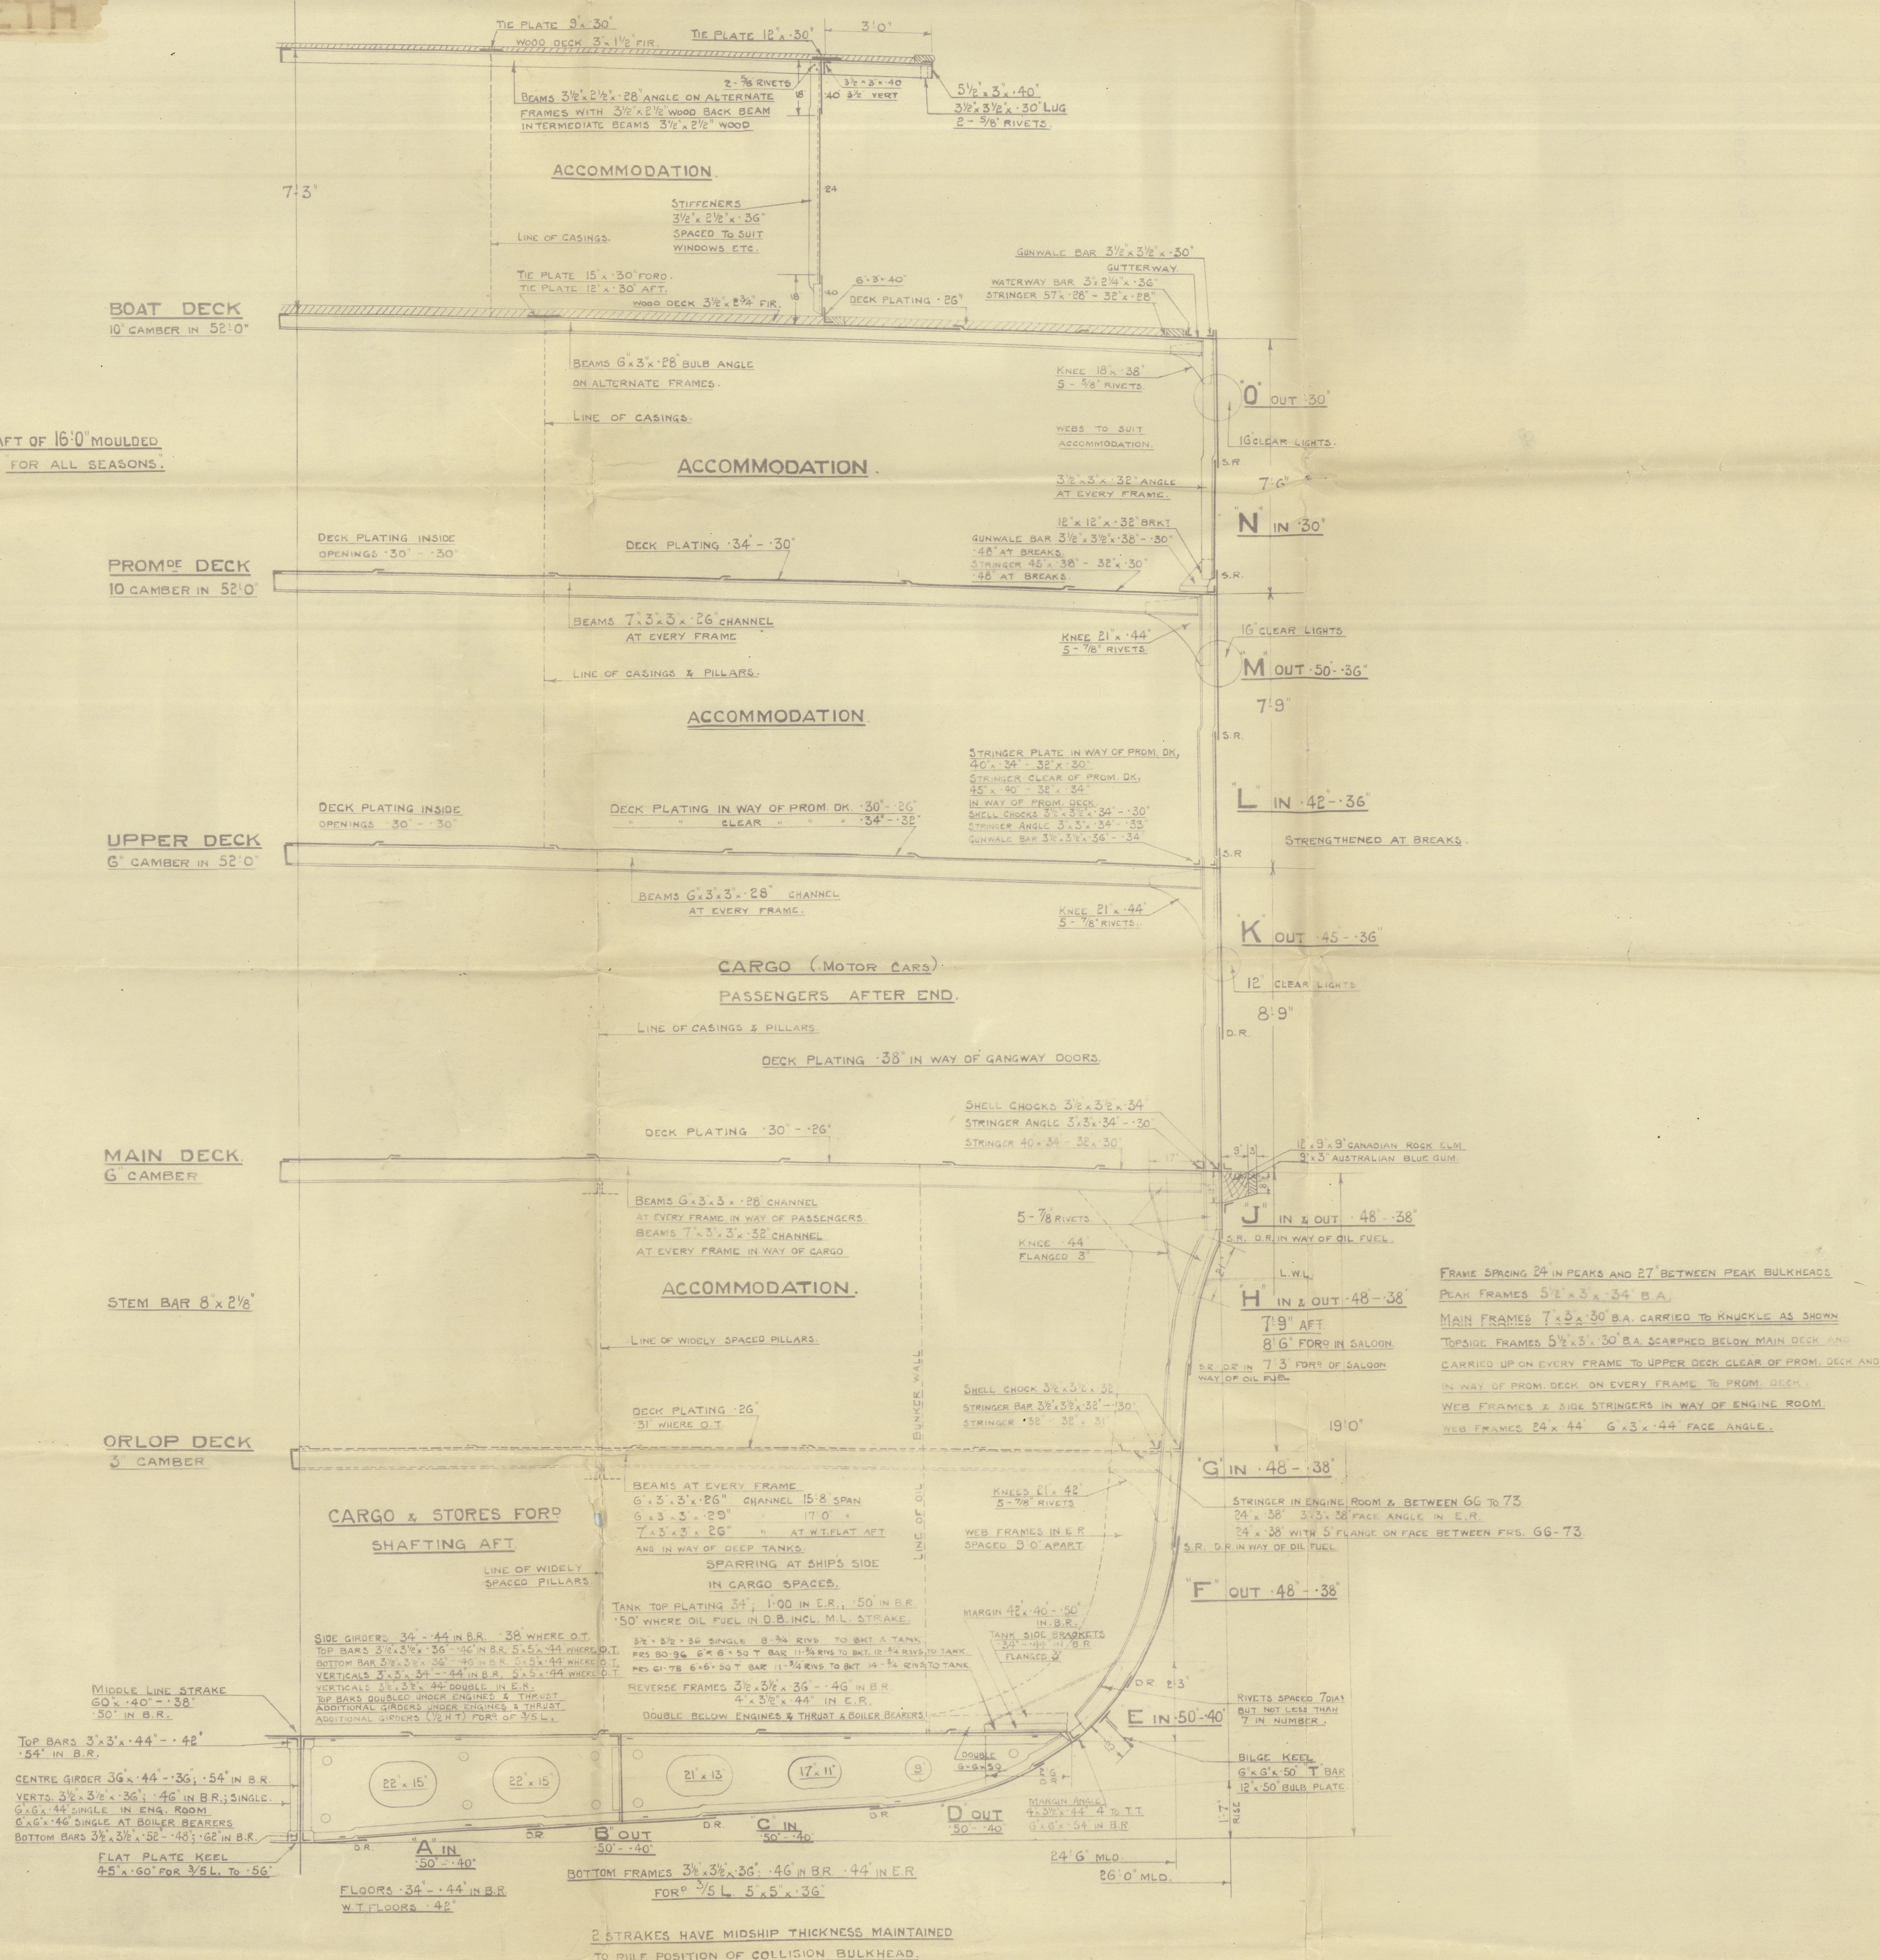

Fairfield S. B. & E. Co. Ltd


No 639

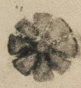Princess Joan 

Midship Section
(As built)

GLASGOW REPORT No 50330

638 50273

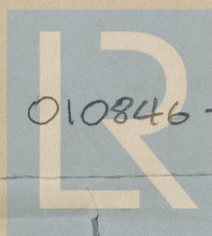

© 2021

010846-010857-0001

Lloyd's Register
Foundation