

LENGTH P.P. 305'-9"  
 BREADTH (MOULDED) 41'-9"  
 DEPTH (UPPER DECK) 25'-0"  
 " (TWEEN DECK) 18'-0"



# M.V. "CERION"

## PROFILE AND DECKS PLAN.

### SCALE 1/8" = 1'-0"

LLOYDS CLASS + 100A1 (FULL SCANTLING)

LLOYDS NUMBERS.  
 D = 25.00  
 L X D = 30575 x 25.00 = 7643.75  
 L (B + D) = 30575 (41.75 + 25.00) = 2040881  
 L/D = 30575 : 25.00 = 12.23

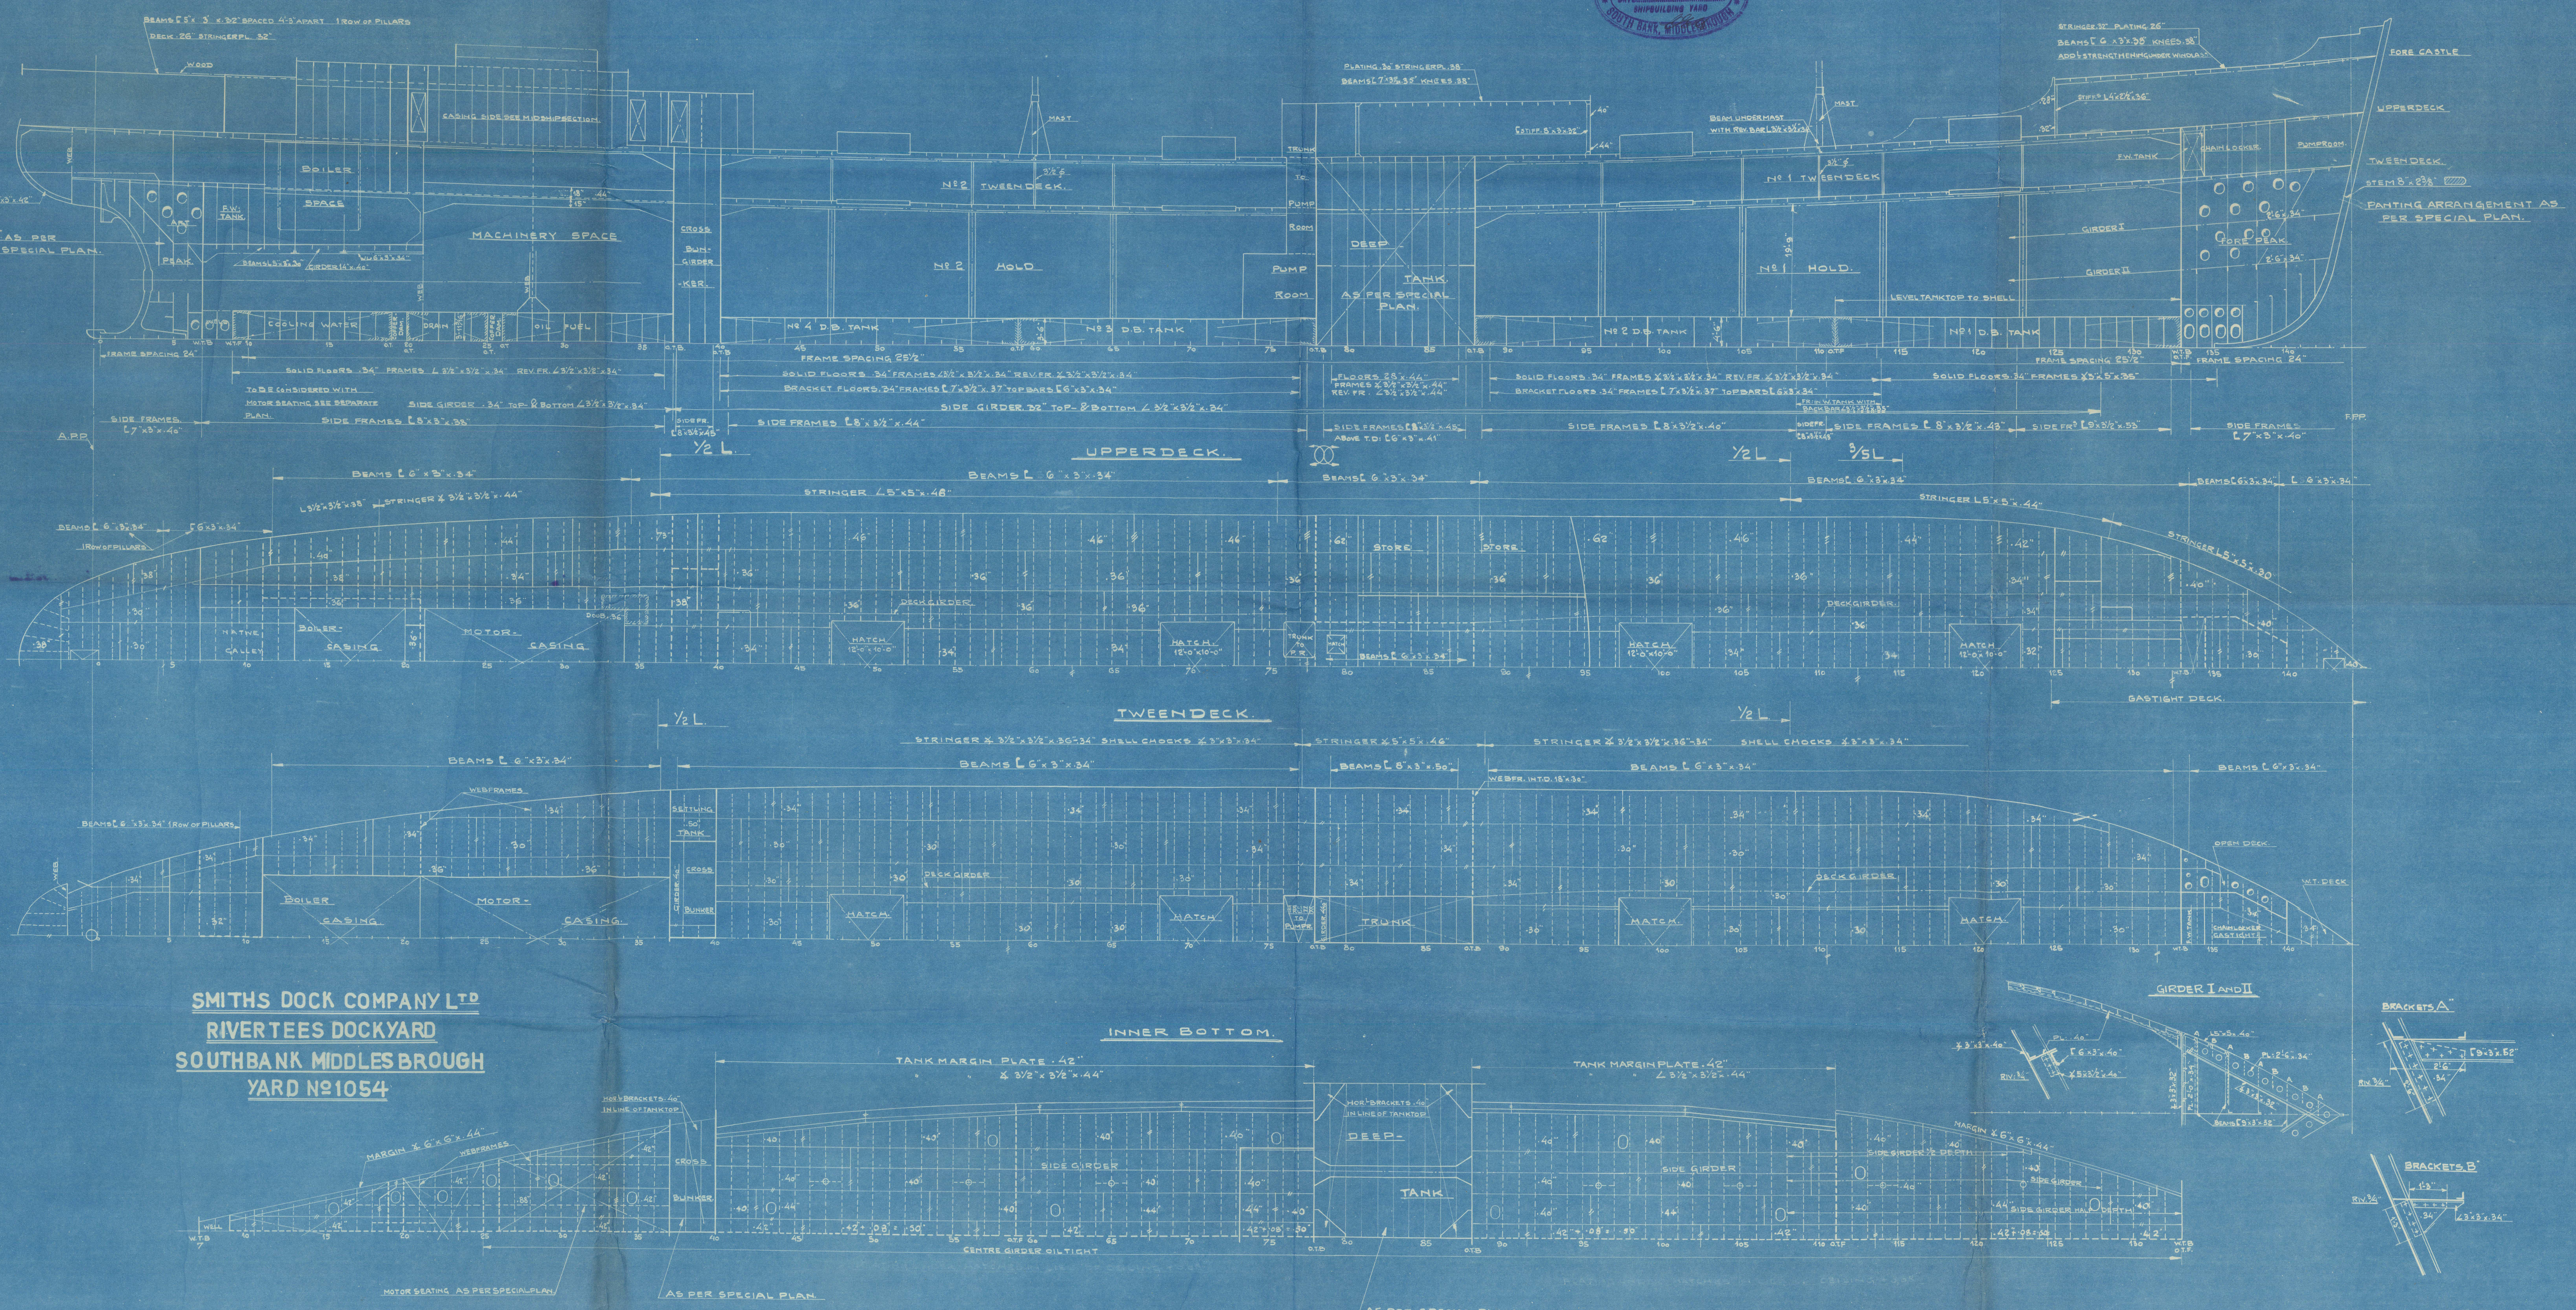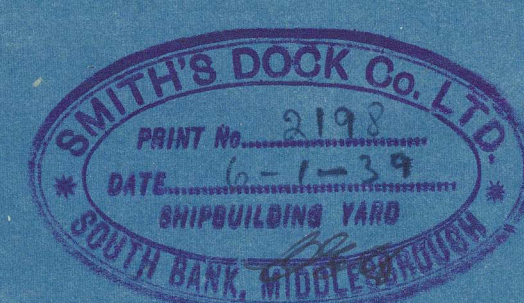

SMITHS DOCK COMPANY LTD  
 RIVER TEES DOCKYARD  
 SOUTHBANK MIDDLESBROUGH  
 YARD No 1054

No 70674



M/V CERION

PROFILE & DECK PLANS

As BUILT.

Mal. Rpt. No. 16490



© 2021

Lloyd's Register  
Foundation

011057-011061-0041