

SCALE :- $\frac{1}{2}'' = 1$ FOOT.


TO LLOYDS REQUIREMENTS FOR CLASS 100 A.I. FULL SCANTLING.

[illegible]

EQUIPMENT				
2	2	2	2	2
1	"	"	"	"
1	STREAM	"	10	EX STOCK
240	FMS	1 3/4"	"	"
75	"	4 1/2"	"	"
90	"	4"	"	"
(2)	90	"	"	"
(2)	90	"	"	"
(4)	90	"	"	"

ALEXANDER STEPHEN & SONS, LTD
SHIPBUILDERS &
ENGINEERS.
GLASGOW.

PLAN NO 110
DATE Dec. 14. 1919

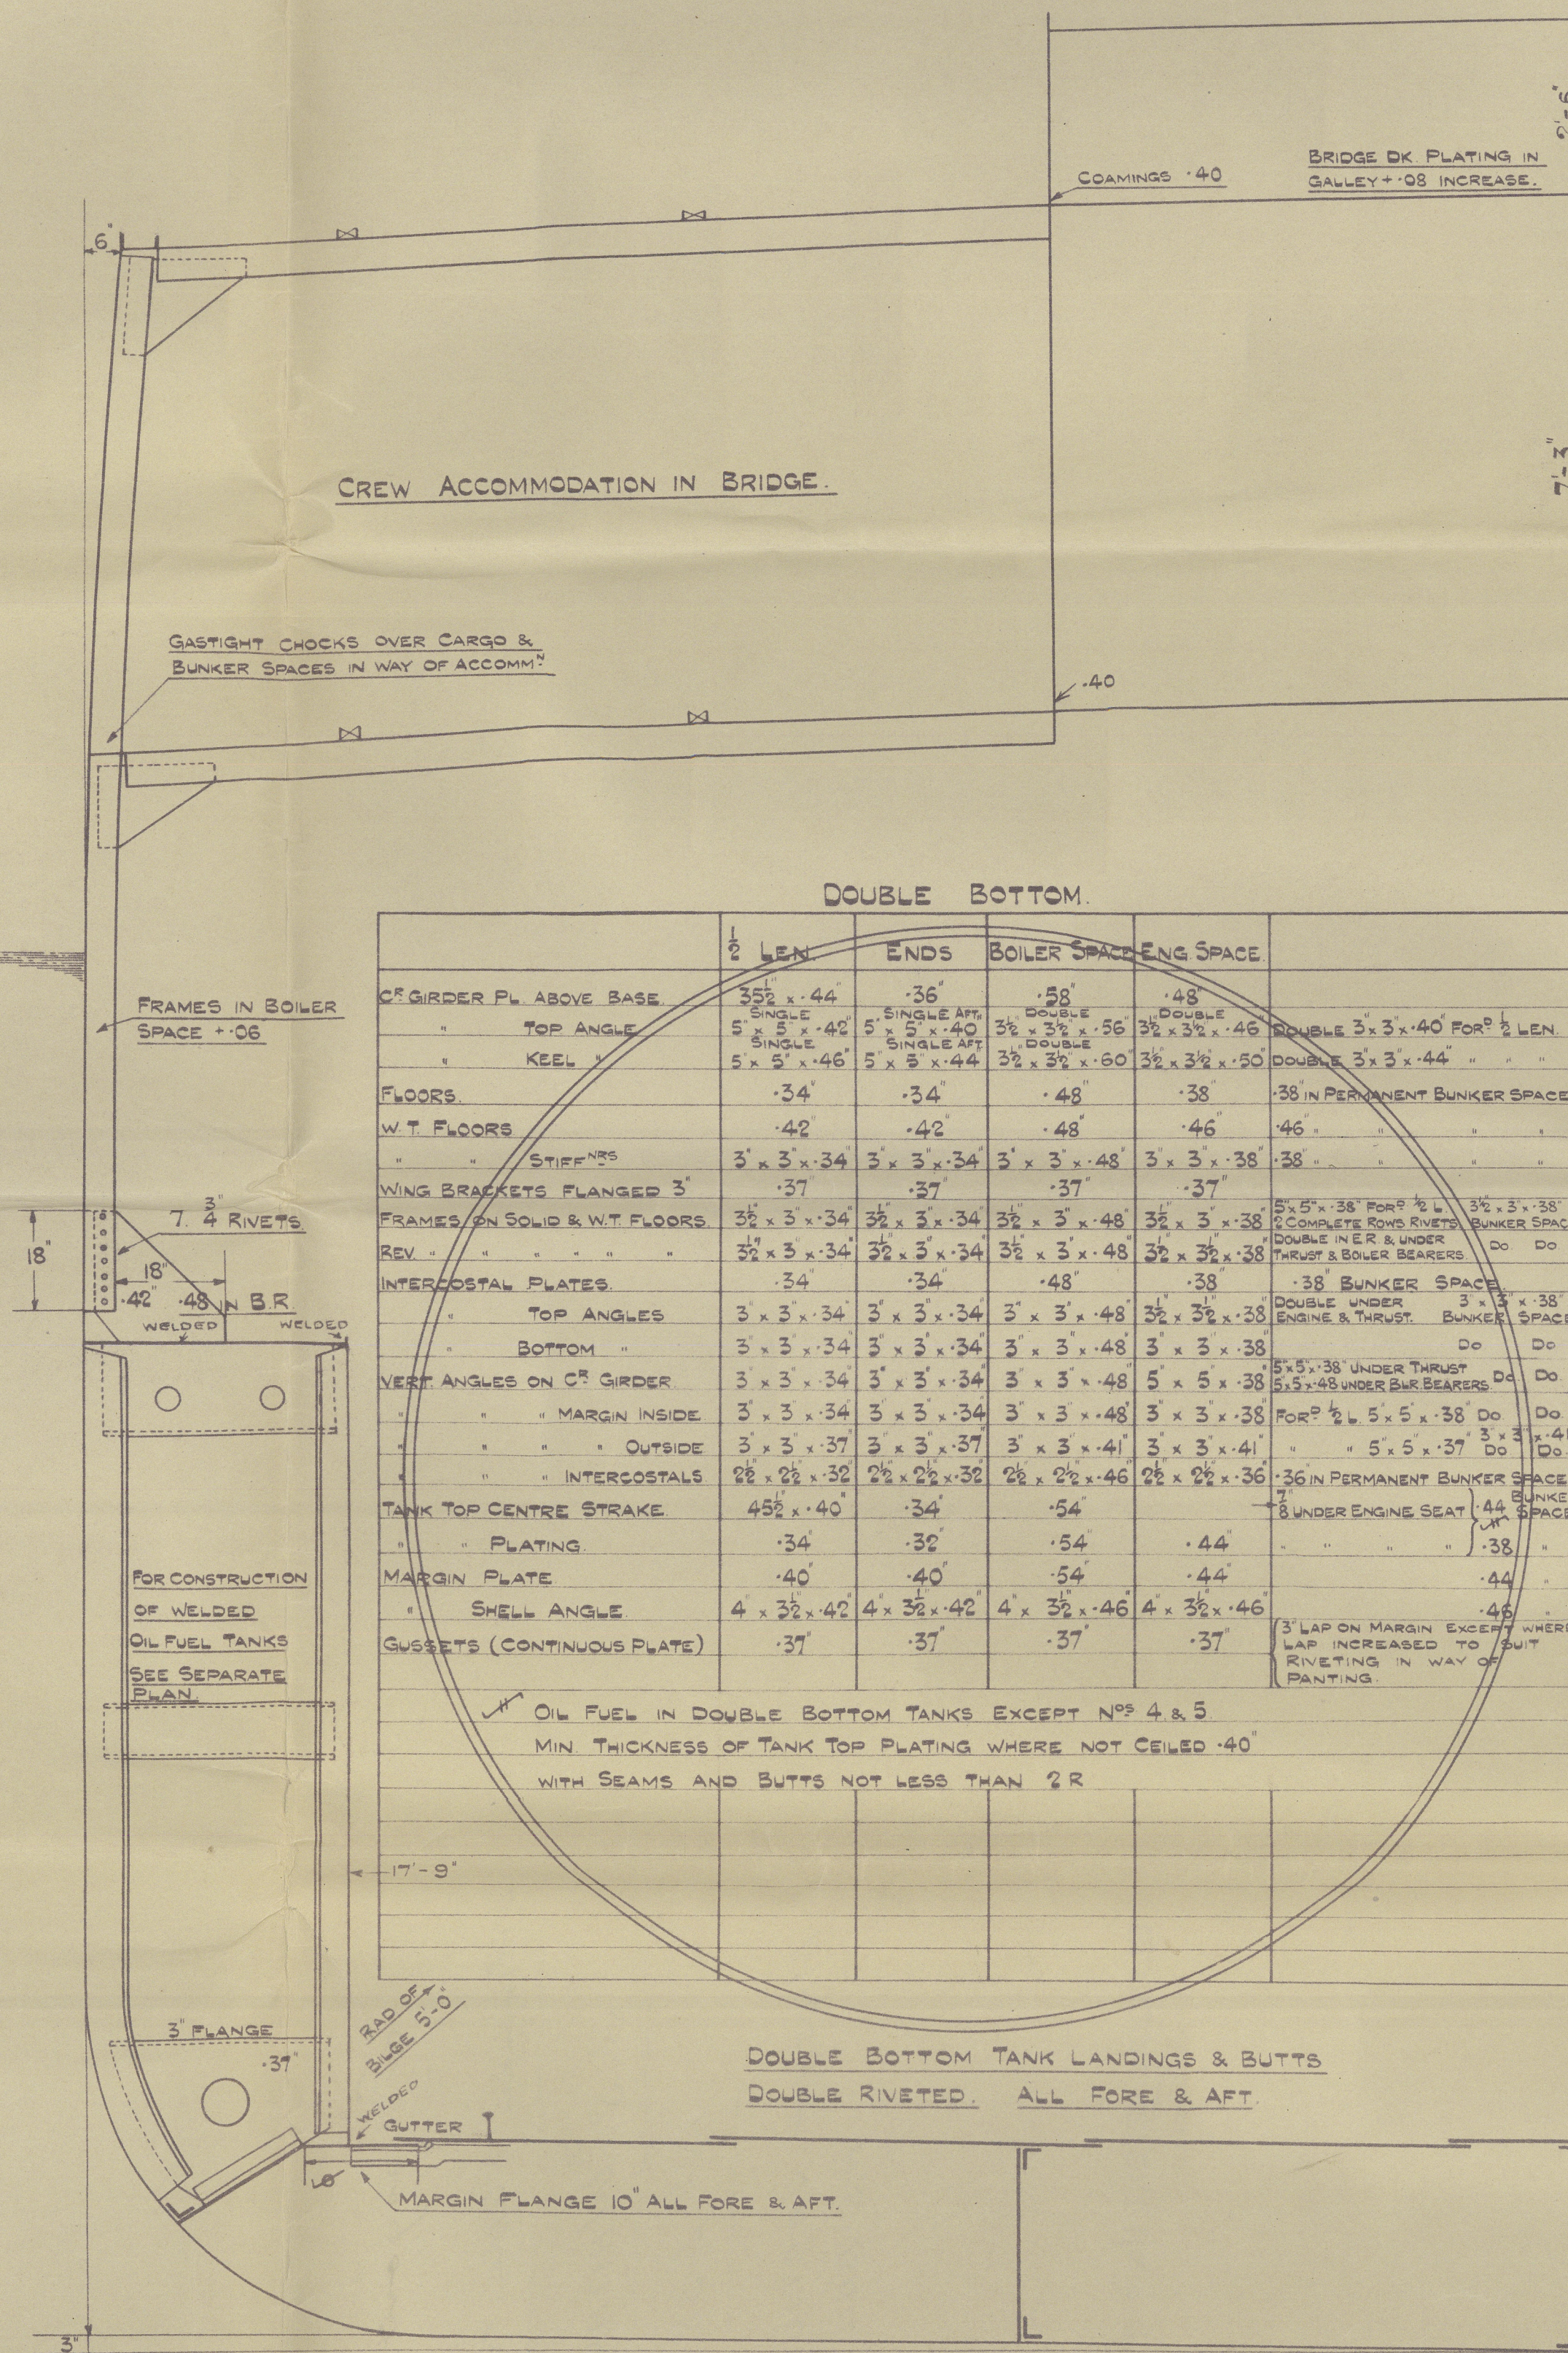

NOTE PER SPEC! FLOORS UNDER ENGINE, BOILER & THRUST SEATS
ALSO UNDER WIDE SPACED PILLARS, FITTED
FLUSH WITH HEELS OF FRAMES & REV. FRAMES.

Glasgow.

Alexander Stephens & Sons Ltd.

S. S. "WAITAKI"

No. 538

MIDSHIP SECTION
AS BUILT.

GLASGOW REPORT No. 5 4 3 9 2



011079-011088-0049 © 2020

Lloyd's Register
Foundation