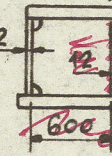




### HATCH SIDE COAMINGS

HATCH	UPPER DECK	NOTES
1	550 x 12 + <del>260</del> 270 x 30	
2	550 x 12 + <del>210</del> 210 x 20	
3	550 x 12 + <del>400</del> 400 x 35	
4	550 x 12 + <del>400</del> 400 x 35	
5	550 x 12 + <del>300</del> 300 x 30	
HATCH	SECOND DECK	NOTES
1	600 x 12 + <del>250</del> 250 x 20 400 x 25	INNER WEB PLATE INTERCOSTAL THROUGH WELDED FROM OUTSIDE BUILT-UP COAMING 
2	600 x 12 + <del>270</del> 270 x 35 300	
3	WEB 680 x 12 FACE PLATE 650 x 35	
4	" " 650 x 35 650 x 31	
5	600 x 12 + <del>360</del> 360 x 40 430	
HATCH	THIRD DECK	NOTES
3	WEB 680 x 12 FACE PLATE 650 x 40	BUILT-UP COAMING
HATCH	FORE CASTLE	NOTES
1	400 x 12 + <del>240</del> 240 x 30 15	

## REFERENCES

MIDSHIP SECTION	DRG. No 51
DOUBLE BOTTOM	" " 53
DECKS	" " 56
TRANSV. BULKHEADS	" " 57
FORE BODY	" " 58
AFTER BODY	" " 59
AFTER PLATE AND TUNNEL	" " 63

FOR HATCH END BEAMS AND  
DECK GIRDERS SEE "DECKS" - DRG. N° 56

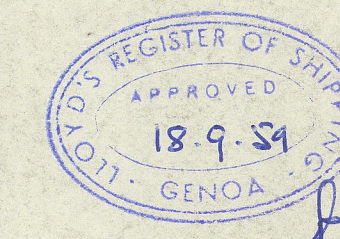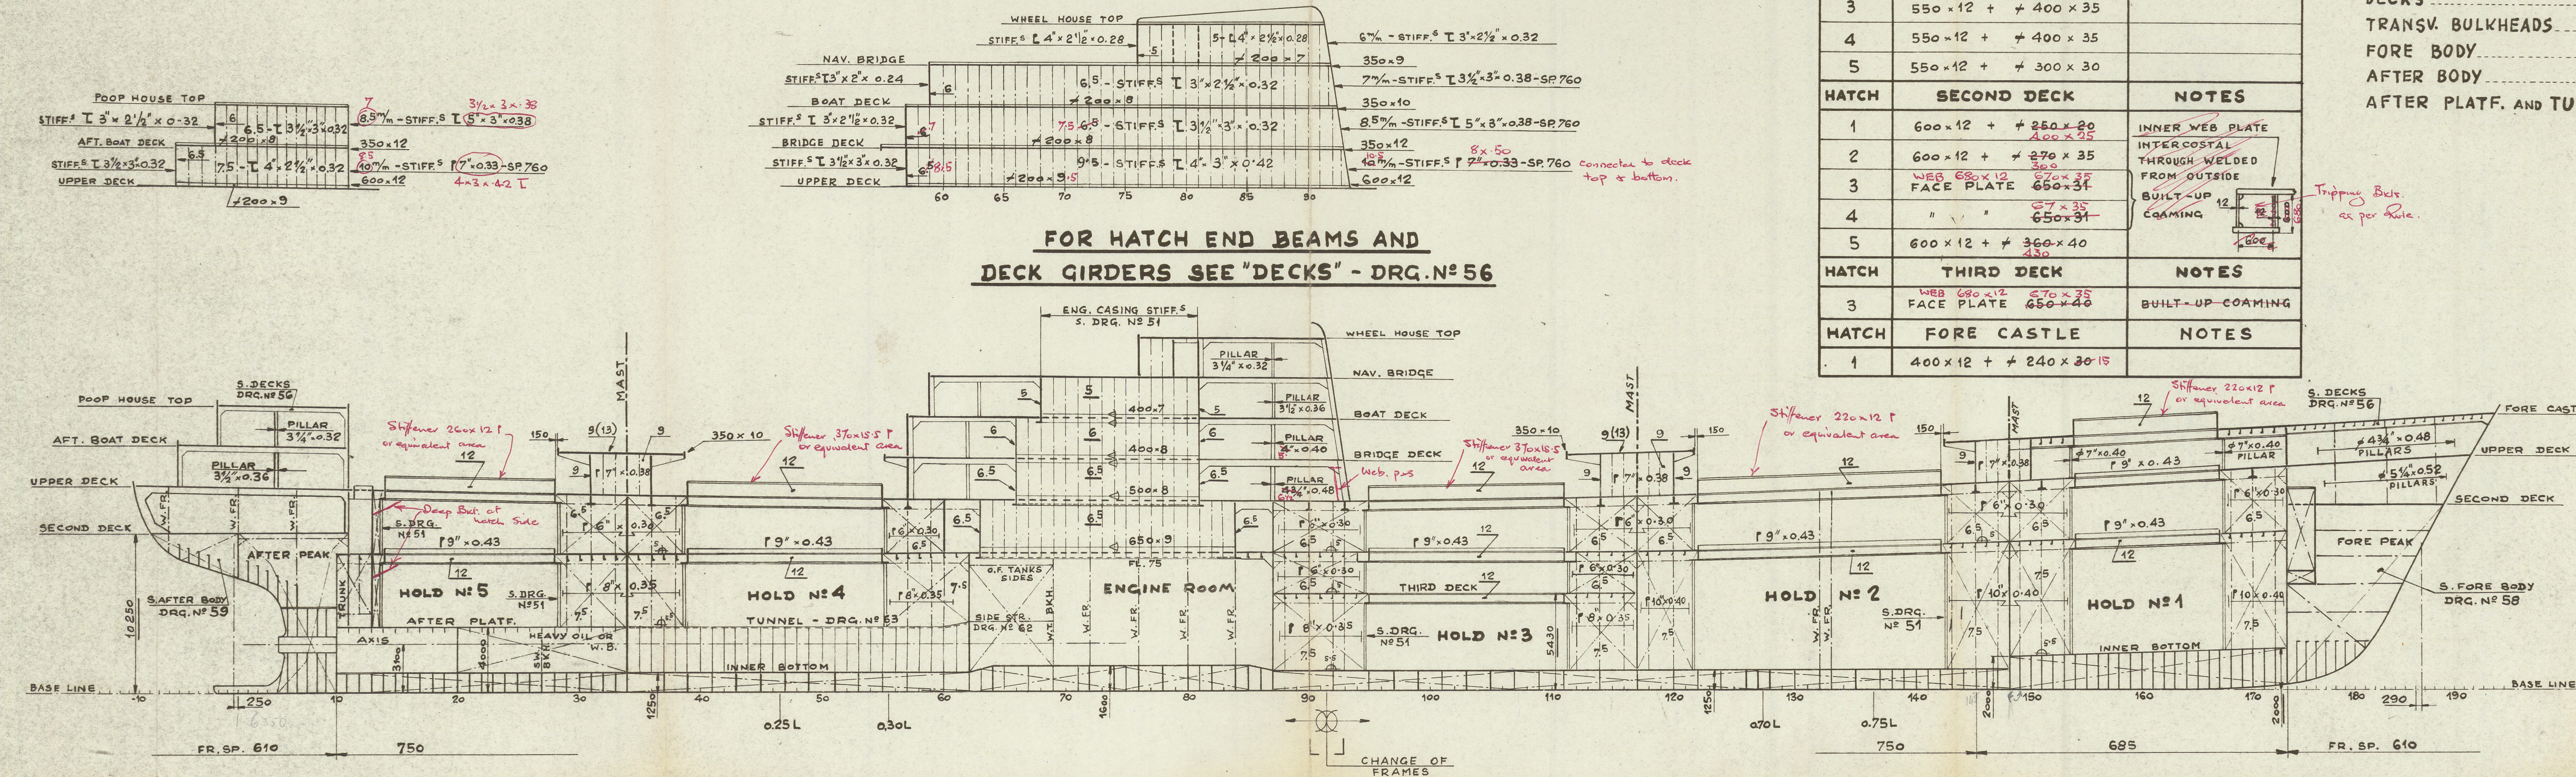

8500/10350 · TON CARGO MOTOR SHIPS  
RIJEKA - YARD N° 480/81/82

MAIERFORM S.A. - GENÈVE

SCALE  
1:200  
0.30 m

LONGIT. SECTION

-VII-59	ms.
PROJECT N° 3608	
DRG. N° 2908/52	



3

RECORDS DEPT.  
LONDON.

WYSPIANSKI ★

Longitudinal Section



© 2021

Lloyd's Register  
Foundation

01110 - 01119 - 084