

M.Y. ACCRITY N^o 190 MIDSHIP SECTION.

DIMNS: 150' 6" B.D. x 27' 6" x 9' 11" M².

SCALE: 1/2" INCH = 1' FOOT.
TO CLASS 100 A1 AT LLOYDS.


EQUIPMENT No.:

L. (B.D.)	5631.71
QR DK 971.3.5	339.0
FOLE DK 20.5.7.75	107.0
AFT HOUSE 26.7.5	91.0
BR 10.25.7.5	35.8
	6204.51

L. (B.D.)	5631.71
L. D	1492.96
L/D	15.1
40 % QR DK	11.2



EQUIPMENT:

1 BOWER ANCHOR	8 3/4 CENTS STOCKLESS
2 "	10 1/4 " EACH "
1 STREAM "	3 1/2 " EX. STOCK
165 FMS. 1 1/16" STUD LINK CABLE	
50 "	2 1/2" STEEL WIRE ROPE
75 "	2 1/2" "
90 "	2 " "

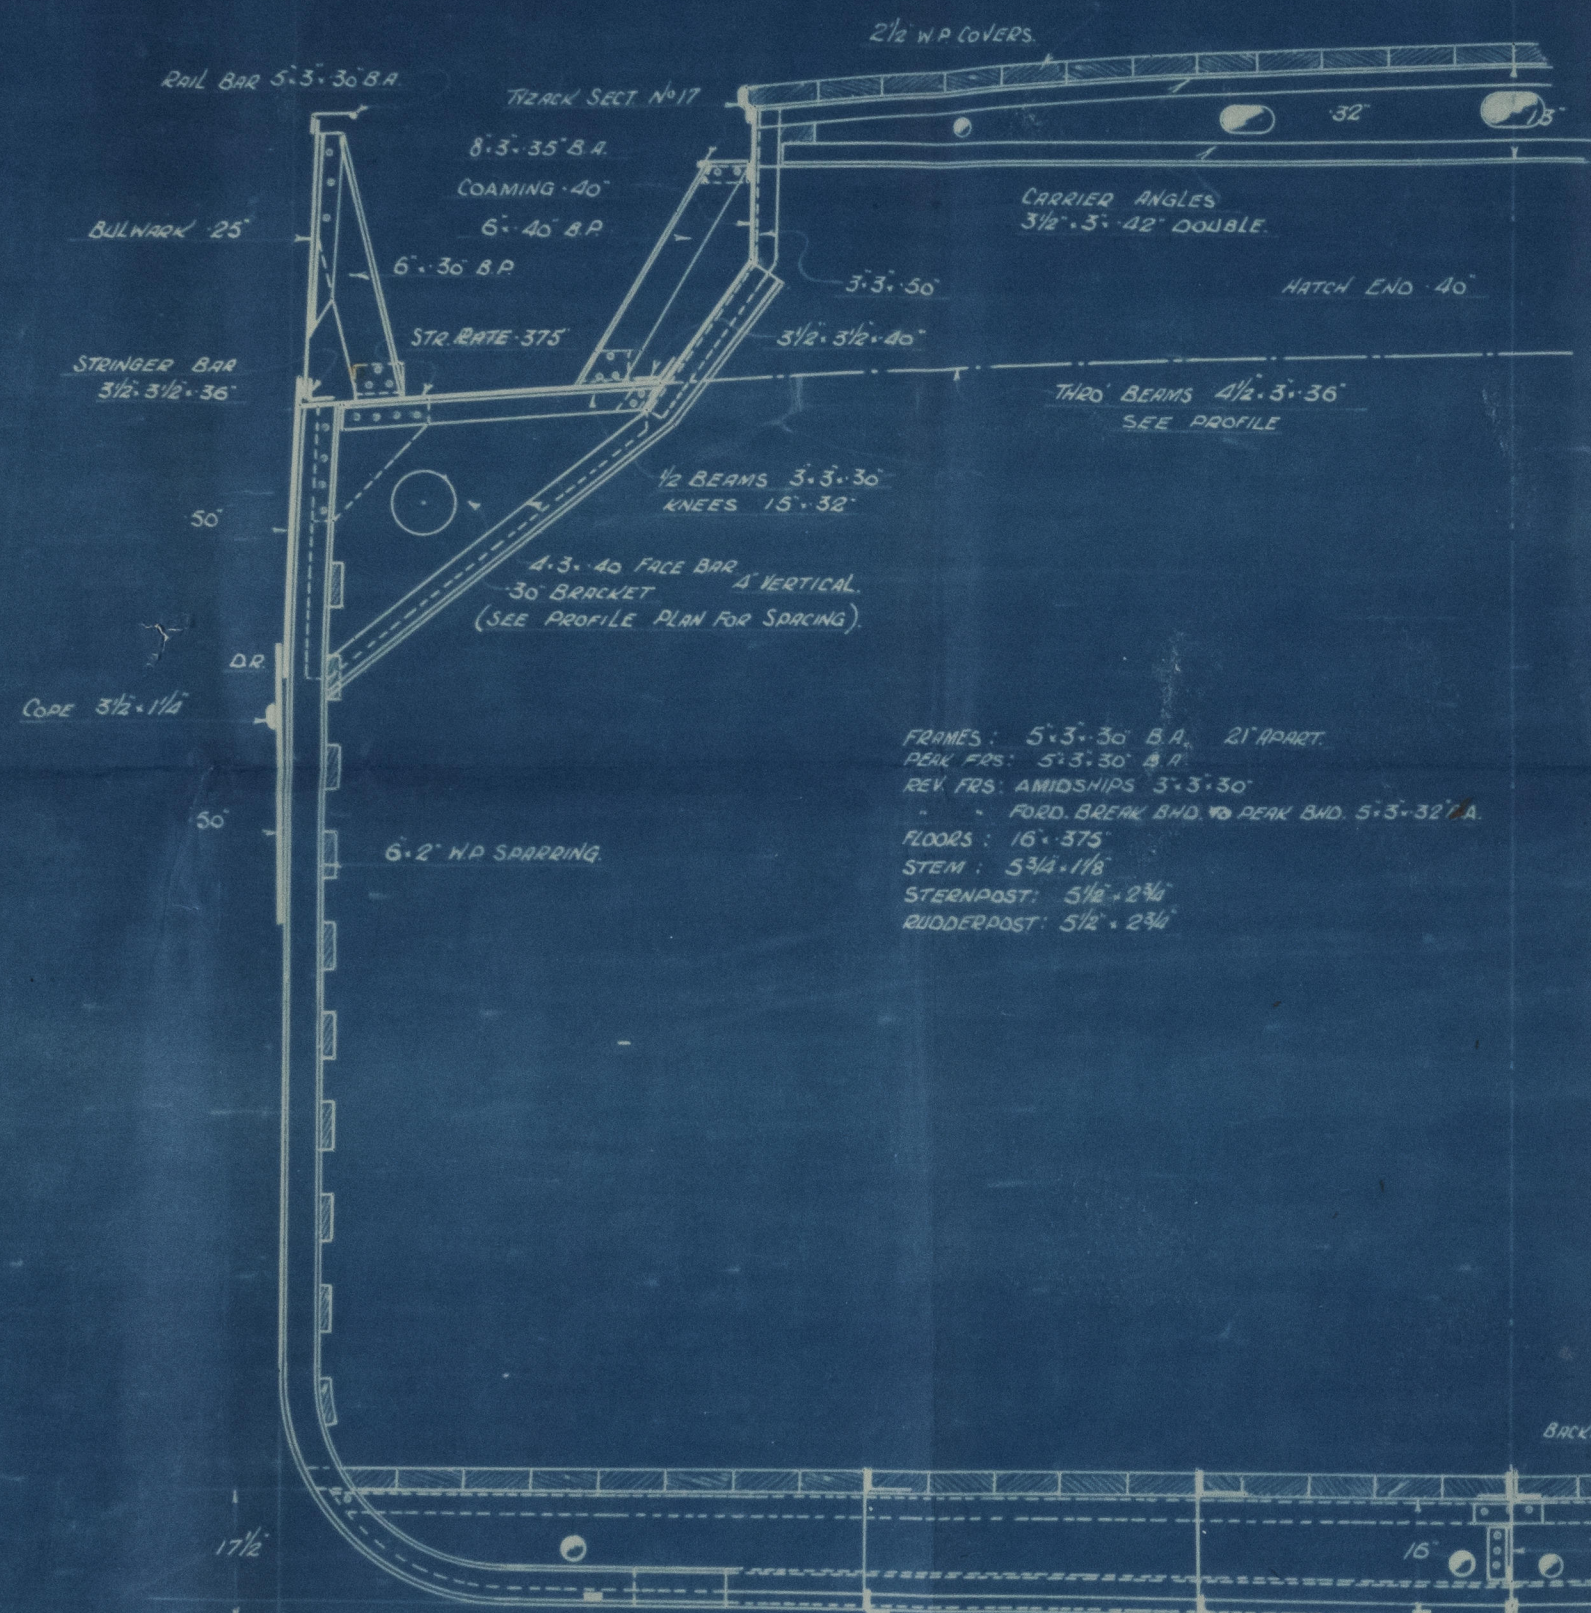

RIVETTING:

SHELL BUTTS & SEAMS D.R. THROUGHOUT
STRINGER BUTTS AT QR DK. ALL D.R.
" " MAIN DK. T.R. FOR 1/2 L. TO D.R.
KEEL BUTTS T.R. TO D.R. AT ENDS.
SHEERSTRAKE AT QR DK. T.R. FOR 1/2 L. ELSEWHERE D.R.
" " MAIN DK. 4.R. AT BREAK TO D.R.
STRAKE BELOW SHEERSTRAKE AT UPPER DK. T.R. FOR 1/2 L. D.R. ELSEWHERE
3/4" RIVETS EXCEPT IN WAY OF BREAK

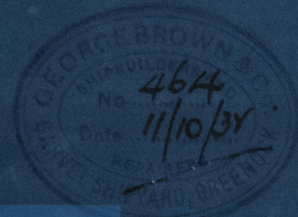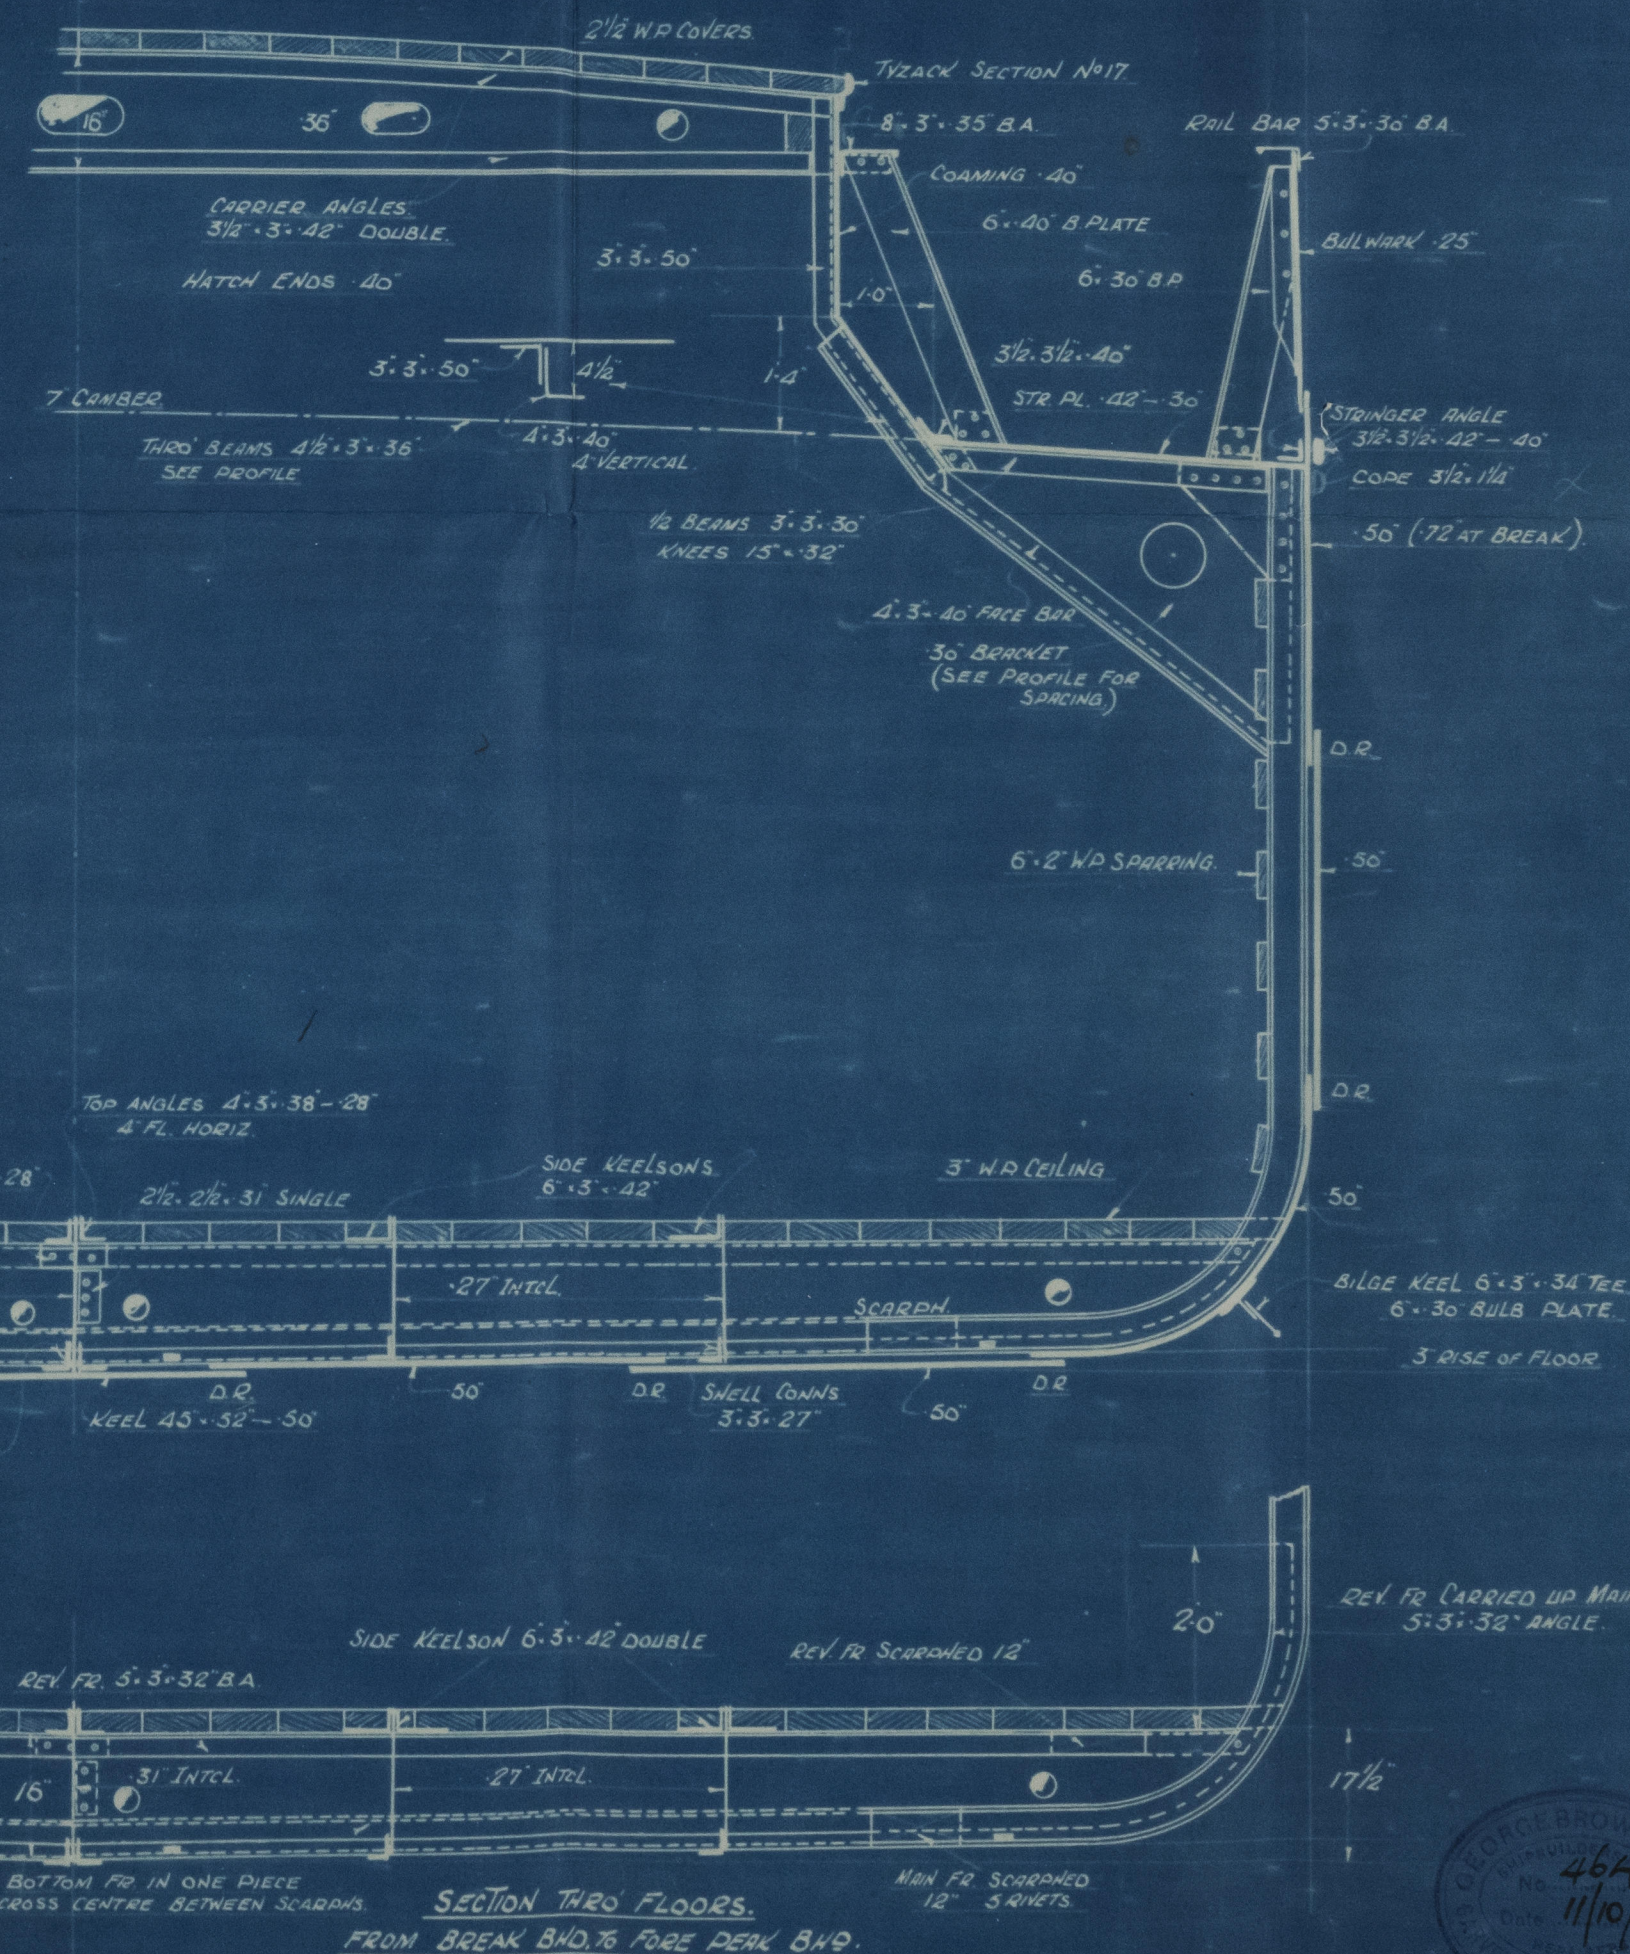

GEO BROWN & Co

N^o 190

M.V. ACCURITY

MIDSHIP
SECTION
As BUILT

GREENOCK 1ST ENTRY

REPORT N^o 20030.



© 2021

Lloyd's Register
Foundation

011860-011868-0158