


EQUIPMENT NUMBER BY LLOYD'S RULE			
EQUIPMENT NUMBER FOR THE HULL	14500 / (1150 + 1100 + 850 + 4300 + (230 - 900))		
EQ NO FOR SUPSTR (P&LE DK)	4,539.23		
	ON UPPER DK	.85 x (1110 + 2.25)	21.21
	ON LOWER DK	.75 x (230 + 32.100)	62.16
EQUIP FOR OTHER ERECTIN	ON BRIDGE DK	.75 x (260 + 130.60)	57.67
	ON BOAT DK	.75 x (260 + 26.20)	51.09
EQUIPMENT	4,732.36		
EQUIPMENT	LETTER		

CLASS	
LLOYD'S REGISTER OF SHIPPING	+ 100A1
NIPPON KAIJI KYOKAI	NS* & MNS*

PRINCIPAL DIMENSION & C	
LENGTH OVERALL	156.370
" BETWEEN PP	145.000
BREADTH MOULDED	19.500
DEPTH (ABOVE TOP OF KEEL)	12.300
DESIGNED LOAD DRAUGHT (ABOVE T O K)	9.000
FREEBOARD	3.324
SHEER AT FP	2.500
" " AP	1.500
CAMBER OF UPPER DECK FOR 19.500 BEAM	380
RISE OF FLOOR	170
RADIUS OF BILGE TURN	2000

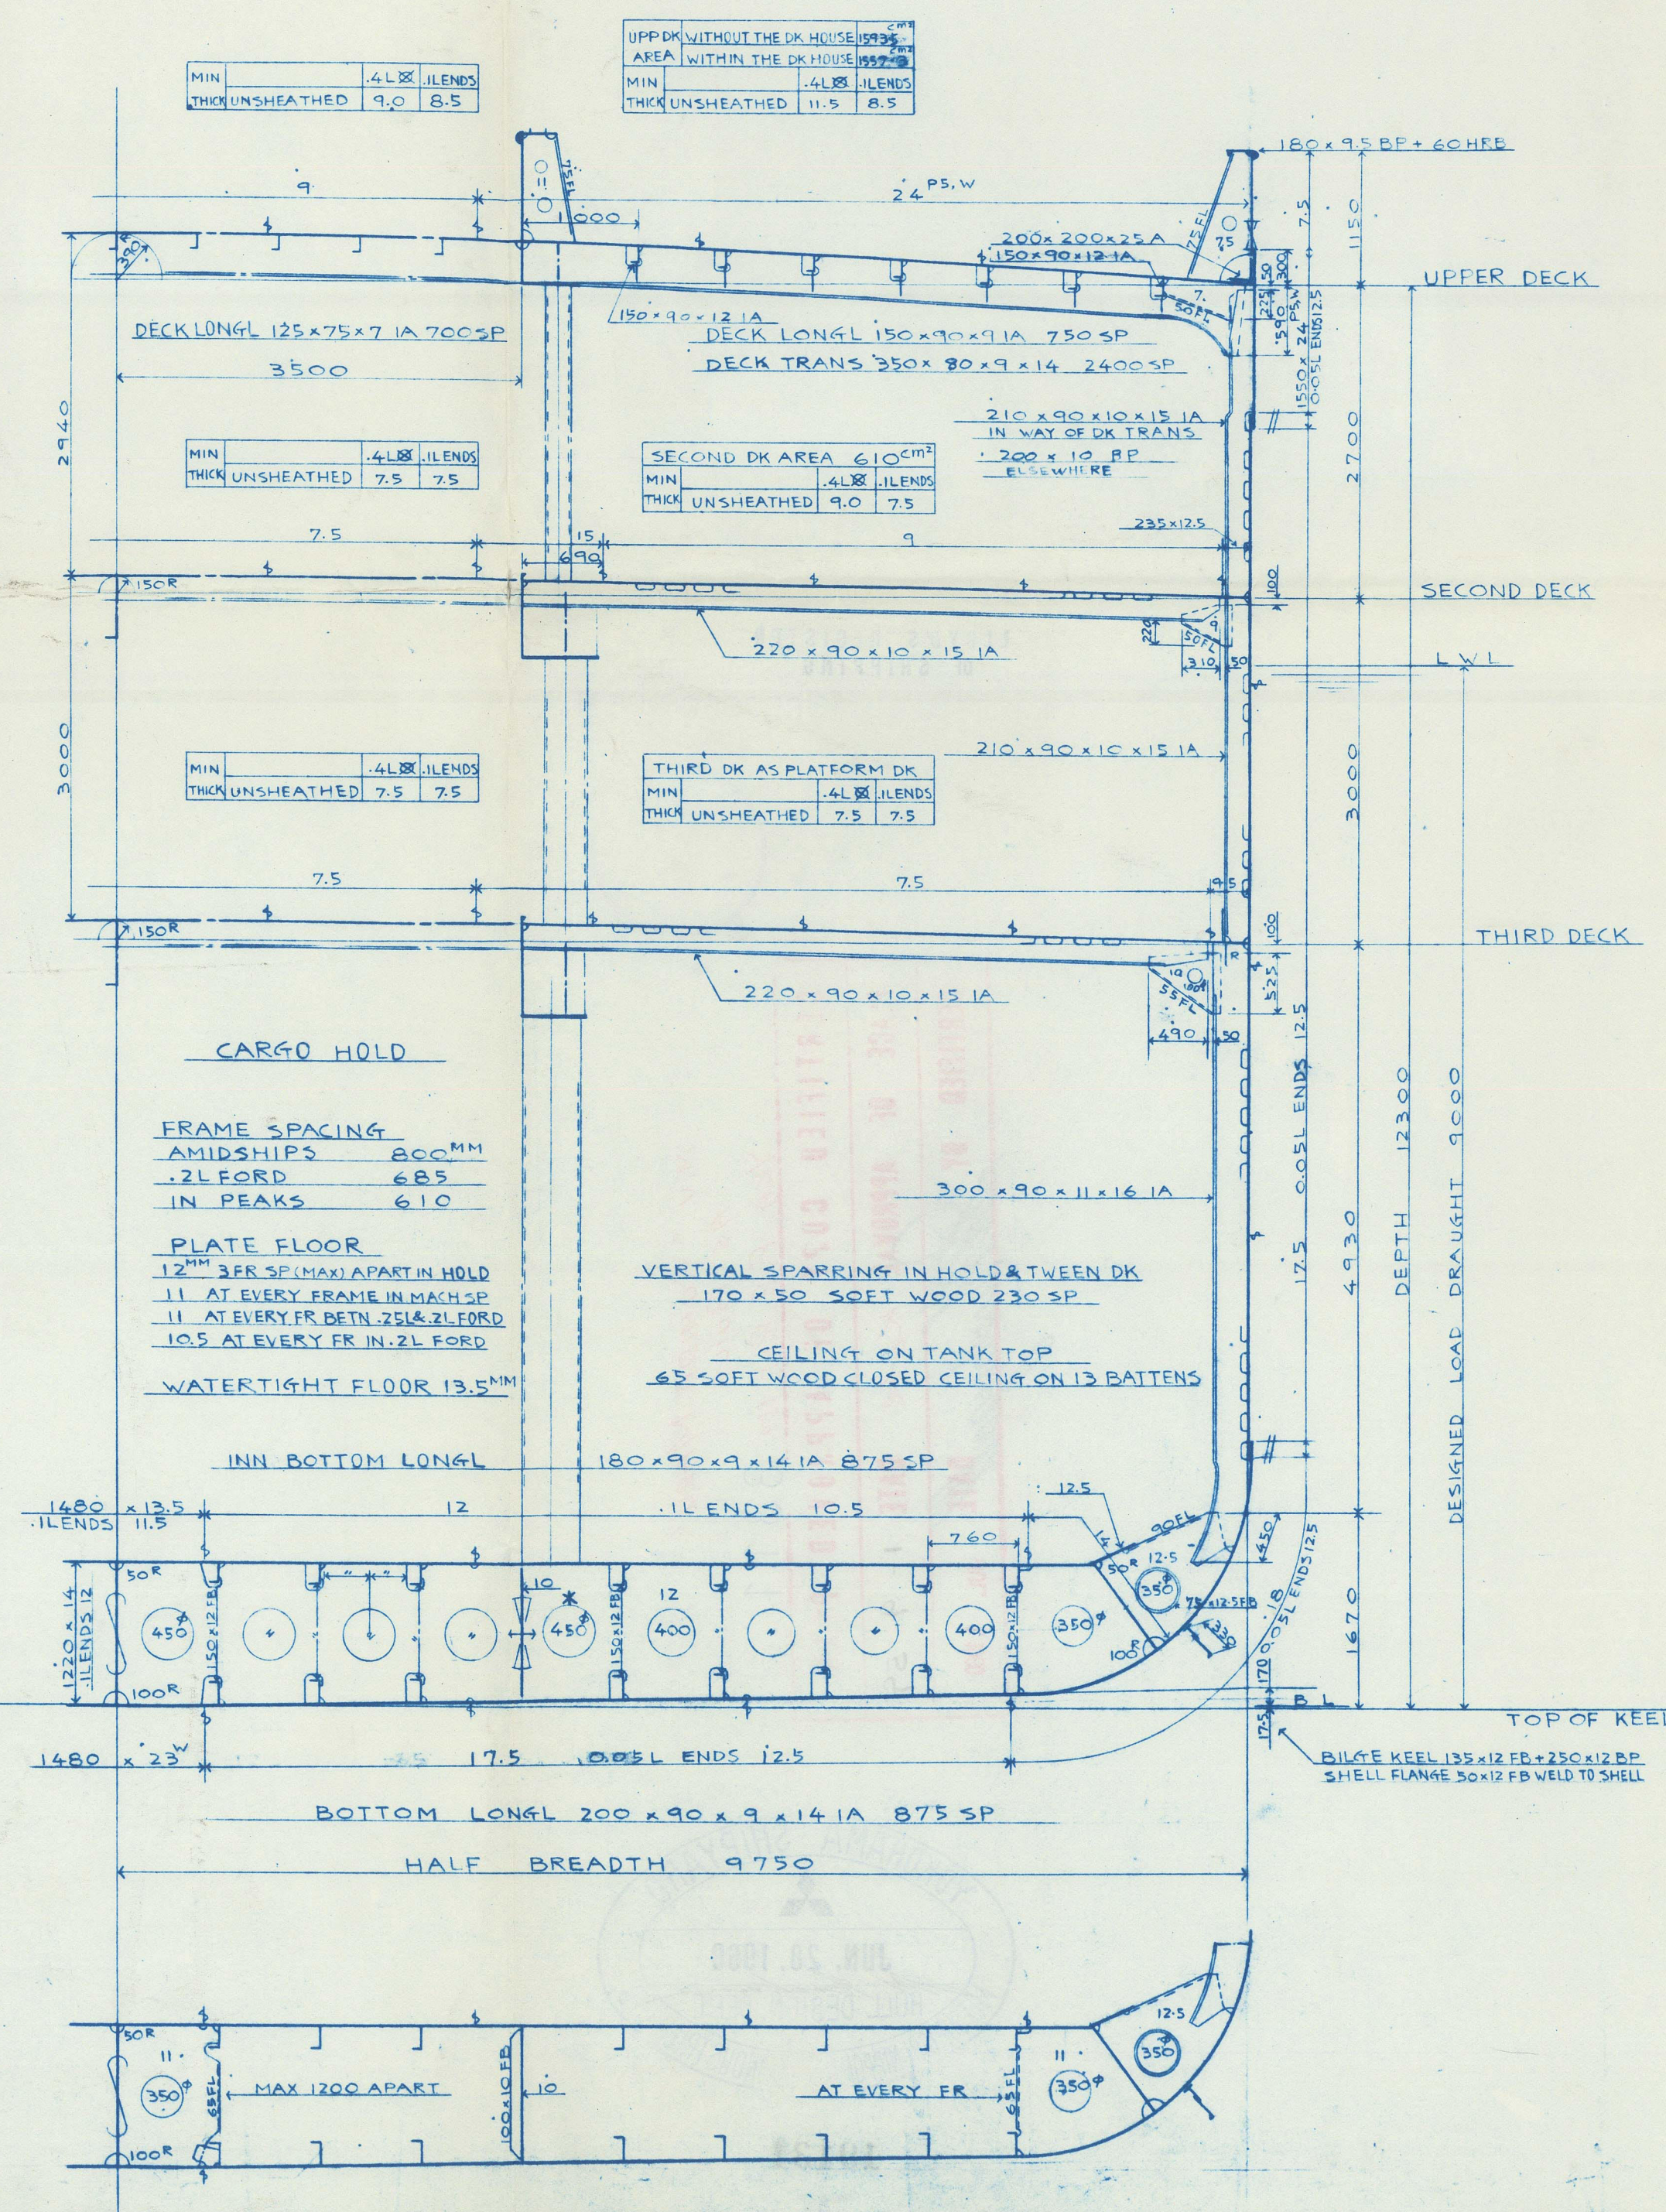

GENERAL NOTES

S 836

S 836

SUMIDA MARU ★

MIDSHIP SECTION

FINISHED PLAN

SCALE 1 : 50

DATE DRAWN JUNE 15 '60

**YOKOHAMA SHIPYARD
& ENGINE WORKS**

MITSUBISHI NIPPON HEAVY-INDUSTRIES, LTD.
HULL DESIGNING DEPARTMENT

APPROVED

[Signature]
[Signature]

CHECKED

[Signature]
[Signature]
[Signature]

DRAWN

TRACED

DATE ISSUED

DRAWING NO H02002F

545 - 733

LLOYD'S REGISTER
OF SHIPPING

RECORDS DEPT.,
LONDON.



CERTIFIED BY	PLACE OF APPROVAL	CERTIFIED COPY OF APPROVED PLAN
<i>[Signature]</i>	Kobe	
DATE	DATE	
JUL 1, 1960	1-9-59	

M.V. "SUMIDA MARU"
AS BUILT
YCA. F.E. Rep. No. 3311



© 2020
19131

Lloyd's Register
Foundation

012193-012202-0254

012193-012202-0254