



SCHWEISSEN

MITTELTRÄGER AN AUSSENHAUT UND INNENBODEN AD 3⁵
 SEITENTRÄGER AN AUSSENHAUT UND INNENBODEN AD 4⁵
 VOLLE WRANGS AN AUSSENHAUT UND INNENBODEN AD 3⁵
 O.D. UND W.D. WRANGEN AN AUSSENHAUT UND INNENBODEN AD 4⁵
 STÜTZBLECHE AD 3⁵
 KANTKLEBE AN AUSSENHAUT AD 3⁵
 KIMMKLEBE AN AUSSENHAUT UND INNENBODEN AD 3⁵
 WRANGEN AN MITTELTRÄGER AD 3⁵
 SPANTEN AN AUSSENHAUT UNTERBROCHEN AD 4⁵
 DECKBALKEN AN DECK UNTERBROCHEN AD 3⁵
 WEBS AN AUSSENHAUT UND DECK UNTERBROCHEN AD 4⁵
 LUKENSÜLLE MIT DECK AD 4⁵
 RELING UND STÜTZEN AD 3⁵ (STÜTZEN MIT DECK AD 4⁵)
 BODENLÄNGSSPANTE MIT BODENBEPLATTUNG UNTERBR AD 4⁵

DETAIL SCHWEISSUNG ZICKZACHE

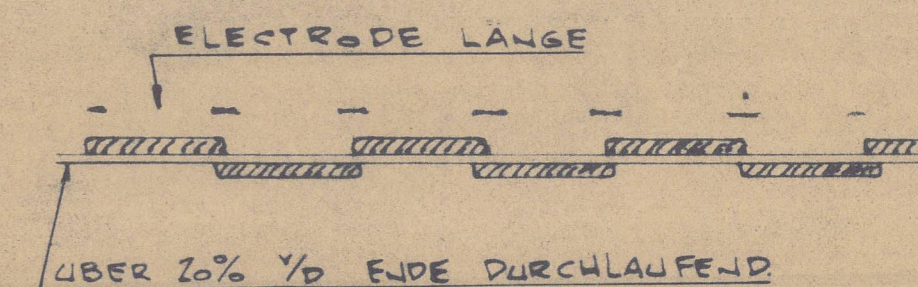

SCHWEISSVERBINDUNG DECK UND LUKENSÜLLE

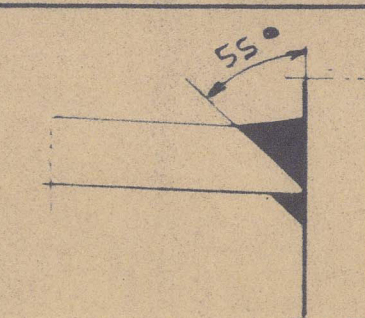

3 BUGANKER GESAMT MASSE 1500 KG. KETTEN STAHL DURCHMESSER 28⁷/₈"
 GESAMT LÄNGE VON 2 STEGKETTEN 350' MIEß ODER HOCHFESTE KETTEN DURCHMESSER 24¹/₂"
 1 STROMANKER 200 KG - LÄNGE DER KETTE ODER TROSSE 100 MIEß
 2 FESTMACHERTROSSEN GESAMTLÄNGE 240 MIEß. MINDESTBRUCHLAST 10.4 MP
 1 VERHOLTROS LÄNGE 90 MIEß. MINDESTBRUCHLAST 6.1 MP
 1 SCHLEPTROS LÄNGE 135 MIEß. MINDESTBRUCHLAST 13.5 MP

Revised copy in
 conformity with
 original approved
 plan signed and
 dated 9th Nov 30-11-34

LÄNGE ÜBER ALLES	48.00 MIEß
LÄNGE ZW. LOTEN	43.00 "
BREITE AUF SPANTEN	9.15 "
HÖHE BIS HAUPTDECK	34.6 "
HÖHE BIS SCHUTZDECK	5.60 "
SOMMERTIEFGANG UKK.	3.35 "

KLASSE: DEUTSCHE SCHIFFS-REVISION UND-KLASSIFICATION.
 GROSZE KÜSTENFAHRT K - UND EIS KLASSE 2.

MVSCHIEPWERF VOORWAARTS	BN 103	MS. SELLIN
" " " VOLHARDING	- 16	MS. STUBNITZ
" " " BULHOLT	- 582	MS. GRANITZ
" " " FIKKERS	- 106	MS. THESSOW
" " " GROL	- 62	MS. GLOWE
" " " TEN BODEWES	- 227	MS. LIETZOW
" " " GEERLOOFS	- 237	MS. SAGARD
" " " GRUNO	- 218	MS. BAABE
" " " HOOGEZAND. H'ZAND	- 123	MS. ALTEFAHR
" " " HOOGEZAND. BERGM.	- 127	MS. PALSWEIK

Deviations from approved plan marked or
 ringed blue on white, yellow on blue.
 Approved by local surveyor or by

GOEDGEKEURD DOOR BOUWOZICHT 31-8-65
 GOEDGEKEURD DOOR D.R.S.K. 20-12-1964.

VEB DEUTSCHE SEEREEDEREI
 ROSTOCK D.D.R.

Conoship BELONGS TO GRONINGEN R.M. 4013
 ONTWERPBUREAU VESSEL'S NAME "ALTEFAHR"

HAUPTSPANT
 1:25
 5.11.64
 F 83/A382-02

PLAN AS BUILT


012519-012304-0075

"ALTEFAHR" ★

MIDSHIP SECTION

(AS. BUILT)

RECORDS DEPT.,
LONDON.

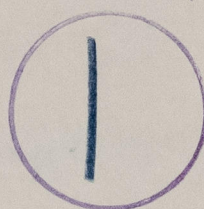

© 2021

Lloyd's Register
Foundation

012699-012704-0095

GRONINGEN: 30-7-66
SHIP: m.s. Altpfäher
VTD: Selma Kobgesand N.V.
HARBOUR: 128
HARBOR NO.: 4023
HARBOR NO. OR: 4013 a
SISTER VESSEL: m.s. Zeller
DEVIATIONS FROM APPROVED PLANS? Blue

012699-012404-0095



© 2021

Lloyd's Register
Foundation