

BALANCED STREAMLINE RUDDER.

S. S. N^o 1029.

SCALE 1" = ONE FOOT.

DETAILS - SCALE AS INDICATED.



RUDDER POST & STOCK - BEST QUALITY FORGED STEEL

RUDDER NOSE PIECE - BEST QUALITY STEEL CASTING.

DIMENSIONS - 44'-11" B.P. x 58'-0" EAT. x 33'-0" ABD. TO UPPER DECK.

TO CLASS 100 A1 AT LLOYDS. LOAD DRAFT 26'-6". SPEED 14 KNOTS.

IMMERSED AREA OF RUDDER AFT OF STOCK OR = 129.2 SQ FT. C.B. = 320 FT. A.D = 438.

IMMERSED AREA OF RUDDER FOR OF STOCK OR = 368.56 SQ FT. C.B. = 1038 FT. A.D = 38.

MODIFIED A.D = (438 - 38) = 395. = 104 RAIL ONE STOCK - FITTED 10" DIA (DISHED).

KEYWAYS ETC CUT IN RUDDER STOCK, BY RUDER MAKERS, THE PARTICULARS GIVEN.

RUDER POST - STOCK TO BE ACCURATELY MACHINED TO DIMENSIONS GIVEN.

RIVET HOLES TO BE BORED & TAPPED INTO RUDER POST, BY RUDER MAKERS.

RUDER NOT TO EXCEED GIVEN SCANTLINGS, EXCESS OVER EAT. WEIGHT WILL NOT BE PAID FOR.

PATTERN OF NOSE PIECE + FINISHED RUDER POST TO BE APPROVED BY SHIPBUILDERS DESIGNER.

FORG 400 X CASTINGS TESTED AS PER RULE.

No 2.

NOTE - KEYWAYS TO BE OF ~~10"~~ SIZE BORED.
DEPTH OF KEYWAYS MEASURED
AT CENTRE LINE OF RUDER STOCK.

KEYWAY U TAPER.

HOLE FOR 2 DA EYE
BORED - TAPPED IN RUDER STOCK.

RAISED SURFACE ON
STOCK 10" FROM A.D. BORDER

DETAIL OF KEYWAYS.
BOSUNG PLATE 3-6-3-6-1 INCH.
LEFT EDGE CUT IN RUDER SHAPED.


BOSK PLATES 40 THICK.
SECOND DECK 10"

BASS OF RUDER CARRIER
MACHINED TO SHAPE OF DOCK.

HOLE FOR 2 DA EYE
BORED - TAPPED IN RUDER STOCK.

RAISED SURFACE ON
STOCK 10" FROM A.D. BORDER

DETAIL OF RUDER POST.
RUDER POST 10" DIAMETER.
RAISED SURFACE ON
STOCK 10" FROM A.D. BORDER

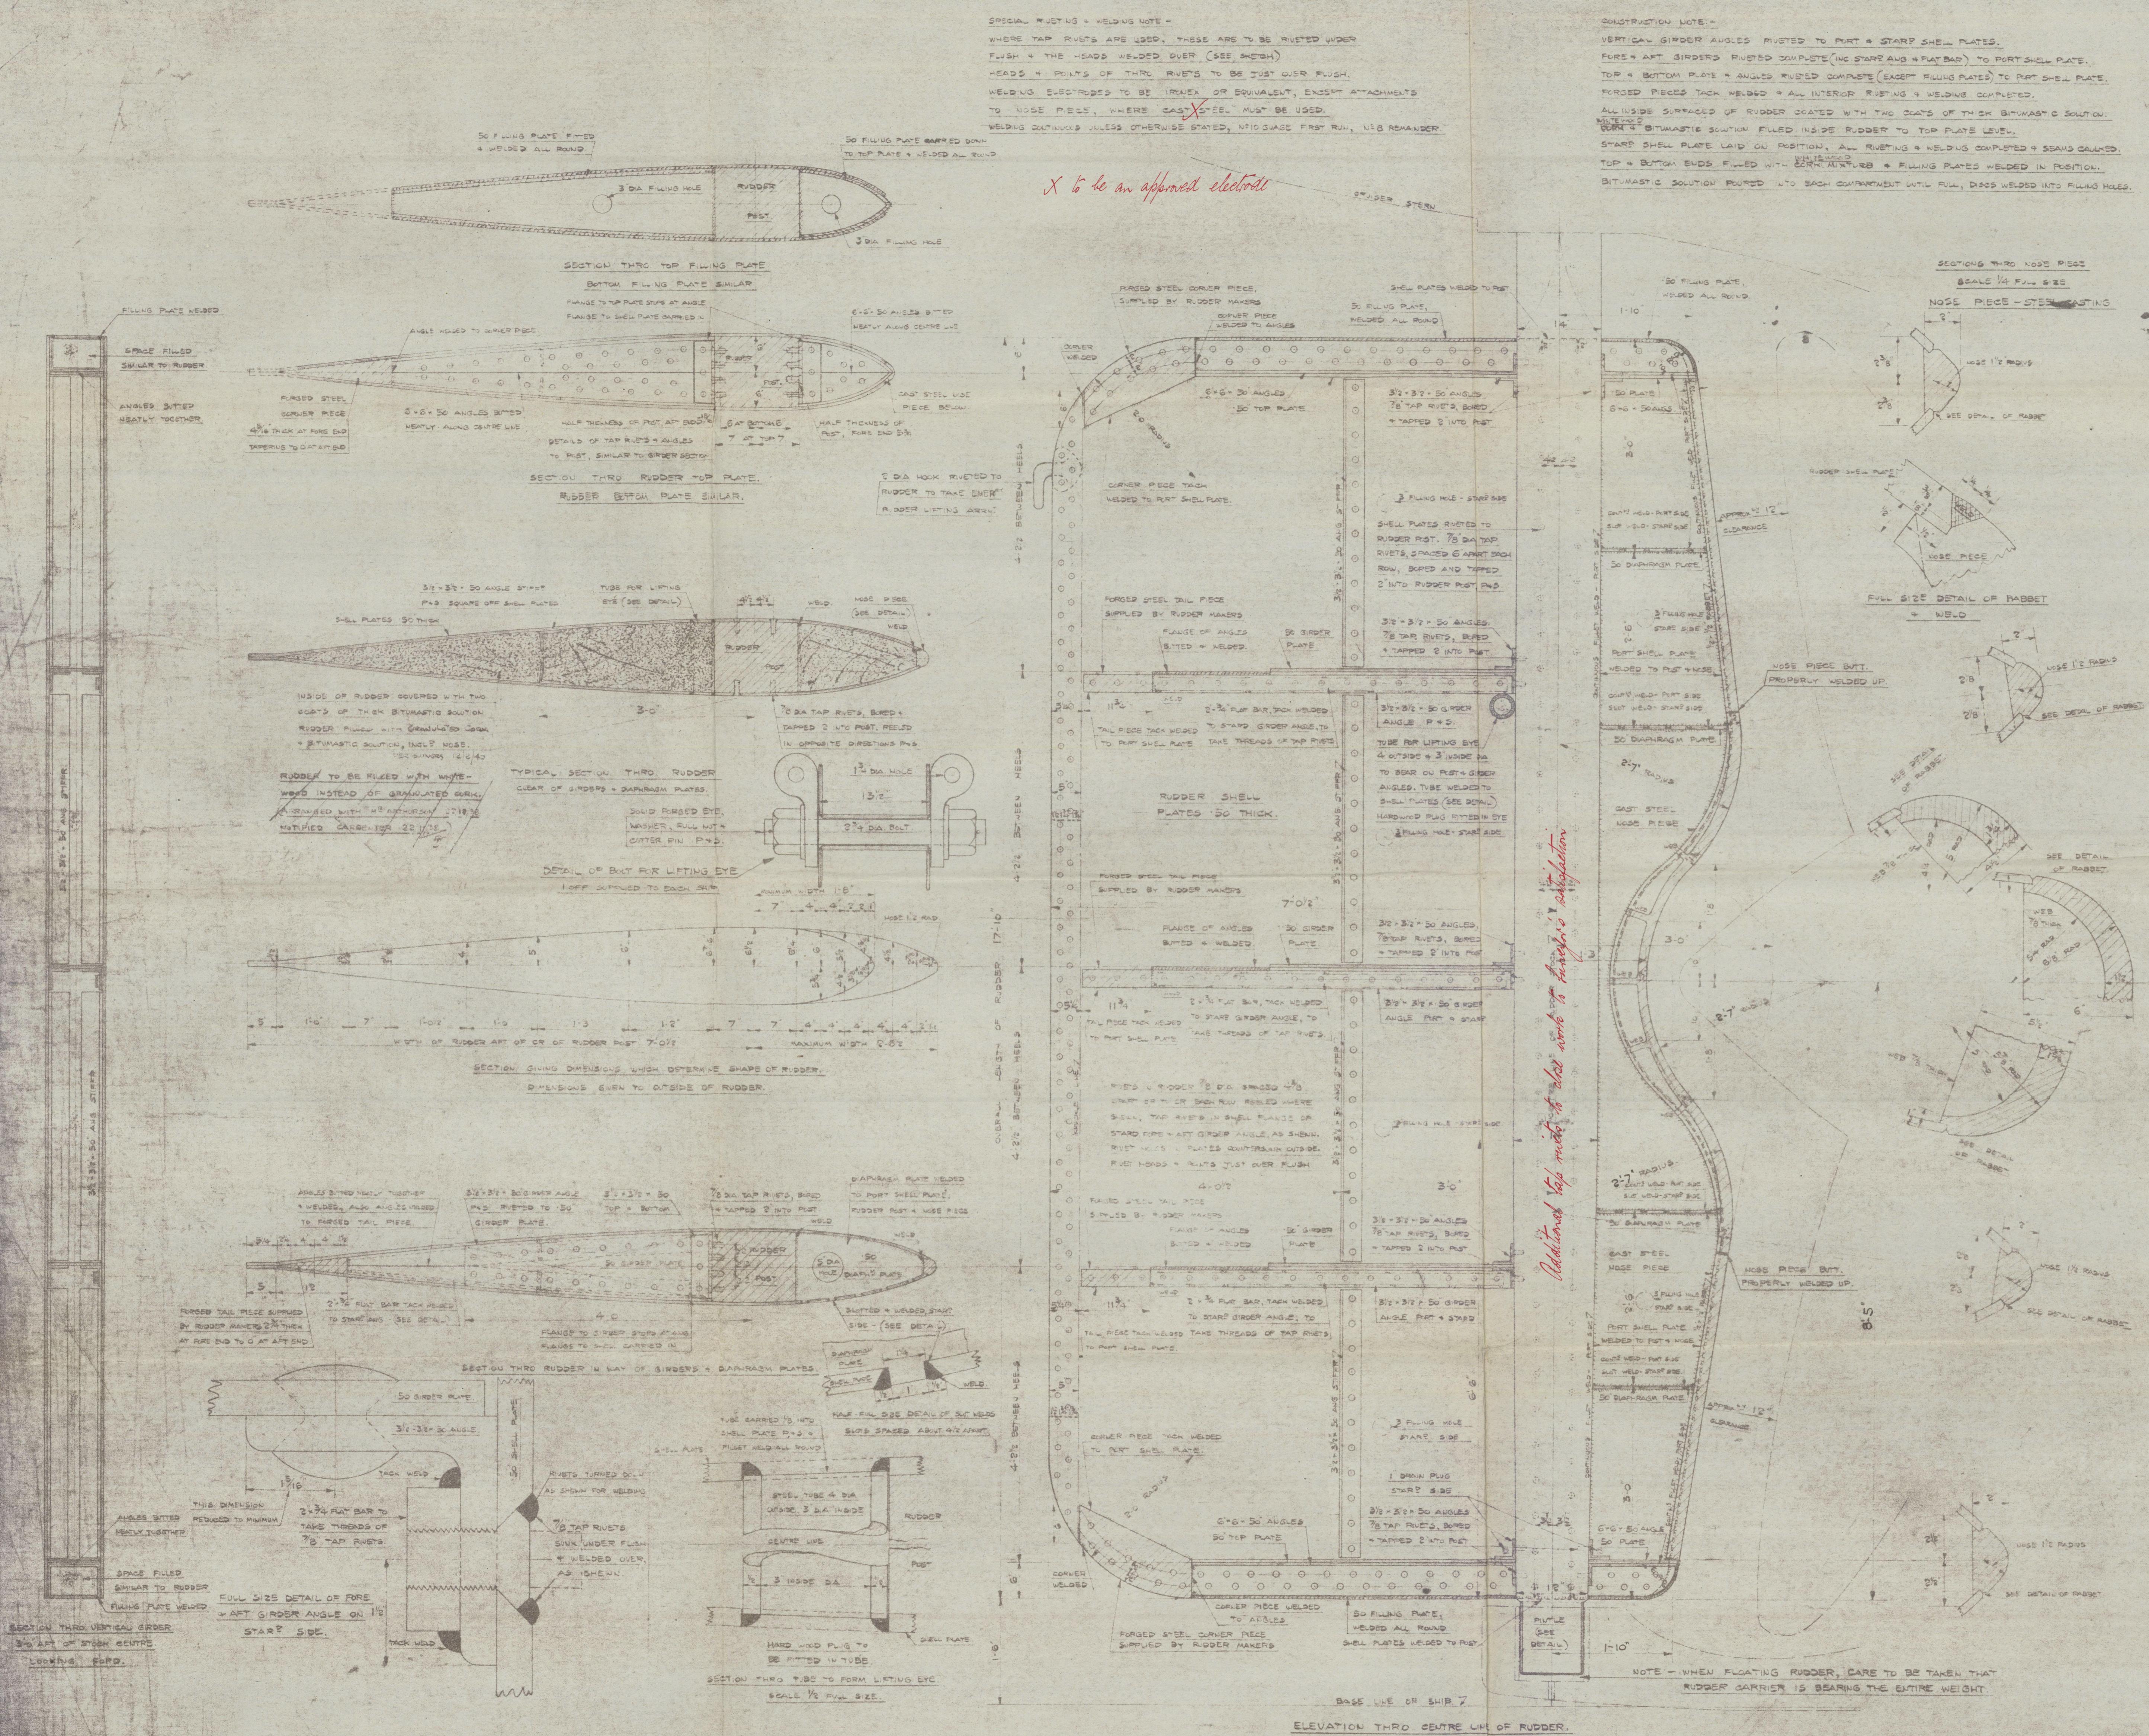

APPROVED

LLOYD'S REGISTER OF SHIPPING

James R Clark

1819/161

012875-012887-0171

lloyd's Register Foundation

~~47~~ ~~15~~
LITHGOWS 1029

RUDDER

"BIOGRAPHER" *

GREENOCK FIRST ENTRY REPORT NO. 23942.

RECORDS DEPT.
LONDON



© 2021
Lloyd's Register
012875-012887-0171
Foundation