

M.V. "EMPIRE GAT."
MIDSHIP SECTION.



DIMENSIONS:- 198'-6" B.P. \times 33'-0" MLD \times 13'-10" MLD.

<u>EQUIPMENT</u>	
2	BOWER ANCHORS- 2 1/4 CWTs EACH STOCKLESS.
1	STREAM ANCHOR- 5 3/4 CWTs EX. STOCK
180	FATHOMS 1 3/8" STUD CHAIN CABLE
60	3/4" STEEL WIRE (6x12 FLEXIBLE)
90	6" WARDER OR 3 3/4" STEEL WIRE
90	5" WARD OR 1 3/4" " "
30	2" STEEL WIRE (6x12 FLEXIBLE)

SECTION IN WAY OF UPPER DECK

HATCH	CORNING	SIDES	44"
"	"	ENDS	44"
"	"	2-6" ABOVE DECK	

HATCH COAMING SIDES		44"	
ENDS		44"	
3'-6" ABOVE DECK AT FORE END			
5'-3"		AFTER	

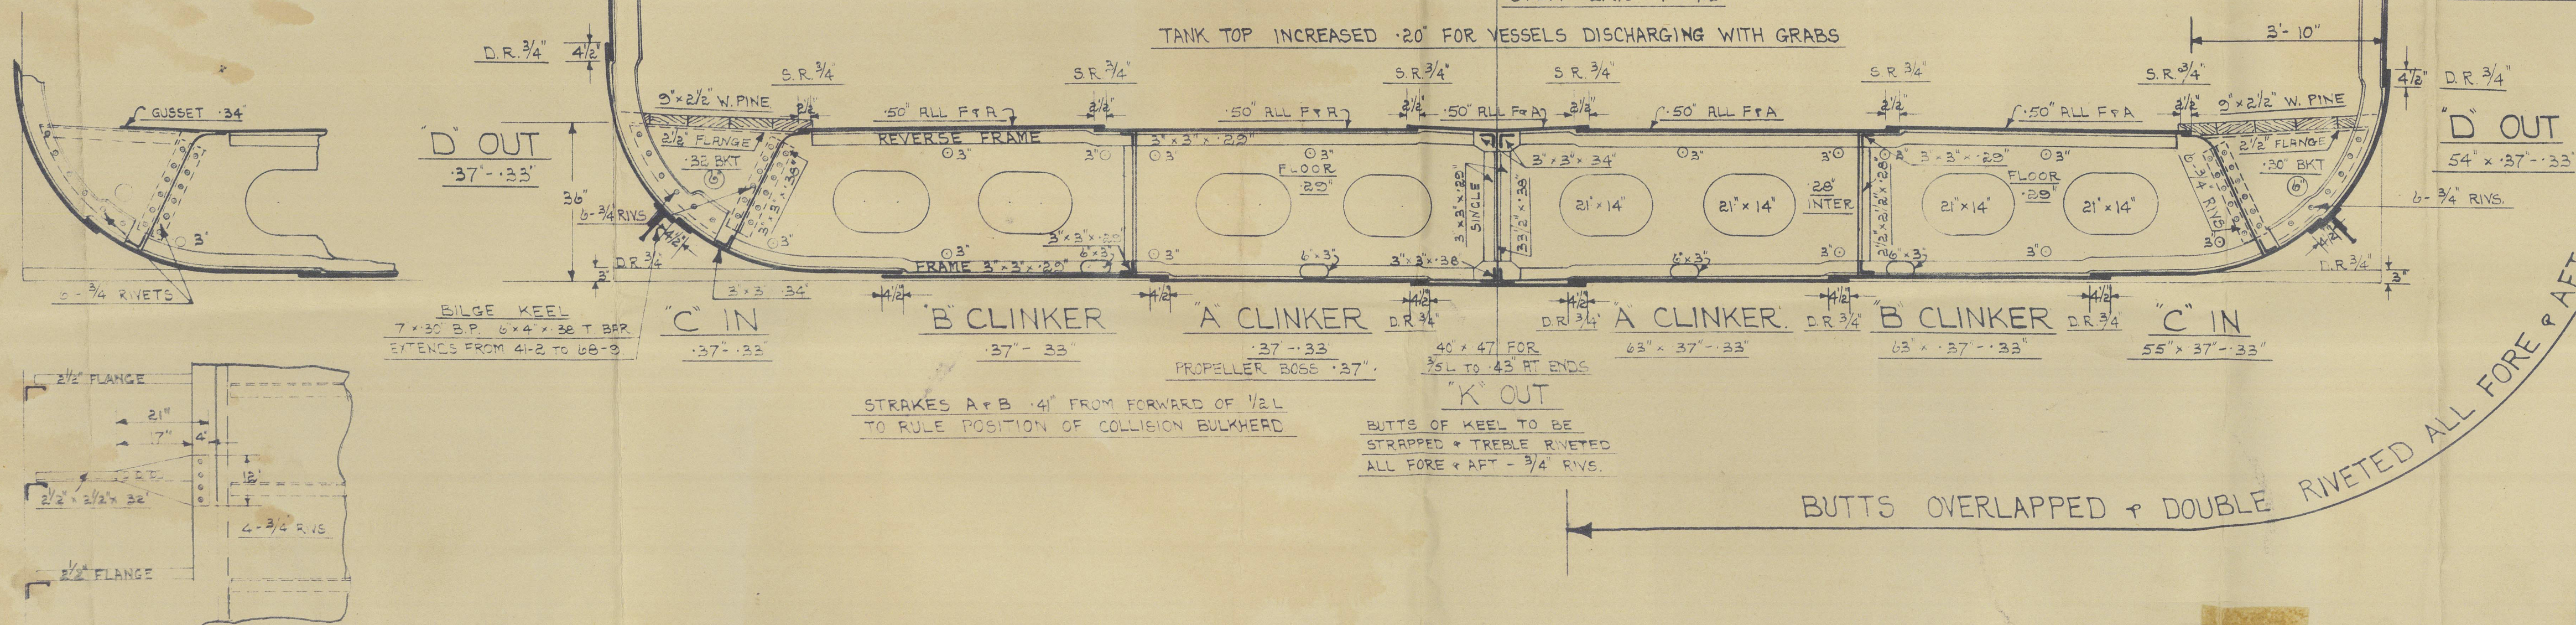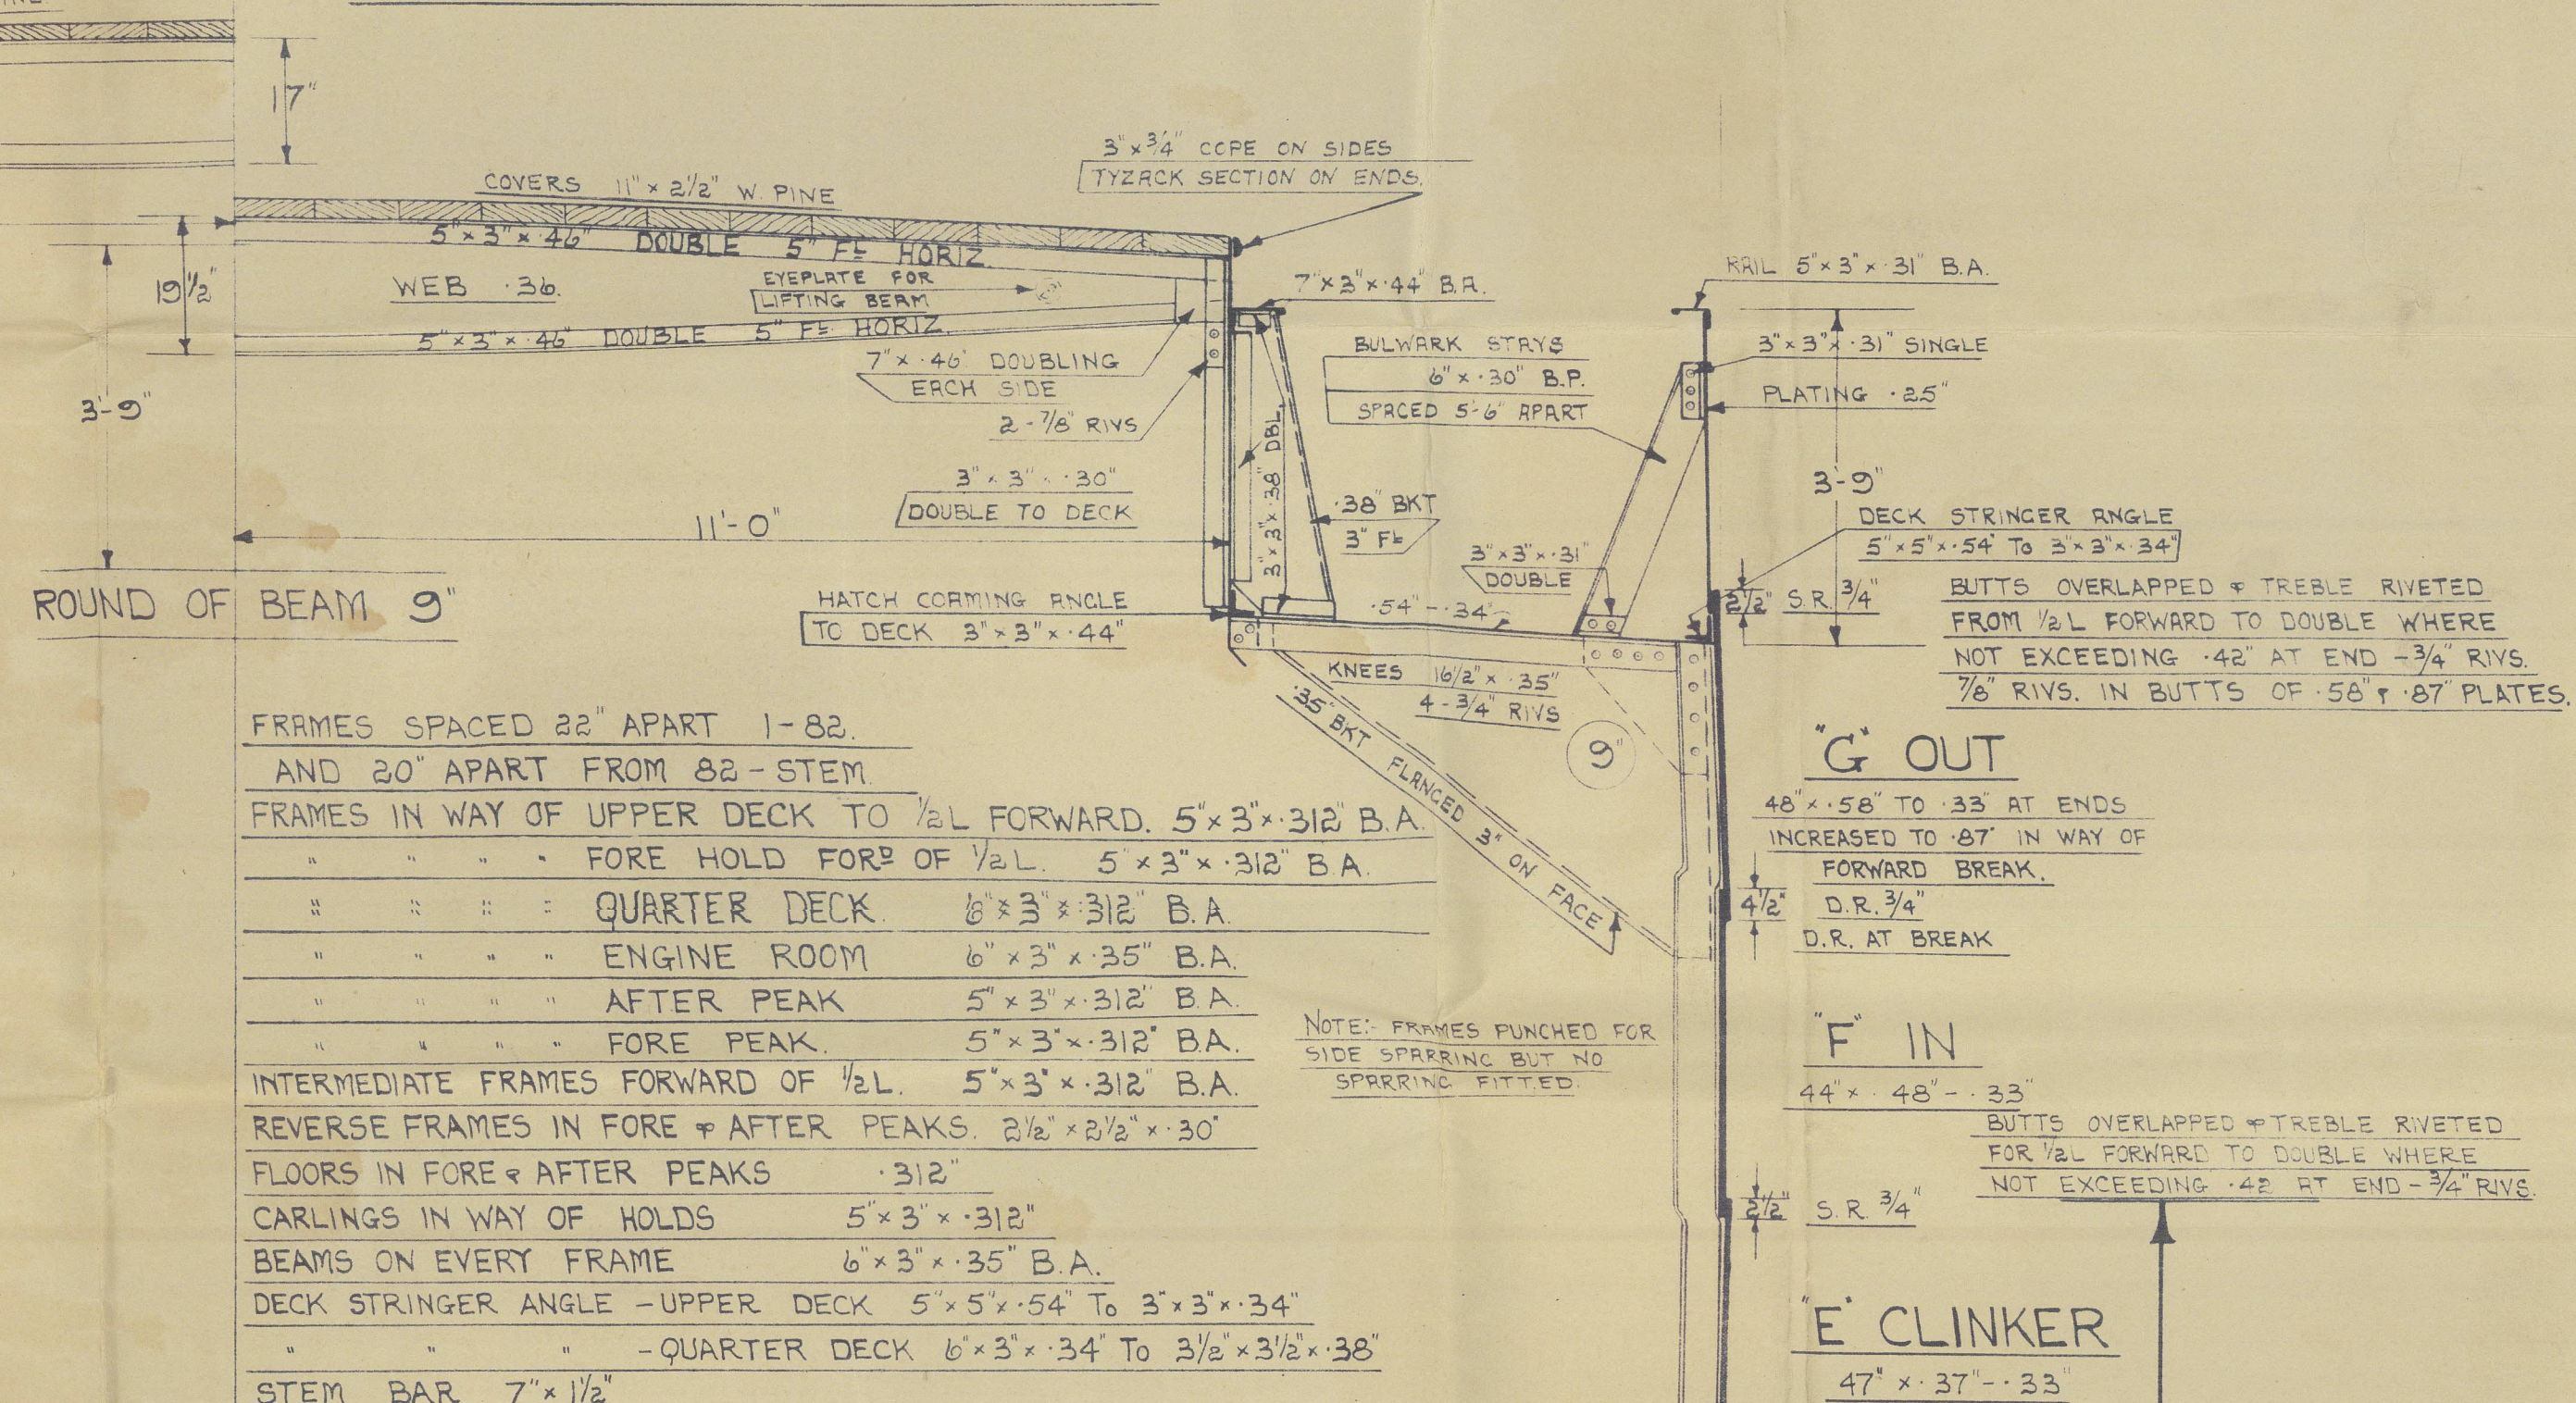

GUSSET PLATES ON ALTERNATE FRAMES

A + J. INGLIS L^d

N^o 1088P.

"EMPIRE GAT"

Lidskip Section
(as built).

GLASGOW REPORT No. 63686

M_n BORTHWICK

M_n ACOSTINO



© 2021

Lloyd's Register
Foundation

013033-013041-0203