


YARD No 631. MIDSHIP SECTION

EQUIPMENT

NUMBER UNDER UPPERDECK	41065
HOUSES	478
FORECASTLE AND POOP	420
EQUIPMENT NUMERAL	<u>41963.</u>

RIVETING.

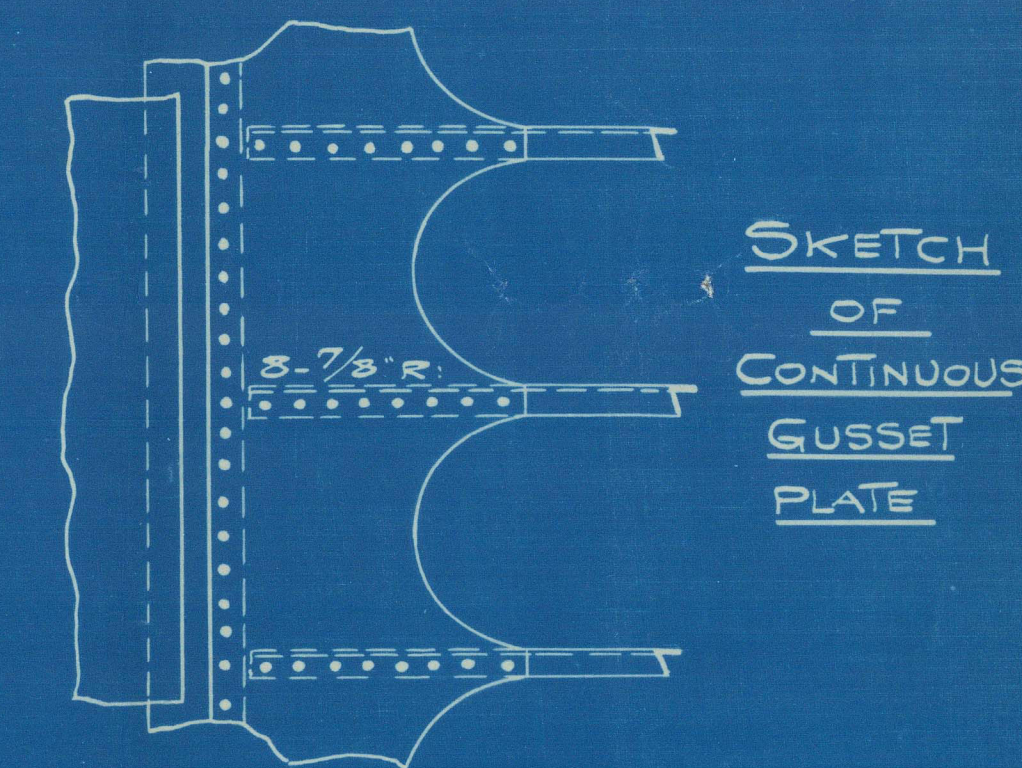

	FORE CASILE	POOP
HEIGHT ABOVE UPPERDECK	7' 6"	7' 6"
ROWS OF PILLARS	1	1
BEAM SPACING	ON EYE FOR	ON EYE FOR
BEAMS	SEE	PROFILES
STRINGER PLATE	35" x 36"	37" x 36"
DECK PLATING (JOGGED)	30"	30"
SHELL PLATING	42"	44"
STRINGER ANGLE	55° 31' x 36"	55° 31' x 36"

	UPPERDECK	SECONDECK
PILLARS	ONE ROW	ONE ROW
BEAM BRACING	ON EVERY FRAME	ON EVERY FRAME
BEAM KEYS	SEE PROFILE	SEE PROFILE
BEAM KNEES	SEE PROFILE	SEE PROFILE
HATCH END BEAMS	SEE PROFILE	SEE PROFILE
— — — — — PLATE	3. DEPTH OF BEAM THICK: 48	3. DEPTH OF BEAM THICK: 48
STEEL SHEET	72" x 96" FOR 2' L TO 40" x 44" AT ENDS	81" x 41" FOR 2' L TO 86" x 86" AT ENDS
— — — — — ANGLE	2" x 2" x 1/4" FOR 2' L TO 3" x 3" AT ENDS	3" x 3" x 1/4" FOR 2' L TO 3" x 3" AT ENDS
DECK PLATE	58" WIDE LINE OF HATCHES 41" TO 36	38" — WITH LINE OF HATCHES 34" TO 32 1/2"
ANGLE RODS/PIERS		3" x 3" x 1/4" TO 1/2" x 3/4"

DOUBLE BOTTOM PLATES					REMARKS
	3/4	4/4	5/4	6/4	
CENTRE GIRDER	44	38	32	26	FLOOR SPACING MAXIMUM
WIDE GIRDERS	38	32	26	20	AND FORWARD OF 1/2
FLOORS	49	43	37	31	FORWARD
TANKTOP CENTRE ST	54	52	44	36	ON EVERY THIRD FRAME
- - - REM STKS	45	40	34	28	ELSEWHERE
MARGIN PLATE	41	35	29	23	
TANKSIDE BRACKET	47	42	36	30	
WATERLIGHT FLOORS SO STIFFENED					5/2 : 3 : 28 & 3 Space
CONTINUOUS GUSSET PLATE 4/3					FOR THE WHOLE LENGTH
OF VESSEL WITH 8 - 3/8" FLUETS EACH ARM					

X .42 AT 27° 57'


SKETCH OF BRACKET FLOORS

AKTIEBELSKABET
BURMEISTER & WAI
MASKIN- & SKIENBYGG
631
BYGGING NR. 14384.
TEGNING NR.
TEGNET AF
KALIBRERT AF
EKSPERIMENT AF
DATO 16-6-37
1/2 • 1 • 0
SKALA
MIDSHIP SEKTOR

Drawn ^{a/s} Børniste & Wain's
yard No. 631.

Midship Section
as built.

m.s. "Jægh Silverstør" of Oslo.
Exp. Rpt. No. 10438.

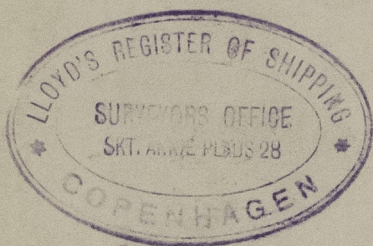

© 2021

Lloyd's Register
Foundation

013436-013443-0239