


S.S. "CRAFTSMAN"

PROFILE AND DECKS.

Scale 1/8" = ONE FOOT.
 DIMENSIONS: 441'-9" EN L.W.L. x 58'-0" BT x 57'-0" MLD x 32'-2" MLD TO UPPER DECK.
 TO CLASS 100-A1 AT LLOYD'S SPECIAL SURVEY.

WATER FORWARD	100'
WATER 1/2 LEN FORWARD	50'
WATER AFT	50'
WATER 1/2 LEN AFT	50'
WATER AT STERN	100'
TUNNELS AT BRIDGE DECK	15'
TUNNELS AT UPPER DECK	5'

PLAN OF CARGO HATCHES, DECK DECKED AND QUARTER PLANKED.
 NOT BULKHEADS, SHUT TUNNEL AND BOTTOM STRENGTHENING FORWARD.
 WITH 50 SUBMITTER LINES.

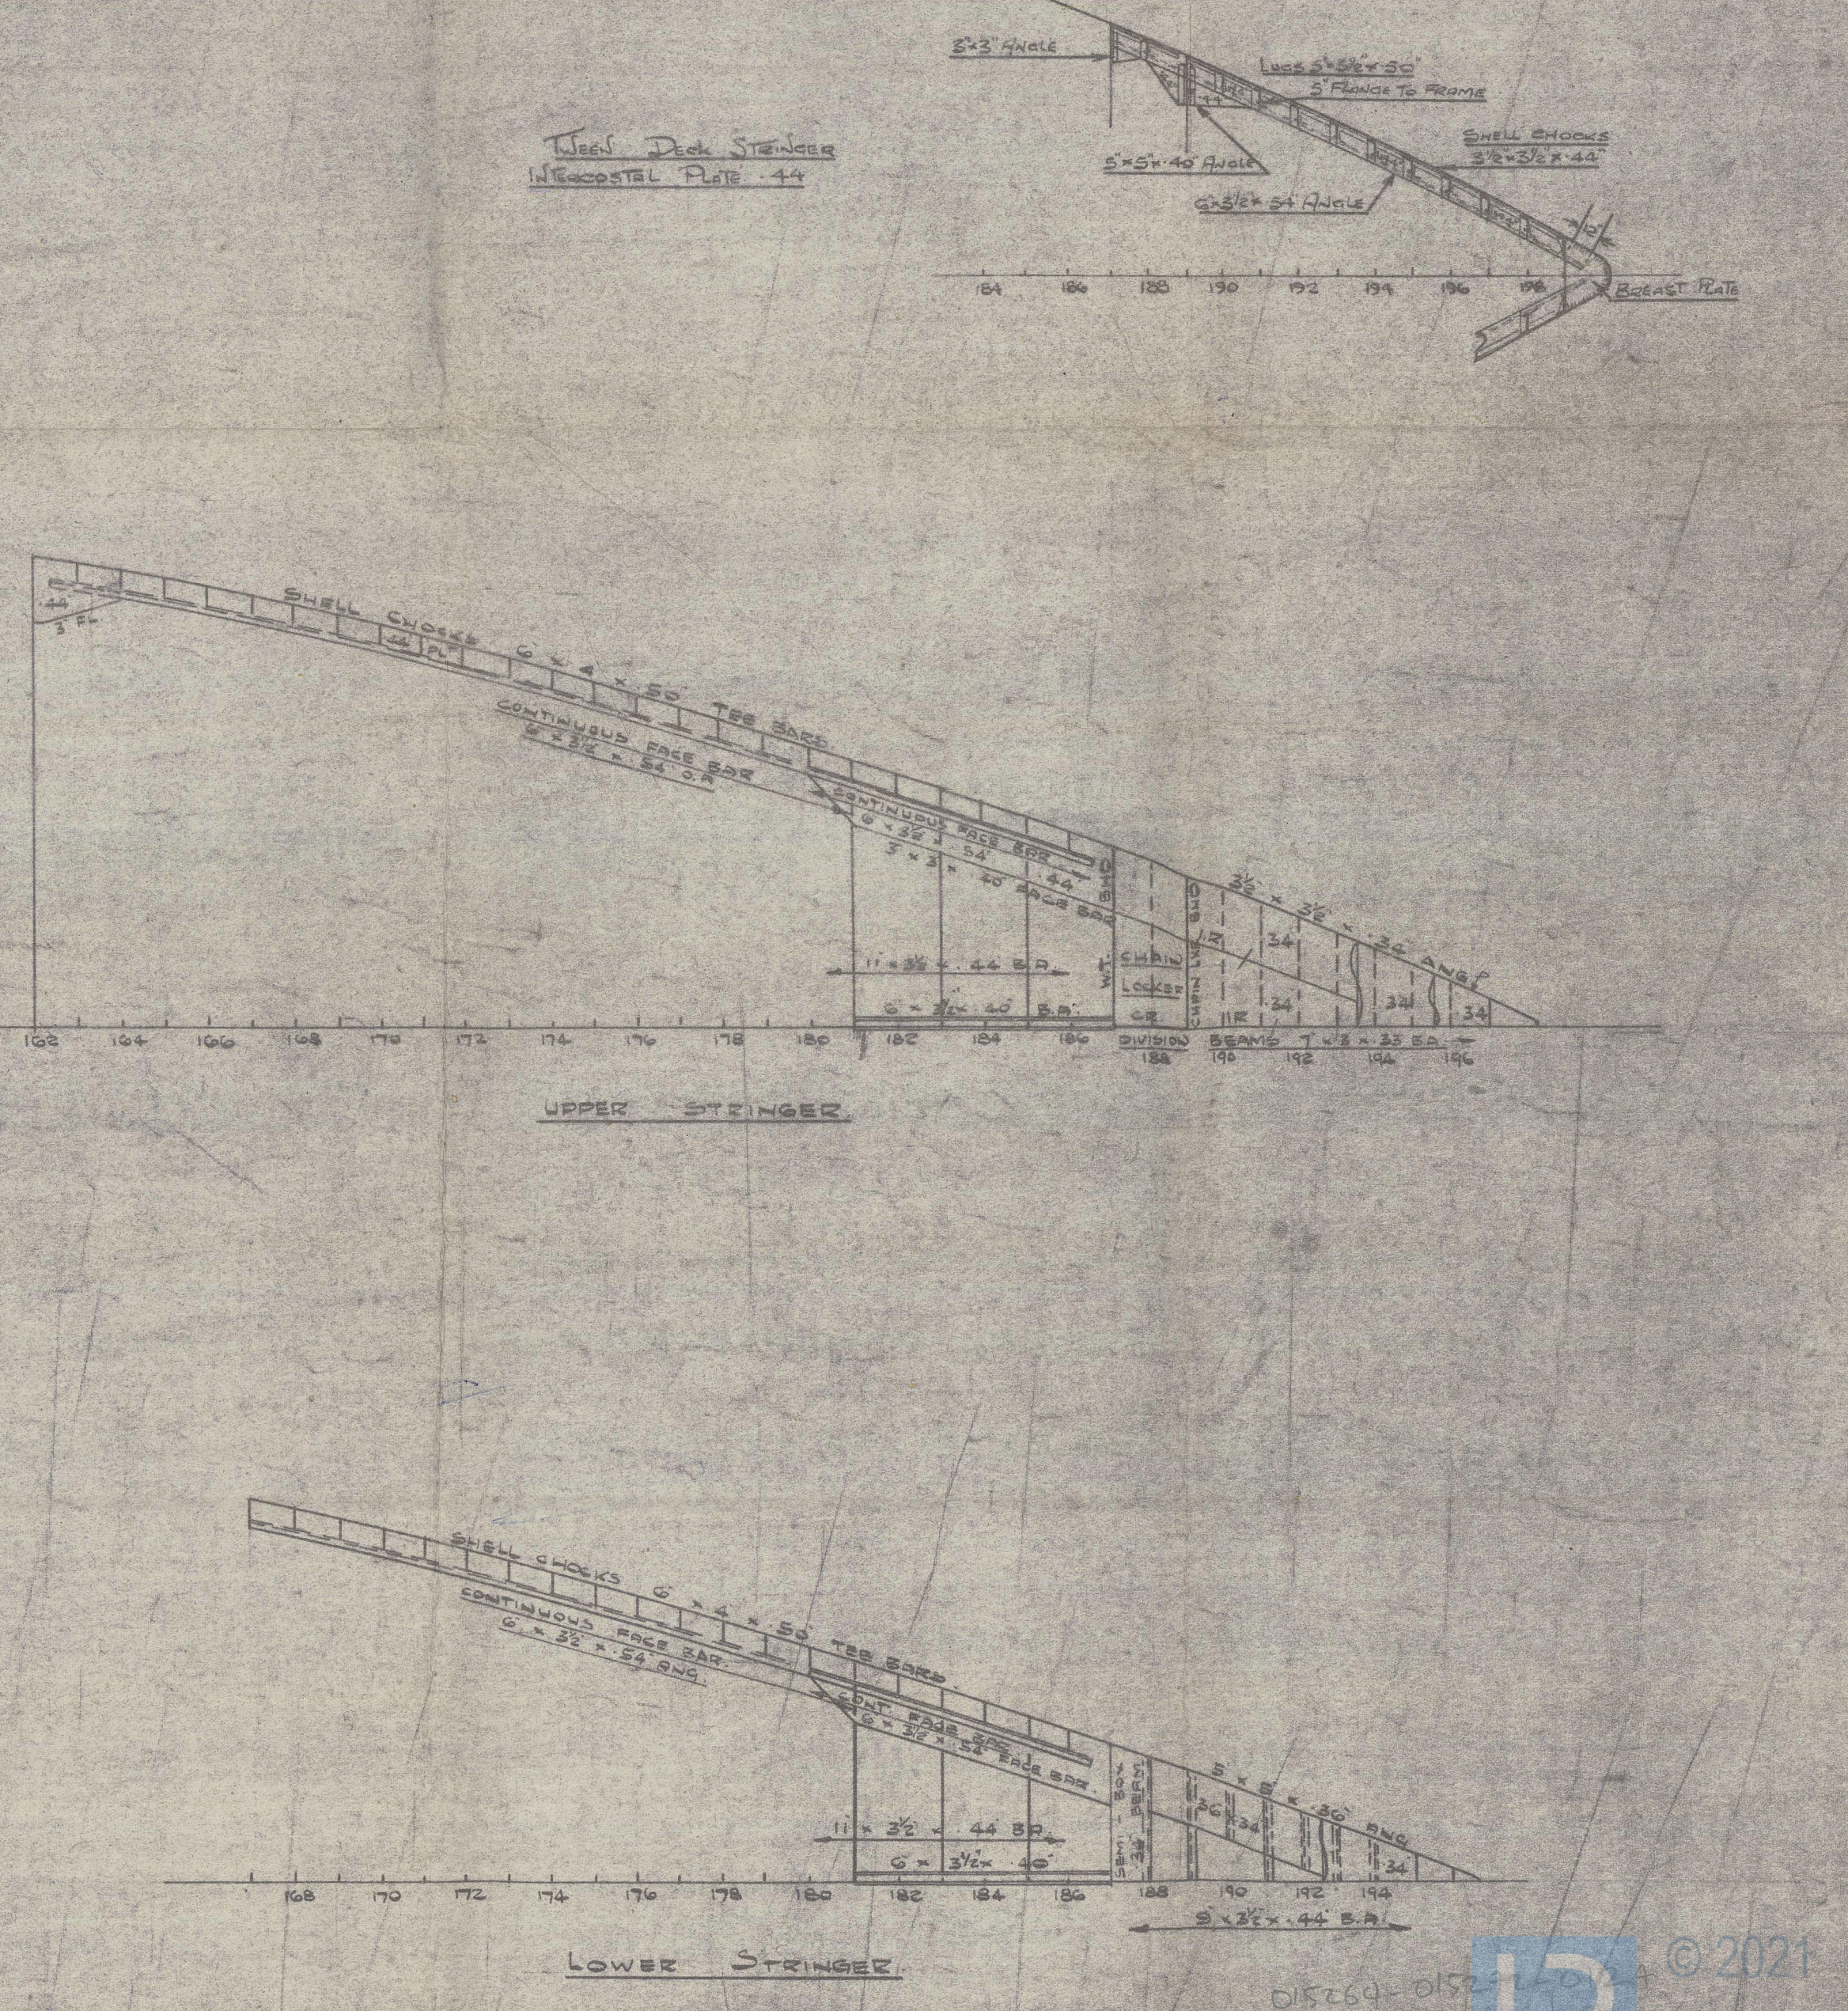

S. S. CRAFTSMAN



LITHGOWS LTD No 1020

PROFILE & DECKS

As BUILT

2



© 2021

Lloyd's Register
Foundation

015264-015272-0124