

PLAN NO 339


NO 582 G.

MIDSHIP SECTION.

405' x 54' x 27' K. TO B.

PROPORTIONS


DEPTHS TO LENGTH (BRIDGE) 9.37
 " " (SHELTER) 11.49
 BEAMS TO LENGTH 7.50

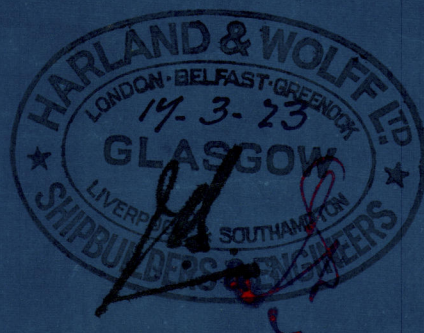SCALE $\frac{1}{2}$ " = 1 FOOT.

TO CLASS 100 A1 AT LLOYDS.

NUMERALS

B+D = 54+35.25-8+21 = 81.46
 L(B+D) 81.46 x 4.05 = 32991
 EQUIPMENT 32991 + 3880 + 440 = 37311

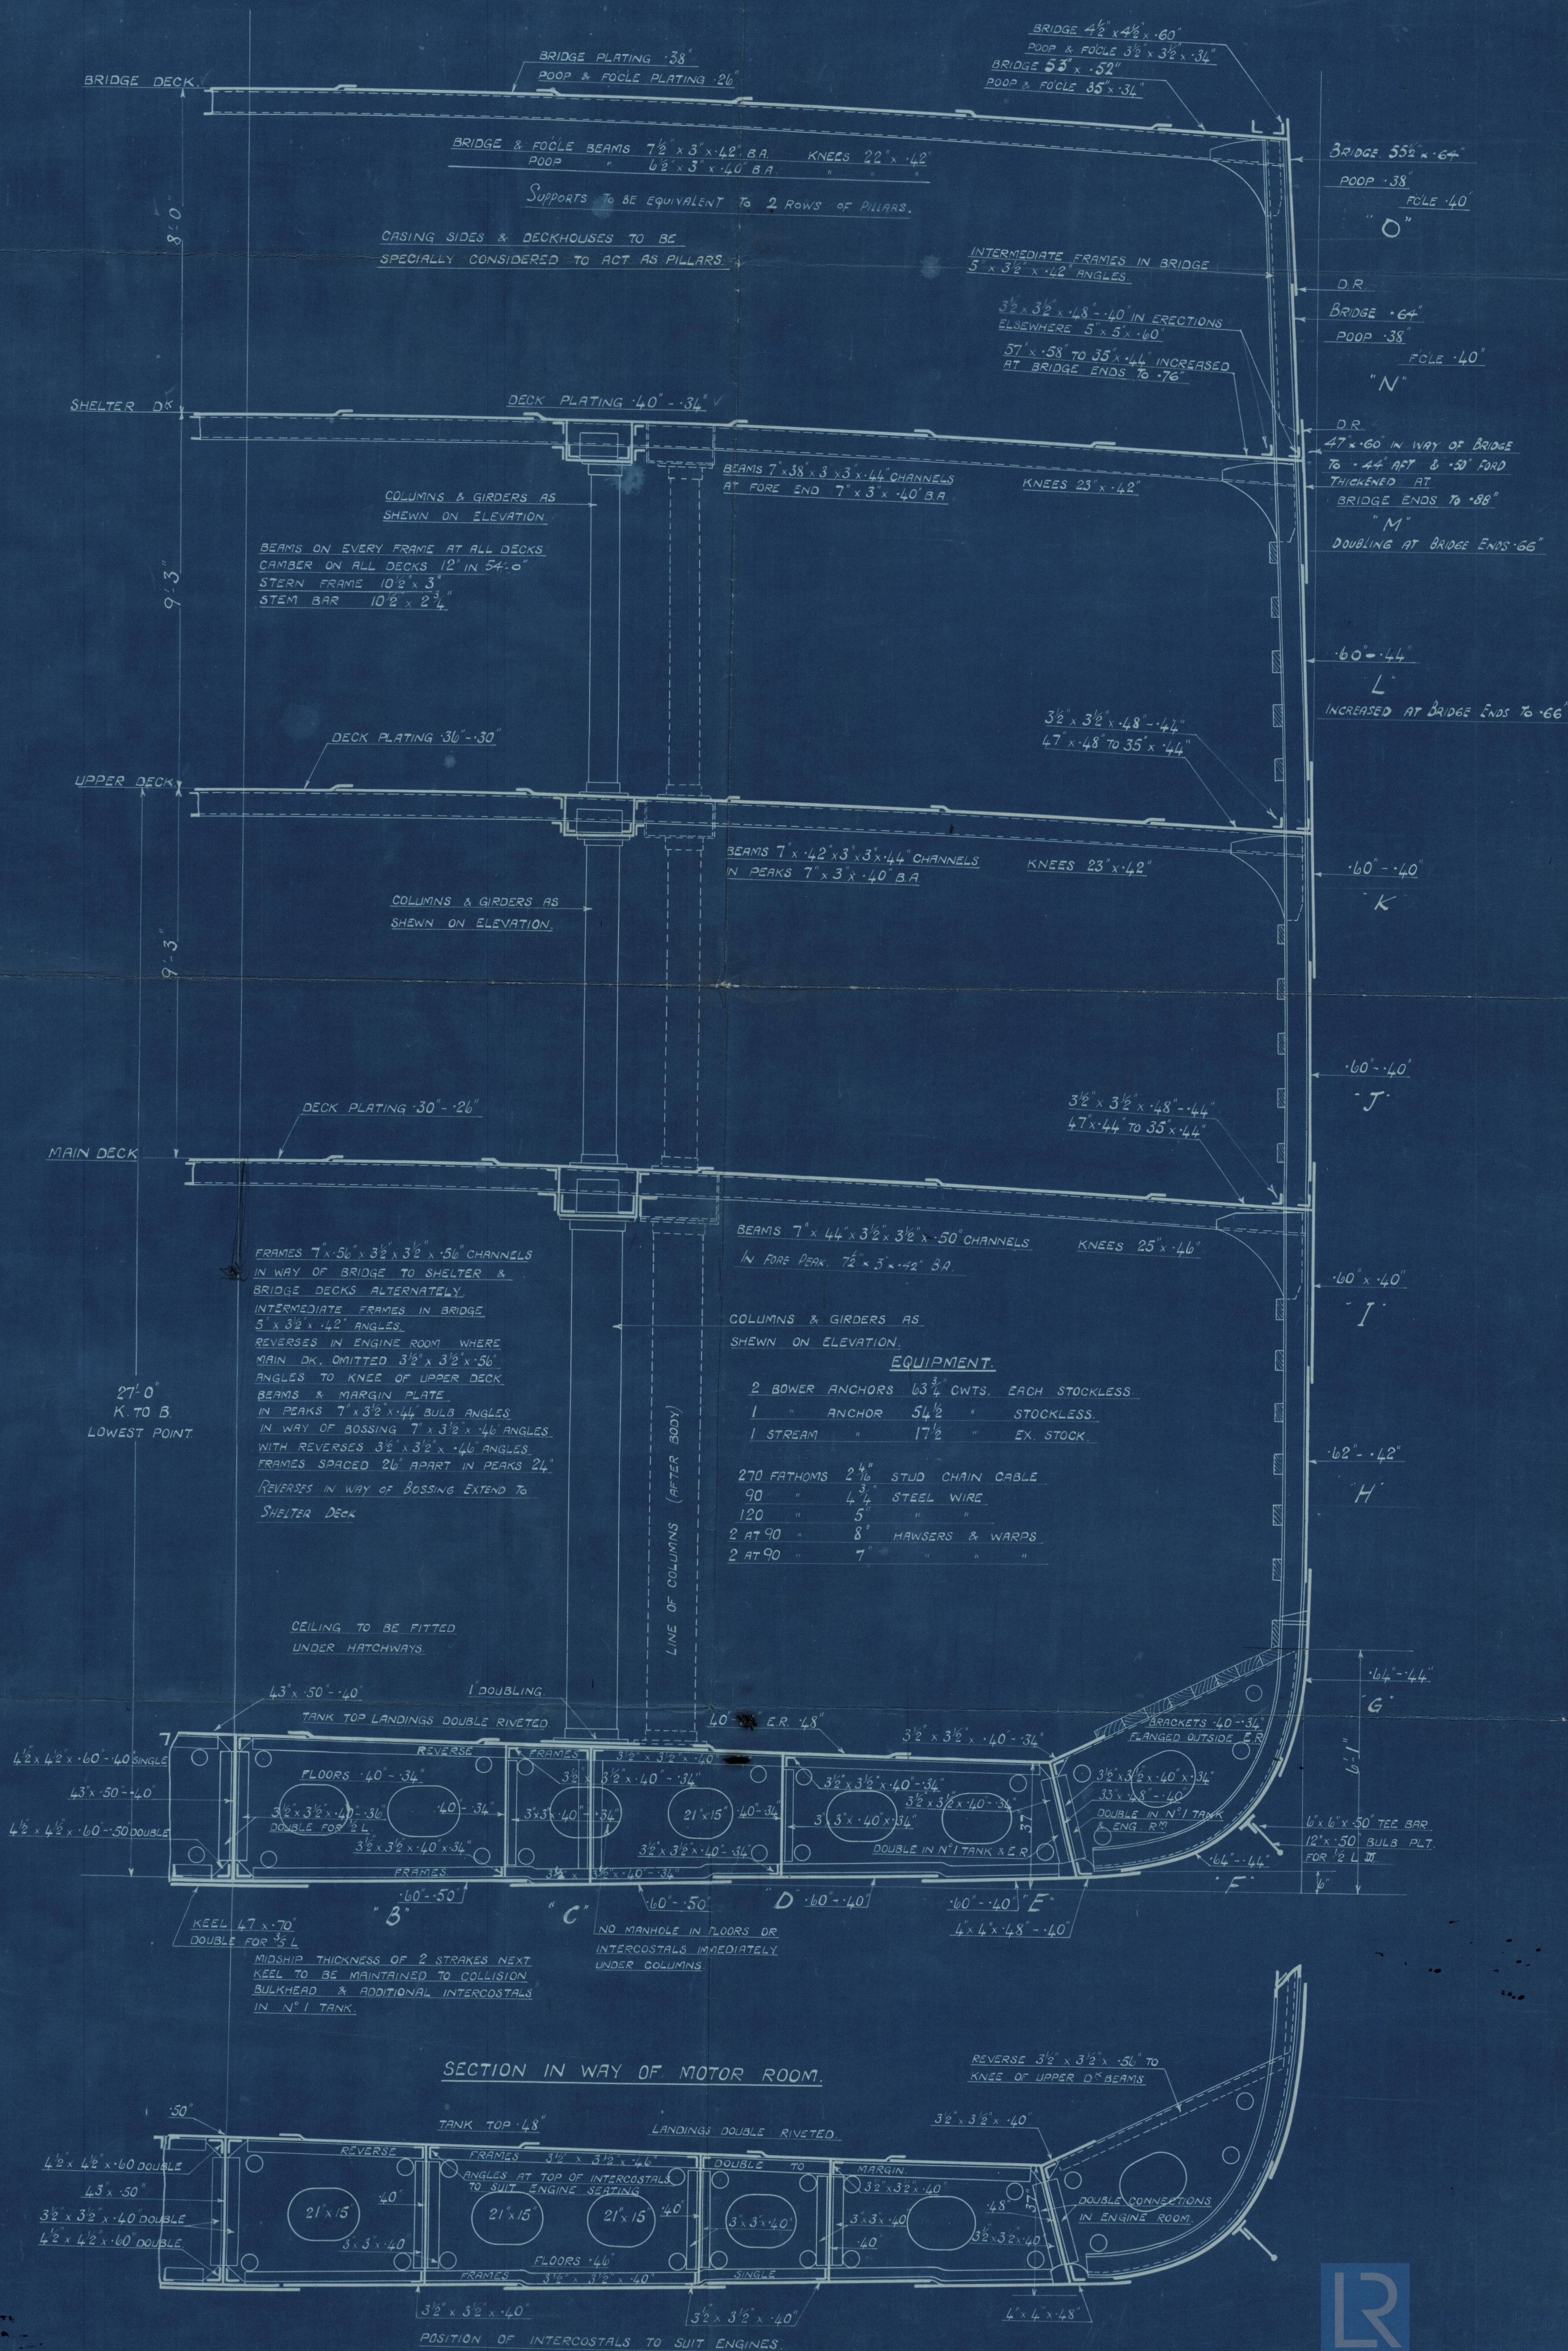

Edib

332

101

Mease Hall and S. Hoff N° 182

"Matting"
T. S. S. ^{ex} EDIB A.

Mudchip section of vessel
as built

382 GLASGOW REPORT No. 42668

W103-0215



© 2021

Lloyd's Register
Foundation