


SCALE $\frac{1}{8}'' = 1 \text{ FOOT}$

CLASS 100 AL LLOYDS

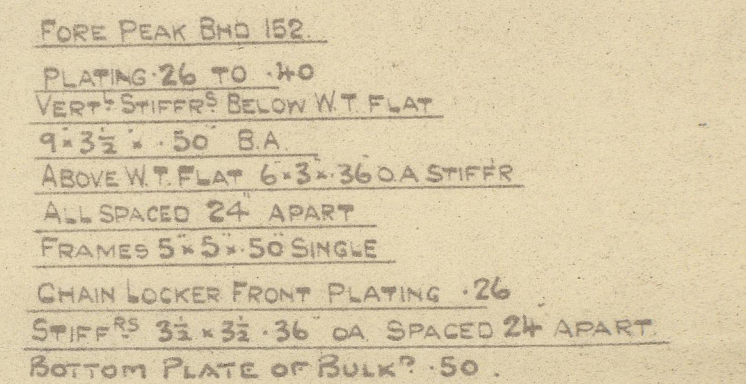

8034
539
21.11.19

SUNDERLAND

S.S. ["]SYRIAN PRINCE["]

J.L. THOMPSON'S No 539

PROFILE

(AS BUILT)

SLO. RAT. No 27674



© 2020

Lloyd's Register
Foundation

W1049-0202