



“UMTATA” **PROFILE & DECK PLANS.**

DIMENSIONS - 445'-0" P.P. - 61'-0" B.M.P. - 35'-6" D.M.P. TO UPPER DECK.

TO CLASS LLOYDS - 100 A.I. WITH FREEBOARD

SCANTLINGS SUITABLE FOR A SUMMER DRAFT OF 25'-6" B.K.

SCALE 1/8" = 1'-0"

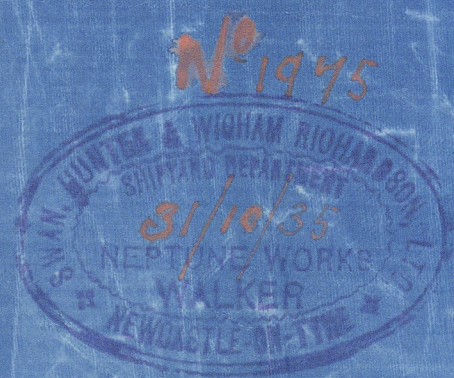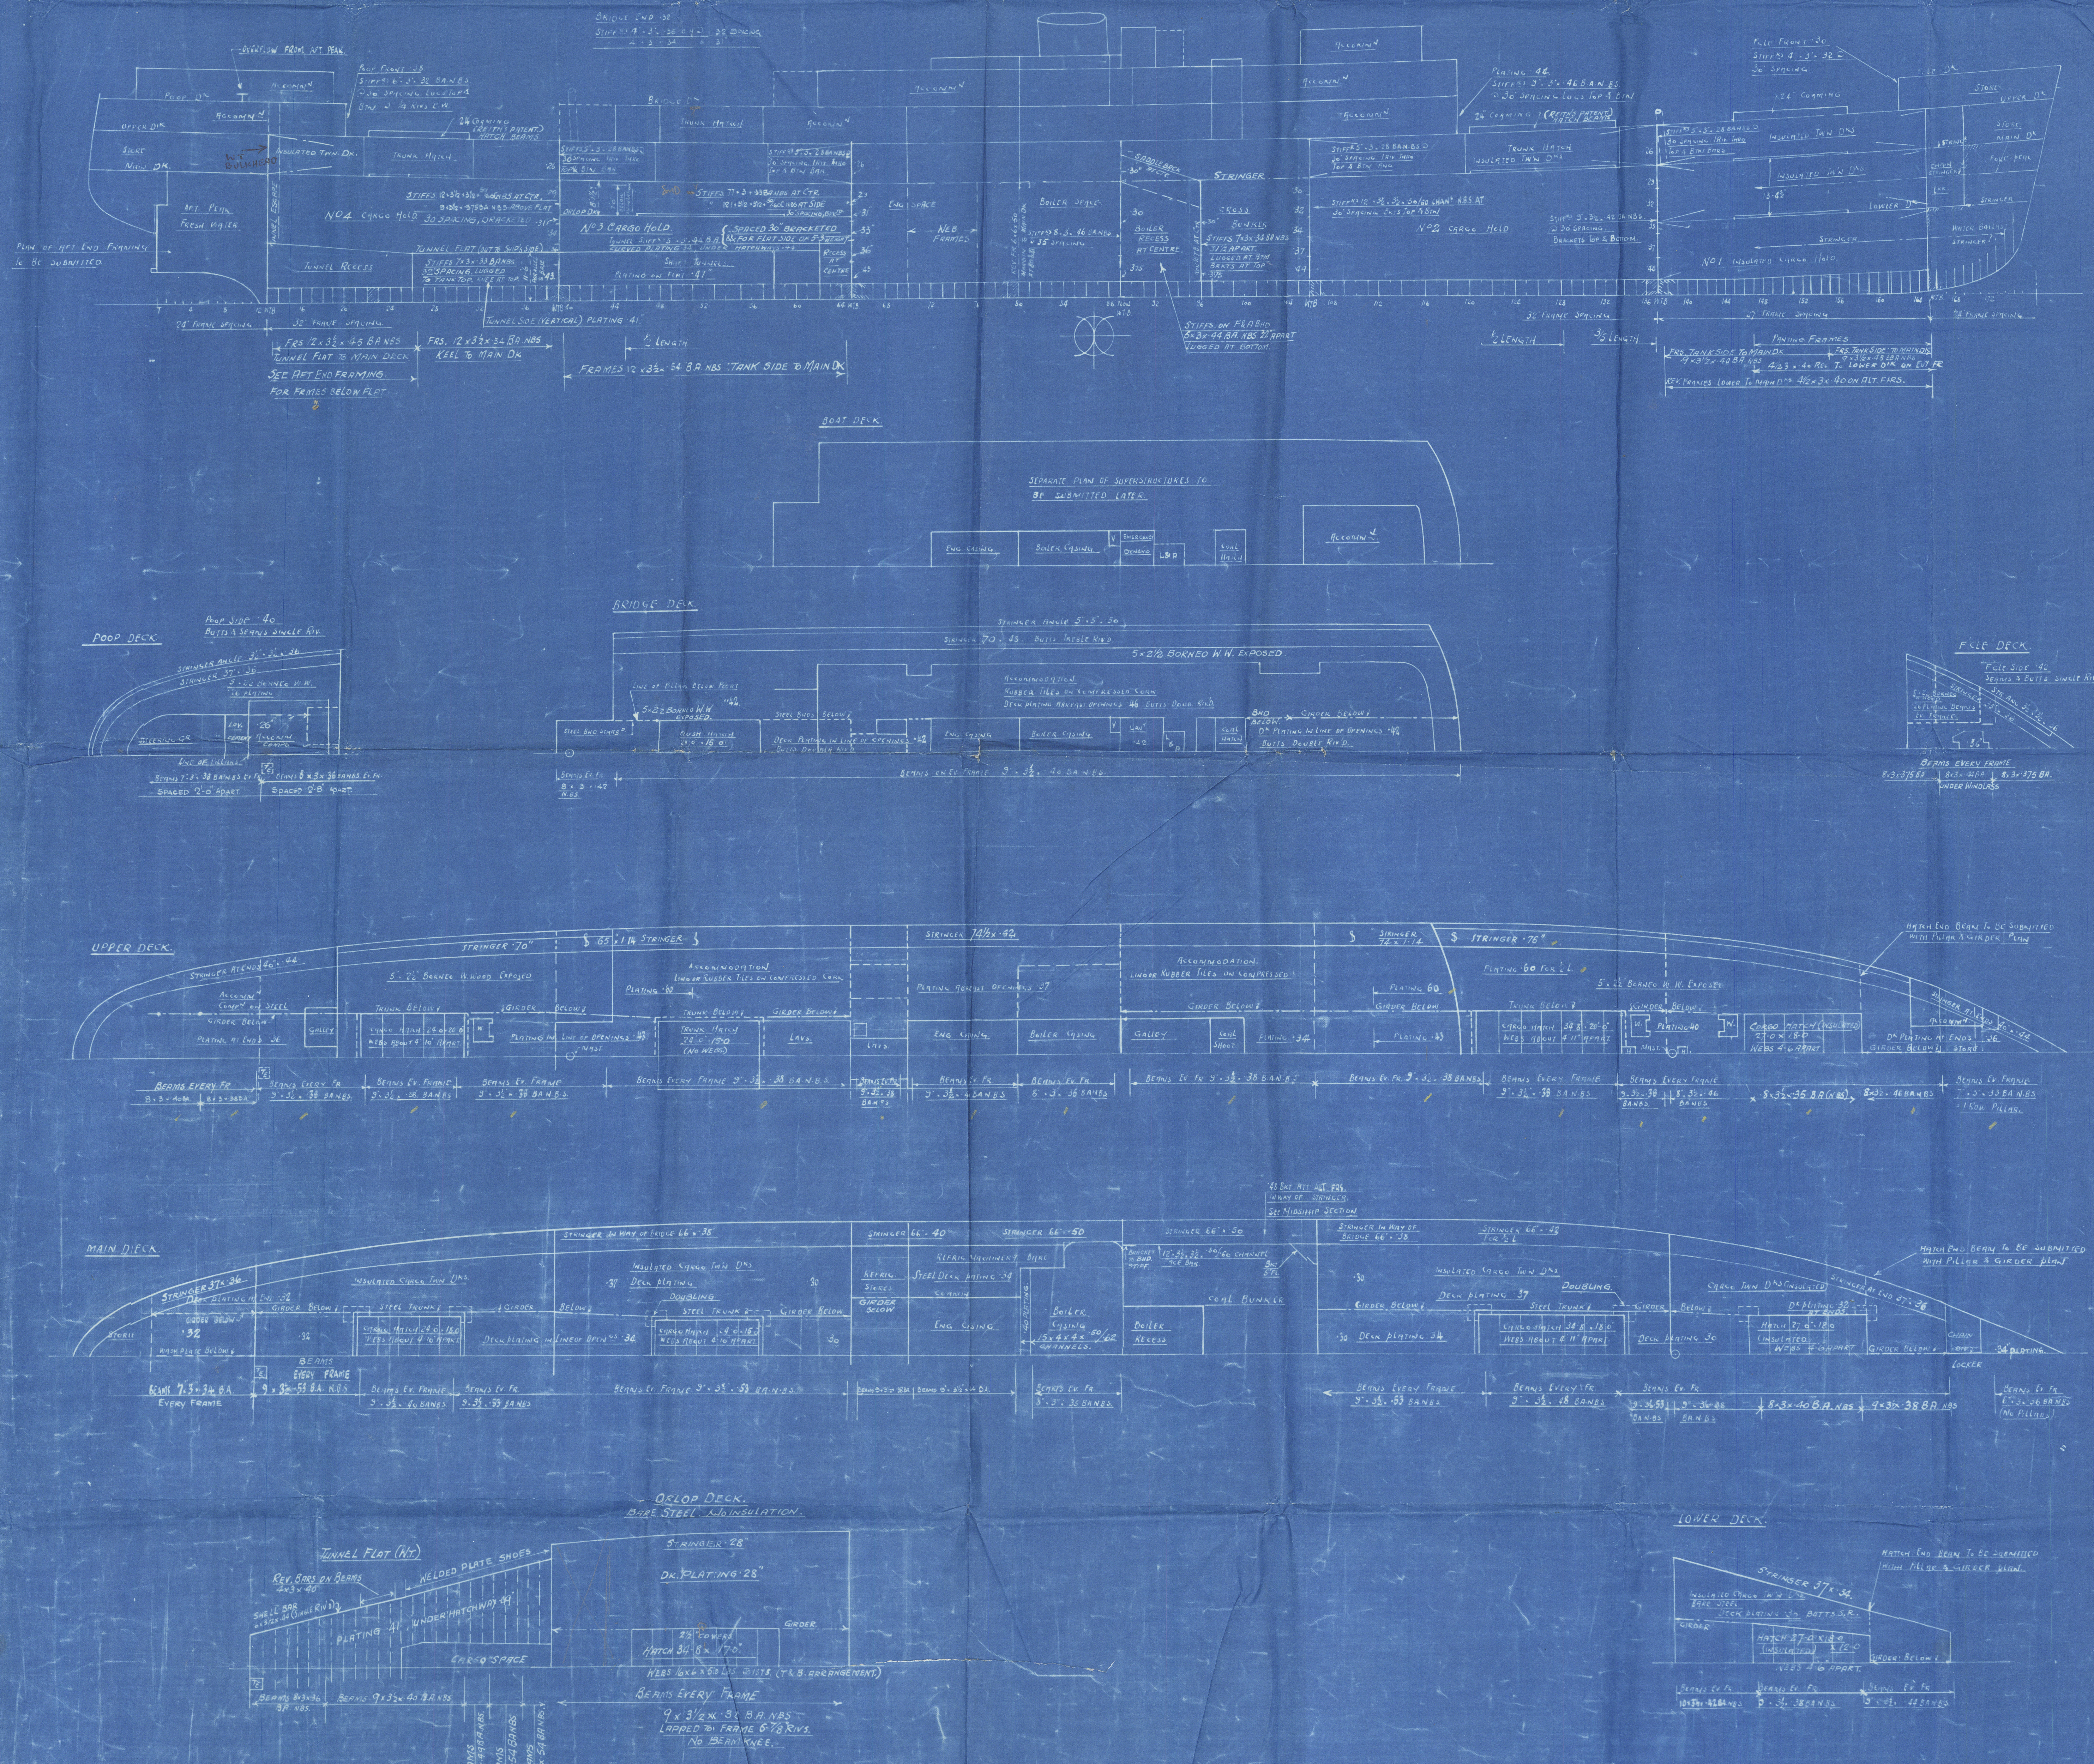

W1178-0206

Swan Hunter No 1480/1492 (22)

Profile + deck plan
as built

RETAIN

1480 T.S. "UMTATA" ~~1480~~

NEWCASTLE ON TYNE.

Report No. 93142

1492 ~~1480~~ Umtali

NEWCASTLE ON TYNE

Report No. 93942

~~PLANS TRANSFERRED
TO SISTER VESSEL~~



© 2021

Lloyd's Register
Foundation