






Master's Section  
(as built)

593 M.V. "~~Domala~~"  
Dumana

GLASGOW REPORT No  
42585

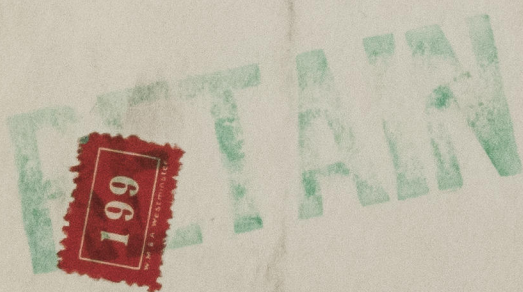

W1207-0049



© 2021

Lloyd's Register  
Foundation