


LENGTH B.P. 290'. BREADTH MLD, 40'-6", DEPTH MLD, 20'-0".

— SCALE $\frac{1}{8}'' = 1 \text{ FOOT.}$ —

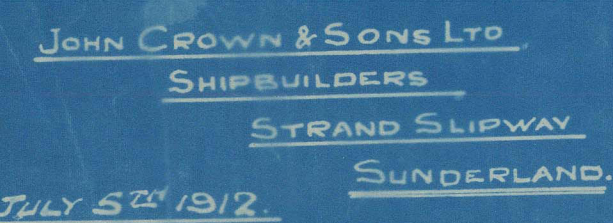

S/s. Slav

Profile & Deck Plan.

as built

J. Brown & Co's

No. 149

Sunderland Report N° 25493



© 2021

Lloyd's Register
Foundation

W1330 - 0230